


EAST QUARTER CORNER OF SECTION 1,  
T1N, R1W, S1B&M, U.S. SURVEY,  
17N, 17W, REBAR IN SOUTHWEST  
GATE POST

**SURVEYORS CERTIFICATE**  

SIGNED THIS 12<sup>TH</sup> DAY OF SEPTEMBER, 2006.  
UJAH LICENSE NUMBER

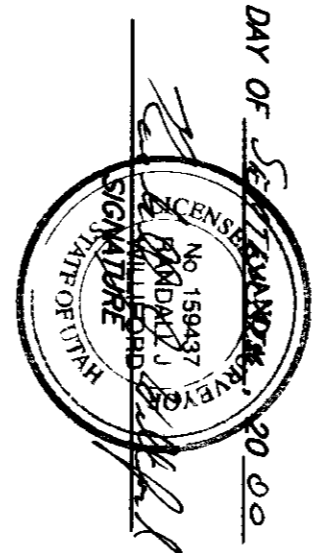

**BAIS OF BEARINGS**

THE BASIS OF BEARINGS FOR THIS PLAT IS THE UTM COORDINATE SYSTEM (1927) NORTH ZONE AS DETERMINED LOCALLY BY THE LINE OF BETWEEN THE EAST QUARTER CORNER AND THE SOUTHEAST CORNER AS 300.2424°W.

**NARRATIVE**



**SURVEYED DESCRIPTION**

PART OF THE SOUTHEAST QUARTER OF SECTION 1, T1N, R1W, S1B&M, U.S. SURVEY, DESCRIBED AS FOLLOWS:  
BEGINNING AT A POINT ON THE WESTERN RIGHT-OF-WAY LINE OF 5950 NORTH STREET, SAID POINT BEING 500.2424'W ALONG THE SECTION LINE 1082.24 FEET AND N89°35'36\"/>

**DEED DESCRIPTION**

PART OF THE SOUTHEAST QUARTER OF SECTION 1, TOWNSHIP 7 NORTH, COMMENCING AT A POINT 1571.02 FEET NORTH AND 1221.06 FEET WEST OF THE SOUTHEAST CORNER OF SAID SECTION 1, TOWNSHIP 7 NORTH, RANGE 1 WEST, THENCE SOUTH 45°14' WEST 241.76 FEET, THENCE 283.40 FEET, THENCE SOUTH 44°41'19\"/>

**LEGEND**

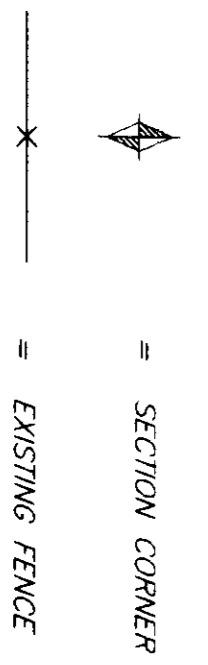

REVISIONS

1	
2	
3	
4	
5	
6	

PROJECT NO.	3435-01	SURVEYOR	A. MANFULL
DATE	8-8-06	DRAWN	K. GUNN
SCALE	1"=80'	CHECKED	

**REEVE & ASSOCIATES, INC.**  

**RECORD OF SURVEY**

**MANFULL PROPERTY**  
PART OF THE SOUTHWEST QUARTER, SECTION 1, T1N, R1W, S1B&M, U.S. SURVEY  
RECORDED IN DEED BOOK 1989, PAGE 188

SHEET	1
SHEETS	1

