

23RD STREET

49.5

SURVEYOR'S CERTIFICATE



SIGNED THIS 17TH DAY OF SEPTEMBER 2000

198437
TAYLOR LICENSE NUMBER

Randall W. Taylor
RANDALL W. TAYLOR
SURVEYOR

BASES OF BEARINGS

THE BASIS OF BEARINGS FOR THIS PLAT IS THE LINE BETWEEN THE FOUND CORNER OF THE NORTH LINE WAS DETERMINED BY THE INTERSECTION OF 23RD STREET AND ECLES AVENUE. ALL OTHER LINES WERE SET BY DEED.

MARRATIVE

THE PURPOSE OF THIS SURVEY IS TO DEFINE THE MORRIS TAYLOR PROPERTY FOR OWN RECORD. THE NORTH LINE WAS DETERMINED BY THE INTERSECTION OF 23RD STREET AND ECLES AVENUE. ALL OTHER LINES WERE SET BY DEED.

SURVEYED DESCRIPTION

PART OF BLOCK 34, PLAT C, AND PART OF THE SOUTHWEST QUARTER OF SECTION 28, T.1N., R.1W., S.1B.M., U.S. SURVEY, DESCRIBED AS FOLLOWS:

BEGINNING AT A POINT ON THE SOUTH RIGHT-OF-WAY LINE OF 23RD STREET, SAID POINT BEING 589.02'00" E 49.50' FEET AND 500.26'00" W 17.50' FEET FROM THE INTERSECTION OF 23RD STREET AND ECLES AVENUE, THENCE S 89°02'00" E ALONG SAID RIGHT-OF-WAY LINE OF 23RD STREET 67.96' FEET TO BEARING 50°03'00" W 89.03' FEET, THENCE N 89°02'00" E ALONG SAID RIGHT-OF-WAY LINE 89.03' FEET TO BEARING N 00°58'00" E 89.03' FEET TO THE POINT OF BEGINNING.


CONTAINS 6,000 SQUARE FEET

DEED DESCRIPTION



LEGEND

- X— EXISTING FENCE
- FOUND STREET MONUMENT
- ▣ EXISTING BUILDING

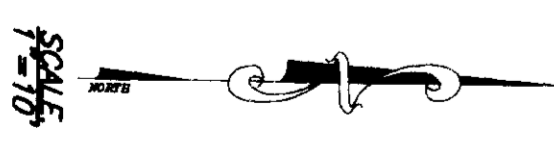


002575

REVISIONS

1	
2	
3	
4	
5	
6	

PROJECT No. J022-01 SURVEYOR ABRAHAM
DATE: NOVEMBER 10, 1999 DRAWN: MARRIAGE

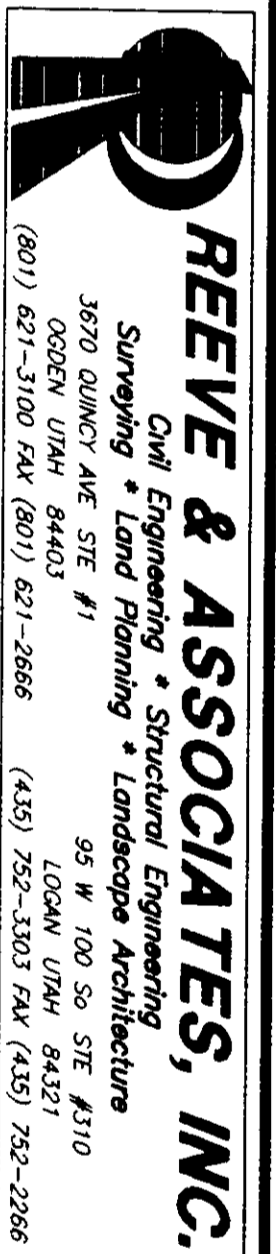

RECORD OF SURVEY

TAYLOR PROPERTY

PART OF BLOCK 34, PLAT C, AND PART OF THE SOUTHWEST QUARTER OF SECTION 28, T.1N., R.1W., S.1B.M., U.S. SURVEY
DATE OF SURVEY: NOVEMBER 1999

SHEET

1

SHEETS

002575