

1	REVISIONS
2	
3	



RECORD OF SURVEY

LOT 10 SHADOW OAKS SUBDIVISION UNIT ONE
 WEBER COUNTY, UTAH


SHEET	1
SHEETS	1

SURVEYED DESCRIPTION
 ALL OF LOT 10, SHADOW OAKS SUBDIVISION UNIT ONE, WEBER COUNTY, UTAH

NARRATIVE
 THE PURPOSE OF THIS SURVEY IS TO DEFINE THE BOUNDARY LINE OF LOT 10, SHADOW OAKS SUBDIVISION UNIT ONE FOR NORM GEORGE. THE SUBDIVISION WAS SET ON THE GROUND FROM THE FOUND REBAR & REBAR MARKERS AND THE FOUND MARKERS OF LOT 10 AND LOT 7, SHADOW OAKS SUBDIVISION UNIT ONE.

BASIS OF BEARINGS

SURVEYED DESCRIPTION
 SHADOW OAKS SUBDIVISION UNIT NO 3
 DAROLD EDWIN GALLOWAY & BONNIE JEAN GALLOWAY TR

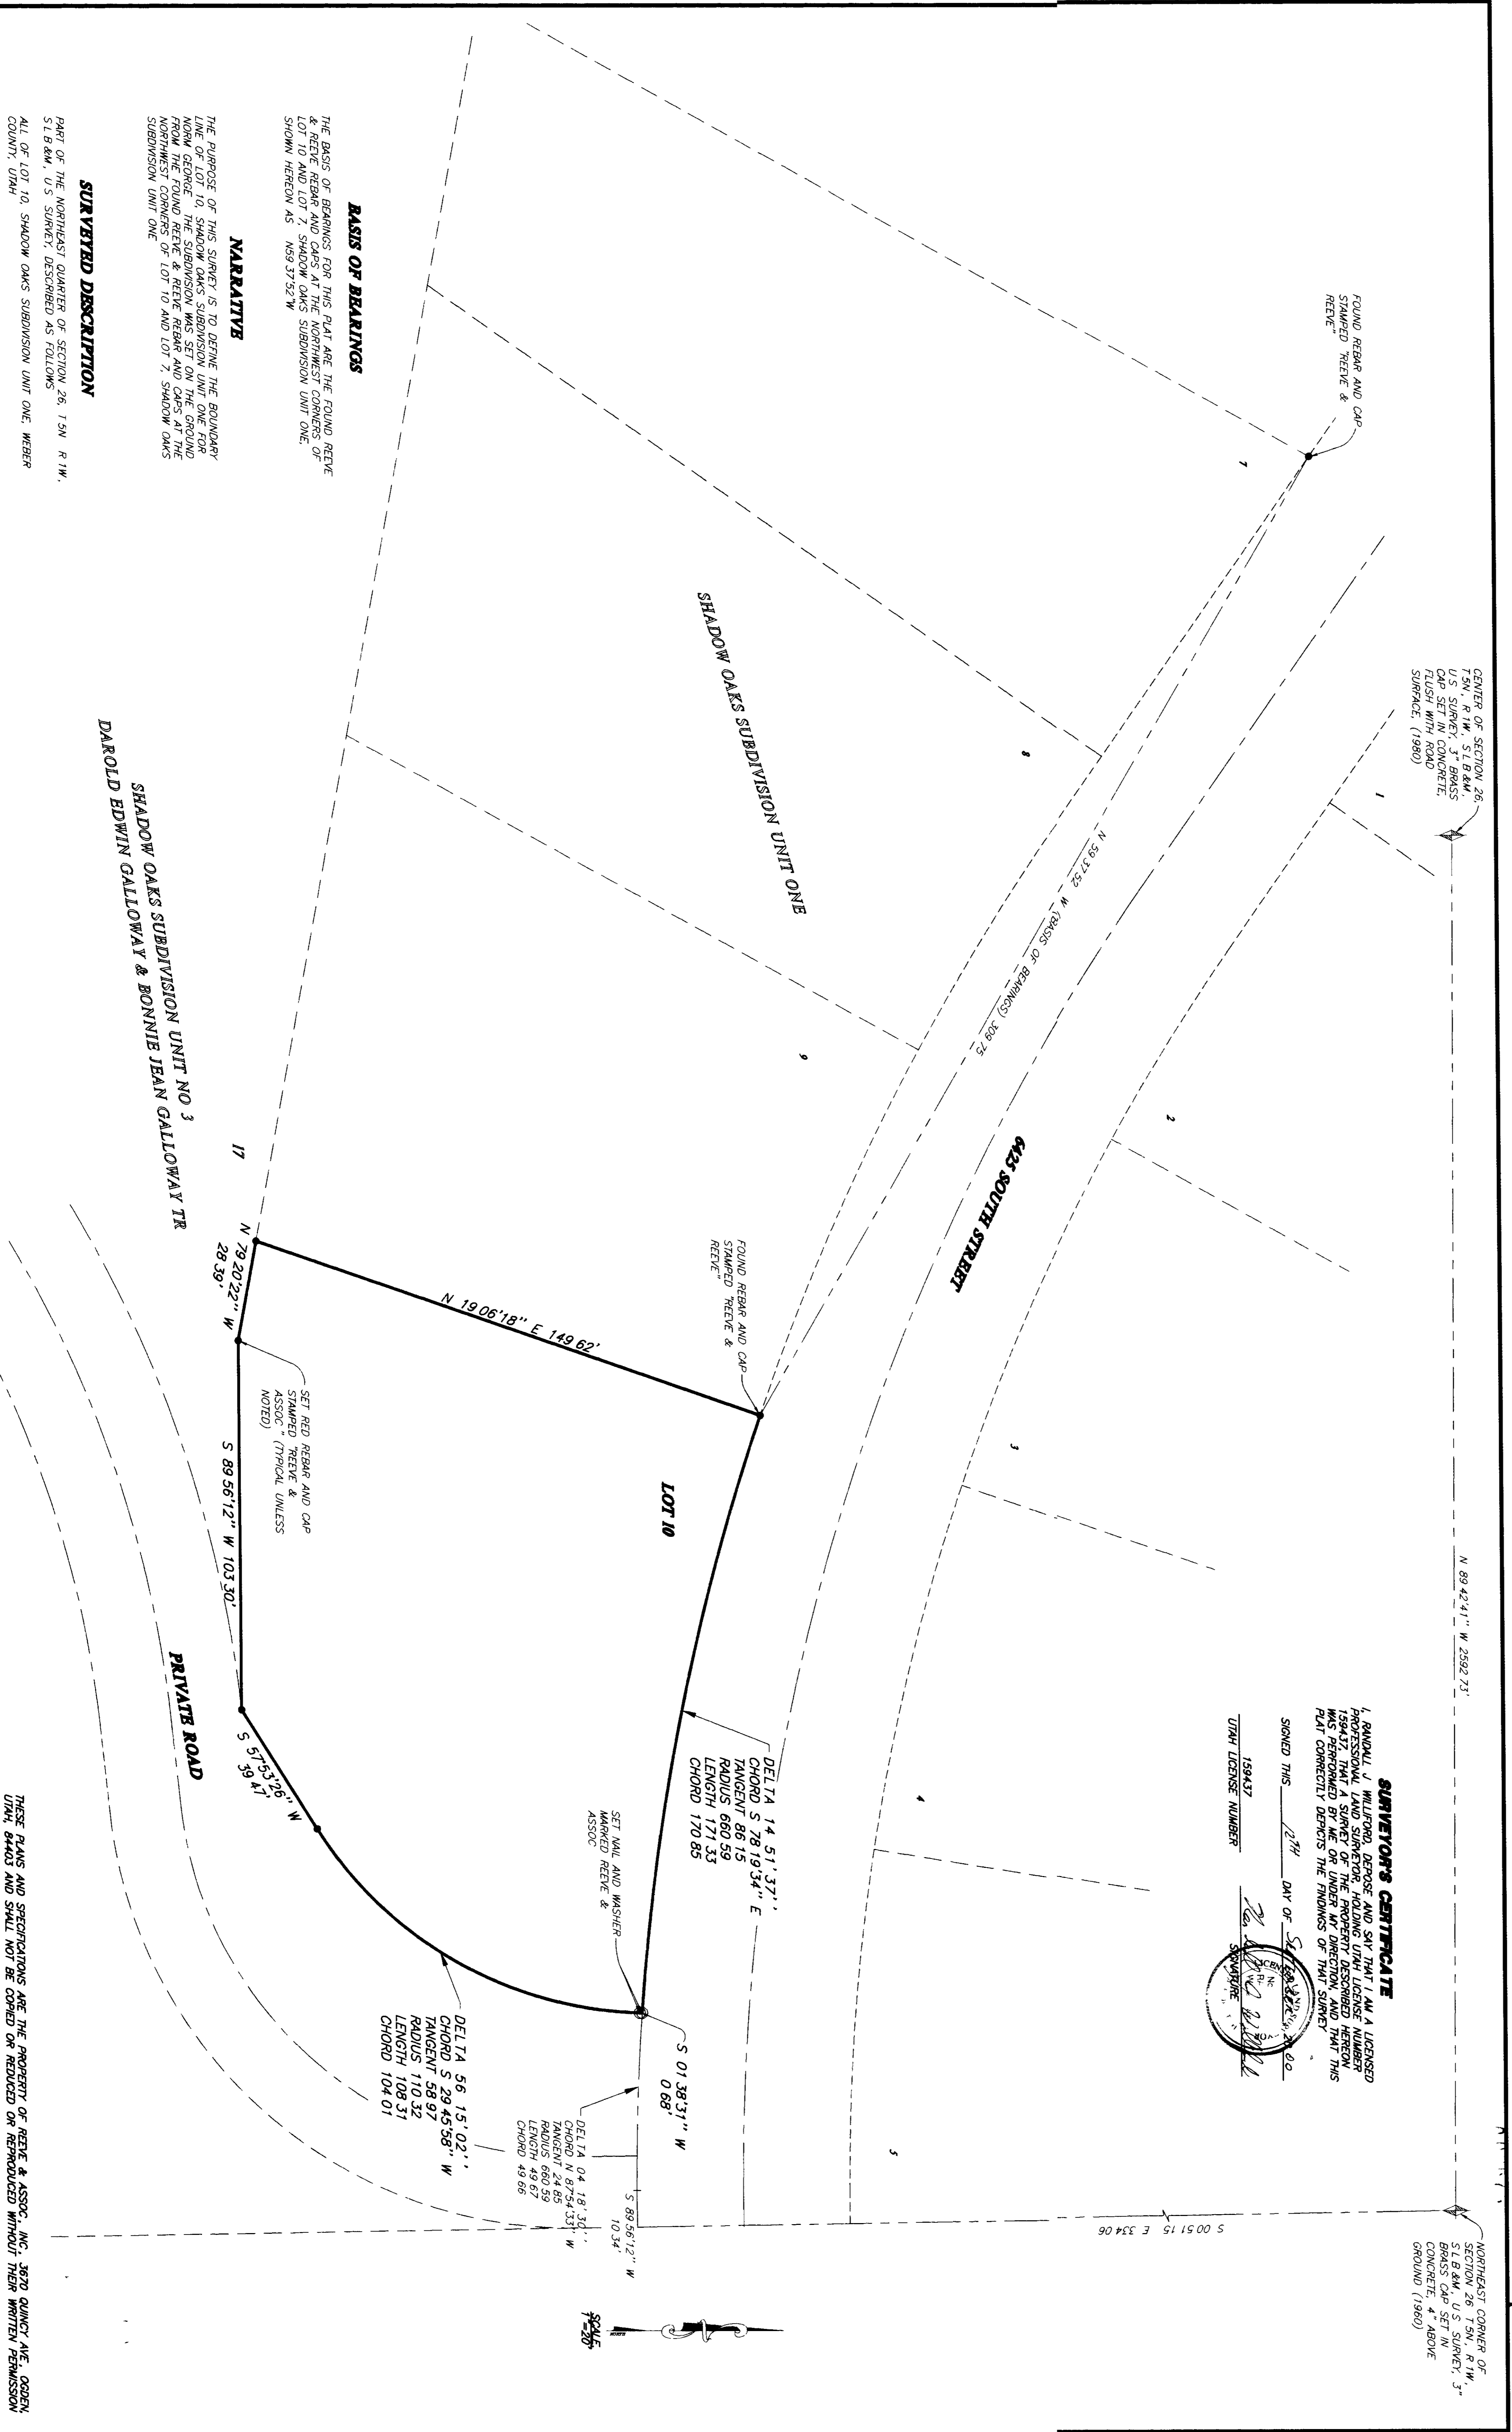

SURVEYOR'S CERTIFICATE
 RANDALL J. WILLFORD
 SURVEYOR
 UTAH LICENSE NUMBER 158437

