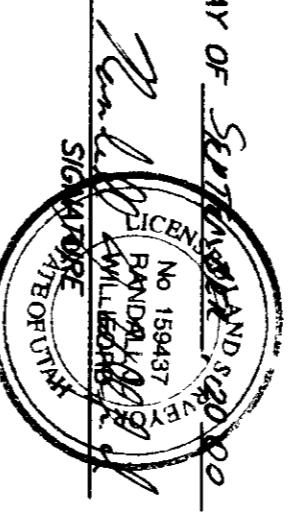
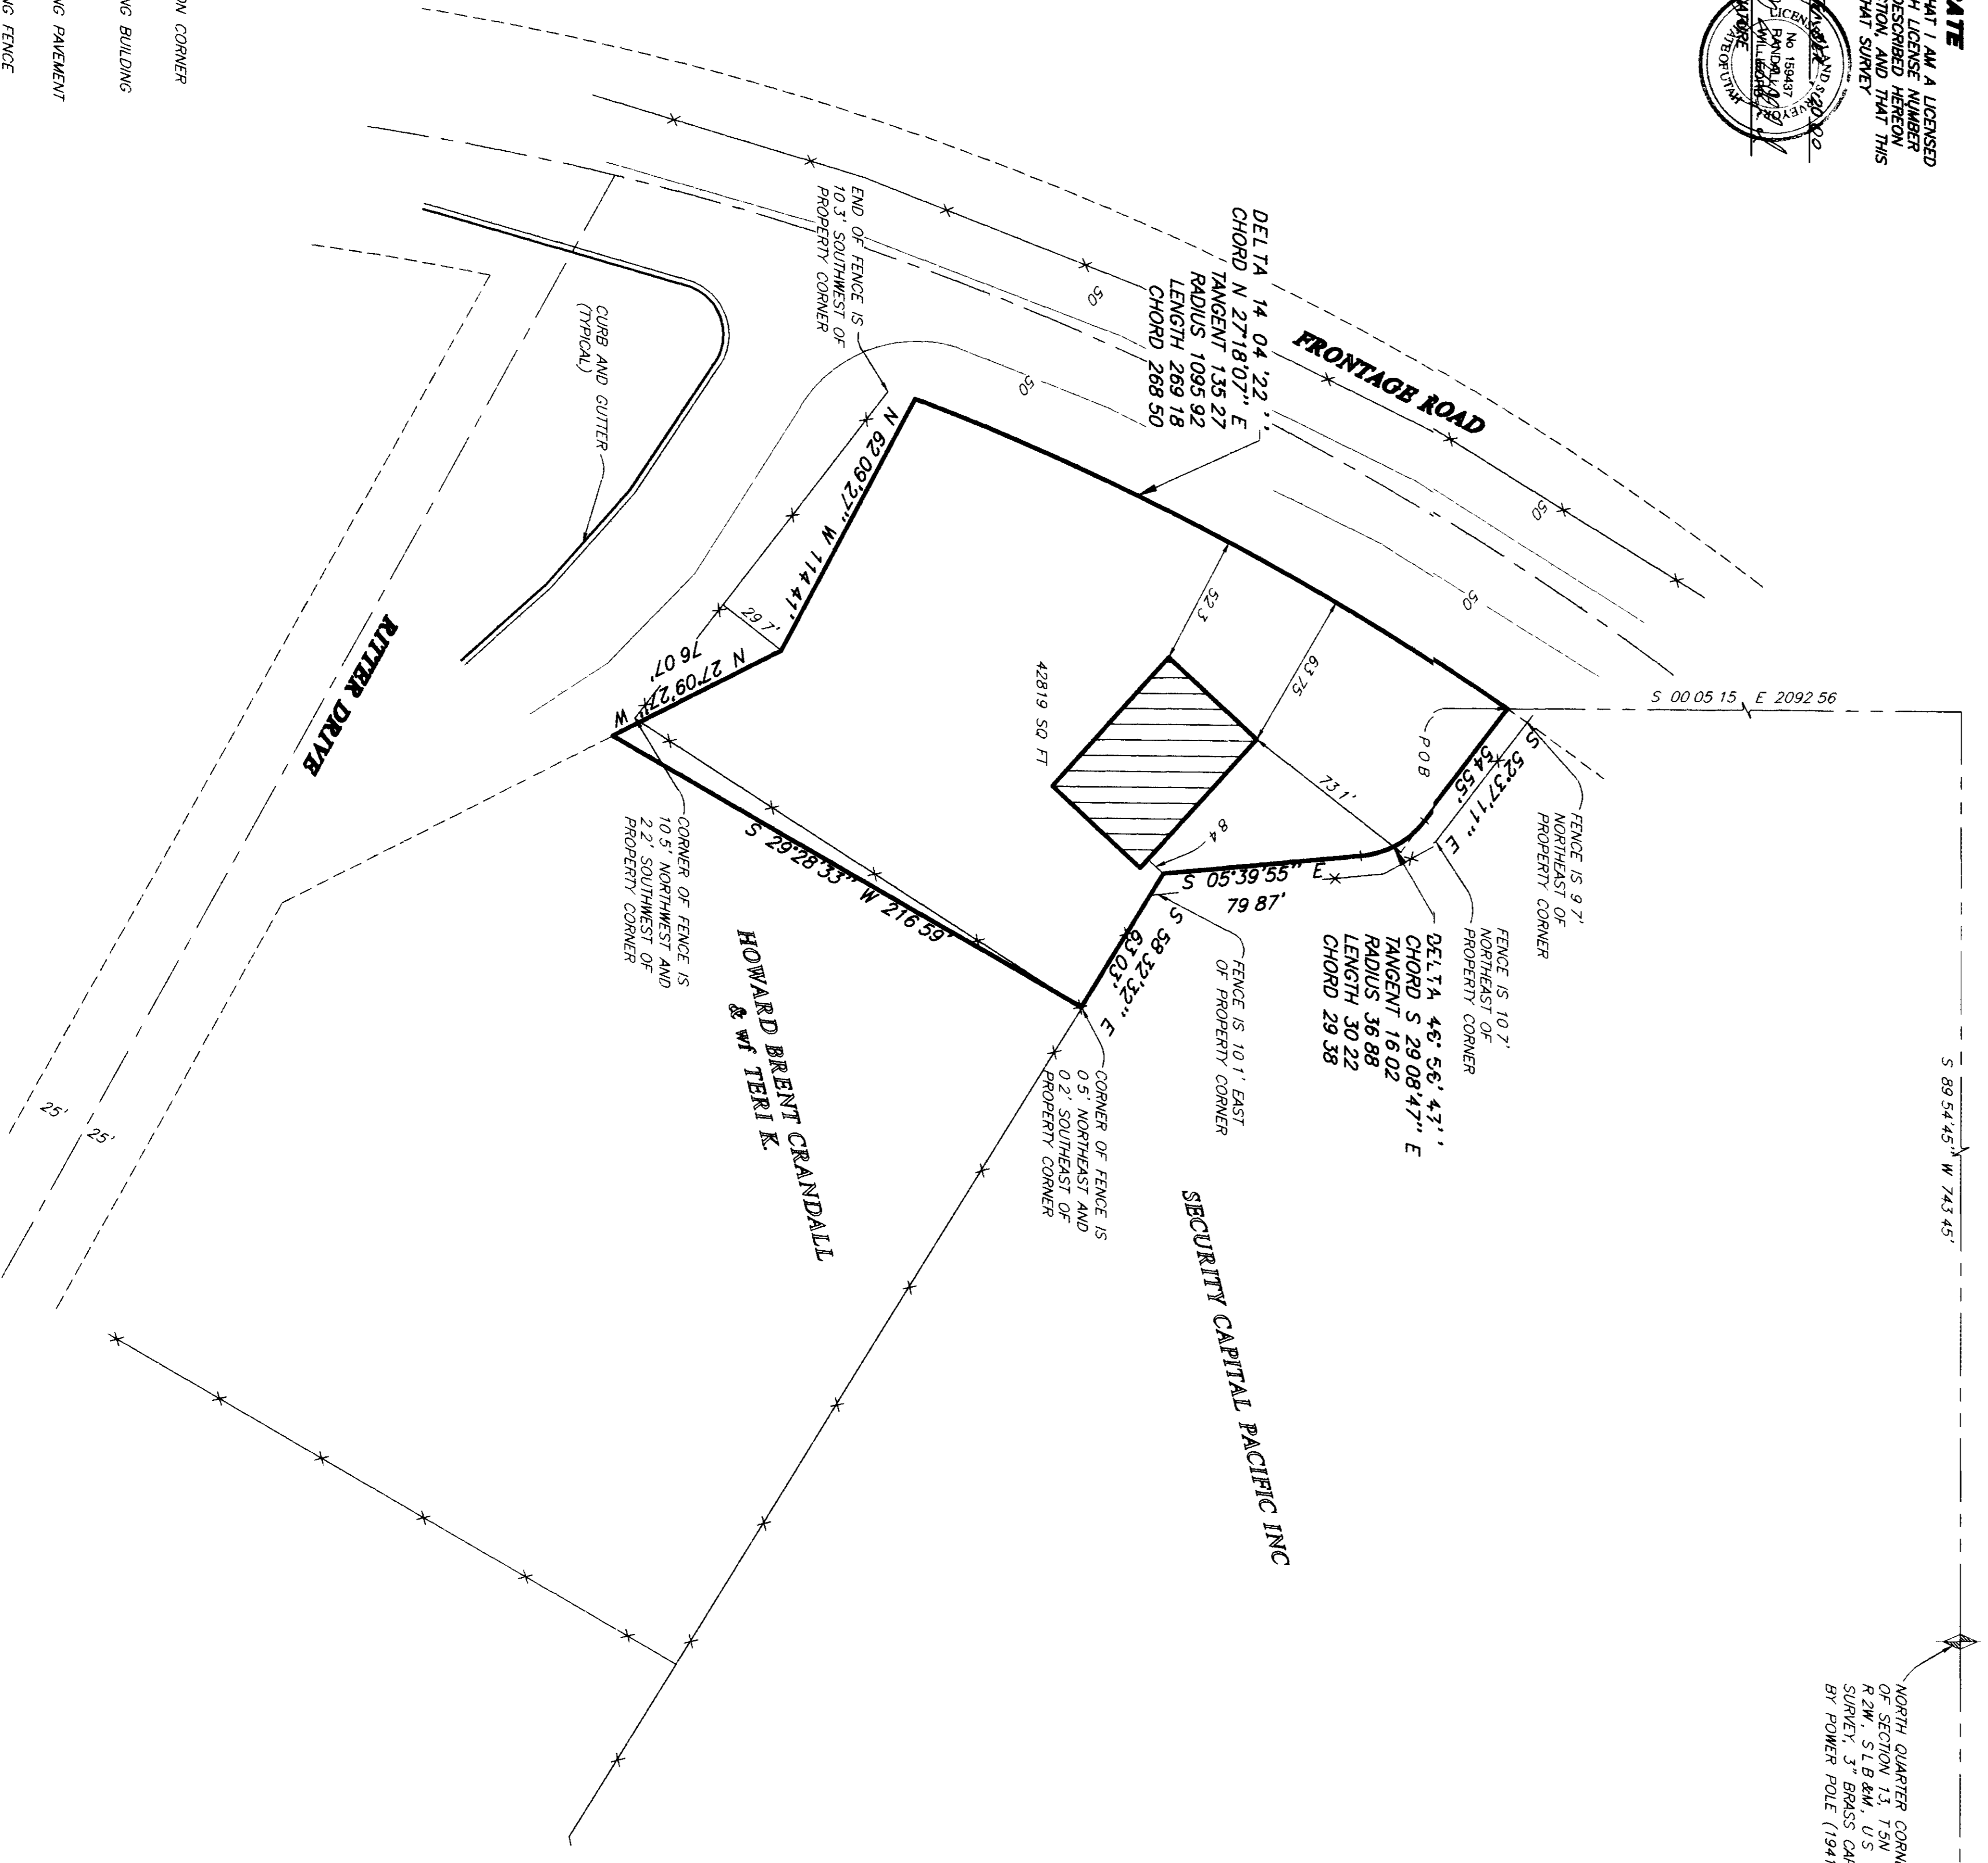
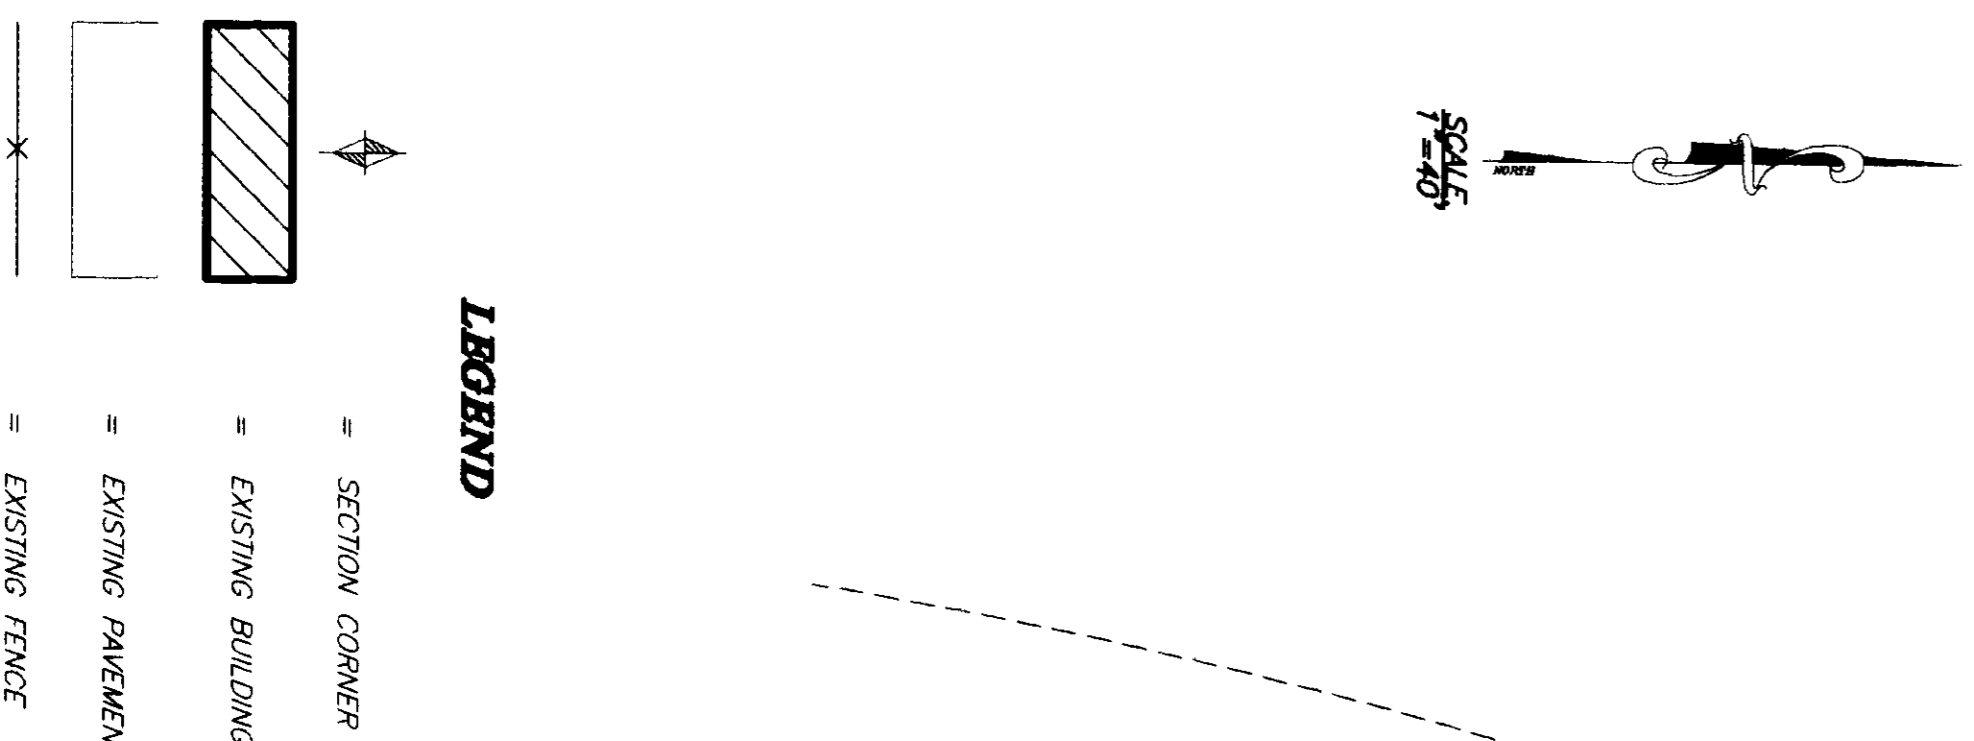


SURVEYORS CERTIFICATE



159437
UNIV. LICENSE NUMBER

NORTH QUARTER CORNER OF SECTION 13, T.5N., R.2W., S.1 & 2, U.S. SURVEY, 3' BRASS CAP BY POWER POLE (1941)

NORTHEAST CORNER OF SECTION 13, T.5N., R.2W., S.1 & 2, U.S. SURVEY, 3' BRASS CAP (1941)

BASIS OF BEARINGS


NARRATIVE

THE PURPOSE OF THIS SURVEY IS TO DEFINE THE BOUNDARY OF THE THOMAS E DAVIS PROPERTY FOR RAY WILEY. THE WESTERN LINE WAS FIXED BY THE EASTERN RIGHT-OF-WAY LINE OF THE FRONTAGE ROAD. ALL OTHER LINES WERE SET BY BEARING ALONG THE PROPERTY LINE OF RITTER DRIVE. ALL OTHER LINES WERE SET BY BEARING FROM CURVES TO BE SET WITH A 5/8" REBAR AND CAP MARKED "REEVE & ASSOCIATES".

SURVEYED DESCRIPTION

START OF THE NORTHWEST QUARTER OF SECTION 13, T.5N., R.2W., S.1 & 2, U.S. SURVEY, DESCRIBED AS FOLLOWS:



DEED DESCRIPTION

PART OF THE SOUTHWEST QUARTER OF THE NORTHWEST QUARTER OF SECTION 13, T.5N., R.2W., S.1 & 2, U.S. SURVEY, DESCRIBED AS FOLLOWS:



THESE PLATS AND SPECIFICATIONS ARE THE PROPERTY OF REEVE & ASSOC. INC. A SUBS. OF THOMAS E DAVIS PROPERTY RECORD OF SURVEY. THESE PLATS AND SPECIFICATIONS SHALL NOT BE COPIED OR REPRODUCED WITHOUT THEIR WRITTEN PERMISSION.

REVISIONS

1		
2		
3		
4		
5		
6		

PROJECT NO. 0001-20
DATE 8-1-00
SCALE 1"=40'
DRAWN BY J. GUNN
CHECKED BY

REEVE & ASSOCIATES, INC.
ENGINEERS PLANNERS & SURVEYORS

RECORD OF SURVEY

THOMAS E DAVIS PROPERTY
PART OF THE NORTHWEST QUARTER OF SECTION 13, T.5N., R.2W., S.1 & 2, U.S. SURVEY
RECORDED BY
DATE 08-12-00

SHEET	1
SHEETS	1