002583

002583

002583

002583

2000\00-3 109\drawings\00-3 109 dwg Fri Jul 28 08 55 39 2000 Greg

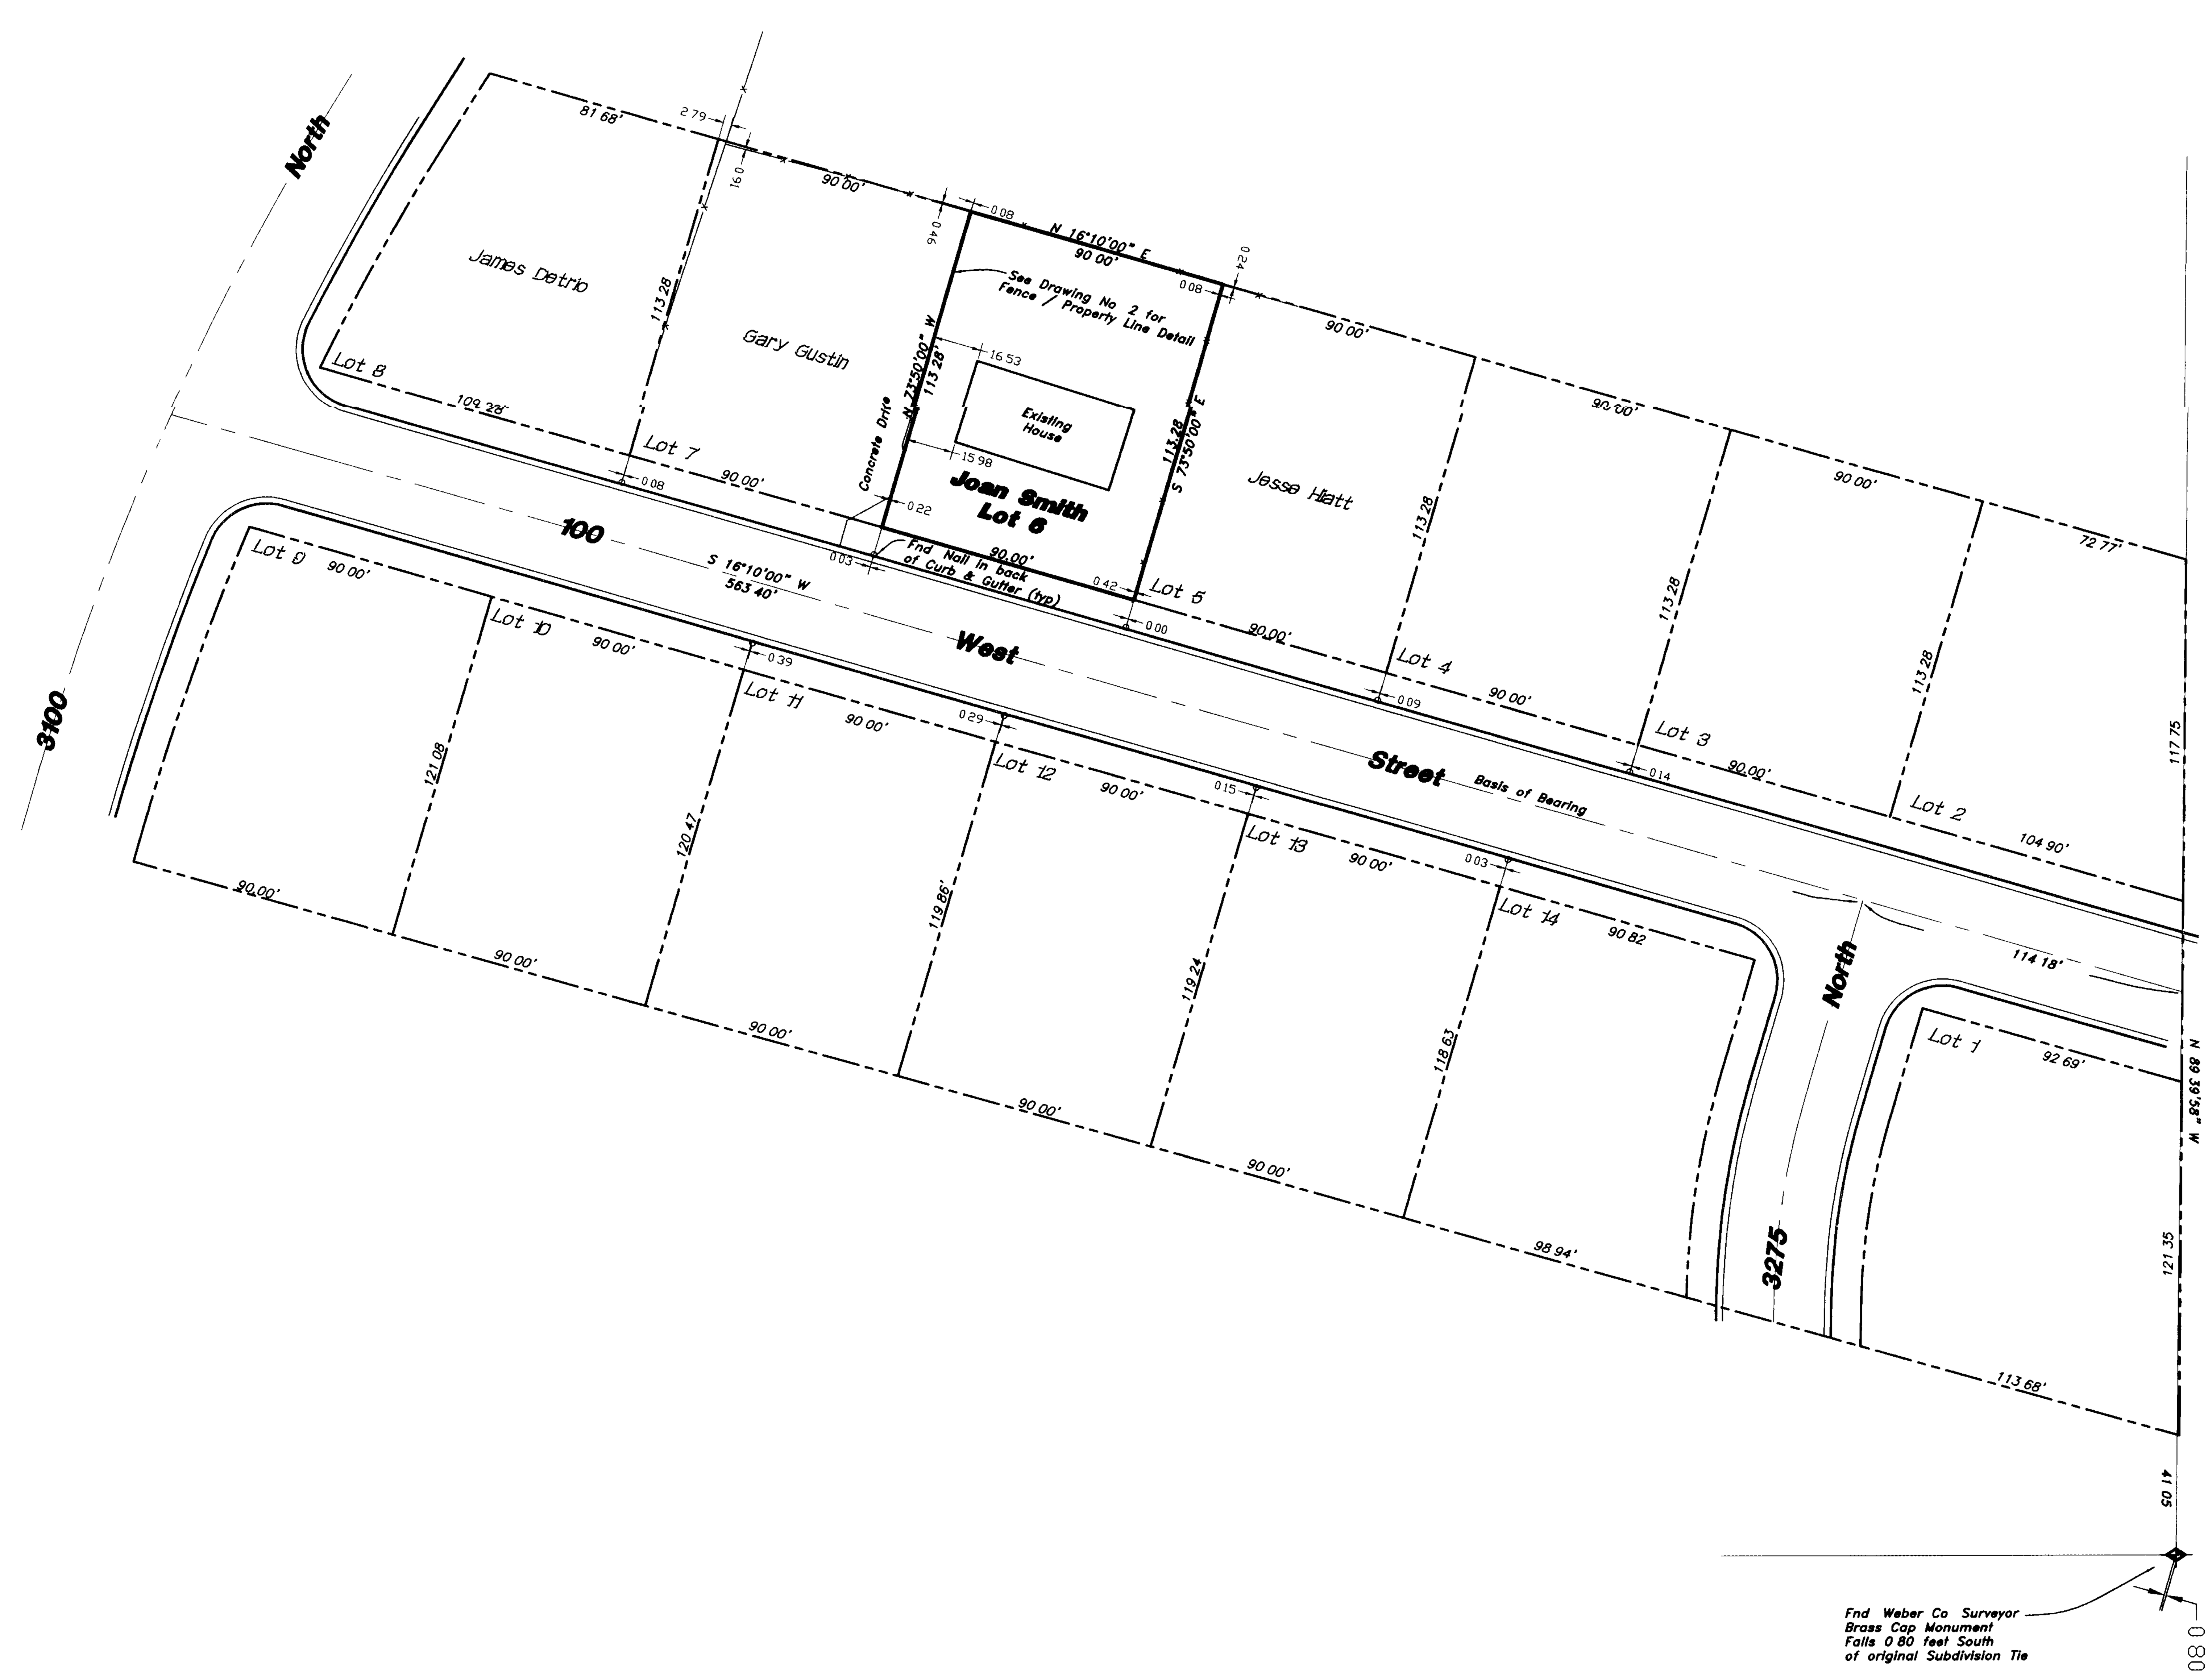

002583

Scale 1" = 30'

LEGEND

- PROPERTY LINE
- CENTERLINE
- CURB & GUTTER
- EDGE OF PAVEMENT
- DITCH
- FENCE LINE
- STREET MONUMENT
- SET 5/8 REBAR W/ CAP SET 01/01/2000

Narrative

The purpose of this survey was to establish and show the relationship between property lines and the existing fence and improvements along the south property line of Lot No 6 as shown and described hereon The survey was ordered by Joan Smith The control used to establish the property corners was the existing concrete nails found in the back of the curb and gutter along with existing fence lines The basis of bearing is the line established from these nails along the west side of 100 West Street which bears North 16°10'00" East The tie to the North Quarter Corner of Section 29, T7N, R1W, SLB&M which is a Weber Co Surveyor Brass Cap Monument fell 0 8' South of the Tie as shown on the Mesa Del Norte' Subdivision

Property Description

Lot 6, Mesa Del Norte' Subdivision being in the Northwest Quarter of section 29, Township 9 North, Range 1 West of the SLB&M, Ogden, Weber County, Utah Survey

RECEIVED
2000
Weber County Surveyor

002583

SURVEY CERTIFICATE

I, K Greg Hansen, do hereby certify that I am a Registered Land Surveyor, and that I hold Certificate No 167819 as prescribed by the Laws of the State of Utah, and that I have made and/or Supervised the survey of the property shown and described hereon and that this plat is a true and correct representation of said survey to the best of my knowledge and belief

K Greg Hansen
RLS No 167819

07/28/2000
date

REGISTERED LAND SURVEYOR 167819 K GREG HANSEN STATE OF UTAH

PROPERTY SURVEY FOR

Joan Smith

3185 North 100 West
North Ogden, Weber Co, Utah
A PART OF THE NORTHWEST QUARTER OF SECTION 29, TOWNSHIP 9 NORTH, RANGE 1 WEST, S L B & M

Drawn By	KGH Date 07/17/00
Designed By	
Checked By	
Approved By	
Scale	1" = 30'
Drawing File	00-3-109 DWG
JOB NUMBER	00-3-109

HANSEN & ASSOCIATES, INC.
Consulting Engineers and Land Surveyors
538 North Main Brigham City, Utah 84302
Brigham City 723-3491 | Ogden 399-4905 | Logan 752-8272

SHEET 1 OF 2 SHEETS

No	Date	By	Revision