


I, **LARRY M. BUTTARS**, A REGISTERED LAND SURVEYOR IN THE STATE OF UTAH, AND HOLDING LICENSE NUMBER **2576** DO HEREBY CERTIFY THAT I HAVE MADE A SURVEY OF THE BELOW DESCRIBED PROPERTY AND THE PLAT HEREON IS A TRUE AND CORRECT REPRESENTATION OF SAID SURVEY.

DATE: 7-29-89

SIGNED: Larry M. Buttars

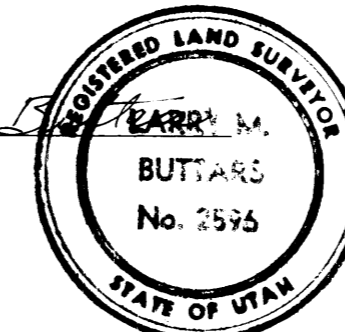

DESCRIPTION

A PART OF LOT 55, SILVER BELL ESTATES NO. 1, SECTION 32, TOWNSHIP 7 NORTH, RANGE 1 EAST, SALT LAKE BASE AND MERIDIAN. BEGINNING AT THE SOUTHEAST CORNER OF SAID LOT 55 AND RUNNING THENCE N. 79° 00' W. 307.28 FEET, THENCE N. 18° 00' E. 49.33 FEET, THENCE N. 8° 44' E. 147.64 FEET, THENCE S. 75° 00' E. 307.86 FEET, THENCE S. 11° 00' W. 67.80 FEET TO A CURVE THAT BEARS A LONG CHORD OF S. 11° 00' W. 86.62 FEET, RADIUS OF 50.0 FEET AND LENGTH OF 104.75 FEET, THENCE S. 11° 00' W. 20.58 FEET TO THE POINT OF BEGINNING.

NARRATIVE

THIS SURVEY WAS TO ESTABLISH THE PROPERTY CORNERS FOR IMPROVEMENT PURPOSES. IN EXAMINING THE ORIGINAL RECORDED SUBDIVISION PLAT (SILVER-BELL ESTATES # 1) IT WAS FOUND THAT THE BACK BOUNDARY OF THE LOT WAS IN ERROR; THE PLAT SHOWS: N. 18° E. 44.33 FEET, WHEN IT SHOULD READ N. 18° E. 49.33 FEET. THIS NEW DISTANCE CLOSES MATHEMATICALLY THE BOUNDARY OF THE LOT AND AGREES WITH THE TOTAL BOUNDARY OF THE ORIGINAL SUBDIVISION PLAT. THERE IS NO AFFECT ON THE ADJACENT LOTS WHATSOEVER.

N.E. Cor. Sec. 32, T.7N., R.1E.

NORTH
5318.69'

S.E. Cor. of Sec. 32 T.7N., R.1E.

Set corners with 1/8" Re-bar as indicated with O
Easements shown by dashed lines.

BUTTARS SURVEYING	
1815 20th ST., OGDEN, UTAH PH. 292-5291	
Client:	Richard D'Amore
Survey Location:	Silver Bell Estates No. 1 Subdivision Weber County, Utah
Survey Date:	7-29-89

RECEIVED
SEP 07 1989
Weber County Surveyor