

SURVEYOR'S NARRATIVE



SURVEYED DESCRIPTIONS

curve of 183 63 foot radius curve on Melanie Lane, thence South 36 53 55" West 35 00 feet to point of curve, thence to the right along the arc of a 20 00 foot radius curve 31 42 feet, the long chord of which bears South 83 54 55" West 28 28 feet to a point of tangent, thence North 51 06 05" West 280 00 feet to the most westerly corner of said Lot 43, thence North 38 53 55" East 460 02 feet to the point of beginning.

Contains 1.93 acres


7/20/00 Date


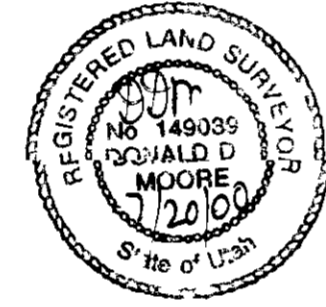

LEGEND

○	SET BAR AND CAP
—	EDGE OF ASPHALT
—x—	FENCE LINE
—P—P—	OVERHEAD POWER LINE
—H—	WATER LINE
— —	IRRIGATION LINE
—PUE	PUBLIC UTILITY EASEMENT

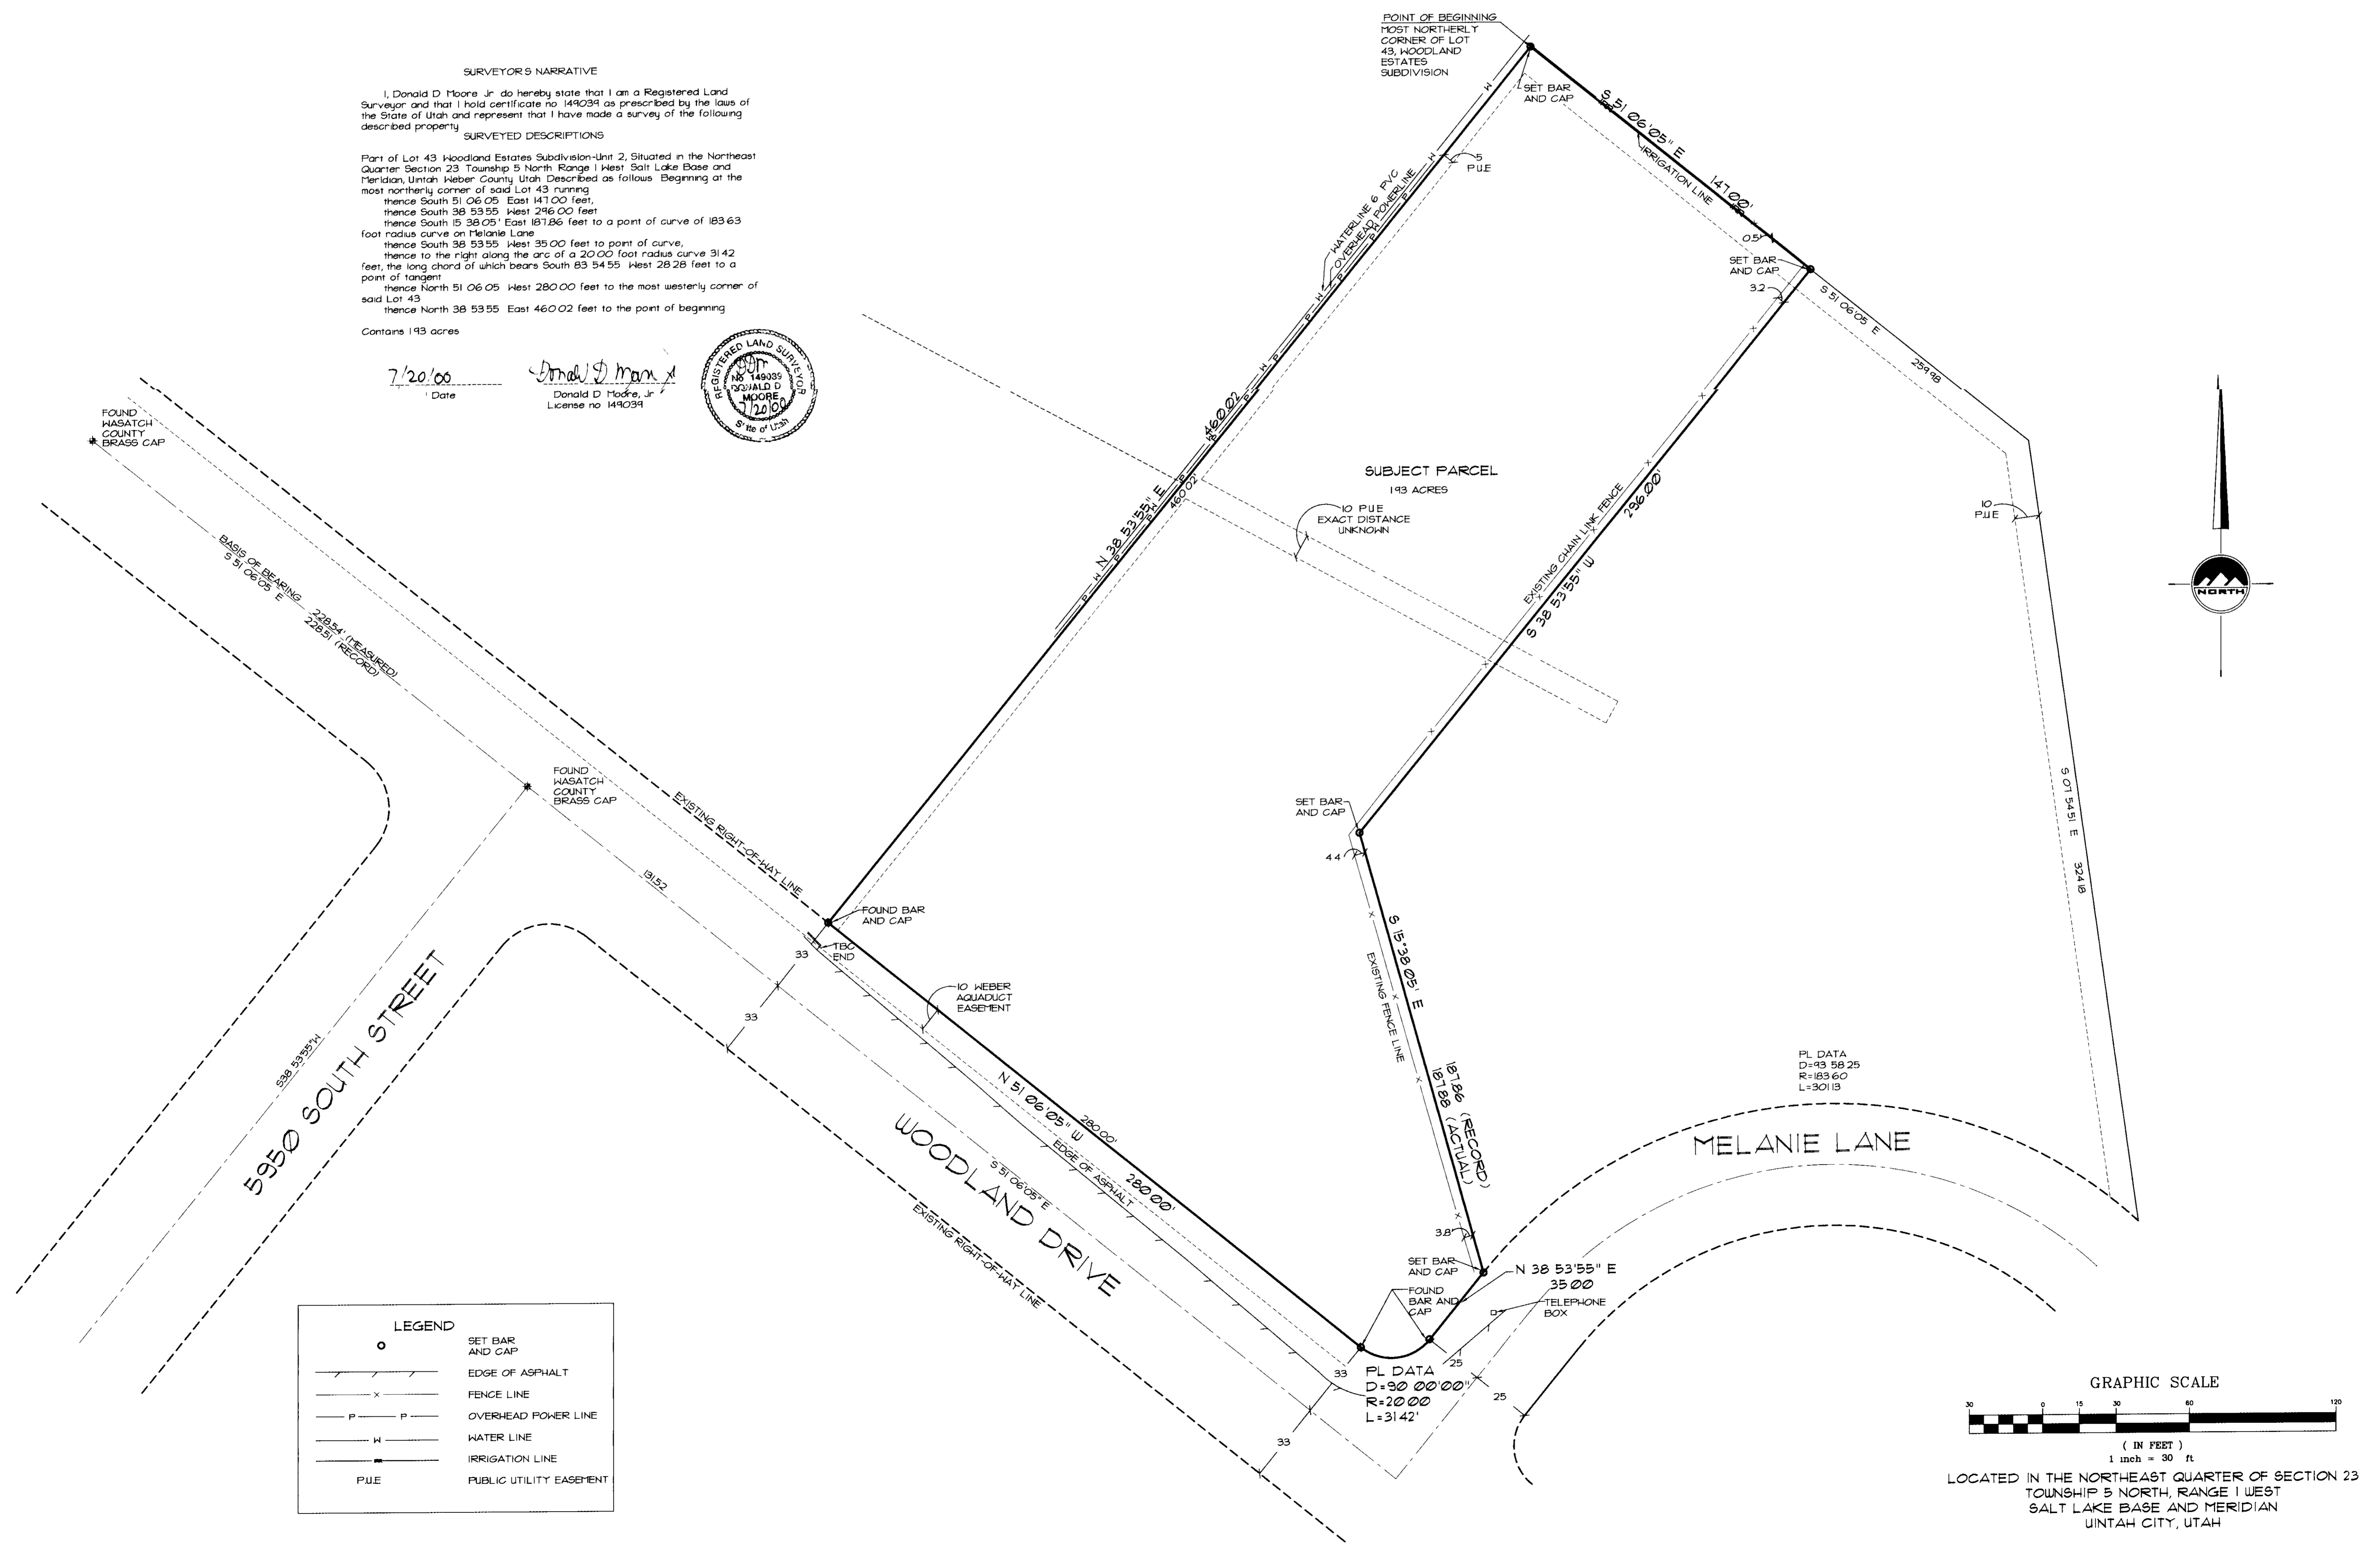


**EN S I G N**

PROJECT MANAGER DONALD MOORE drawn by L. K STAUB date 07/18/00

60 East East Utah Blvd Suite 100  
phone (801) 255-8558  
fax (801) 255-4419

NO.	REVISION	DATE	BY
1			
2			
3			
4			
5			
6			
7			
8			
9			

 

**LOT 43, WOODLAND ESTATES SUBDIVISION**  
2612 WOODLAND DRIVE  
UINTAH, UTAH  
SHERREY HALL

**BOUNDARY SURVEY**

PROJECT NAME: LOT 43, WOODLAND ESTATES SUBDIVISION

FILE: F:\PROJECT\L1099\DWG

PROJECT NO: L1099

SHEET: 1 of 1

GRAPHIC SCALE  
(IN FEET)  
1 inch = 30 ft

RECEIVED

002602

002602

002602

002602