


##2603

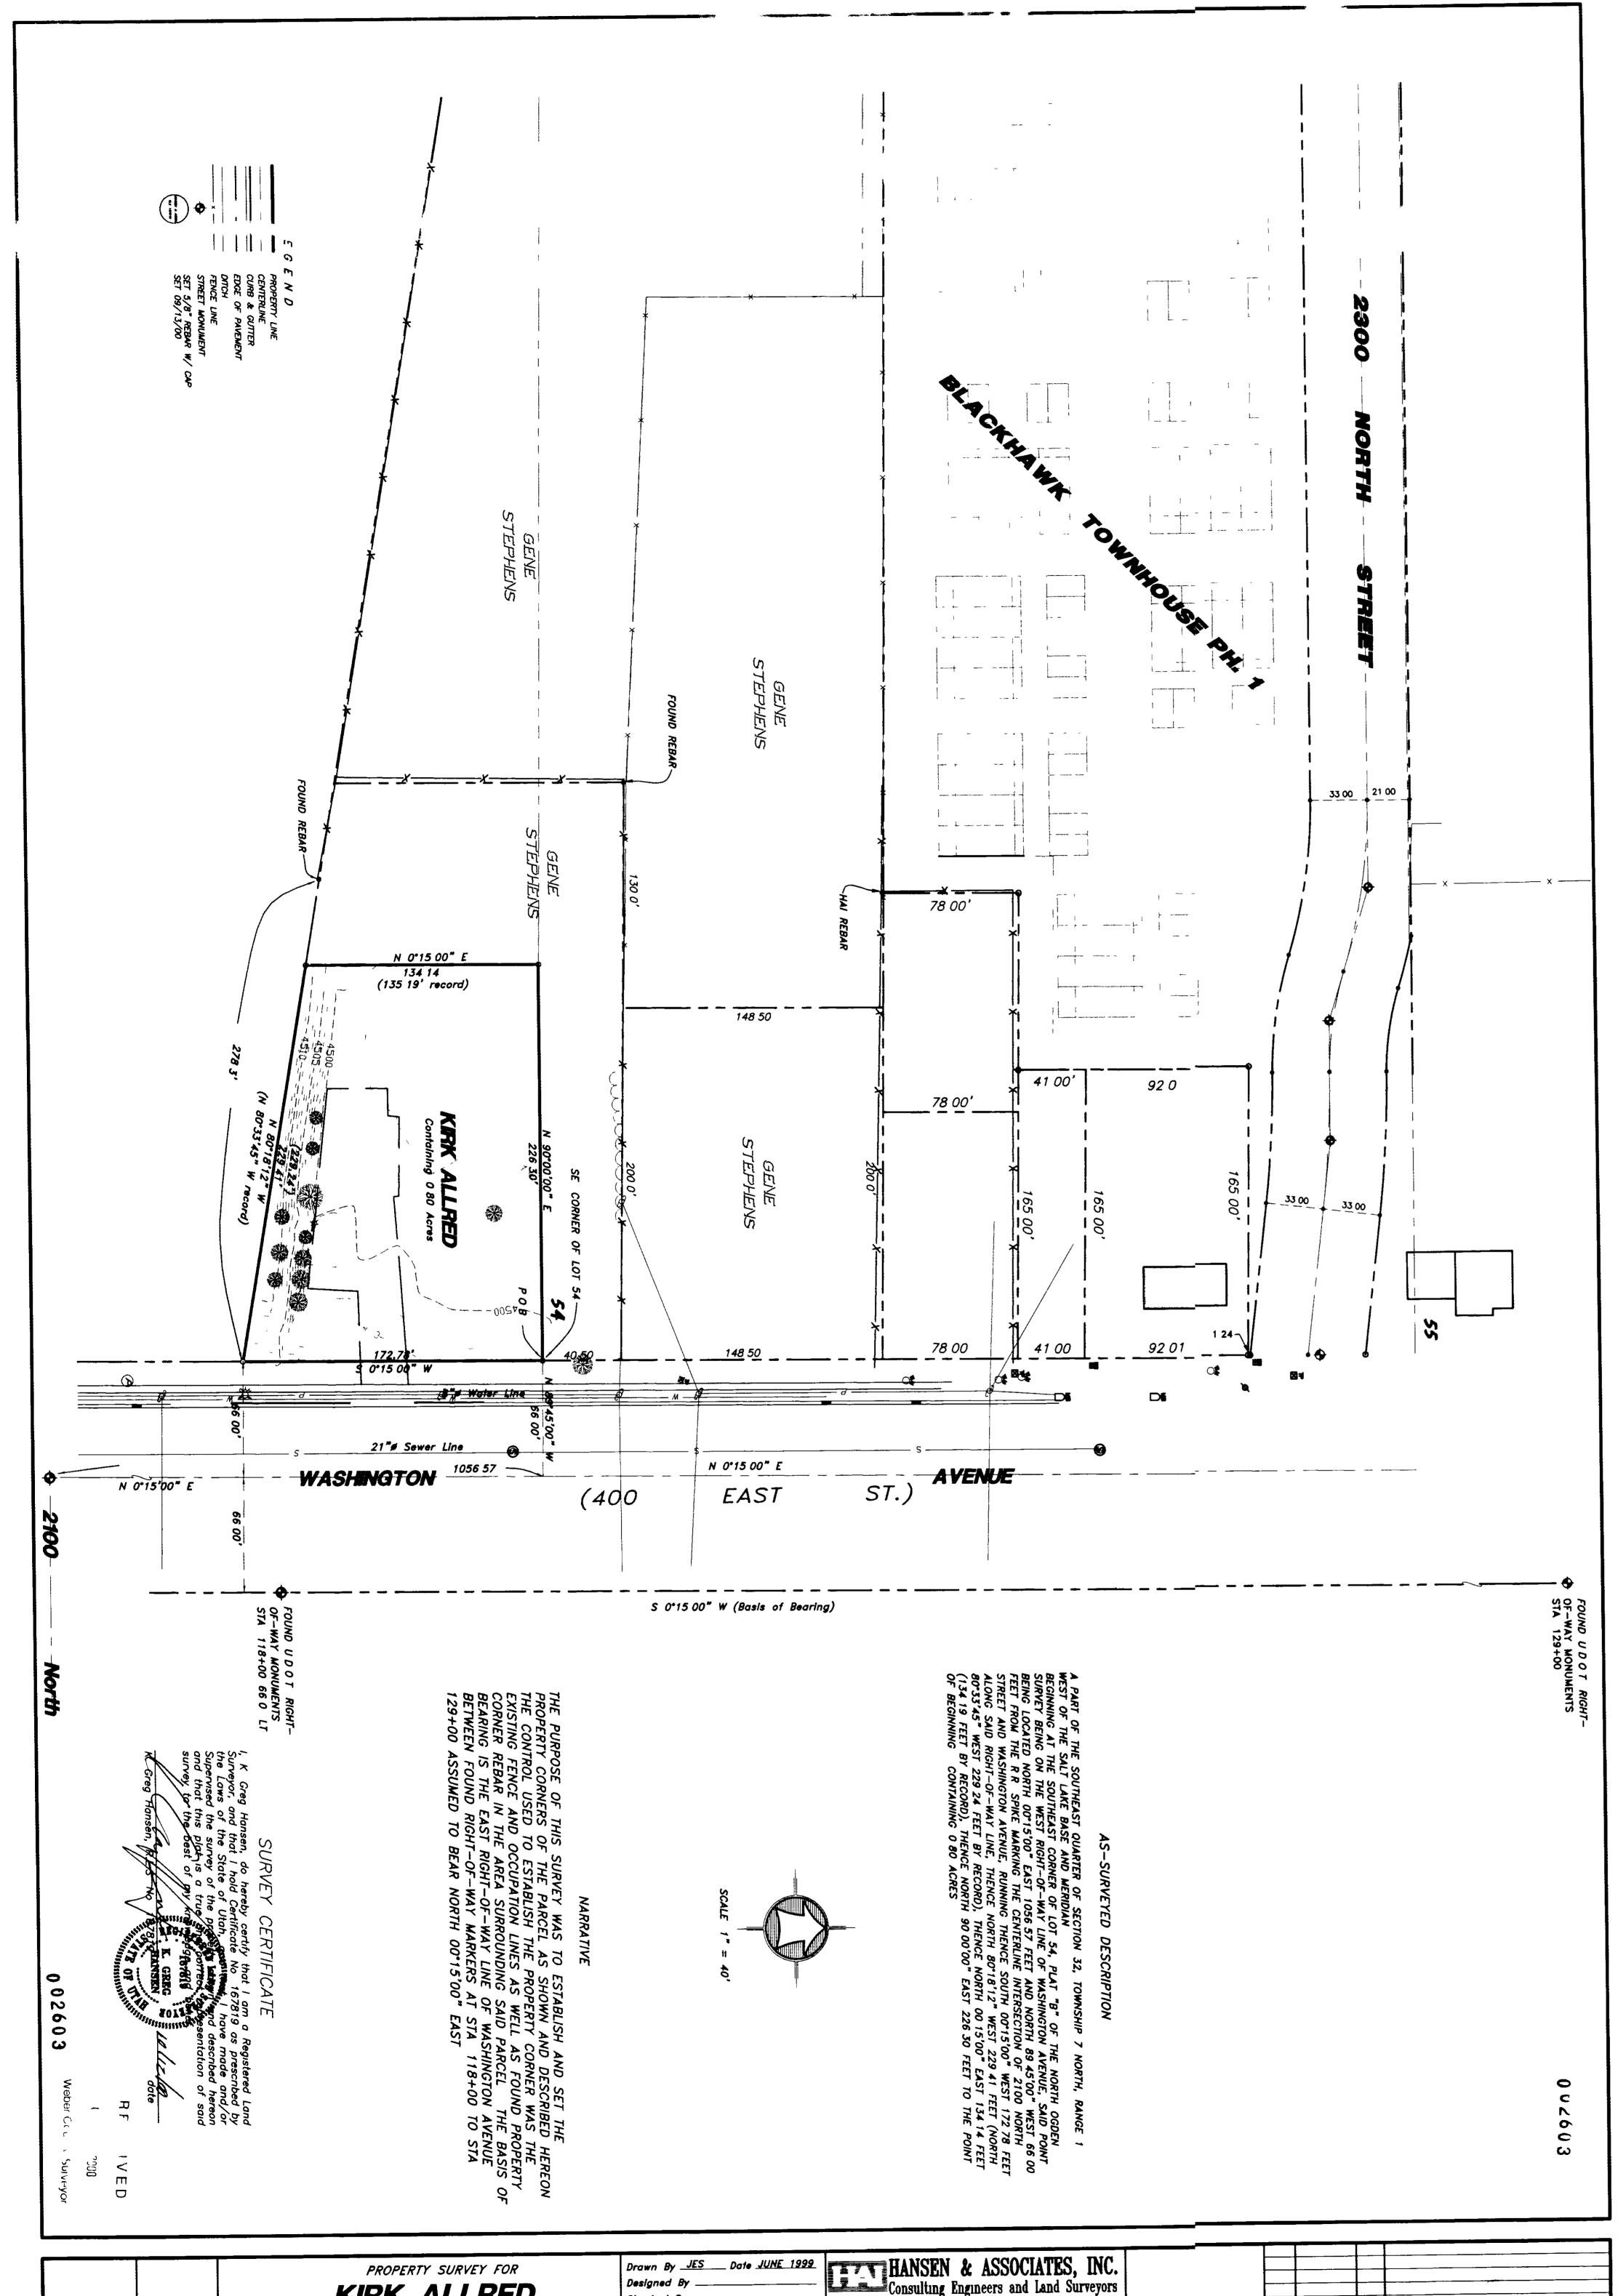

PROPERTY SURVEY FOR

KIRK ALLRED

North Ogden, Weber Co, Utah

A PART OF THE NORTHEAST QUARTER OF SECTION 32, TOWNSHIP 7 NORTH, RANGE 1 WEST, S L B & M

Drawn By JES Date JUNE 1999
Designed By Checked By Approved By Approved By Scale 1" = 40
Drawing File 99-3-96 DWG
JOB NUMBER 99-3-96


Drawn Brigham City, Utah 84302
Brigham City Ogden Logan
723-3491 399-4905 752-8272
No Date By Revision