


SURVEYOR'S CERTIFICATE

I, Larry M. Buttars, a registered Land Surveyor as prescribed by the laws of the State of Utah, and holding licence No. 2596, do hereby certify that I made a survey of the below described property and the plat hereon is a true and correct representation of said survey.

Date 7-11-89 Sign. *Larry M. Buttars*

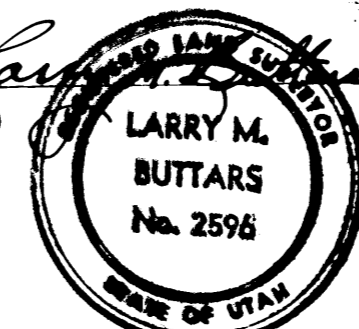

DESCRIPTION

Part of the Southeast 1/4 of Section 7, T. 7 N., R. 1 E., S. L. B. & M.: Beginning at a point N. 53° 42' W. 1005.66' ft. from the S. E. corner of said S. E. 1/4 section; and running thence North 644.6' ft. to the North line of said South 1/2 of the S. E. 1/4; thence S. 87° 41' W. 267' ft. along said line; thence S. 6° 29' E. 400.5' ft.; thence S. 50° 37' E. 277.0' ft. to the point of beginning.

NARRATIVE

Basis of bearings: from County Survey information - 1/4 Section line bearing est. by County Surveyor from a Survey for Brad Wilson.
County reference points shown were used as control for this survey.

LEGEND

- Set 1/2" x 24" re-bar with plastic cap stamped L. Buttars R.L.S. 2596
- Set P.K. nail with ribbon

BUTTARS SURVEYING 1815 26 th STREET OGDEN, UT 84401 PHONE 392-5291
CLIENT: James Bradley Johnson
SURVEY LOCATION: Sec. 7, T. 7 N., R. 1 E. S. L. B. & M. Liberty, Weber County, Utah
SURVEY DATE: 7-9-89

RECEIVED
SEP 07 1989
Weber County Surveyor