

NARRATIVE



BASIS OF BEARINGS

THE BASIS OF BEARINGS FOR THIS PLAT IS THE LINE BETWEEN THE ROUND CORNER CITY STREET MONUMENTS ALONG THE CENTERLINE OF WINCHESTER LANE, SHOWN HEREON AS S89°03'15"E.

DEED DESCRIPTION PARCEL 'A'






CURVA TABLE

NUMBER	DELTA	CHORD	TANGENT	RADIUS	LENGTH	CHORD
C1	58.29.11"	N 71.57.24" E	120.23	367.00	233.28	228.27
C2	29.14.00"	S 77.13.00" E	82.15	367.00	61.53	160.33
C3	08.07.12"	S 68.39.56" E	50.73	433.00	61.37	61.37
C4	81.01.23"	N 77.00.34" E	77.19	90.34	127.78	117.37
C5	07.38.48"	S 53.30.54" E	19.03	224.47	10.92	30.00
C6	44.48.56"	N 28.44.51" W	49.82	120.34	94.13	91.78

REVISIONS

NO.	DESCRIPTION	DATE
1		
2		
3		



REEVE & ASSOCIATES, INC.
Civil Engineering • Structural Engineering
Surveying • Land Planning • Landscape Architecture
3870 OGDEN AVENUE, SUITE #1
OGDEN, UTAH 84403
(801) 621-3100 FAX (801) 621-2866

RECORD OF SURVEY

RICHARDS PROPERTY
OGDEN, WEBER COUNTY, UTAH
SHEETS 1


SURVEYED DESCRIPTION PARCEL 'A'

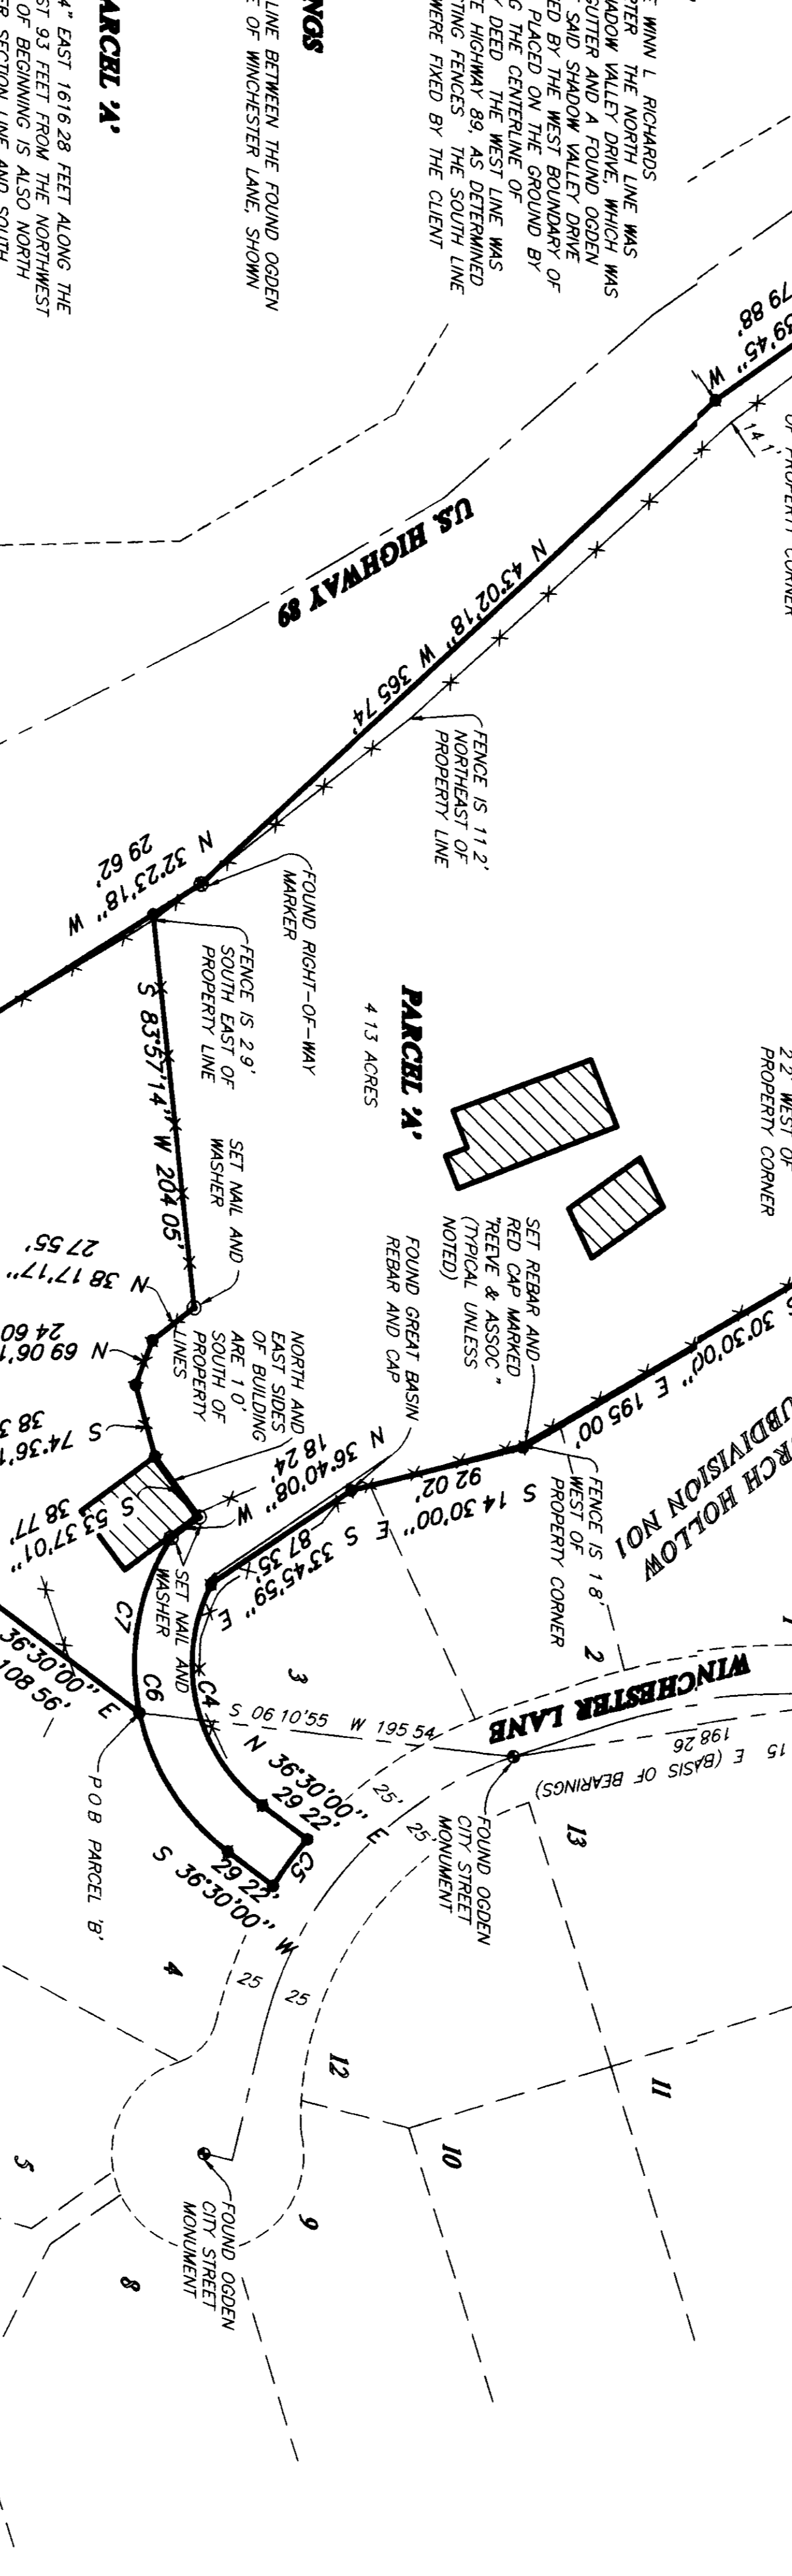

SURVEYED DESCRIPTION PARCEL 'B'

BEGINNING AT A POINT ON THE WESTERN LINE OF LOT 4, BURCH HOLLOW SUBDIVISION NO. 1, SAID POINT BEING 506.1055 W 195.54 FEET FROM THE ROUND CORNER CITY STREET MONUMENT IN THE CENTERLINE OF WINCHESTER LANE (BASIS OF BEARINGS BEING NORTH 89°49'34" WEST 1024.

LEGEND

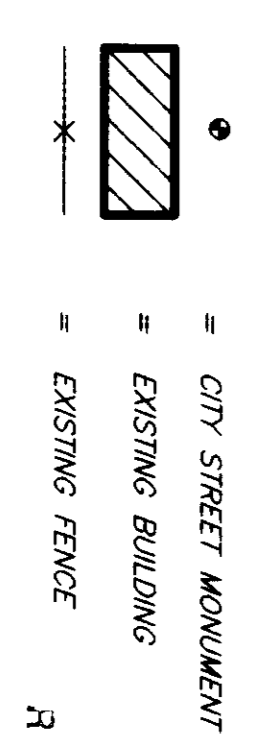

RECEIVE
DEC 07 2000
Weber County Surveyor

THESE PLANS AND SPECIFICATIONS ARE THE PROPERTY OF REEVE & ASSOC., INC. NO PART OF THESE PLANS OR SPECIFICATIONS ARE TO BE COPIED OR REPRODUCED WITHOUT THEIR WRITTEN PERMISSION.

SHEET 1

002613