

10/18/00

THIS IS TO CERTIFY THAT THIS MAP WAS MADE AND THE SURVEY WAS RUN BY ME AND MY ASSISTANTS IN ACCORDANCE WITH THE RULES AND REGULATIONS OF THE SURVEYORS' BOARD AND THE PROFESSIONAL STANDARDS AND ETHICS AS SET FORTH BY THE SURVEYORS' BOARD.

**PARCEL 1**  




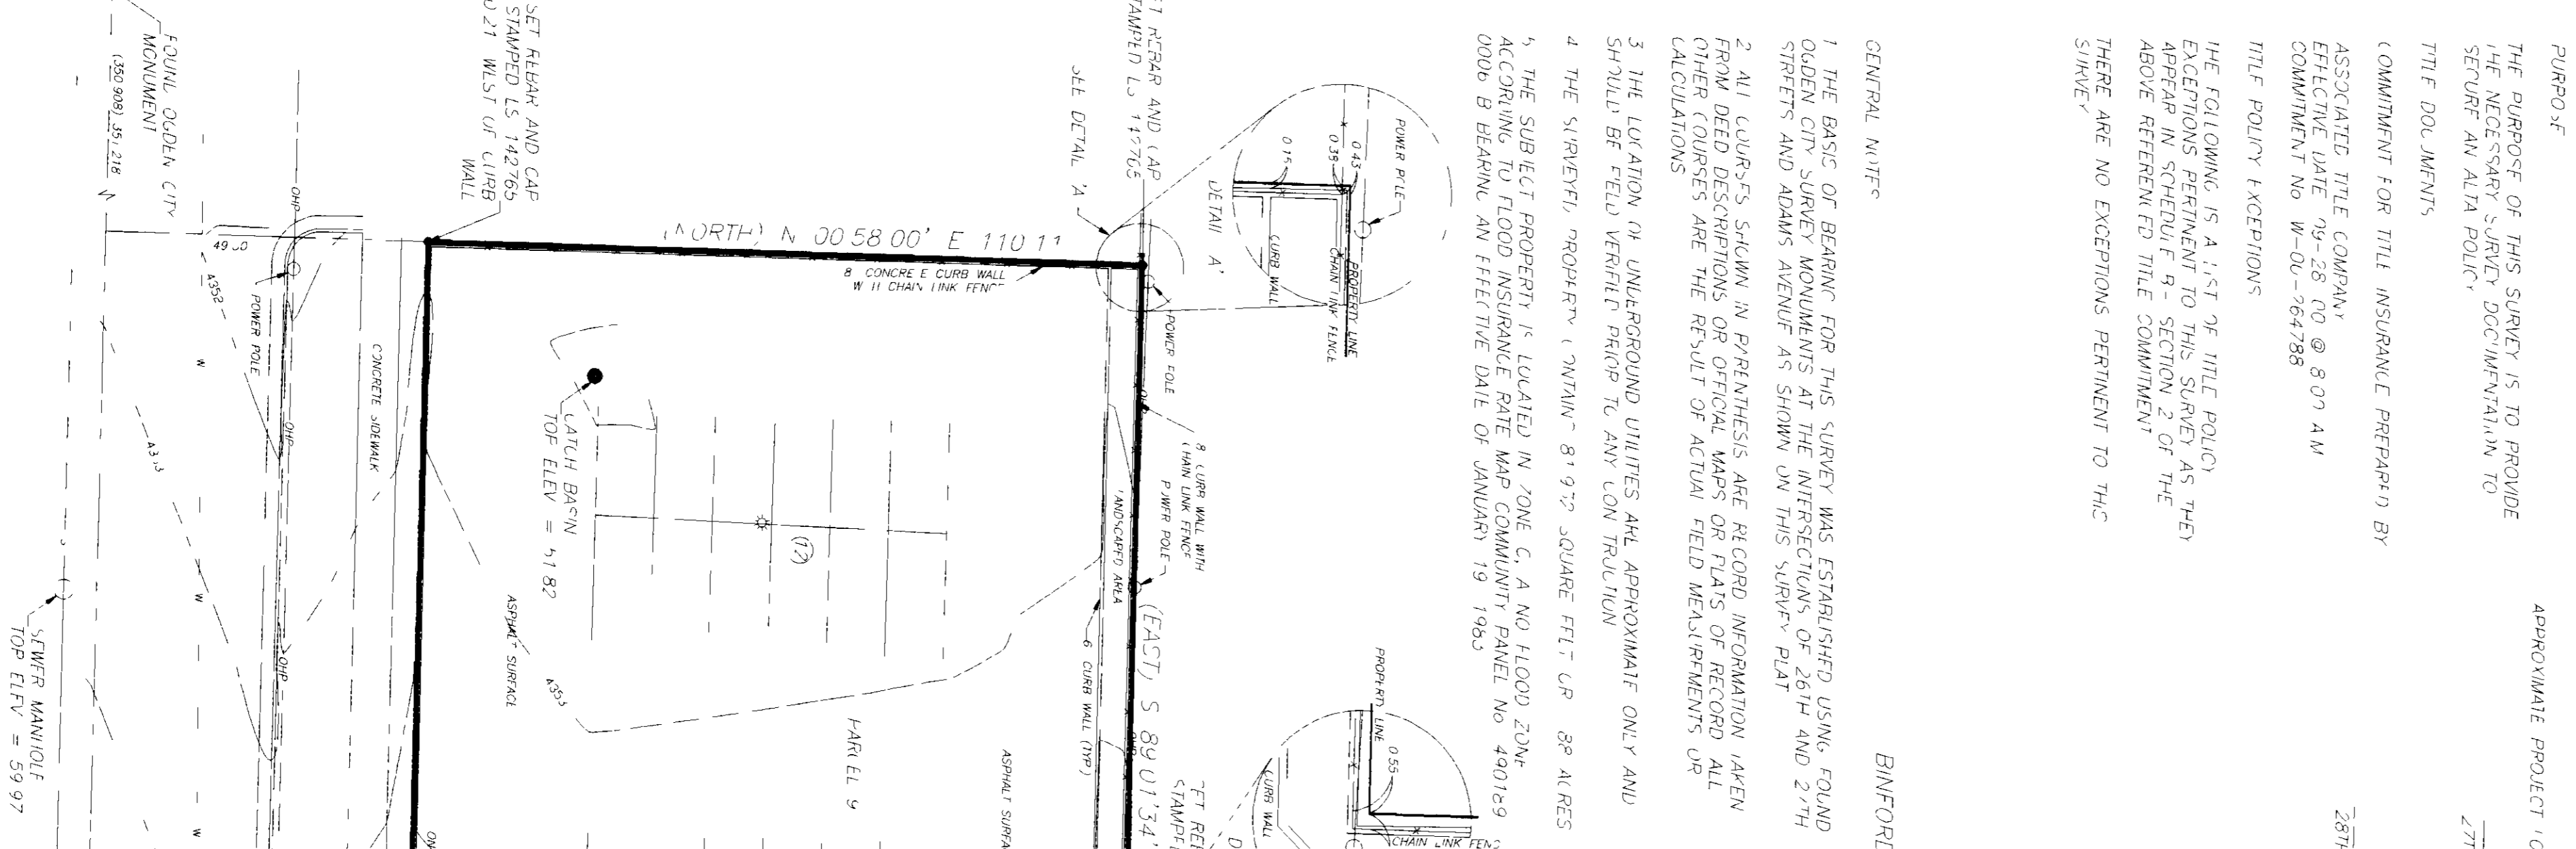

**GENERAL NOTES**  
3. THE LOCATION OF UNDERGROUND UTILITIES ARE APPROXIMATE ONLY AND SHOULD BE FIELD VERIFIED PRIOR TO ANY CONSTRUCTION.  



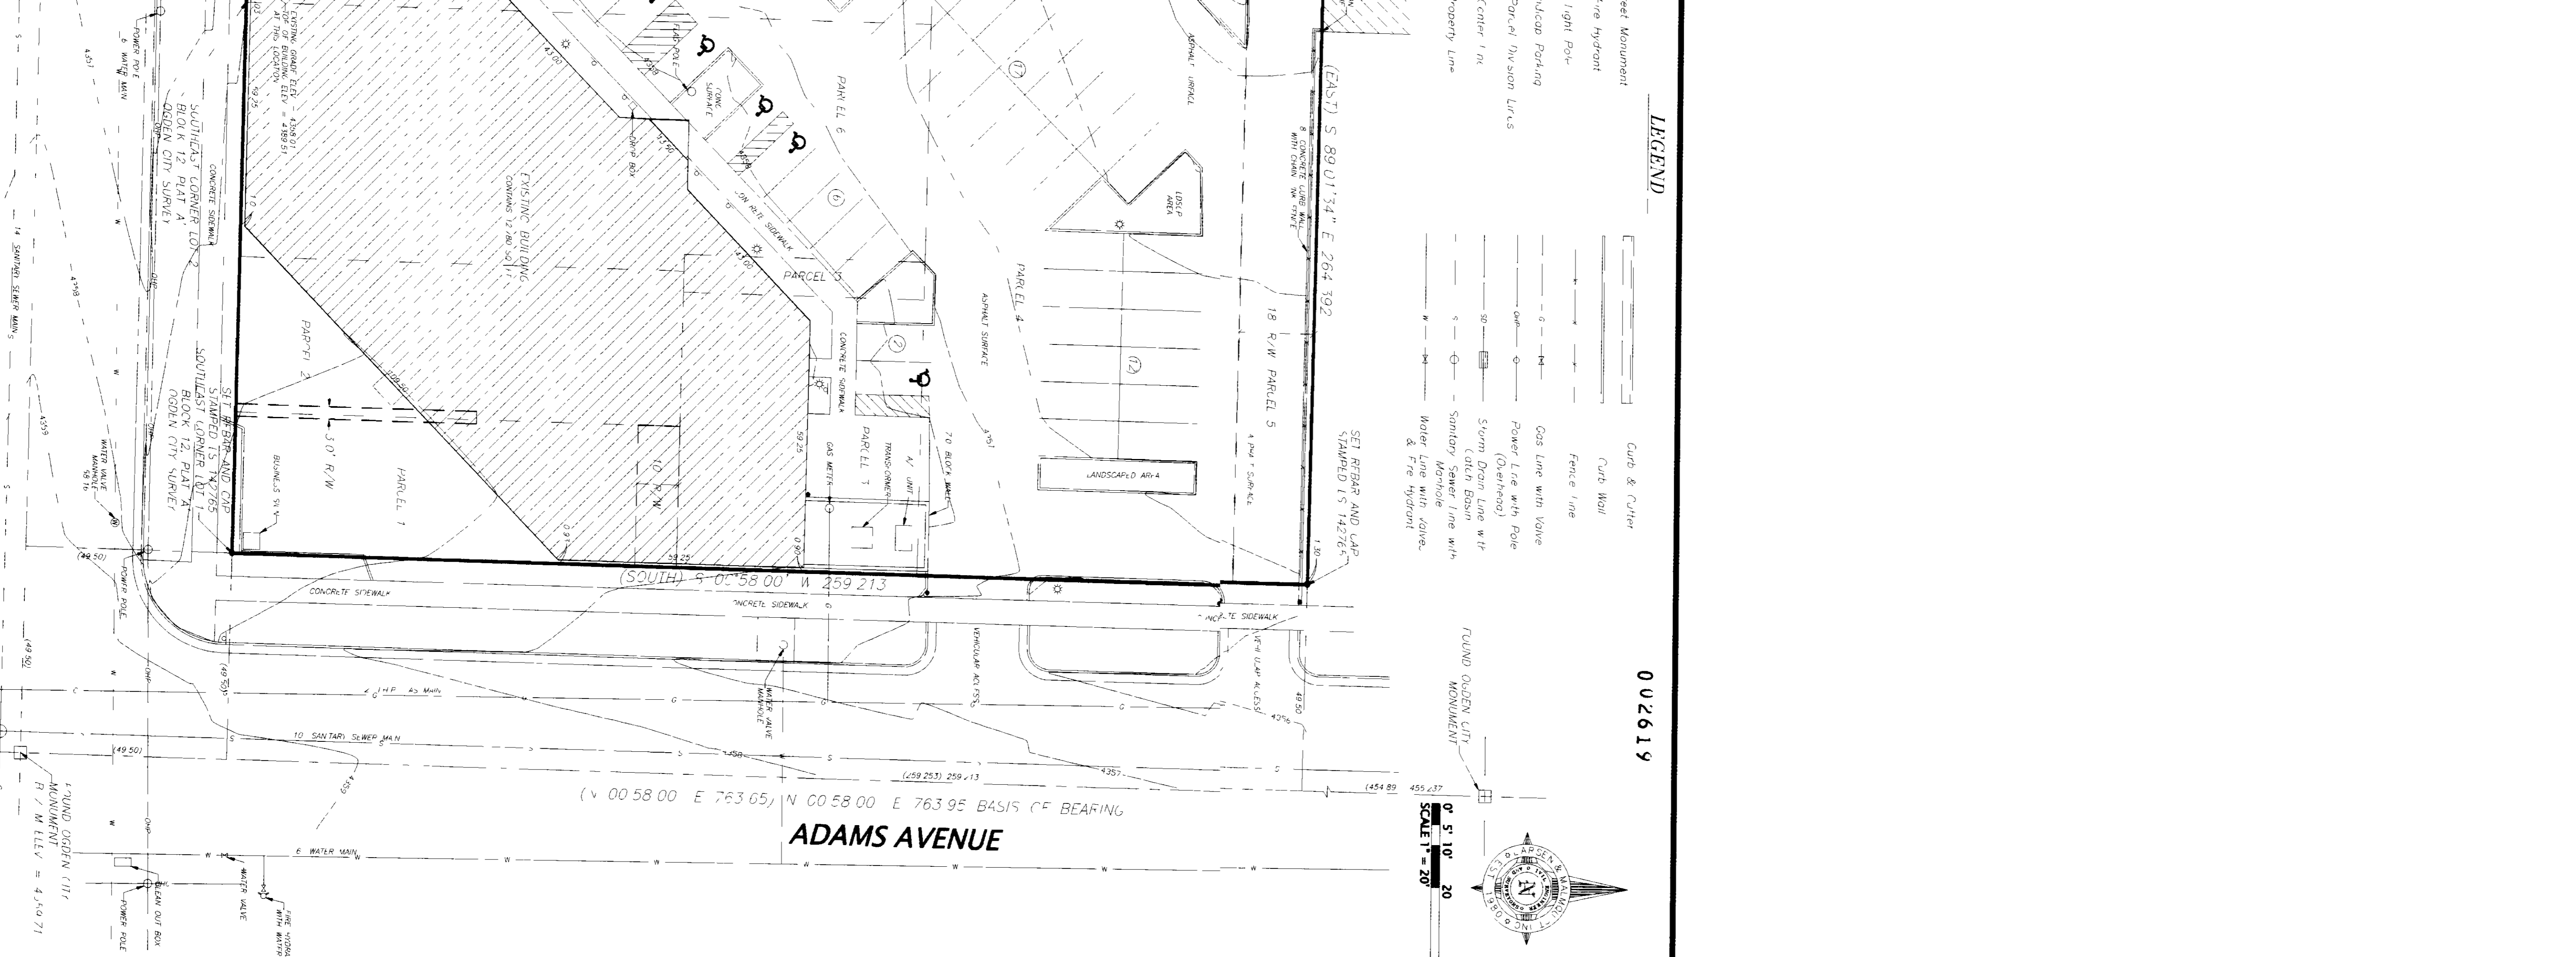

**LEGEND**


SCALE = 1" = 20'

ADAMS AVENUE

27TH STREET

RECEIVED  
DEC 18 2000  
002619  

DATE	TO	BY	SCALE	PROJECT
10/18/00	CLIENT	PROJECT	SCALE	PROJECT

**LARSEN & MALMOQUIST, INC.**  
CONSULTING ENGINEERS AND LAND SURVEYORS  
1574 WEST 1700 SOUTH  
SALT LAKE CITY, UT 84119  
PHONE (801) 487-3233 FAX (801) 972-2088

**ALTA / ACSM LAND TITLE SURVEY**  
DATE 10/18/00  
DRAWN BY  
CHECKED BY  
IN CHARGE  
PROJECT