


BOUNDARY DESCRIPTION

NORTH PARCEL
 A part of the Southwest Quarter of Section 9, Township 6 North, Range 2 West, Soil Lake Base and Meridian, U.S. Survey
 Beginning at a point 530.0 feet East from the Southwest corner of the Southwest Quarter of Section 9, Township 6 North, Range 2 West, Soil Lake Base and Meridian, U.S. Survey, thence North 2540.0 feet to the North line of the Southwest Quarter of Section 9, Township 6 North, Range 2 West, Soil Lake Base and Meridian, U.S. Survey, thence East 333.5 feet to the place of beginning.
SOUTH PARCEL
 Northernly 60 feet of Lot 2, Section 16, Township 6 North, Range 2 West, Soil Lake Meridian, U.S. Survey

NARRATIVE
 This property survey was conducted by Mr. Kenneth Hippwell for the purpose of establishing the boundaries of this property. A brass cap monument was found at the South 1/4 corner of Section 9, T6N, R2W, S16E, U.S. Survey. The monument was used as the point of beginning for the survey. The Tower on Mount O'Brien was used as the meridian for bearings. Property corners were monumented as depicted on this drawing.

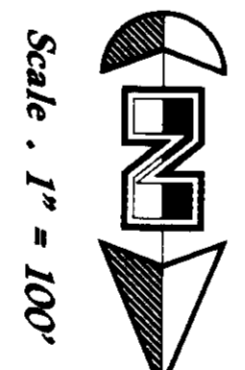

- LEGEND**
- ▲ Found Brass & Cap Monument to the NW 1/4 corner of Section 9, Township 6 North, Range 2 West, Soil Lake Meridian, U.S. Survey
 - Found Brass & Cap Monument to the SW 1/4 corner of Section 9, Township 6 North, Range 2 West, Soil Lake Meridian, U.S. Survey
 - Found Brass & Cap Monument to the SE 1/4 corner of Section 9, Township 6 North, Range 2 West, Soil Lake Meridian, U.S. Survey
 - Found Brass & Cap Monument to the NE 1/4 corner of Section 9, Township 6 North, Range 2 West, Soil Lake Meridian, U.S. Survey
 - Existing Fence

SURVEYOR'S CERTIFICATE

I, Gory L. Newton, do hereby certify that I am a Registered Land Surveyor in the State of Utah, and I have made a true and correct survey of the above described land, and I further certify that the above plot correctly shows the true dimensions of the property surveyed.

Date: 12-7-2000

Gory L. Newton
 Registered Land Surveyor
 State of Utah

Property Survey

GREAT BASIN ENGINEERING NORTH		SCALE: 1" = 100'		DATE: 29 Jun, 2000	
Kenneth Hippwell		RECEIVED		DEC 19 2000	
A part of the Southwest 1/4 of Section 9, and the Northwest 1/4 of Section 16, T6N, R2W, S16E, U.S. Survey, Weber County, Utah		DWC: NO		ONS/21V	