002624

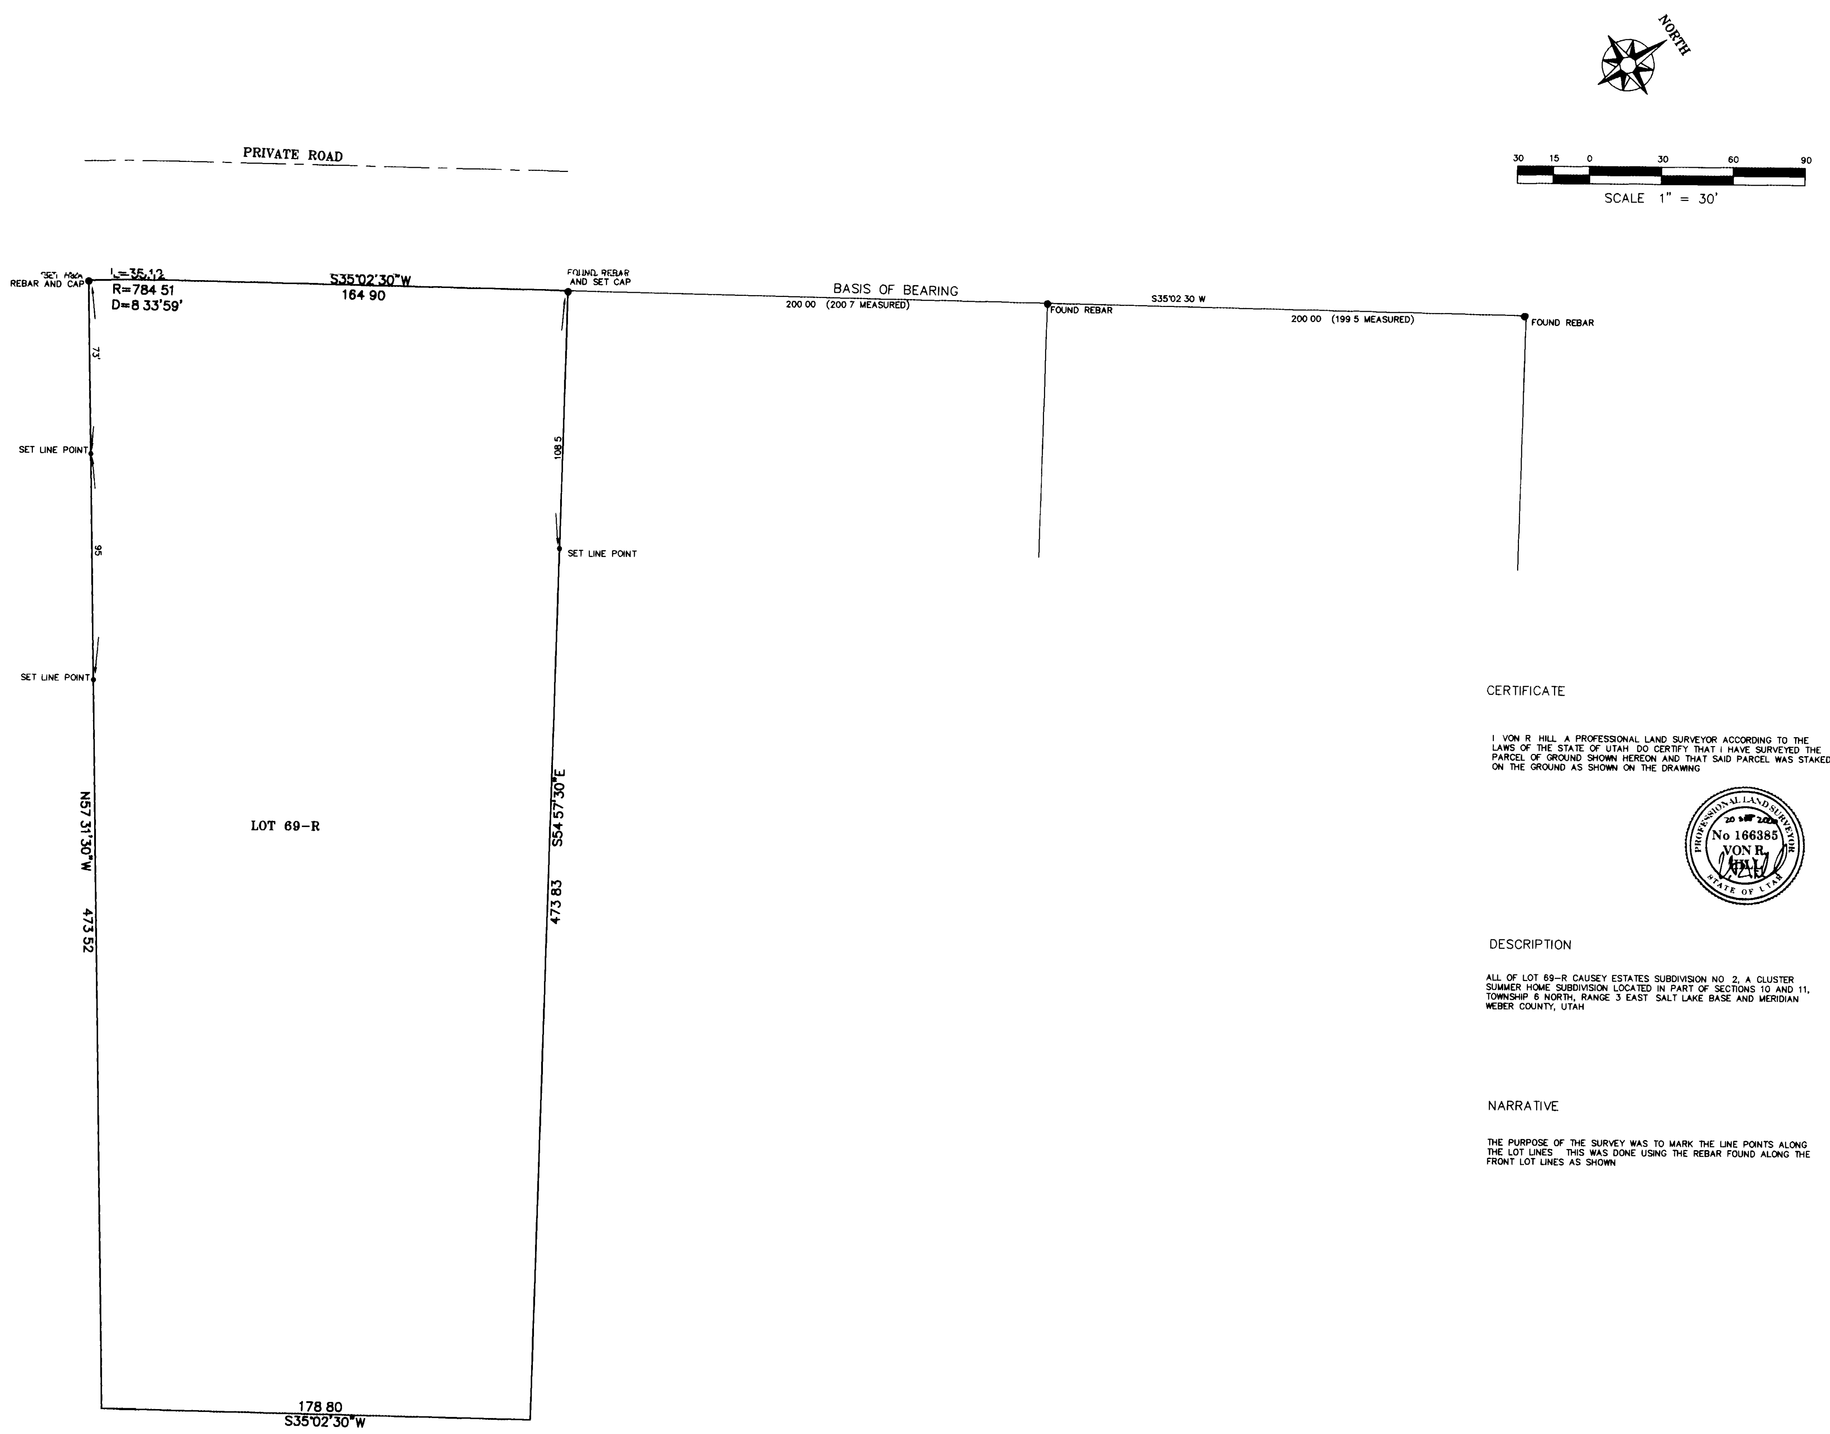

CERTIFICATE

I VON R HILL A PROFESSIONAL LAND SURVEYOR ACCORDING TO THE LAWS OF THE STATE OF UTAH DO CERTIFY THAT I HAVE SURVEYED THE PARCEL OF GROUND SHOWN HEREON AND THAT SAID PARCEL WAS STAKED ON THE GROUND AS SHOWN ON THE DRAWING

PROFESSIONAL LAND SURVEYOR 20 SEP 2000 No 166385 VON R. HILL STATE OF UTAH

DESCRIPTION

ALL OF LOT 69-R CAUSEY ESTATES SUBDIVISION NO 2, A CLUSTER SUMMER HOME SUBDIVISION LOCATED IN PART OF SECTIONS 10 AND 11, TOWNSHIP 6 NORTH, RANGE 3 EAST SALT LAKE BASE AND MERIDIAN WEBER COUNTY, UTAH

NARRATIVE

THE PURPOSE OF THE SURVEY WAS TO MARK THE LINE POINTS ALONG THE LOT LINES THIS WAS DONE USING THE REBAR FOUND ALONG THE FRONT LOT LINES AS SHOWN

RECEIVED
JAN 09 2001
Weber County Surveyor
002624

HILL & ARGYLE, Inc.
Engineering and Surveying
181 North 200 West Suite #4 Bountiful Utah 84010
(801) 298-2236 Phone (801) 298-5953 Fax

SURVEY REQUESTED BY:
PHIL SQUIRES

LOT 69-R CAUSEY ESTATES SUBDIVISION # 2
LOCATED IN THE NE 1/4 OF SEC 10 AND THE NW 1/4 OF SEC 11 T6N R3E SLB&M
WEBER COUNTY UTAH

DRAWN HG	DATE 9/11/00	
APPROVED VGH	DATE 9/11/00	
REVISED	DATE	

SHEET
OF

DRAWING NAME
SURVEY DWG

FILE NO
99-211

002624
002624
002624
002624