
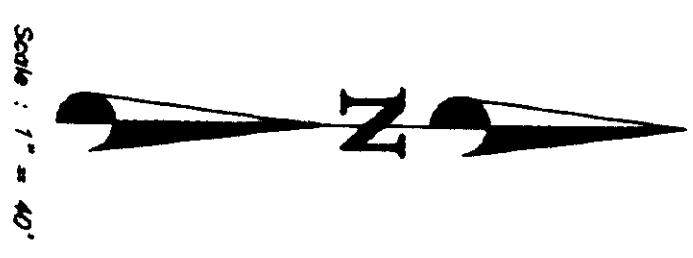


CERTIFICATION OF SURVEY PLAT

002632

Northern Quarter of NE 1/4 of Section 31,
Township 7 North, Range 1 West,

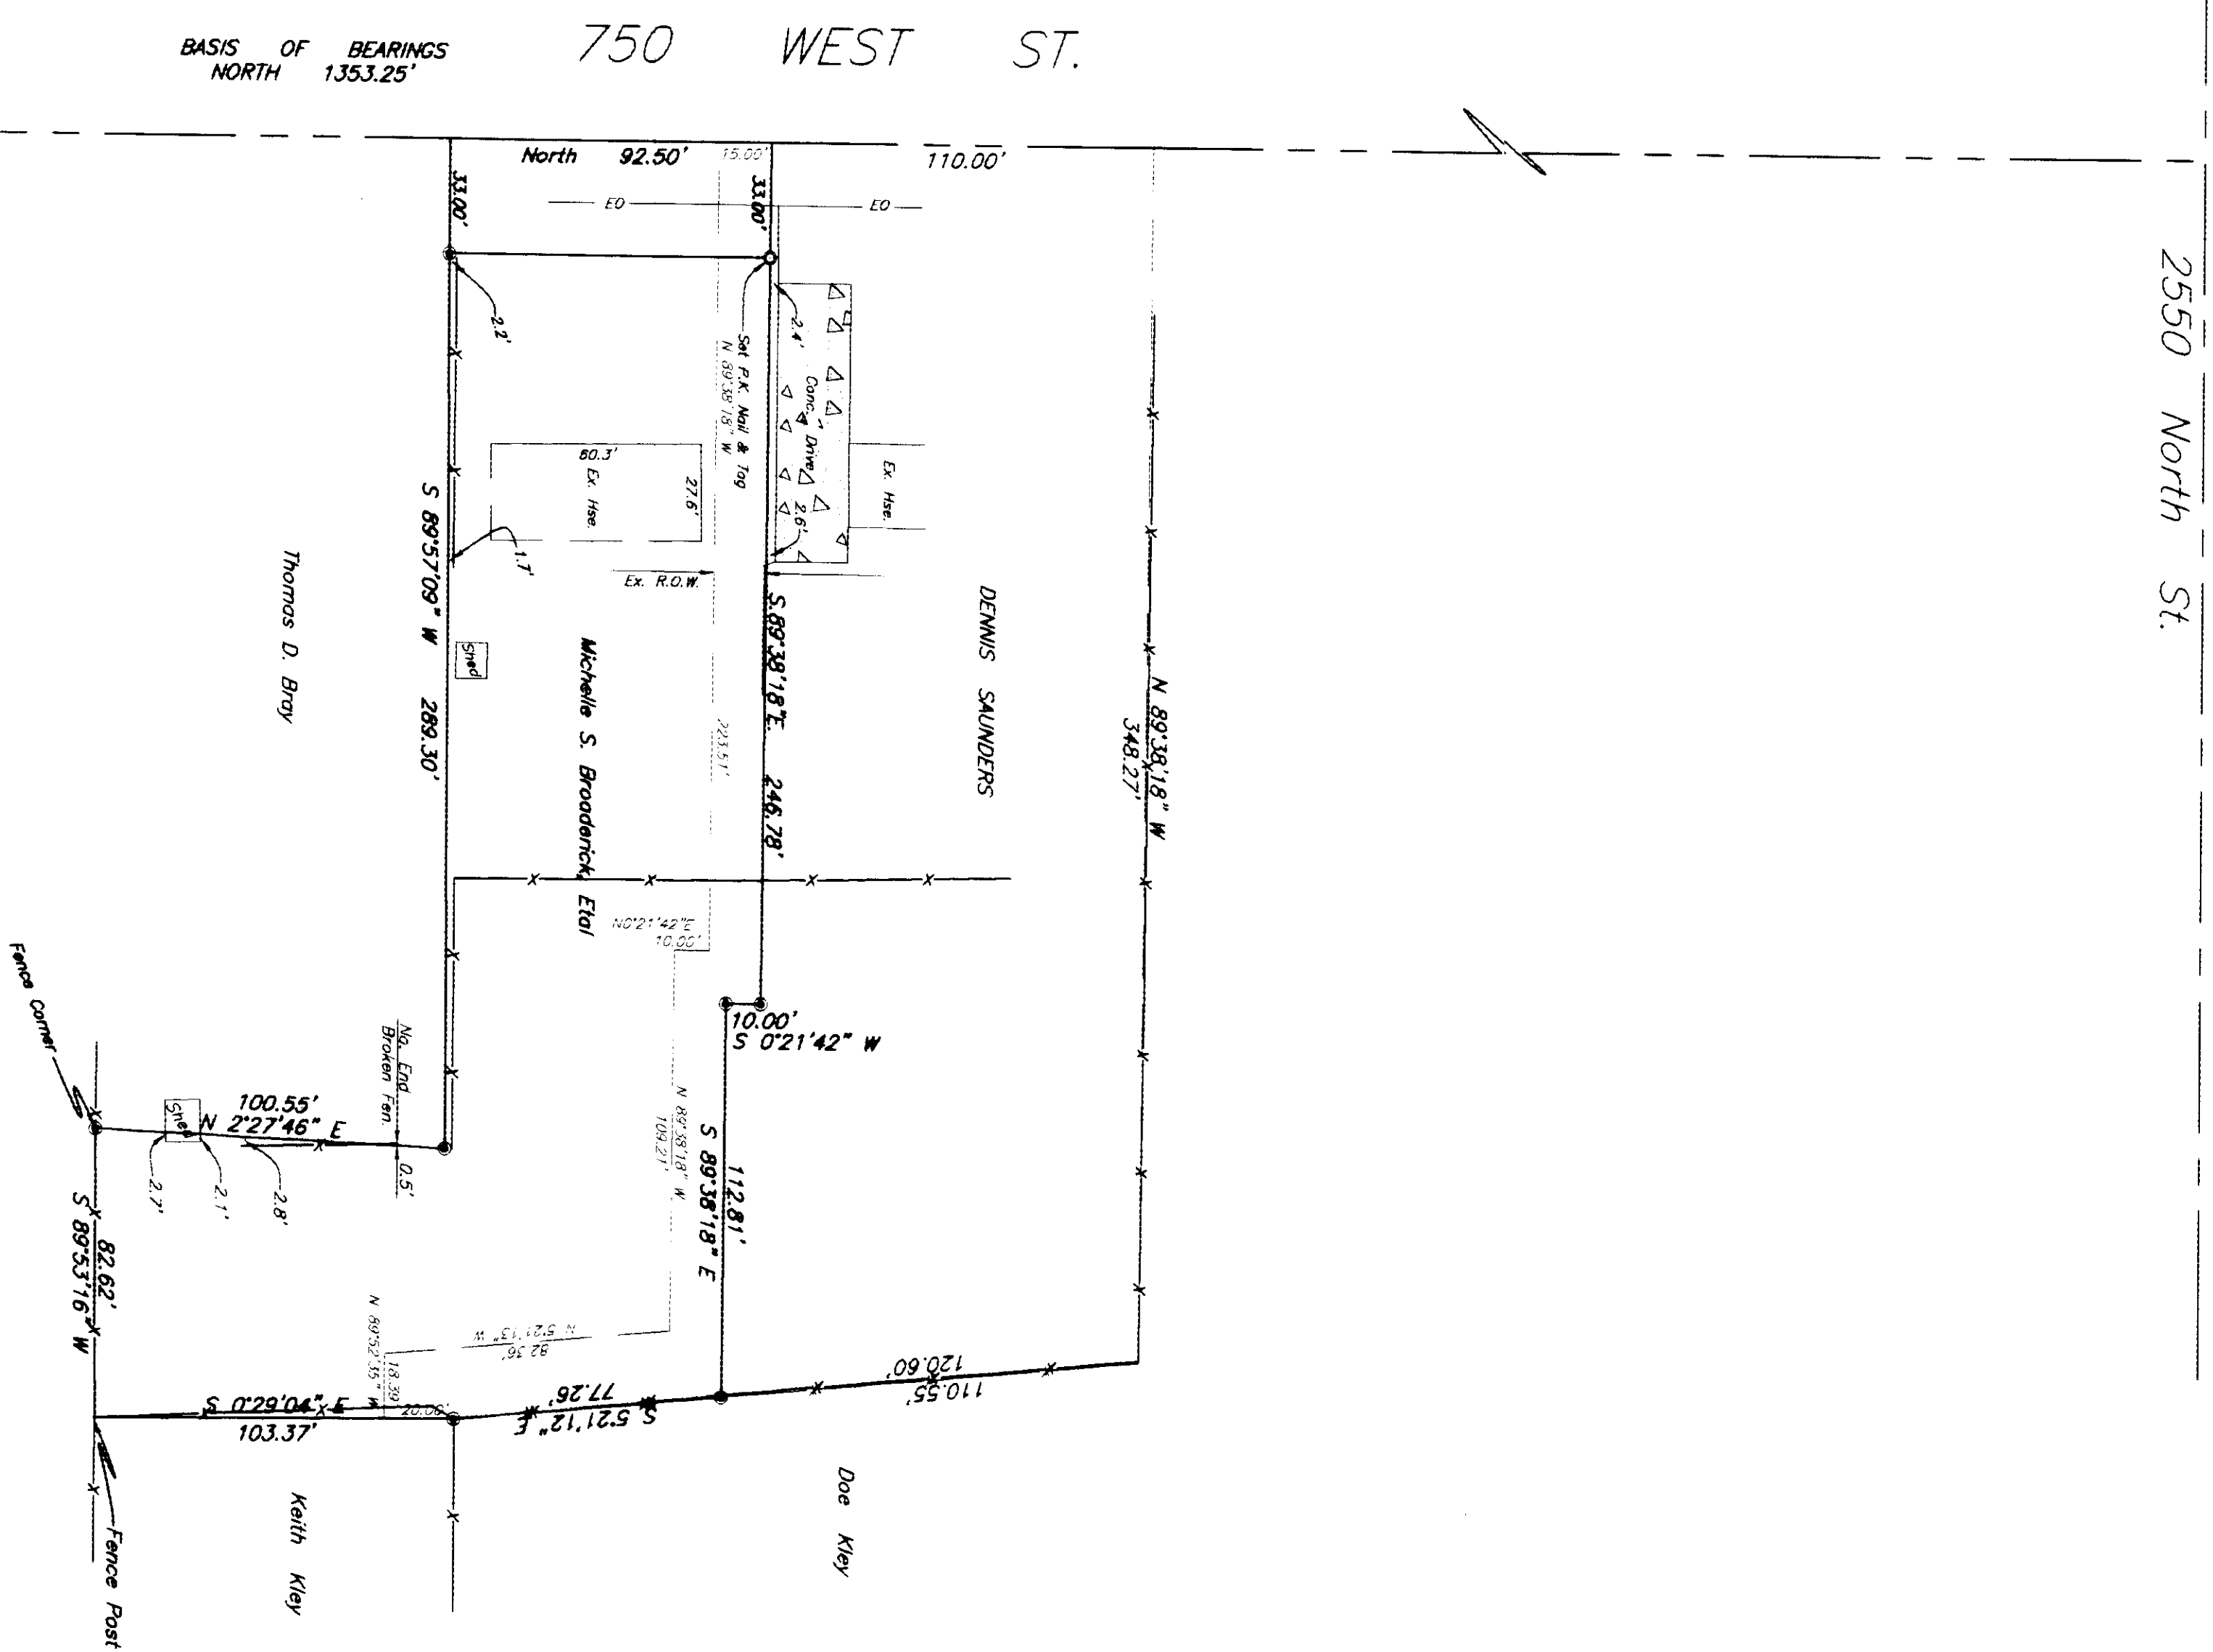

LEGAL DESCRIPTION








LEGEND:

- () DISTANCE AND OR BEARING PER DEED OR PLAT.
- NO PARALLELS IS MEASURED DISTANCE OR ROTATED PLAT.
- EXISTING FENCES.
- SET 3/4" WEAVER, C. & L.S. CAP.
- SET P.K. NAIL & TAG.

BASIS OF BEARINGS

750 WEST ST.

2550 North St.

CONSTRUCTION & LAND SURVEYORS
810 CANYON ROAD
OKMUR, UTAH 84404 FAX (801) 627-1088

RECEIVED
JUN 09 2001

CLIENT: Michelle Broadrick	CONSTRUCTION & LAND SURVEYORS 810 CANYON ROAD OKMUR, UTAH 84404 (801) 399-4335
SURVEY DATE: 5/18/2000	JOB No. P500-23