


002664

SURVEYOR'S CERTIFICATE


SIGNED THIS 12TH DAY OF FEBRUARY 2001.

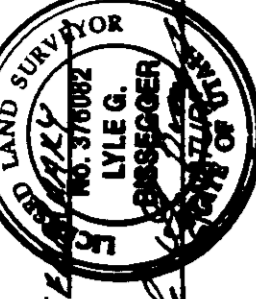




BASIS OF BEARINGS


THE BASIS OF BEARINGS FOR THIS PLAT IS THE CENTERLINE OF 575 EAST STREET AS DETERMINED FROM A SPLIT OF THE EXISTING CURB AND GUTTER SHOWN HEREON AS: S00°50'00"W.

NARRATIVE

THE PURPOSE OF THIS SURVEY IS TO DEFINE THE BOUNDARY OF LOT 48, JILLVILLE SUBDIVISION NO. 1, FOR DEAN ALLRED. THE SURVEY ALSO SHOWS THE LOCATION OF THE CURB AND GUTTER IMPROVEMENTS IN 575 EAST STREET AND THE FOUND PLUGS IN SAID SUBDIVISION.

SURVEYED DESCRIPTION

PART OF THE SOUTHWEST QUARTER OF SECTION 33, T.7N., R.1W., S.L.B. &M., U.S. SURVEY, DESCRIBED AS FOLLOWS:
ALL OF LOT 48, JILLVILLE SUBDIVISION NO. 1, NORTH OGDEN CITY, WEBER COUNTY, UTAH.

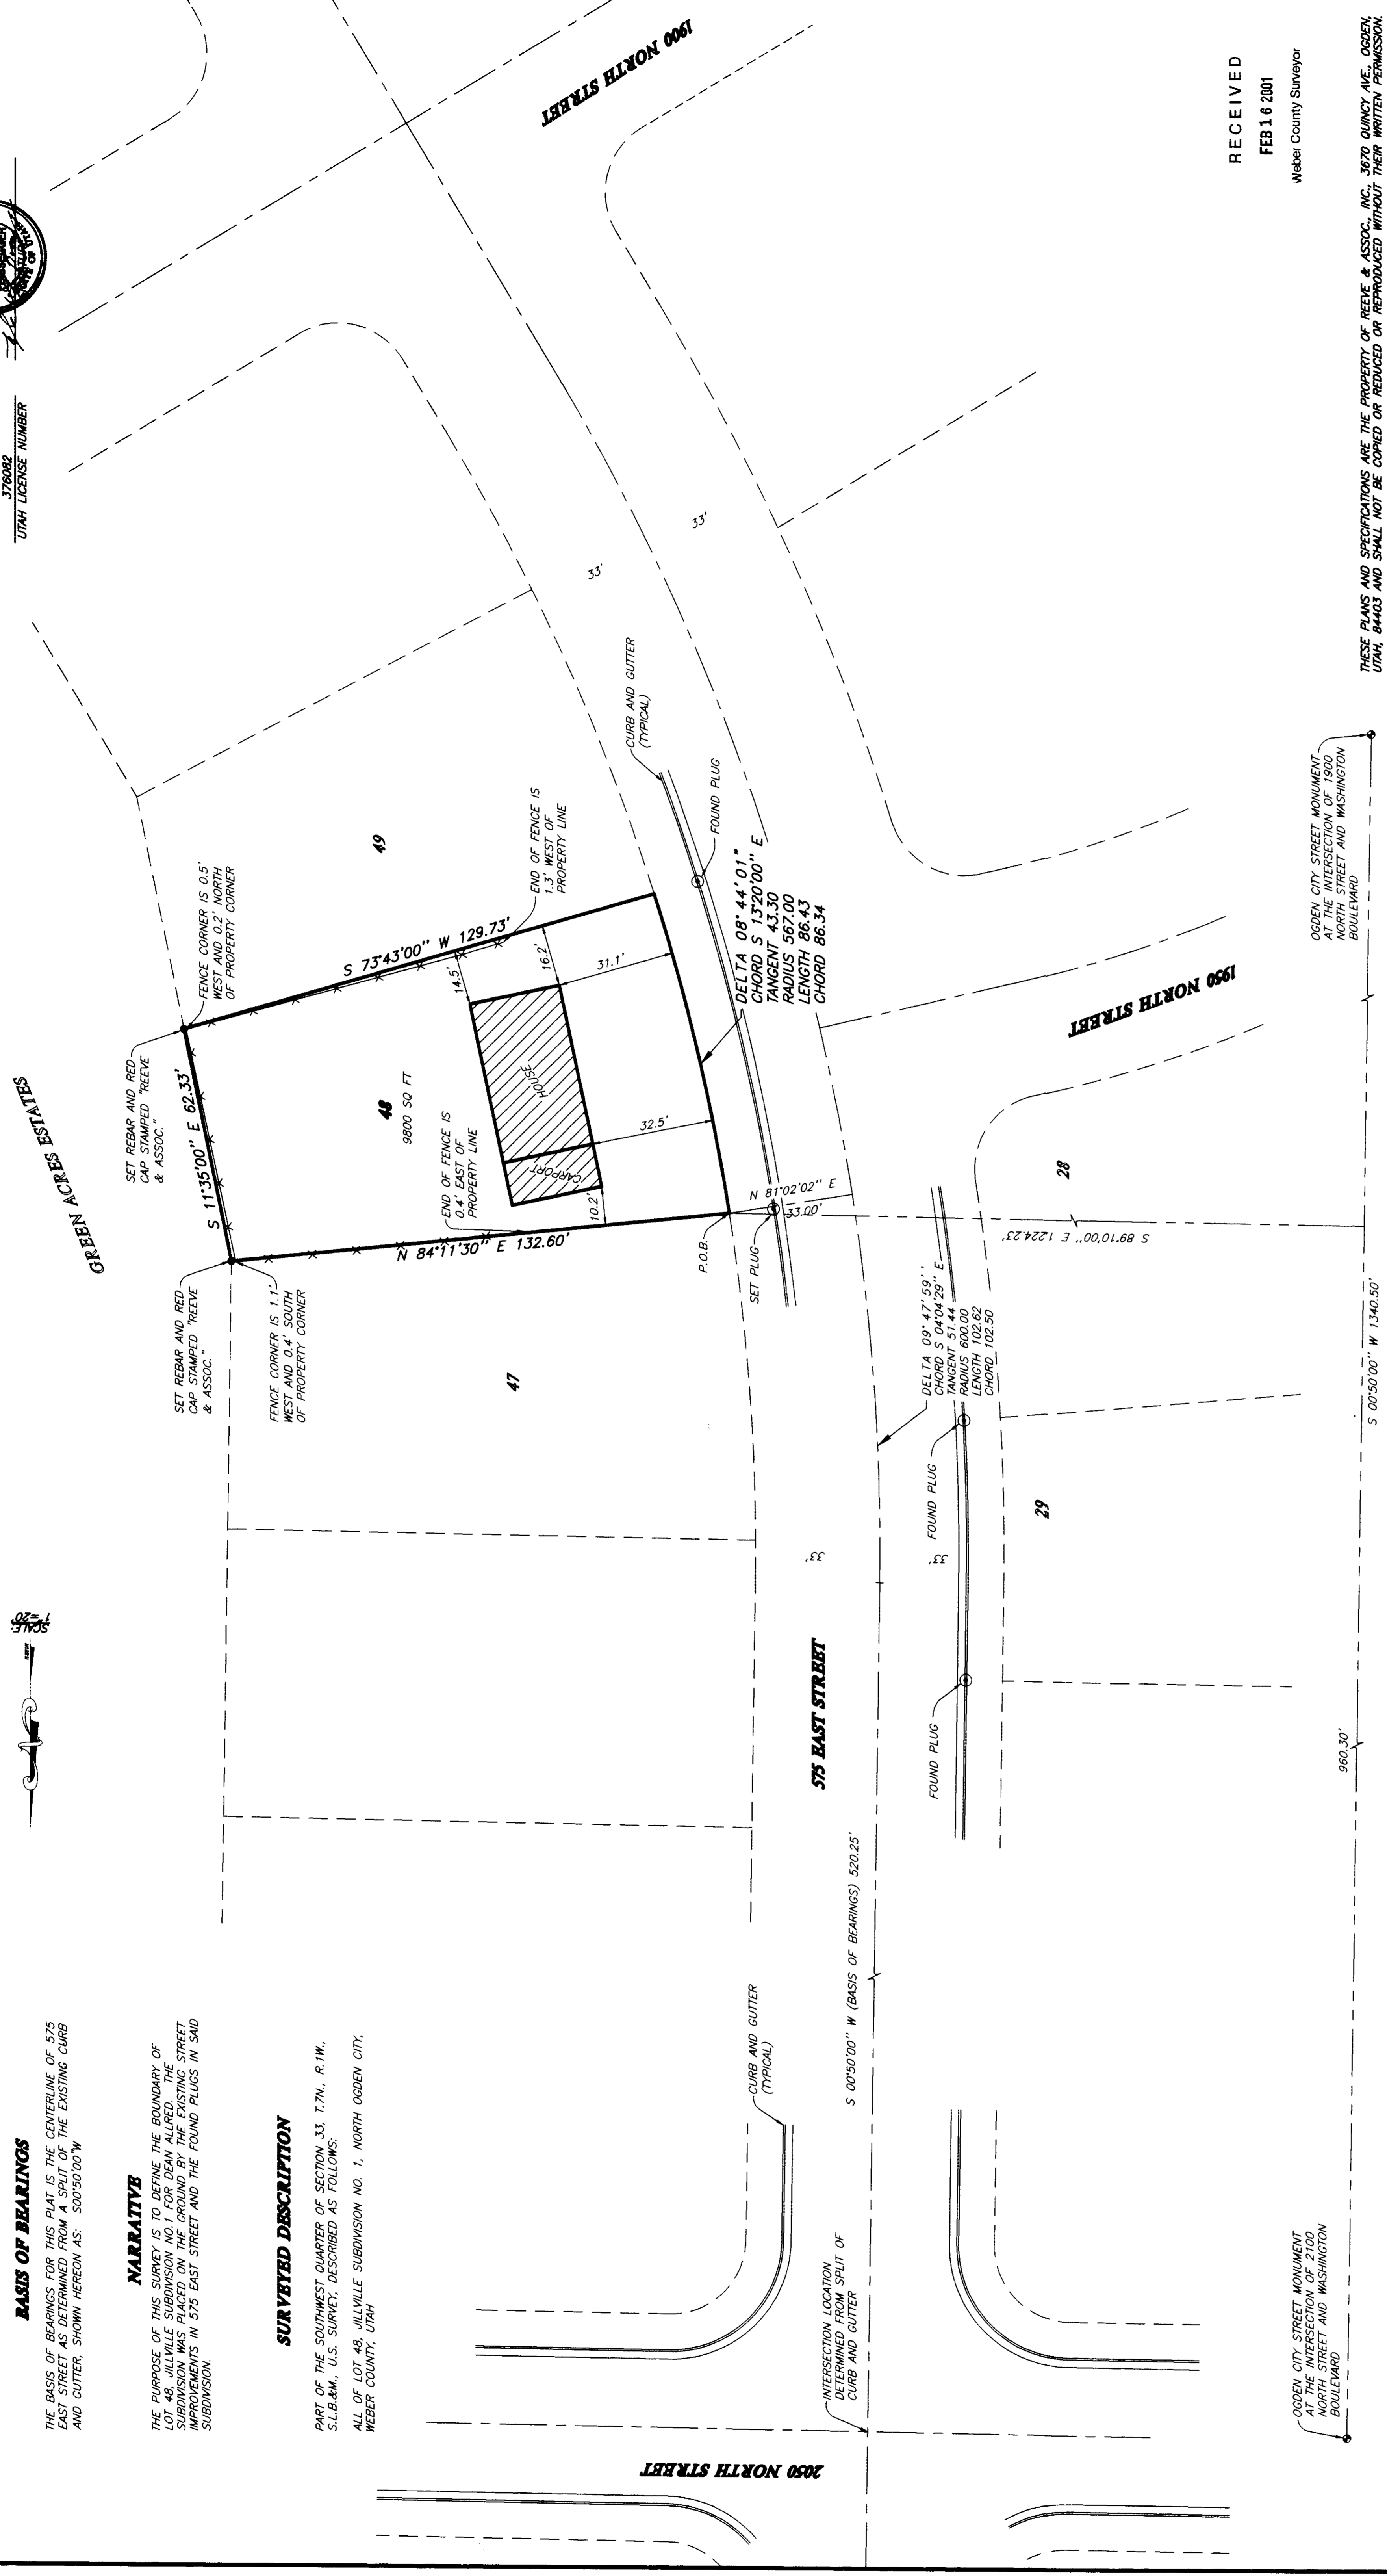

OGDEN CITY STREET MONUMENT
LOCATED AT THE INTERSECTION OF
NORTH STREET AND WASHINGTON
BOULEVARD

RECEIVED
FEB 16 2001
Weber County Surveyor


SHEET 1

LOT 48, JILLVILLE SUBDIVISION NO. 1
PART OF THE SOUTHWEST QUARTER OF SECTION 33, T.7N., R.1W., S.L.B. &M., U.S. SURVEY
WEBER COUNTY, UTAH

RECORD OF SURVEY

REEVE & ASSOCIATES, INC.
Civil Engineering • Structural Engineering
Surveying • Land Planning • Landscape Architecture


REVISIONS
1. _____
2. _____
3. _____
4. _____
5. _____
6. _____

002664




