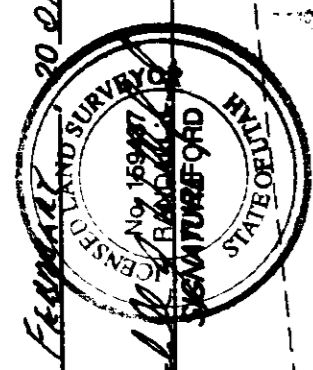
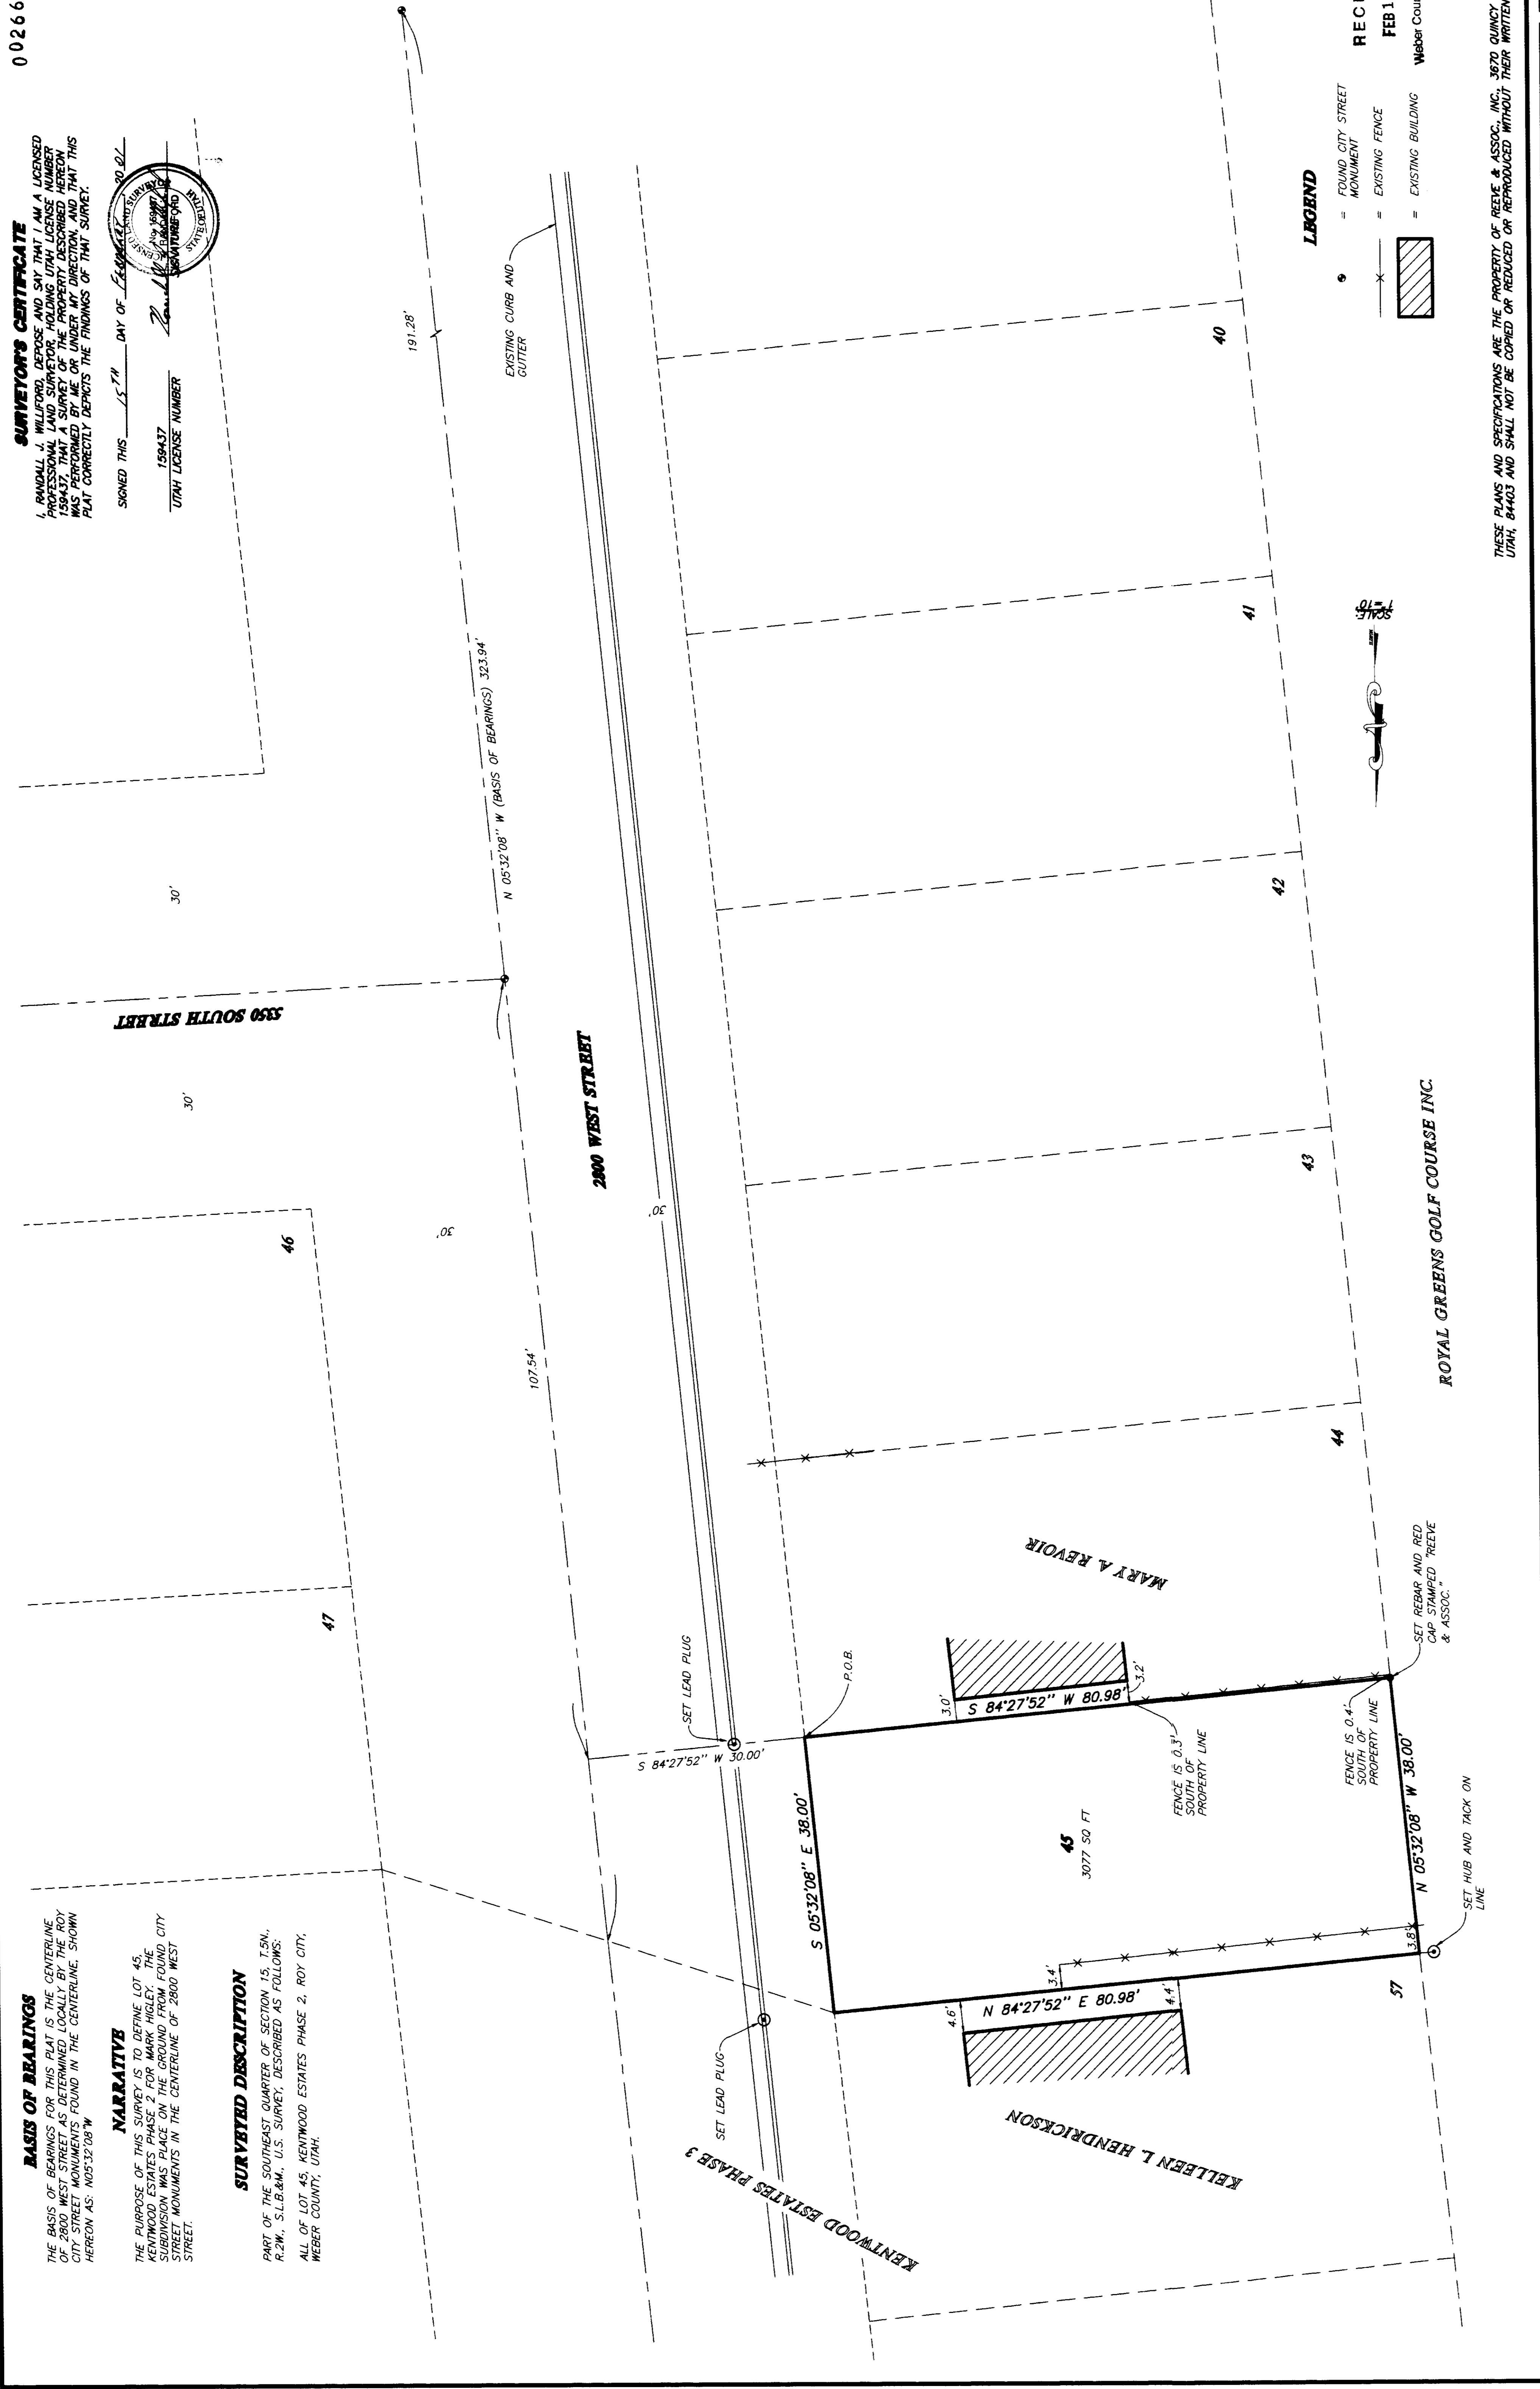


SURVEYOR'S CERTIFICATE

 159437
 UTAH LICENSE NUMBER
 RANDALL J. WILLIFORD
 SURVEYOR


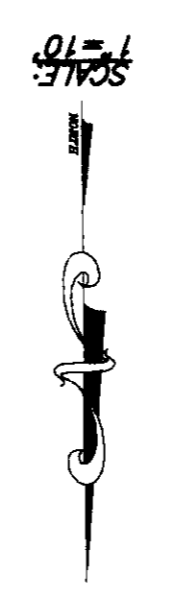


BASIS OF BEARINGS

NARRATIVE

SURVEYED DESCRIPTION
 PART OF THE SOUTHEAST QUARTER OF SECTION 15, T.5N., R.2W., S.L.B.4M., U.S. SURVEY, DESCRIBED AS FOLLOWS:
 ALL OF LOT 45, KENTWOOD ESTATES PHASE 2, ROY CITY, WEBER COUNTY, UTAH.

LEGEND
 ○ FOUND CITY STREET MONUMENT
 ——— EXISTING FENCE
 ▨ EXISTING BUILDING



THESE PLANS AND SPECIFICATIONS ARE THE PROPERTY OF REEVE & ASSOCIATES, INC. NO PART HEREOF SHALL BE COPIED OR REPRODUCED WITHOUT THEIR WRITTEN PERMISSION.
 UTAH, 84403 AND SHALL NOT BE COPIED OR REPRODUCED WITHOUT THEIR WRITTEN PERMISSION.
 WEBER COUNTY, UTAH

SHEET 1 OF 1 SHEETS

RECORD OF SURVEY
LOT 45, KENTWOOD ESTATES PHASE 2
 PART OF THE SOUTHEAST QUARTER OF SECTION 15, T.5N., R.2W., S.L.B.4M., U.S. SURVEY
 ROY CITY, WEBER COUNTY, UTAH
 FEB 16 2008
 RECEIVED
 FEB 16 2008
 WEBER COUNTY, UTAH

RECORD OF SURVEY

REEVE & ASSOCIATES, INC.
 CIVIL ENGINEERING
 SURVEYING & LAND PLANNING * LANDSCAPE ARCHITECTURE
 OGDEN, UTAH 84403
 (801) 225-3300 FAX (435) 725-2266


REVISIONS
 1. _____
 2. _____
 3. _____
 4. _____
 5. _____
 6. _____