


# RECORD OF SURVEY


PART OF THE NW 1/4 OF SECTION 29,  
TOWNSHIP 6 NORTH, RANGE 1 WEST, SALT LAKE BASE & MERIDIAN

0 0 2 6 7 8

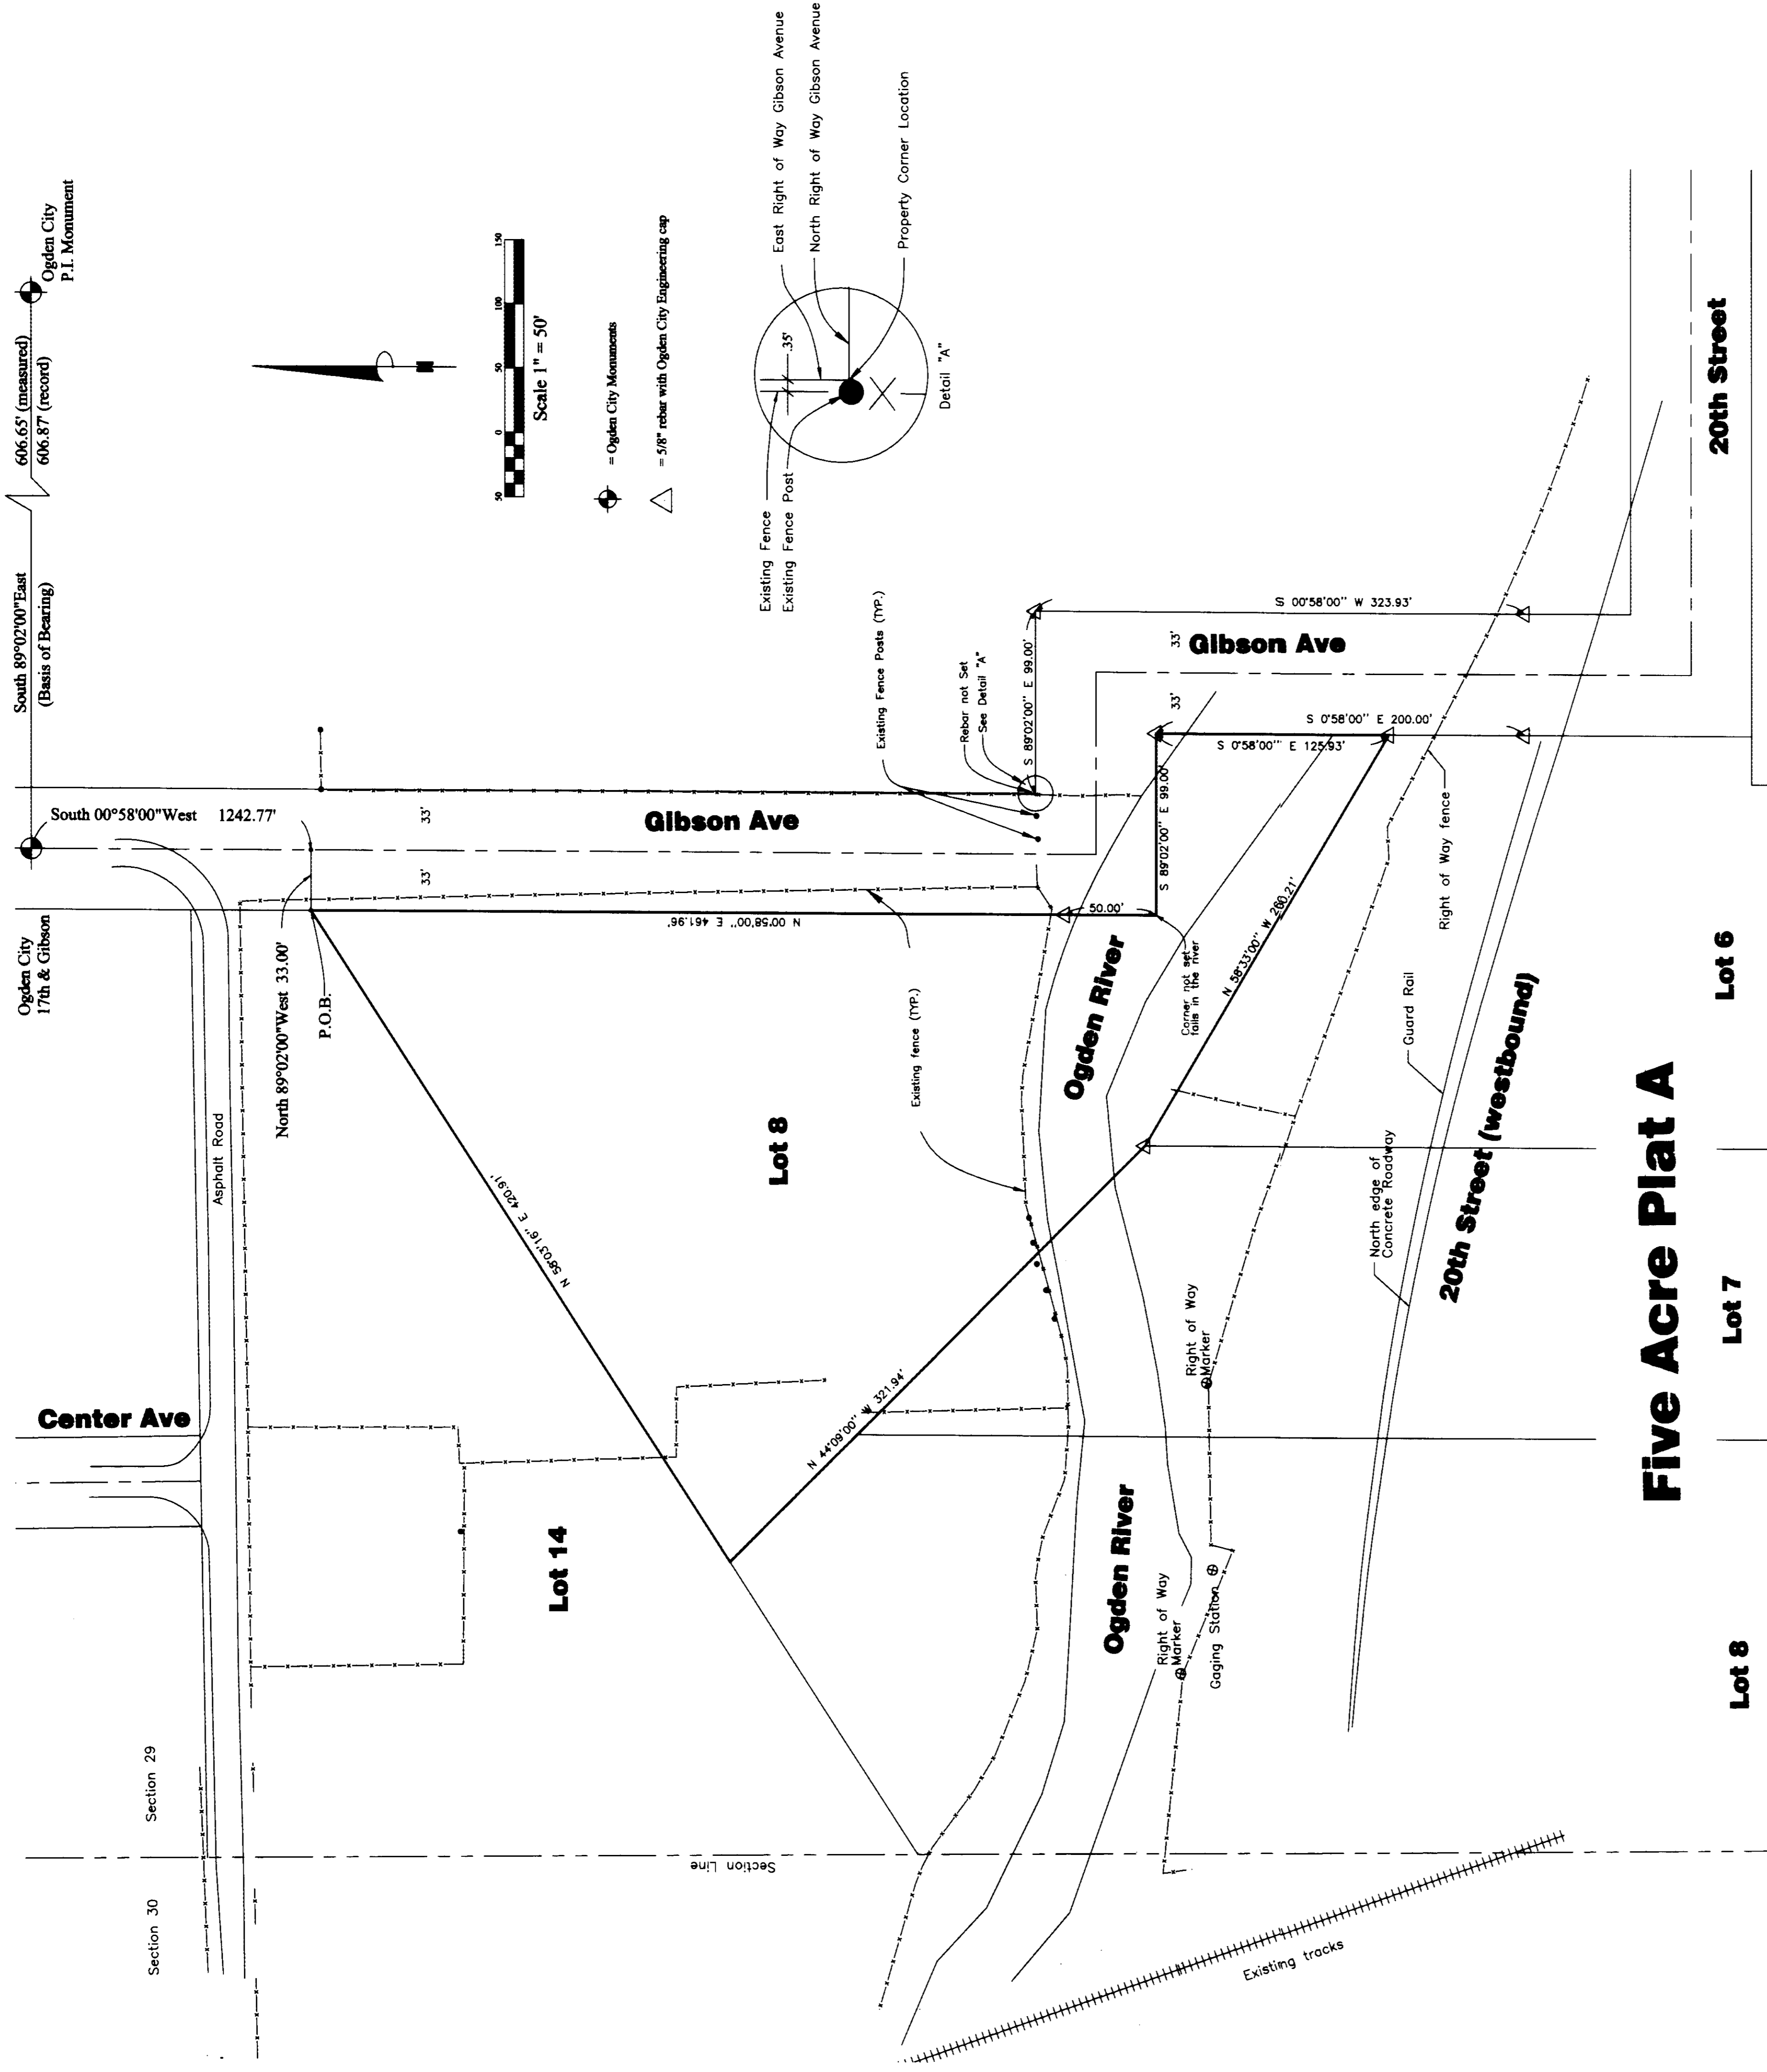

### SURVEYOR CERTIFICATE


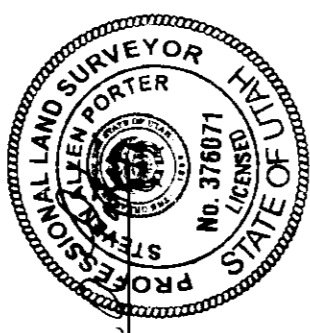


### BOUNDARY DESCRIPTION


Part of Lot 8, Block 6, Five Acre Plat A, Ogdan City Survey, being part of the Northwest Quarter of Section 29, Township 6 North, Range 1 West, Salt Lake Base & Meridian, U.S. Survey, Beginning at the intersection of the West line of Gibson Avenue with the southerly line of Lot 14 of said survey, thence South 00°58'00" West 1242.77 Feet to the Ogdan City Monument at the intersection of 17th Street and Gibson Avenue, thence South 89°02'00" West 33.00 Feet along the southerly line of Gibson Avenue, thence South 89°02'00" East 99.

### NARRATIVE

This survey was done to establish the property boundary for Donna Ogdan's property, so that we (Ogdan City) can negotiate a location for a park way trail on the south side of the Ogdan River.

The basis of bearing for this survey is between the Ogdan City monuments at 17th & Gibson and the P.I. monument that is east along 17th street as shown herein.

RECEIVED  
MAR 26 2001  
Weber County Surveyor  
0 0 2 6 7 8

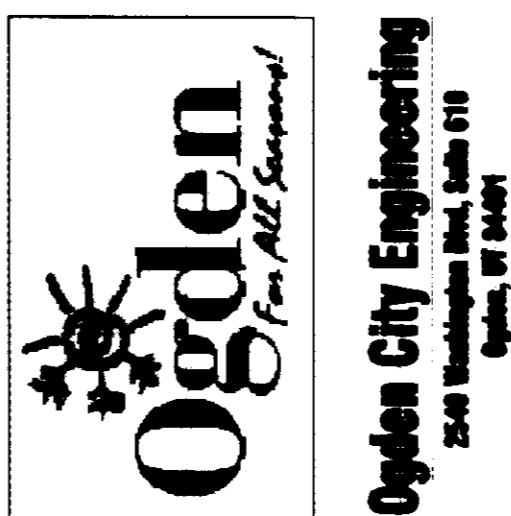




