

NARRATIVE

Brass cap monuments were found at the Northwest corner of Section 2, Township 5 North, Range 2 West, Salt Lake Base and Meridian, U.S. Survey, and the bearing N 0°51'40" E between these two monuments was used as the basis of bearings. Property corners were monumented as depicted on this drawing.

Scale: 1" = 30'

BOUNDARY DESCRIPTION

A part of the Northwest Quarter of the Southwest Quarter of Section 2, Township 5 North, Range 2 West, Salt Lake Base and Meridian, U.S. Survey, and described as follows:
 Beginning at the Southwest corner of said section, which intersects the East line of 2700 West Street, South 89°08'24" East 33 feet and South 0°51'36" West 38 feet from the Northwest corner of said Southwest Quarter and running thence South 89°23'26" East 331.5 feet to the corner of said section 2, Township 5 North, Range 2 West, Salt Lake Base and Meridian, U.S. Survey, South Street, thence North 89°08'24" West 391.5 feet along the South line of 3600 South Street to the point of beginning.

SURVEYOR'S CERTIFICATE

I, Gary L. Newman, do hereby certify that I am a Registered Land Surveyor, and that I hold Certificate No. 4778, as prescribed by the Laws of the State of Utah, and I have made a survey of the above described property, and the bearings and distances herein set forth are true and correct, and I have marked the property surveyed.

Date: 3-23-2001



NOTE: Bearings & Distances shown around Parcel in Parenthesis () are original deed bearings & distances. Bearings in description related 0°49'06" in a clockwise direction to derive state plane bearings.

BENCHMARK:
 Top of Brass Cap Monument at the West 1/4 corner of Section 2, T5N, R2W, S18M, U.S. Survey, Elevation 4286.07

RECEIVED
 APR 10 2001
 Weber County Surveyor




0 0 2 6 8 5

Property & Topographic Survey

LDS Church West Haven
 A part of the Southwest 1/4 of Section 2,
 Township 5 North, Range 2 West, Salt Lake Base and Meridian, U.S. Survey,
 West Haven City, Weber County, Utah

DATE: 8 Mar, 2001
 DRAWN: AH
 01N304Y

SCALE: 1" = 30'

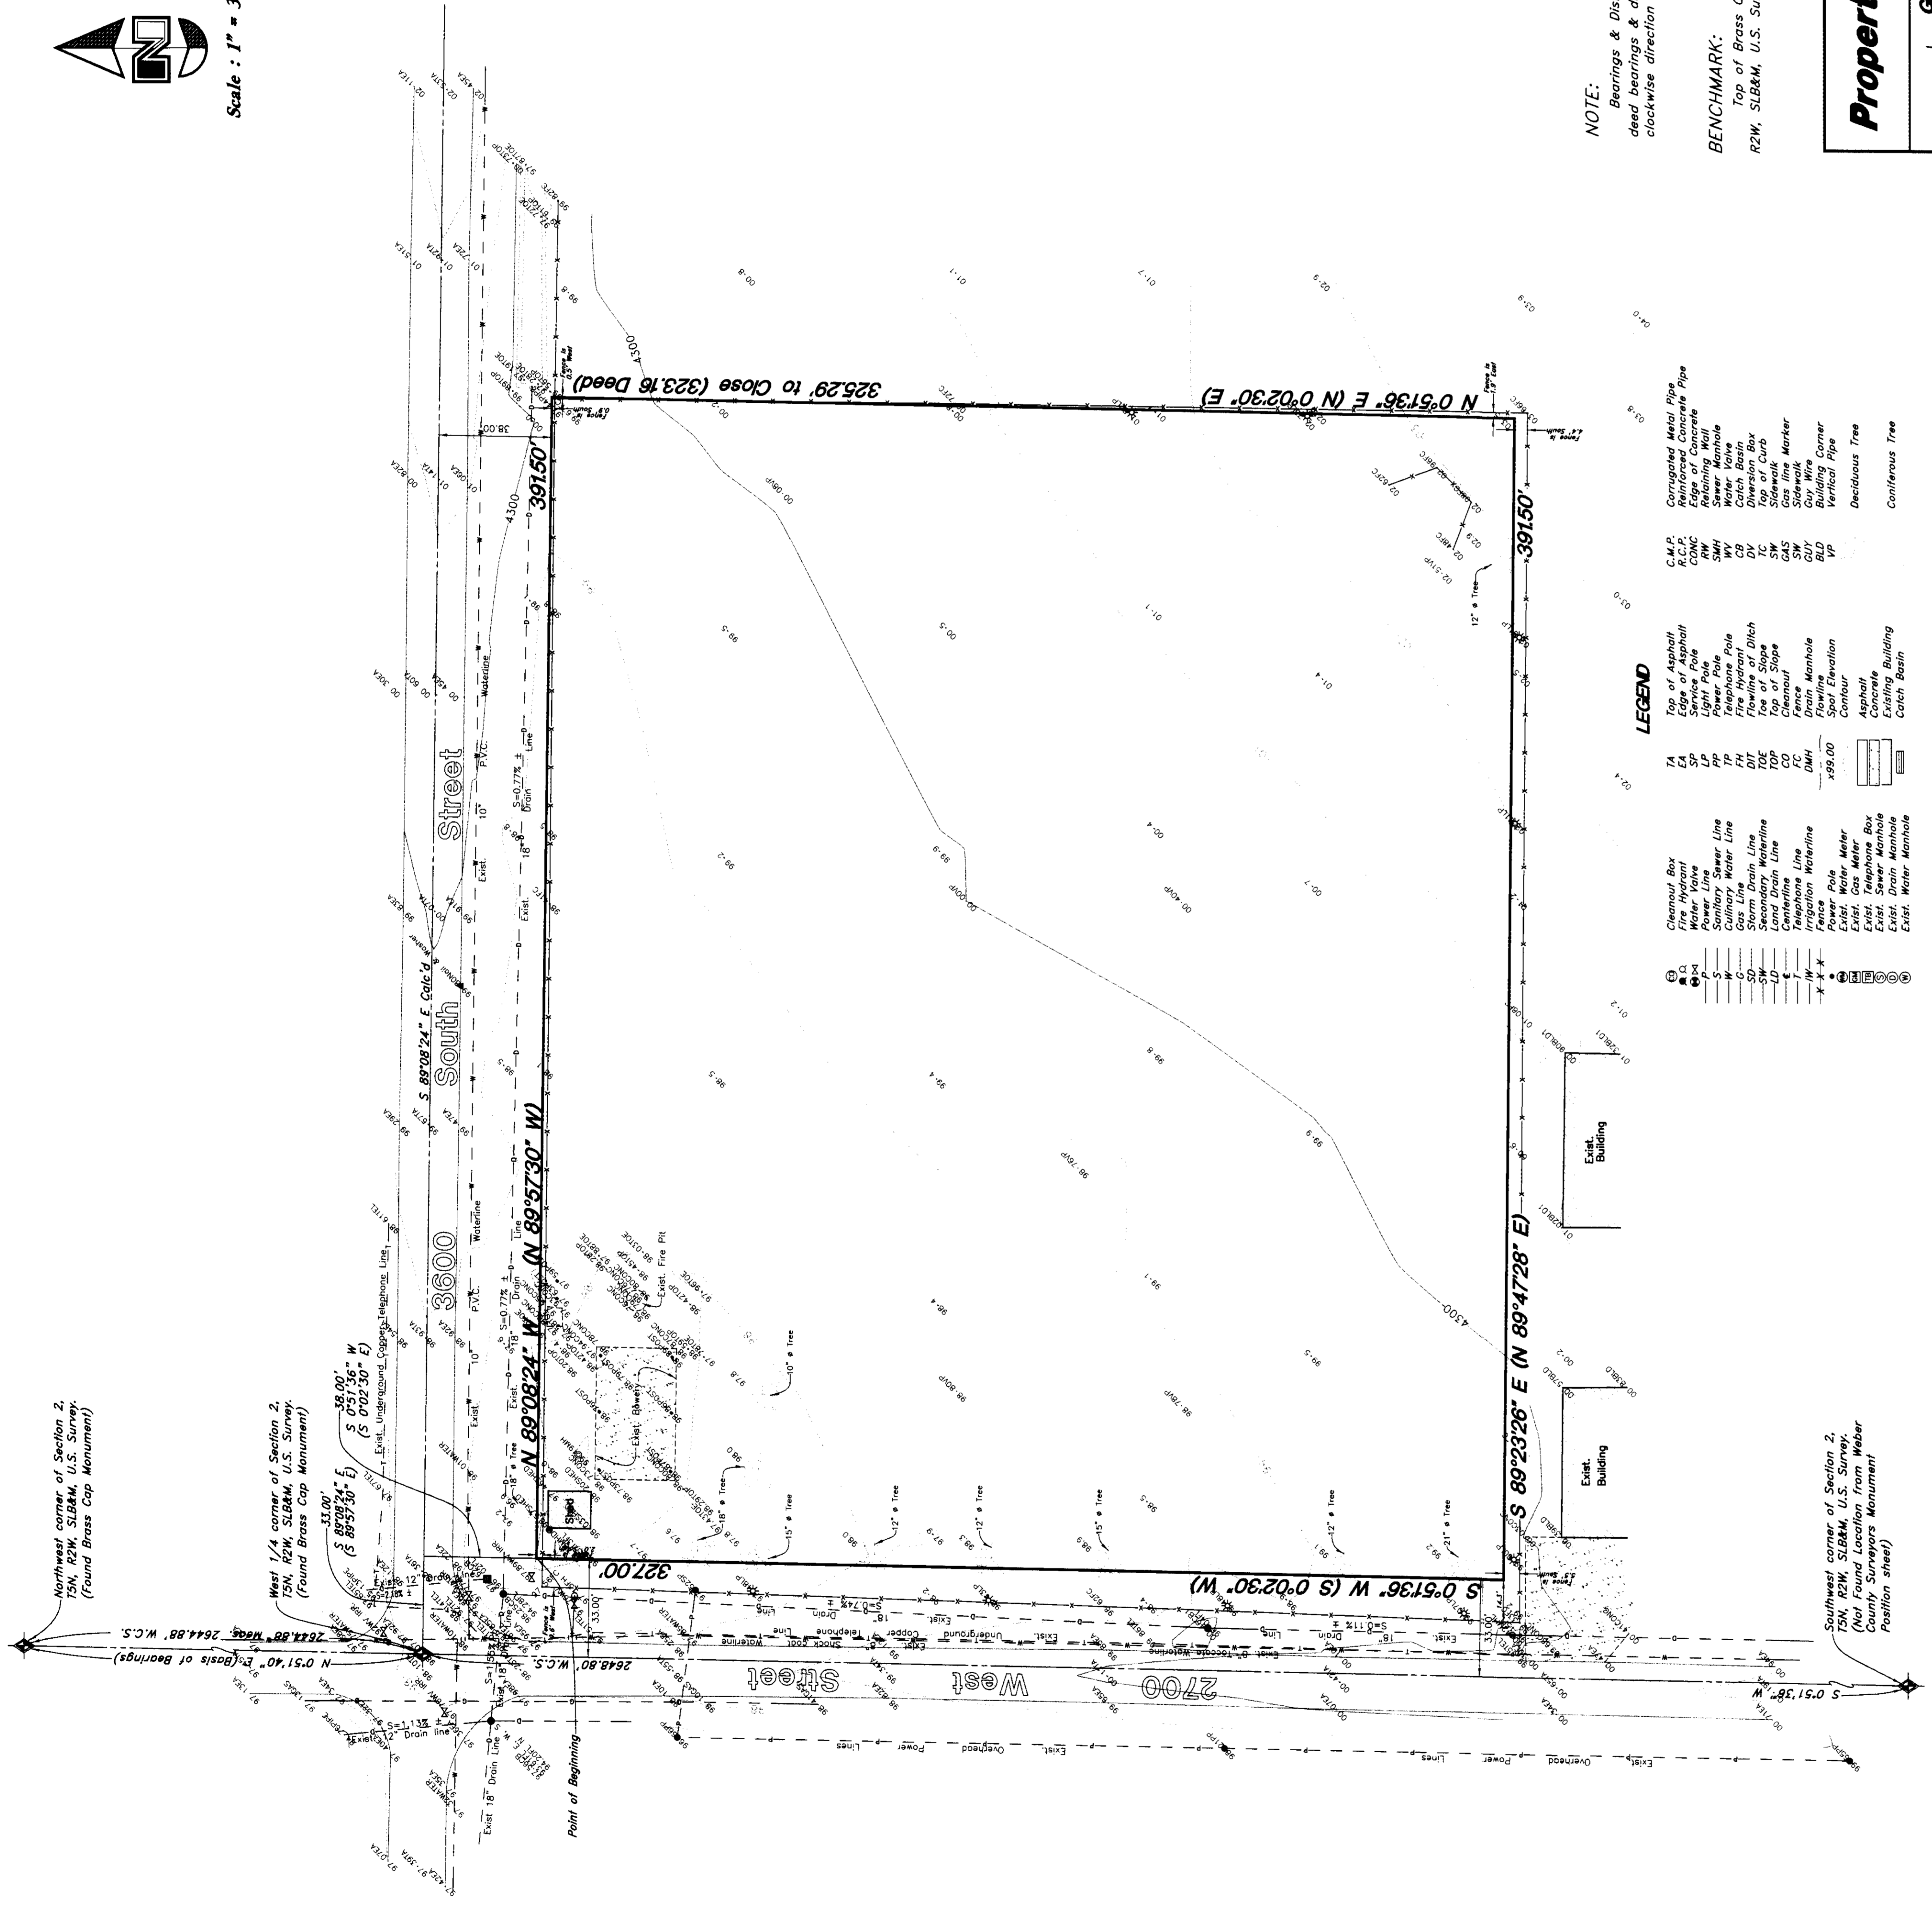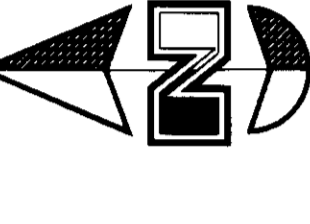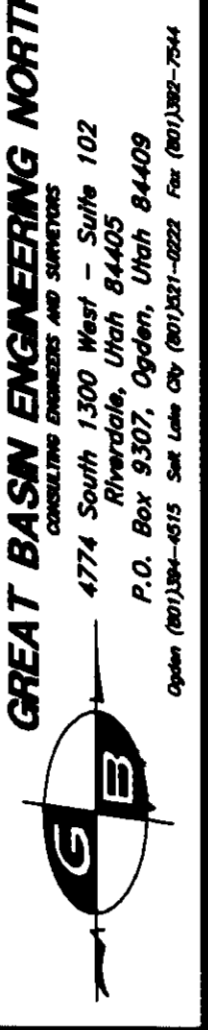

LEGEND

