


RECORD OF SURVEY

ROY WATER CONSERVANCY DISTRICT
PART OF THE SOUTH HALF OF SECTION 13, TOWNSHIP 5 NORTH, RANGE 2 WEST, S.L.B.&M.
WEBER COUNTY, UTAH


02691

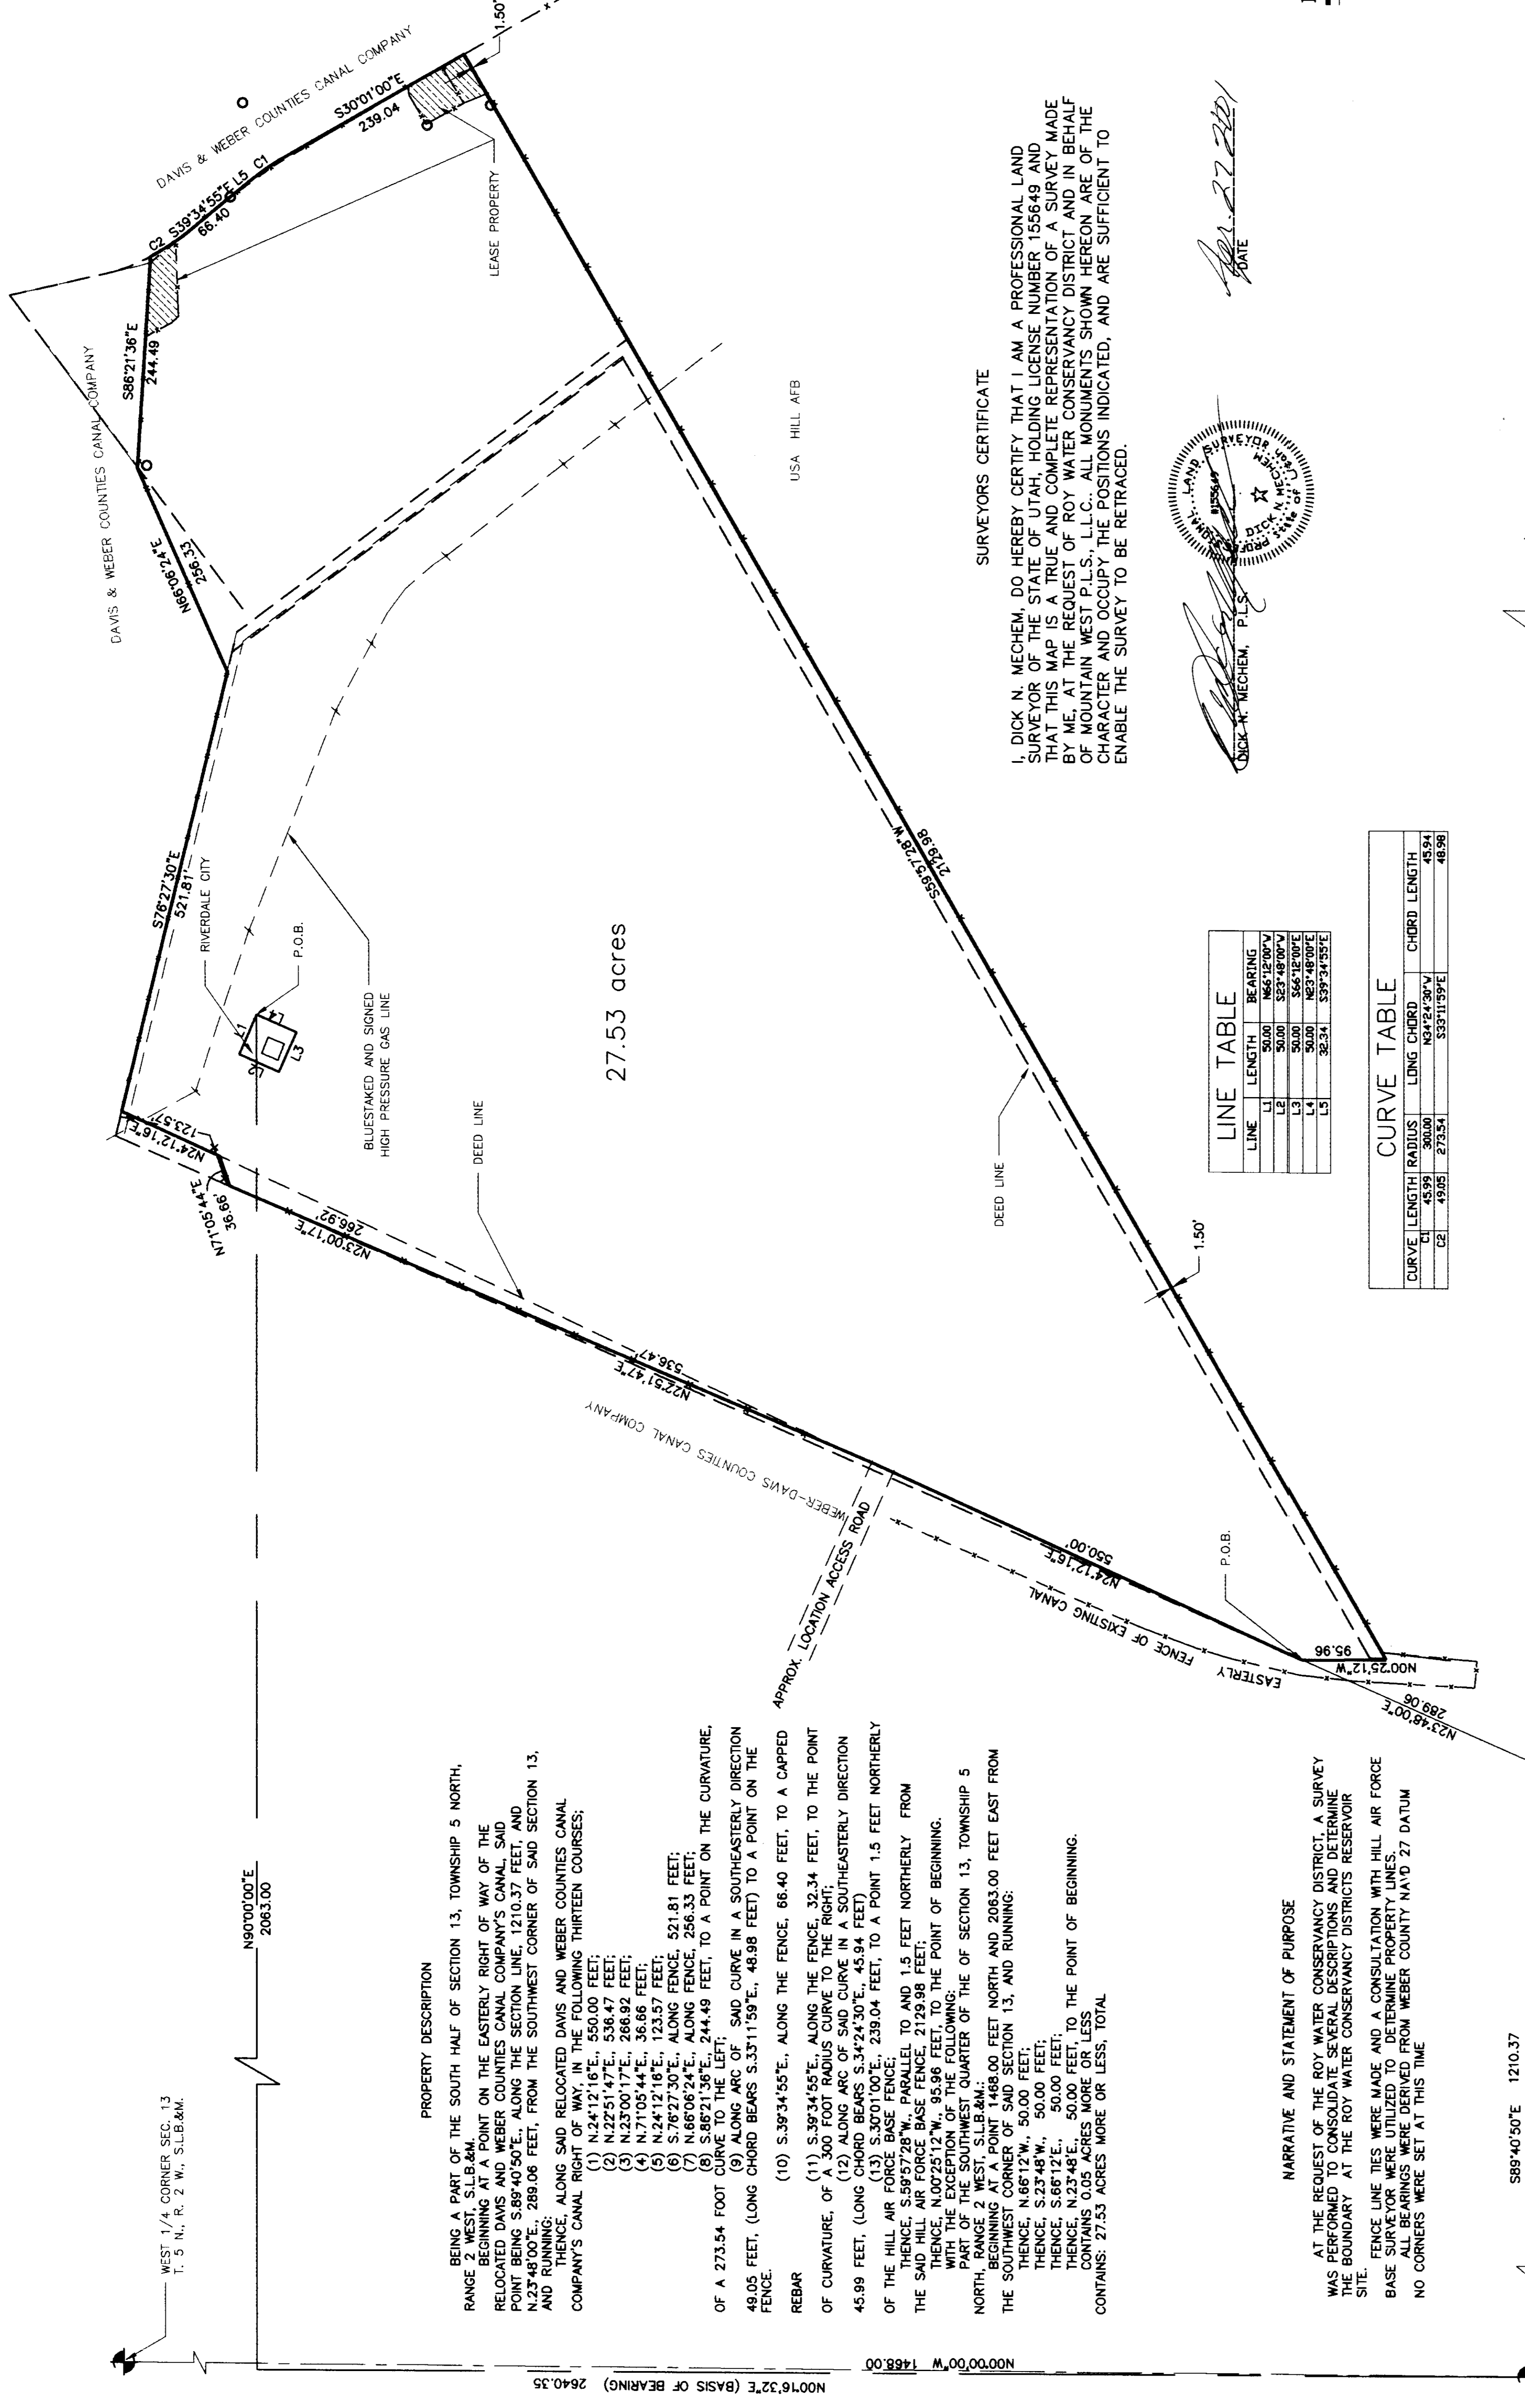

PROPERTY DESCRIPTION

REBAR
WITH THE EXCEPTION OF THE FOLLOWING:
PART OF THE SOUTHWEST QUARTER OF THE OF SECTION 13, TOWNSHIP 5 NORTH, RANGE 2 WEST, S.L.B.&M.;
THE SOUTHWEST CORNER OF SAID SECTION 13, AND RUNNING:
CONTAINS 0.05 ACRES MORE OR LESS
CONTAINS: 27.53 ACRES MORE OR LESS, TOTAL

SURVEYORS CERTIFICATE
I, DICK N. MUEHLEN, DO HEREBY CERTIFY THAT I AM A PROFESSIONAL LAND SURVEYOR OF THE STATE OF UTAH, HOLDING LICENSE NUMBER 155649 AND THAT THIS MAP IS A TRUE AND COMPLETE REPRESENTATION OF A SURVEY MADE BY ME, AT THE REQUEST OF ROY WATER CONSERVANCY DISTRICT AND IN BEHALF OF MOUNTAIN WEST P.L.S., L.L.C.. ALL MONUMENTS SHOWN HEREON ARE OF THE CHARACTER AND OCCUPY THE POSITIONS INDICATED, AND ARE SUFFICIENT TO ENABLE THE SURVEY TO BE RETRACED.

DICK N. MUEHLEN, P.L.S.
[Signature]

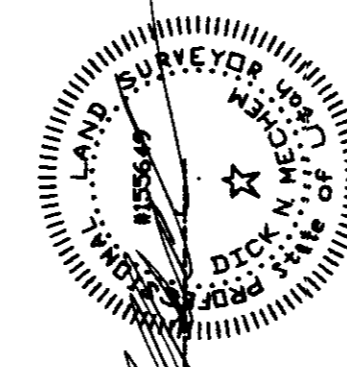

LINE TABLE

LINE	LENGTH	BEARING



Scale: 1" = 100'

LEGEND
PROPERTY LINE
RIVERDALE CITY PROPERTY
EXISTING FENCE
SECTION LINE
BLUESTAKE & SIGNED GAS
O FOUND REBAR AND CAP

SE CORNER SEC. 13,
T.5N., R.2W., S.L.B.&M.

SW COR SEC. 13,
T.5N., R.2W., S.L.B.&M.

RECORD OF SURVEY
for
ROY WATER CONSERVANCY DISTRICT
Located in The South Half of Section 13,
Township 5 North, Range 2 West, S.L.B.&M.
Date: JAN 2001 Lib. 1930-01-00 Loc. 804M Local JNH
Author: Mountain West P.L.S., L.L.C. 1862 V-4462 1 PO Box 207
Roy, Utah 84067 Phone: 800.726.3326 Fax: 800.726.3326

RECEIVED
MAY 02 2001
Weber County Surveyor

02691