



002706

**SURVEYOR'S CERTIFICATE**  
I, **DAVID J. REEVE**, a duly licensed and sworn surveyor in the State of Utah, do hereby certify that the foregoing plat is a true and correct copy of the original as shown to me by the owner of the property described herein and that the same was prepared by me or under my direction and that this plat correctly depicts the findings of that survey.

SIGNED THIS 5th DAY OF FEBRUARY, 2001.

159437  
UTAH LICENSE NUMBER

*David J. Reeve*  
SURVEYOR

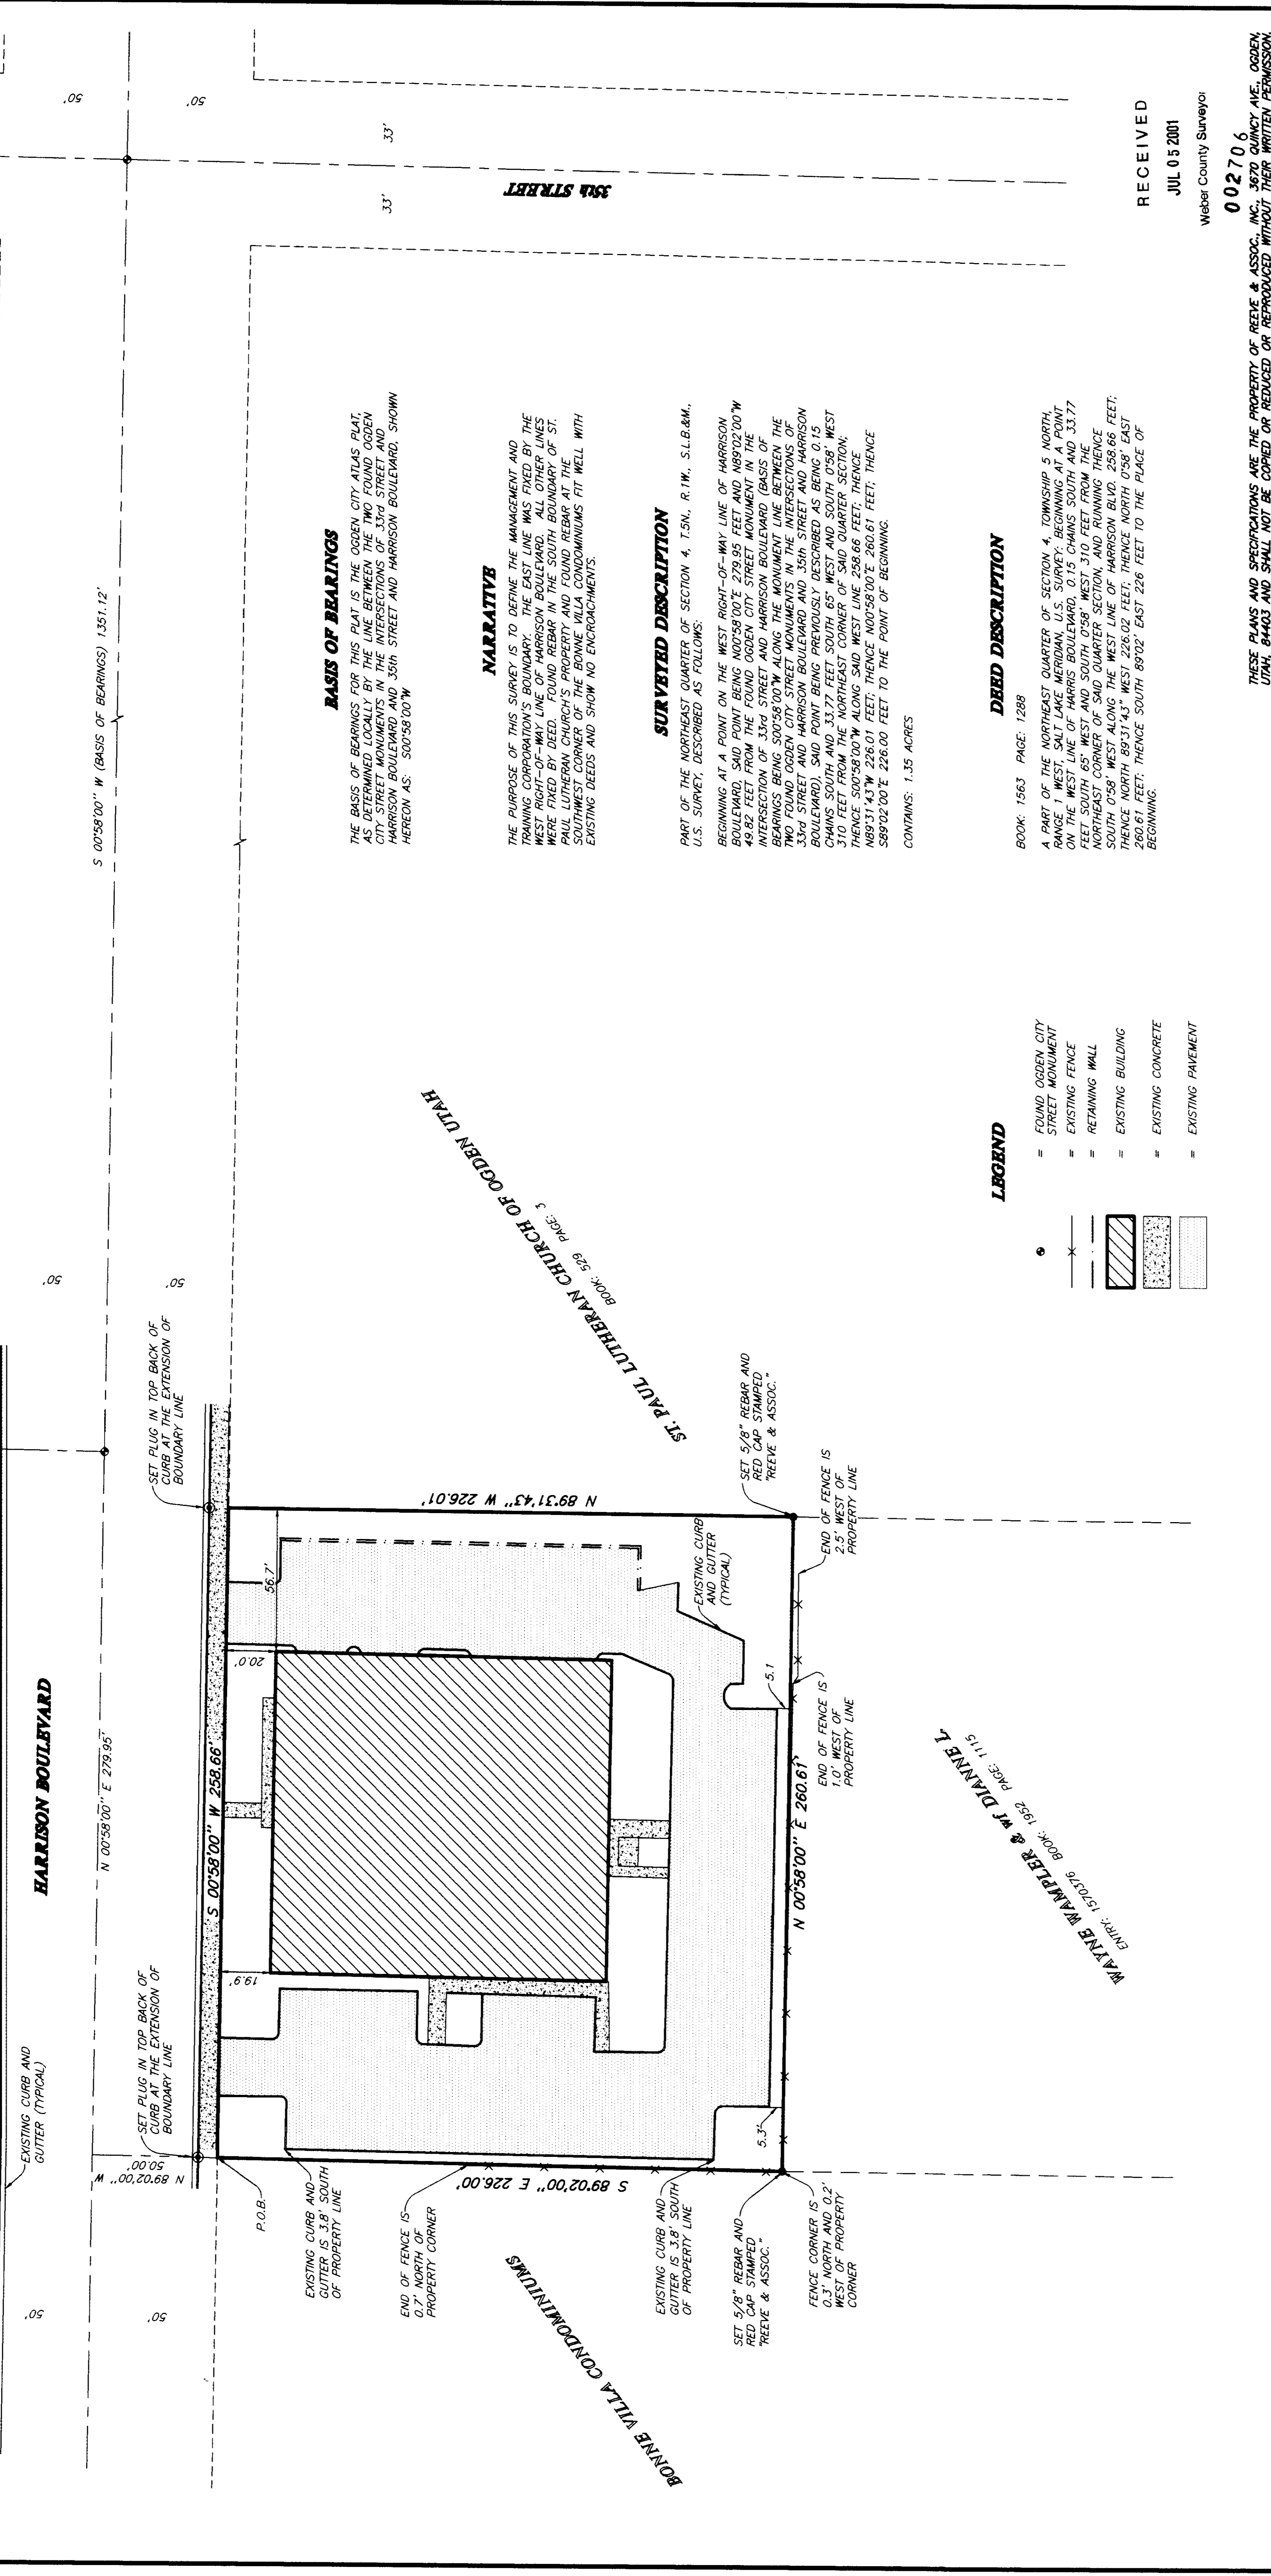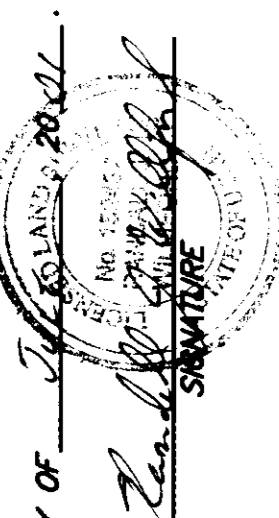

**BASIS OF BEARINGS**  

**NARRATIVE**  

**SURVEYED DESCRIPTION**  
PART OF THE NORTHEAST QUARTER OF SECTION 4, T.5N., R.1W., S.L.B.M., U.S. SURVEY, DESCRIBED AS FOLLOWS:  


CONTAINS: 1.35 ACRES

**DEED DESCRIPTION**  
BOOK: 1563 PAGE: 1288  
A PART OF THE NORTHEAST QUARTER OF SECTION 4, TOWNSHIP 5 NORTH, RANGE 1 WEST, SALT LAKE MERIDIAN, U.S. SURVEY; BEGINNING AT A POINT ON THE WEST LINE OF HARRIS BOULEVARD, 0.15 CHAINS SOUTH AND 33.77 FEET WEST OF THE INTERSECTION OF SAID WEST LINE AND HARRISON BOULEVARD; THENCE S 00°58'00" W 310 FEET TO THE INTERSECTION OF SAID WEST LINE OF HARRISON BLVD. 258.66 FEET; THENCE NORTH 89°31'43" WEST 226.02 FEET; THENCE NORTH 0°58' EAST 260.61 FEET; THENCE SOUTH 89°02' EAST 226 FEET TO THE PLACE OF BEGINNING.

**LEGEND**

- FOUND OGDEN CITY STREET MONUMENT
- ⊗ EXISTING FENCE
- ▨ RETAINING WALL
- ▧ EXISTING BUILDING
- ▩ EXISTING CONCRETE
- ▬ EXISTING PAVEMENT

RECEIVED  
JUL 05 2001  
Weber County Surveyor

002706  
THESE PLANS AND SPECIFICATIONS ARE THE PROPERTY OF REEVE & ASSOC., INC., 3870 QUINCY AVE., OGDEN, UTAH, 84403 AND SHALL NOT BE COPIED OR REPRODUCED WITHOUT THEIR WRITTEN PERMISSION.

REVISIONS  
1. \_\_\_\_\_  
2. \_\_\_\_\_  
3. \_\_\_\_\_  
4. \_\_\_\_\_  
5. \_\_\_\_\_  
6. \_\_\_\_\_

**RECORD OF SURVEY**  
MANAGEMENT AND TRAINING CORPORATION  
PART OF THE NORTHEAST QUARTER OF SECTION 4, T.5N., R.1W., S.L.B.M., U.S. SURVEY  
OGDEN CITY, WEBER COUNTY, UTAH  
FEBRUARY, 2001

**REEVE & ASSOCIATES, INC.**  
Civil Engineering • Structural Engineering  
Surveying • Land Planning • Landscape Architecture  
3805 QUINCY AVE., SUITE 210  
OGDEN, UTAH 84403  
(801) 821-1100 FAX (801) 821-2666 (435) 752-3303 FAX (435) 752-2266

PROJECT NO.: \_\_\_\_\_ SURVEYOR: **DAVID J. REEVE**  
DATE: \_\_\_\_\_ DRAWN: \_\_\_\_\_  
SCALE: \_\_\_\_\_ CHECKED: \_\_\_\_\_

REVISIONS  
1. \_\_\_\_\_  
2. \_\_\_\_\_  
3. \_\_\_\_\_  
4. \_\_\_\_\_  
5. \_\_\_\_\_  
6. \_\_\_\_\_

SHEET

1

SHEETS

1

002706



