PROPERTY SURVEY FOR

Matt Shipley

4261 North 125 West
Pleasant View, Weber County, Utah

A PART OF THE NORTHWEST QUARTER OF SECTION 20, TOWNSHIP 7 NORTH, RANGE 1 WEST, S.L.B.& M.

SHEET	OF	SHEETS
1	1	1

HANSEN & ASSOCIATES, INC.
Consulting Engineers and Land Surveyors

Brigham City	Ogden	Logan
538 North Main	Brigham City, Utah	84302
723-3491	399-4903	752-8272

No.	Date	By	Revision

Drawn By: KBH Date: 08/04/01
Designed By: ____
Checked By: ____
Approved By: ____
Scale: 1" = 50'
Drawing File: 01-5-58.DWG
JOB NUMBER: 01-5-58

RECEIVED
AUG 09 2001
Weber County Surveyor

002714

SURVEY CERTIFICATE

I, K. Greg Hansen, do hereby certify that I am a Registered Land Surveyor, and that I hold Certificate No. 167819 as prescribed by the Laws of the State of Utah; and that I have made and/or Supervised the survey of the property shown and described hereon and that this plat is a true and correct representation of said survey to the best of my knowledge. 08 Jul 01 date

K. Greg Hansen
P.L.S. No. 167819

K. GREG HANSEN 167819 REGISTERED LAND SURVEYOR STATE OF UTAH

As-Surveyed Property Description

A PART OF THE NORTHWEST QUARTER OF SECTION 20, TOWNSHIP 7 NORTH, RANGE 1 WEST OF THE SALT LAKE BASE AND MERIDIAN, U.S. SURVEY:
BEGINNING AT A POINT ON THE WEST RIGHT-OF-WAY LINE OF 125 WEST STREET LOCATED NORTH 89°50'22" WEST 598.01 FEET ALONG THE NORTH LINE OF SAID NORTHWEST QUARTER AND SOUTH 00°09'38" WEST 603.76 FEET (600.20 FEET BY RECORD) FROM THE NORTHEAST CORNER OF SAID NORTHWEST QUARTER; RUNNING THENCE SOUTH 00°09'38" WEST 145.20 FEET; THENCE NORTH 89°50'22" WEST 163.80 FEET; THENCE NORTH 00°09'38" EAST 145.20 FEET; THENCE SOUTH 89°50'22" EAST 163.80 FEET TO THE POINT OF BEGINNING. CONTAINING 0.546 ACRES.

Narrative

The purpose of this survey was to establish and set the property corners of the Matt Shipley Property. The Control used to set the property corners was the existing Weber Co. Surveyor Monumentation along the north line of Section 20, T7N, R1W, SLB&M. Based on occupation lines in the Cottonwood Heights Subdivision and the Edmunds and Shipley Property, it appears that the North Quarter Corner of said section was in a different location in 1983 when Cottonwood Heights was filed than its present location. The records in the Weber County Surveyors office show this corner being monumented in 1973 and its current condition is good and looks non disturbed which causes some confusion why the error exists. There is a 3.57 foot overlap in a north-south direction of the Ridgeview Subd. Phase 2 on to the Cottonwood subdivision and the Matt Shipley Property. Reber set by Wayne Crow were found and appear to somewhat fit the Ridgeview Subd. per plat. Also, found curb nails set by Reeves for both phase 1 and 2 of Ridgeview Subd. fit per plat. But the found rebars set by Reeves in the back of the lots north of lots 7 of Ridgeview are more in harmony with the location of the Cottonwood Subdivision.
The Shipley property was staked on this survey in the location that is in harmony with Cottonwood Heights and the other occupation lines. Obviously, this creates an overlap on to lot 1 of the Ridgeview Subd. Phase 1 of the 3.57 feet.

Scale: 1" = 50'

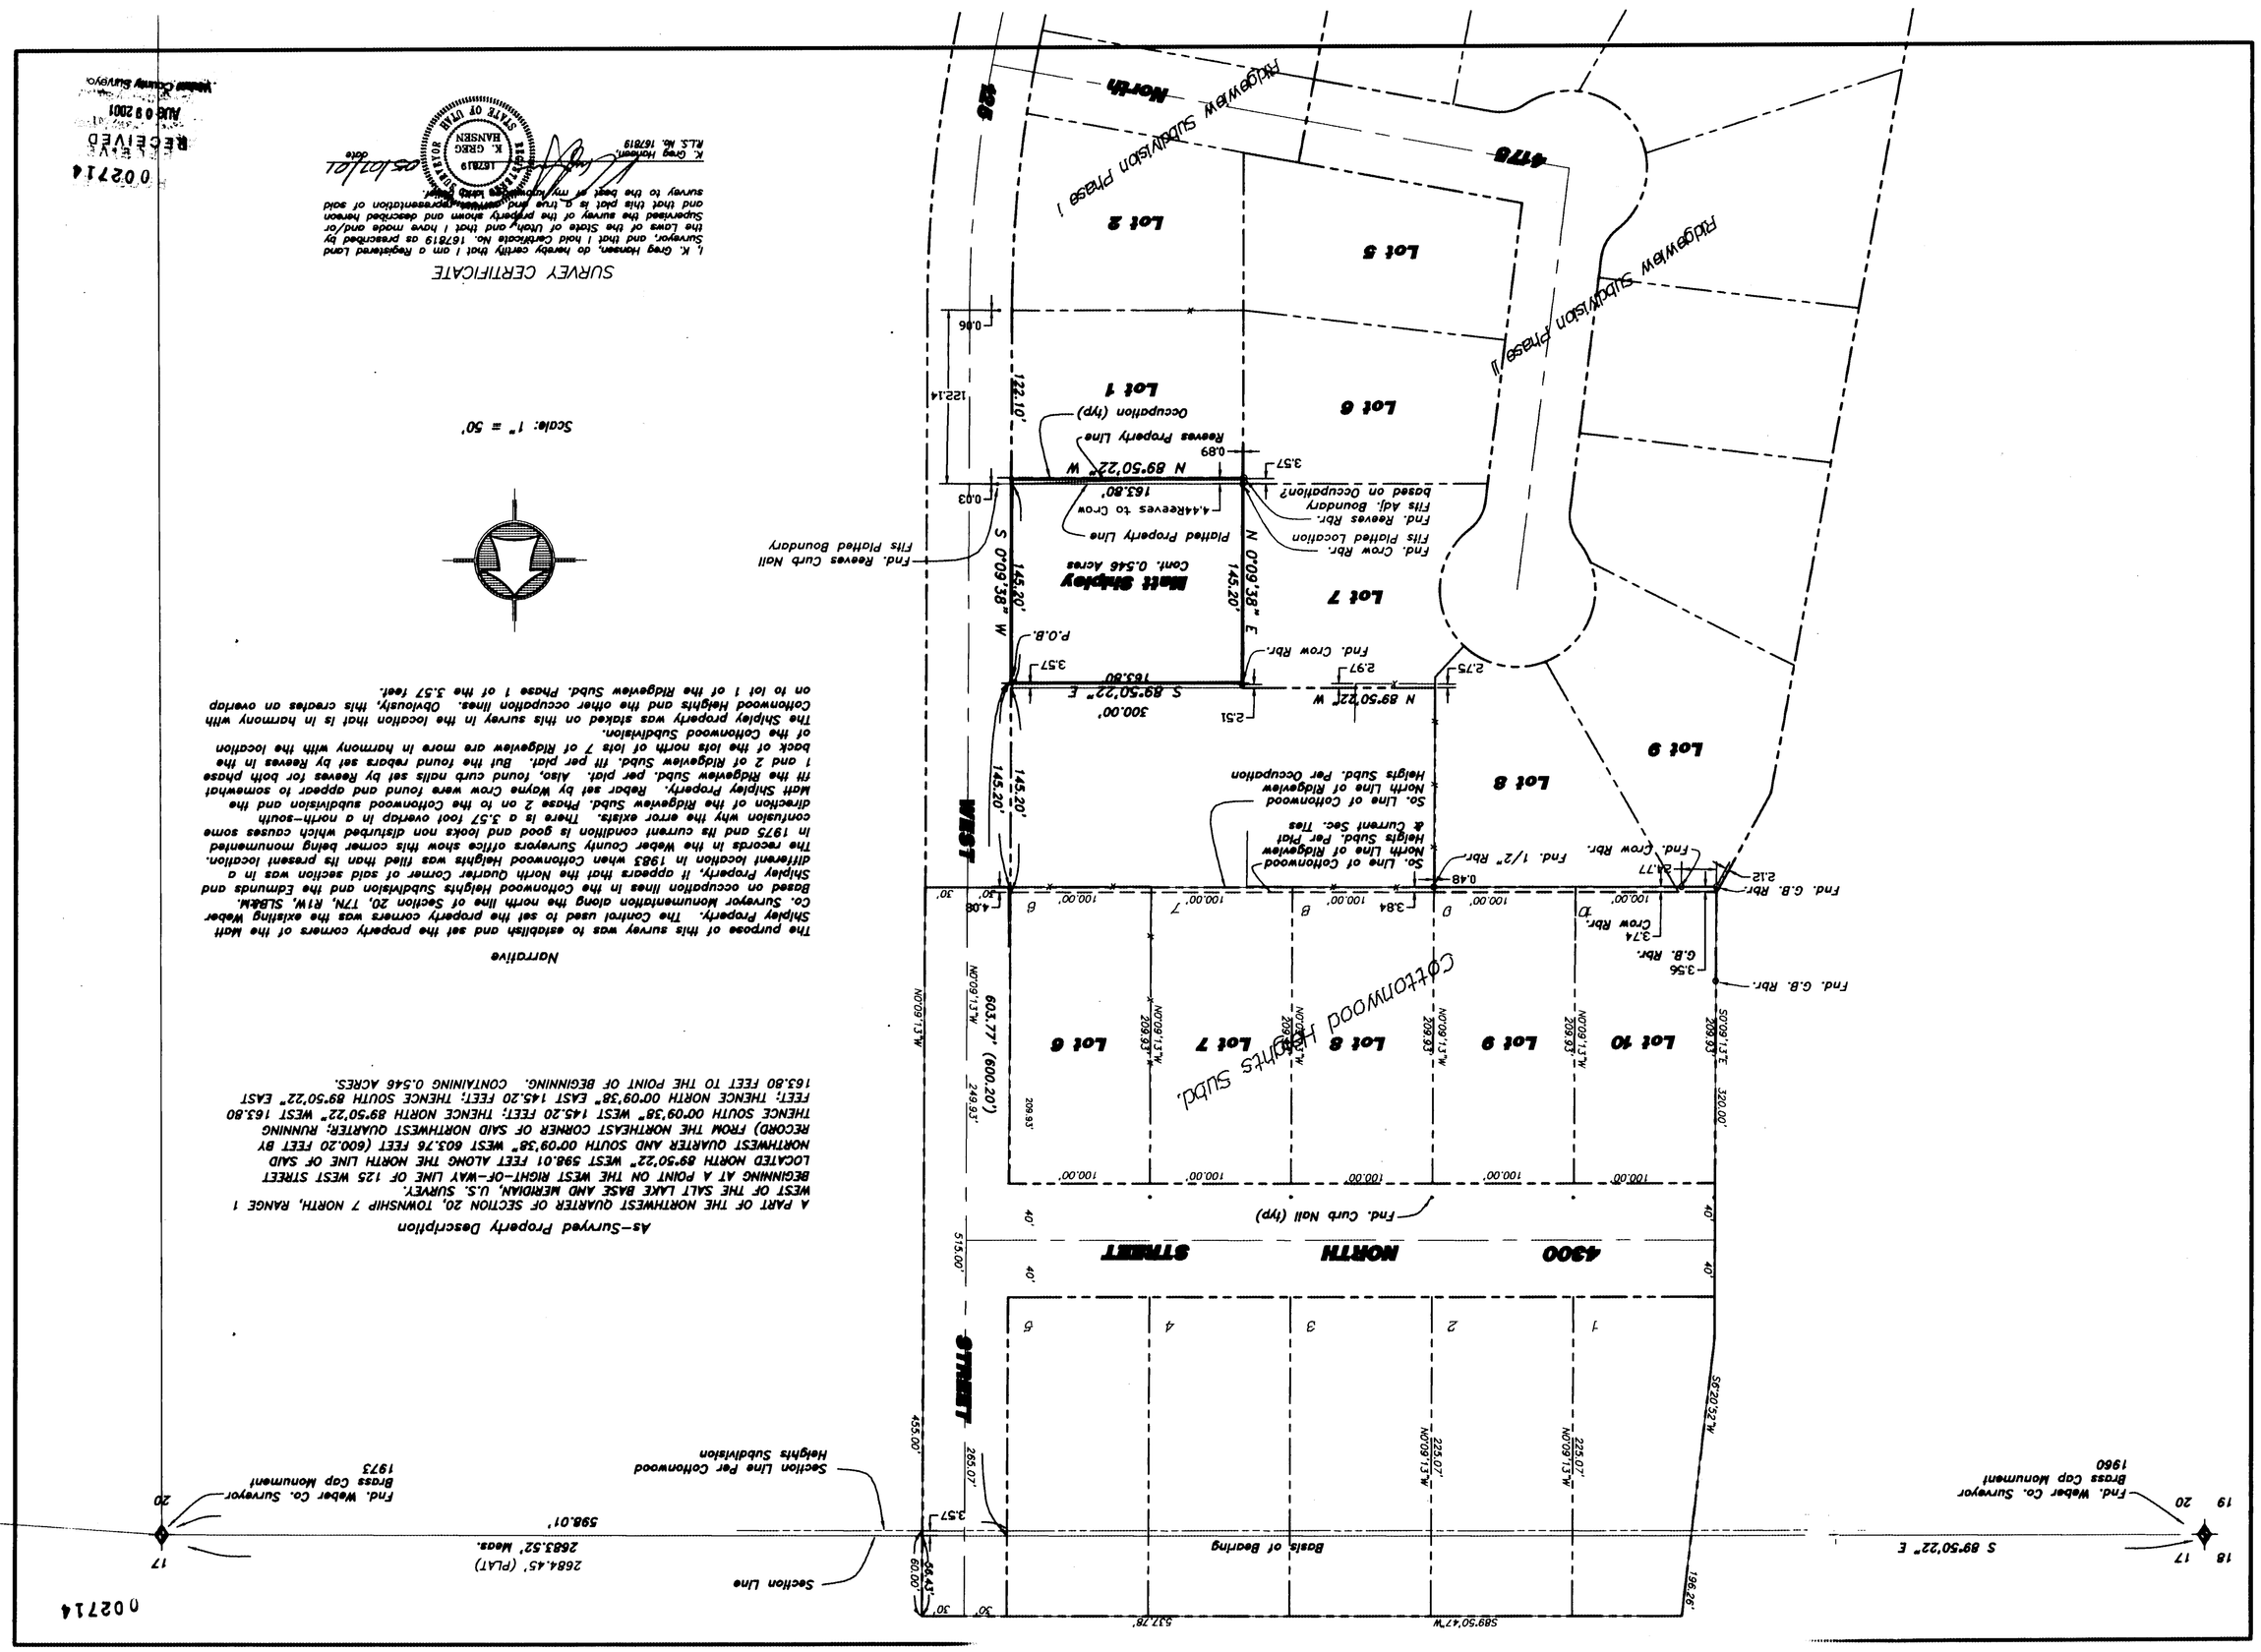

002714

N:\2001\01-3-58\dgn\plat01-3-58.dwg Mon May 07 11:24:36 2001 dgn