002718

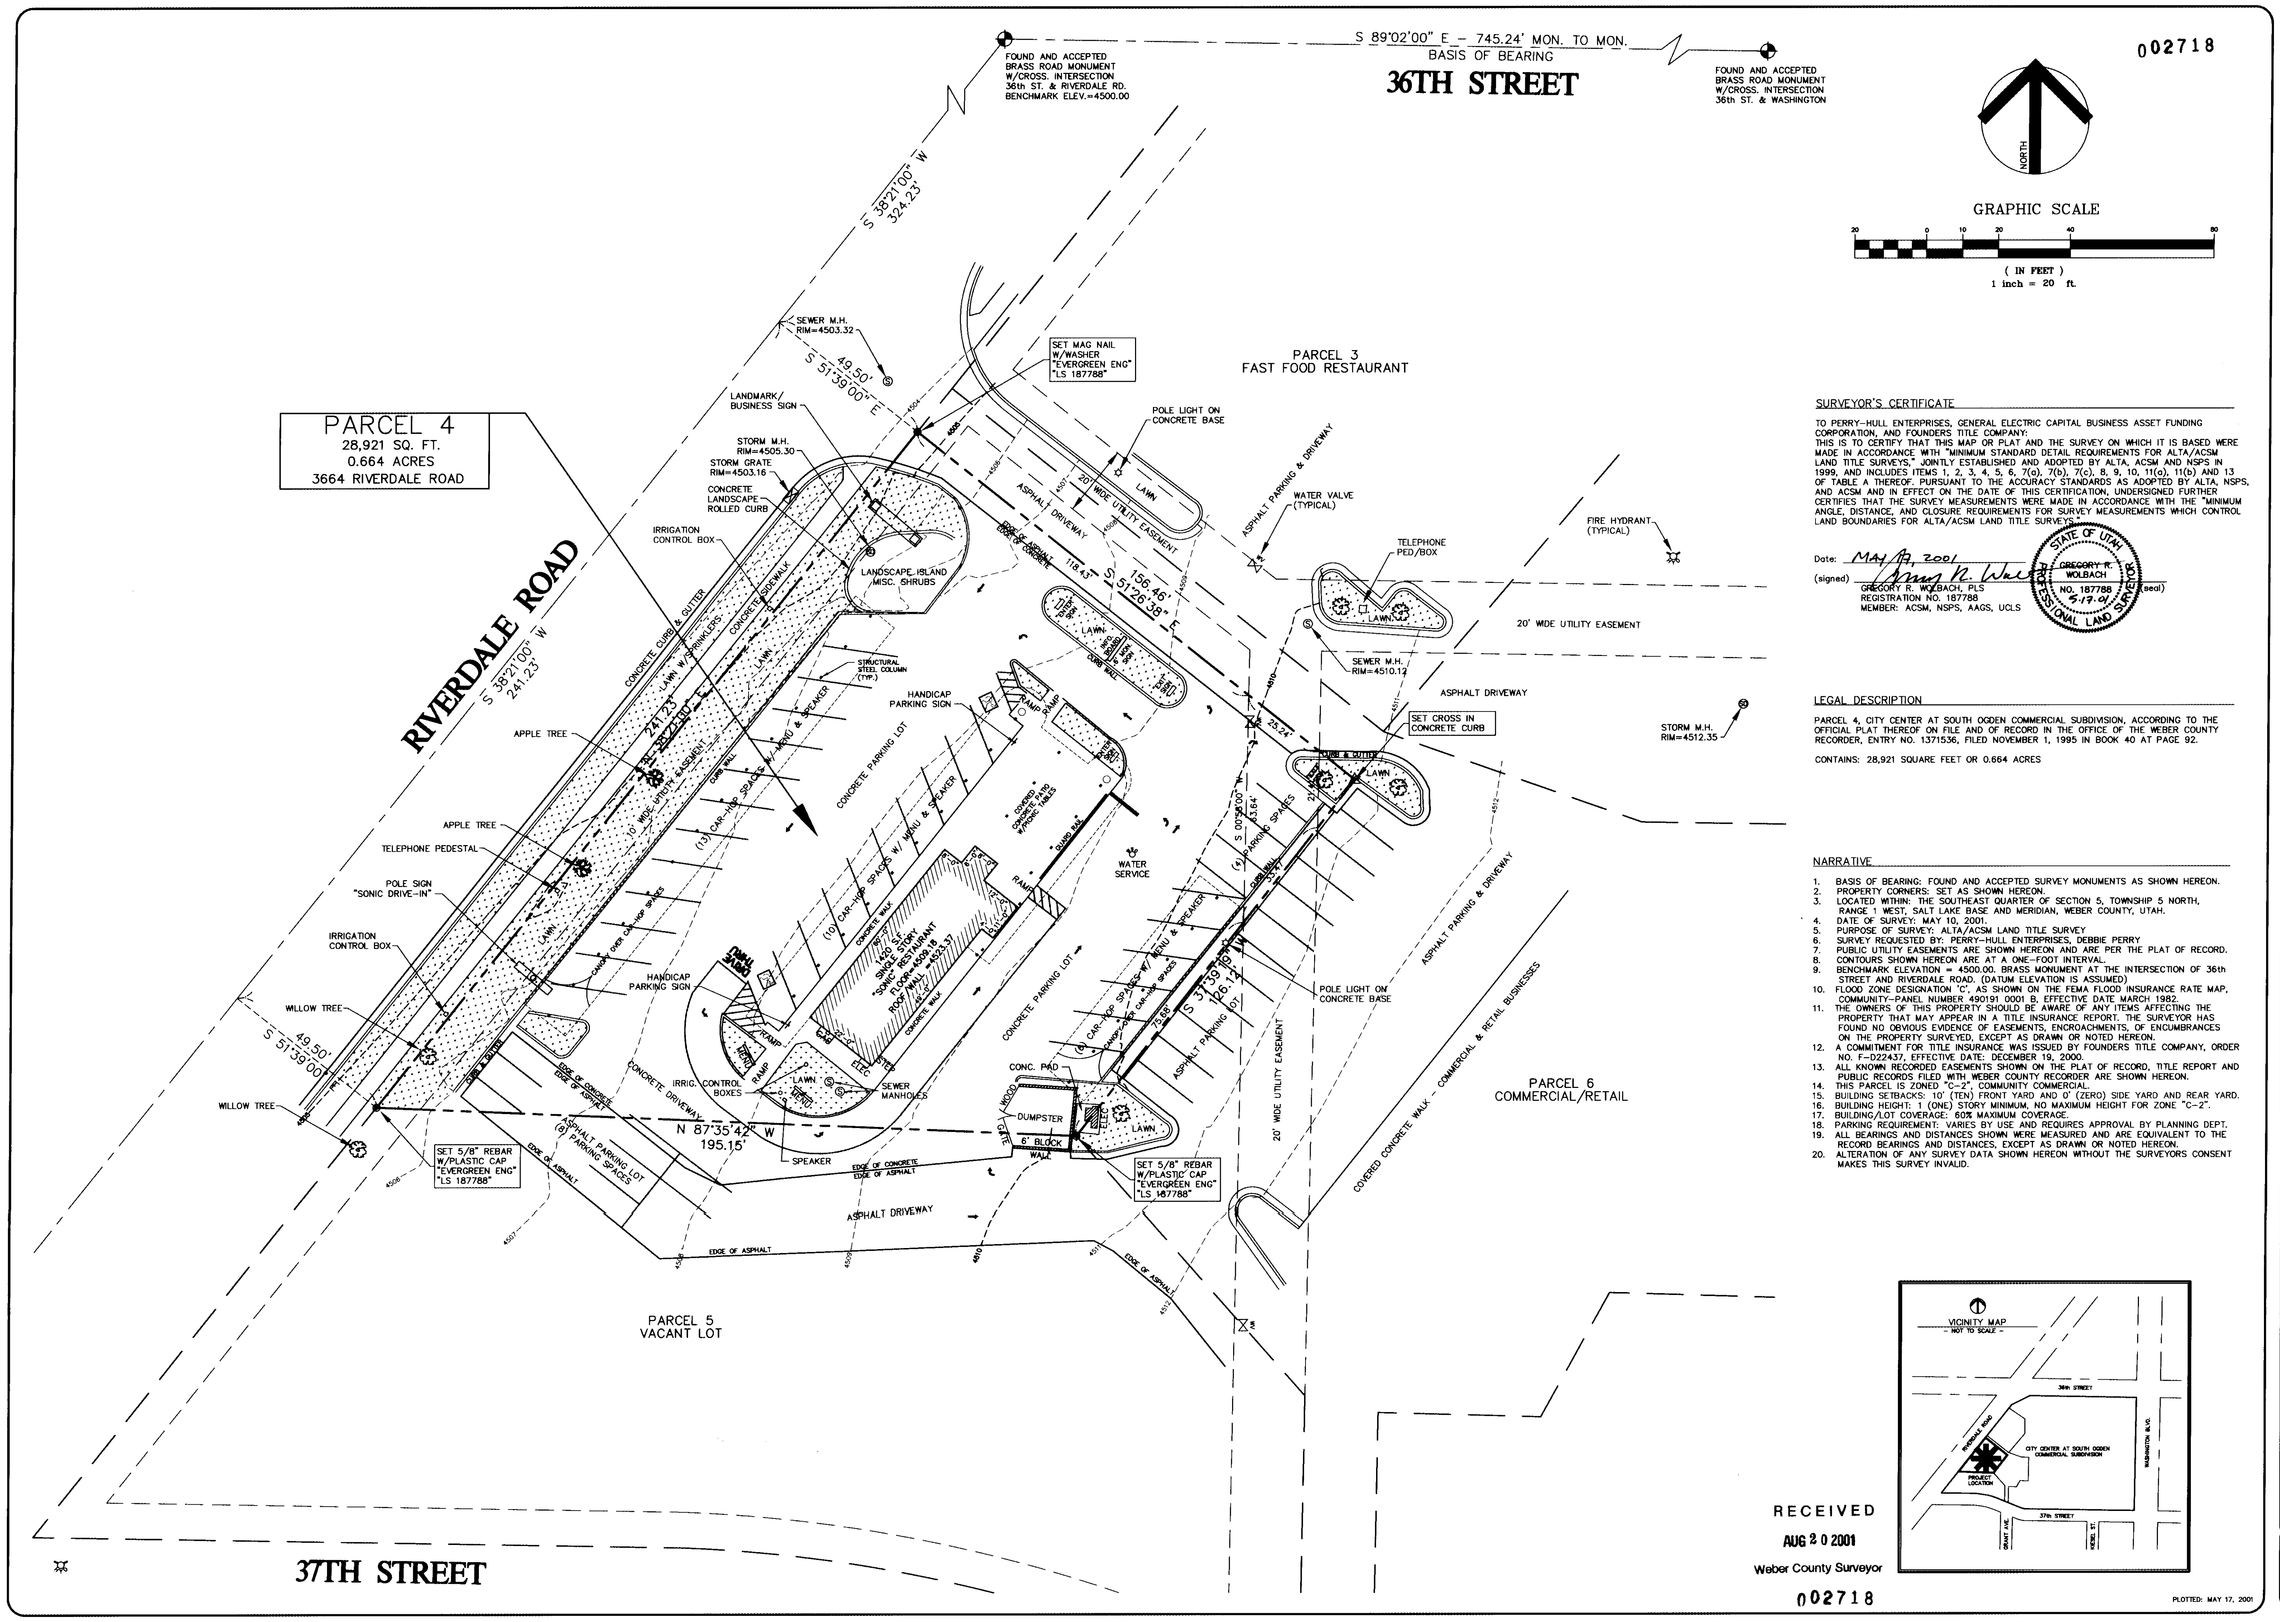

RECEIVED
AUG 20 2001
Weber County Surveyor
002718

PLOTTED: MAY 17, 2001

Evergreen Engineering, Inc.
Civil Engineering • Land Surveying
1741 Sidewinder • Suite 200 • P.O. Box 2861 • Park City • UT • 84060
(435) 649-4687 • Fax: (435) 649-9219 • Email: ee@mission.com

REVISIONS
DATE | BY | COMMENTS
© 2001 Evergreen Engineering, Inc.

SURVEYED BY: GRW/ADM
DRAWN BY: GRW
CHECKED BY: GRW

** ALTA/ACSM LAND TITLE SURVEY **
PARCEL 4, CITY CENTER AT SOUTH OGDEN COMMERCIAL SUBDIVISION

FOR: PERRY-HULL ENTERPRISES

JOB NO. 0047
DWG: SSOALTA2.DWG

SHEET 1 OF 1