


McNEIL ENGINEERING AND LAND SURVEYING, L.C.
 PROFESSIONAL CIVIL ENGINEERING & LAND SURVEYING SERVICES
 6896 SOUTH 900 EAST MIDVALE, UTAH 84047
 TEL: (801) 265-7100
 VISIT OUR WEB SITE AT www.mcneileng.com

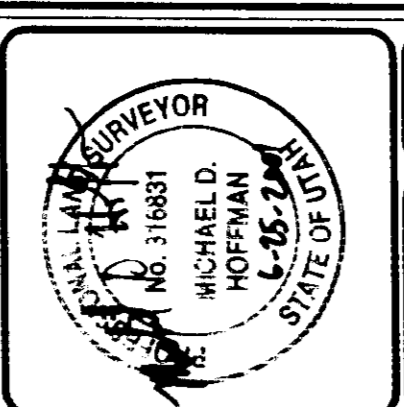



AMBERLY PROPERTIES II, L.L.C.
 FARVIEW APTS 679 27TH STREET

REVISIONS

NO.	DATE	DESCRIPTION

DATE: 01/18/2001
 DRAWN BY: JS
 CHECKED BY: WH/S
 SURVEYED BY: WH/S
 JOB NO: 210169
 SCALE: 1" = 20'
 COMD. DRWG.: P010261A

SHEET NUMBER
1 of 1

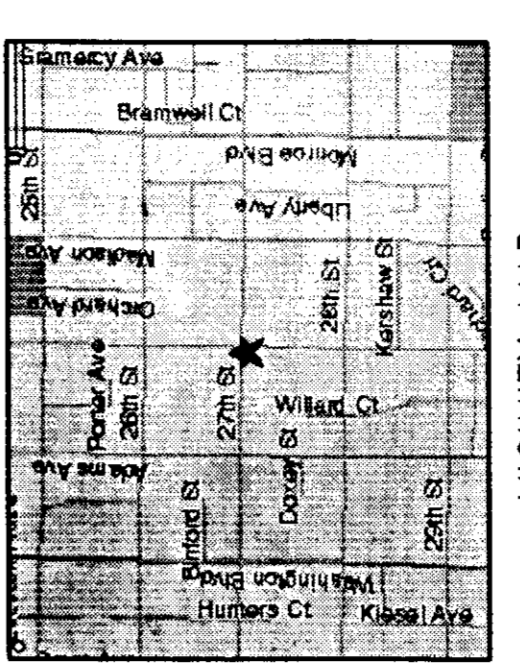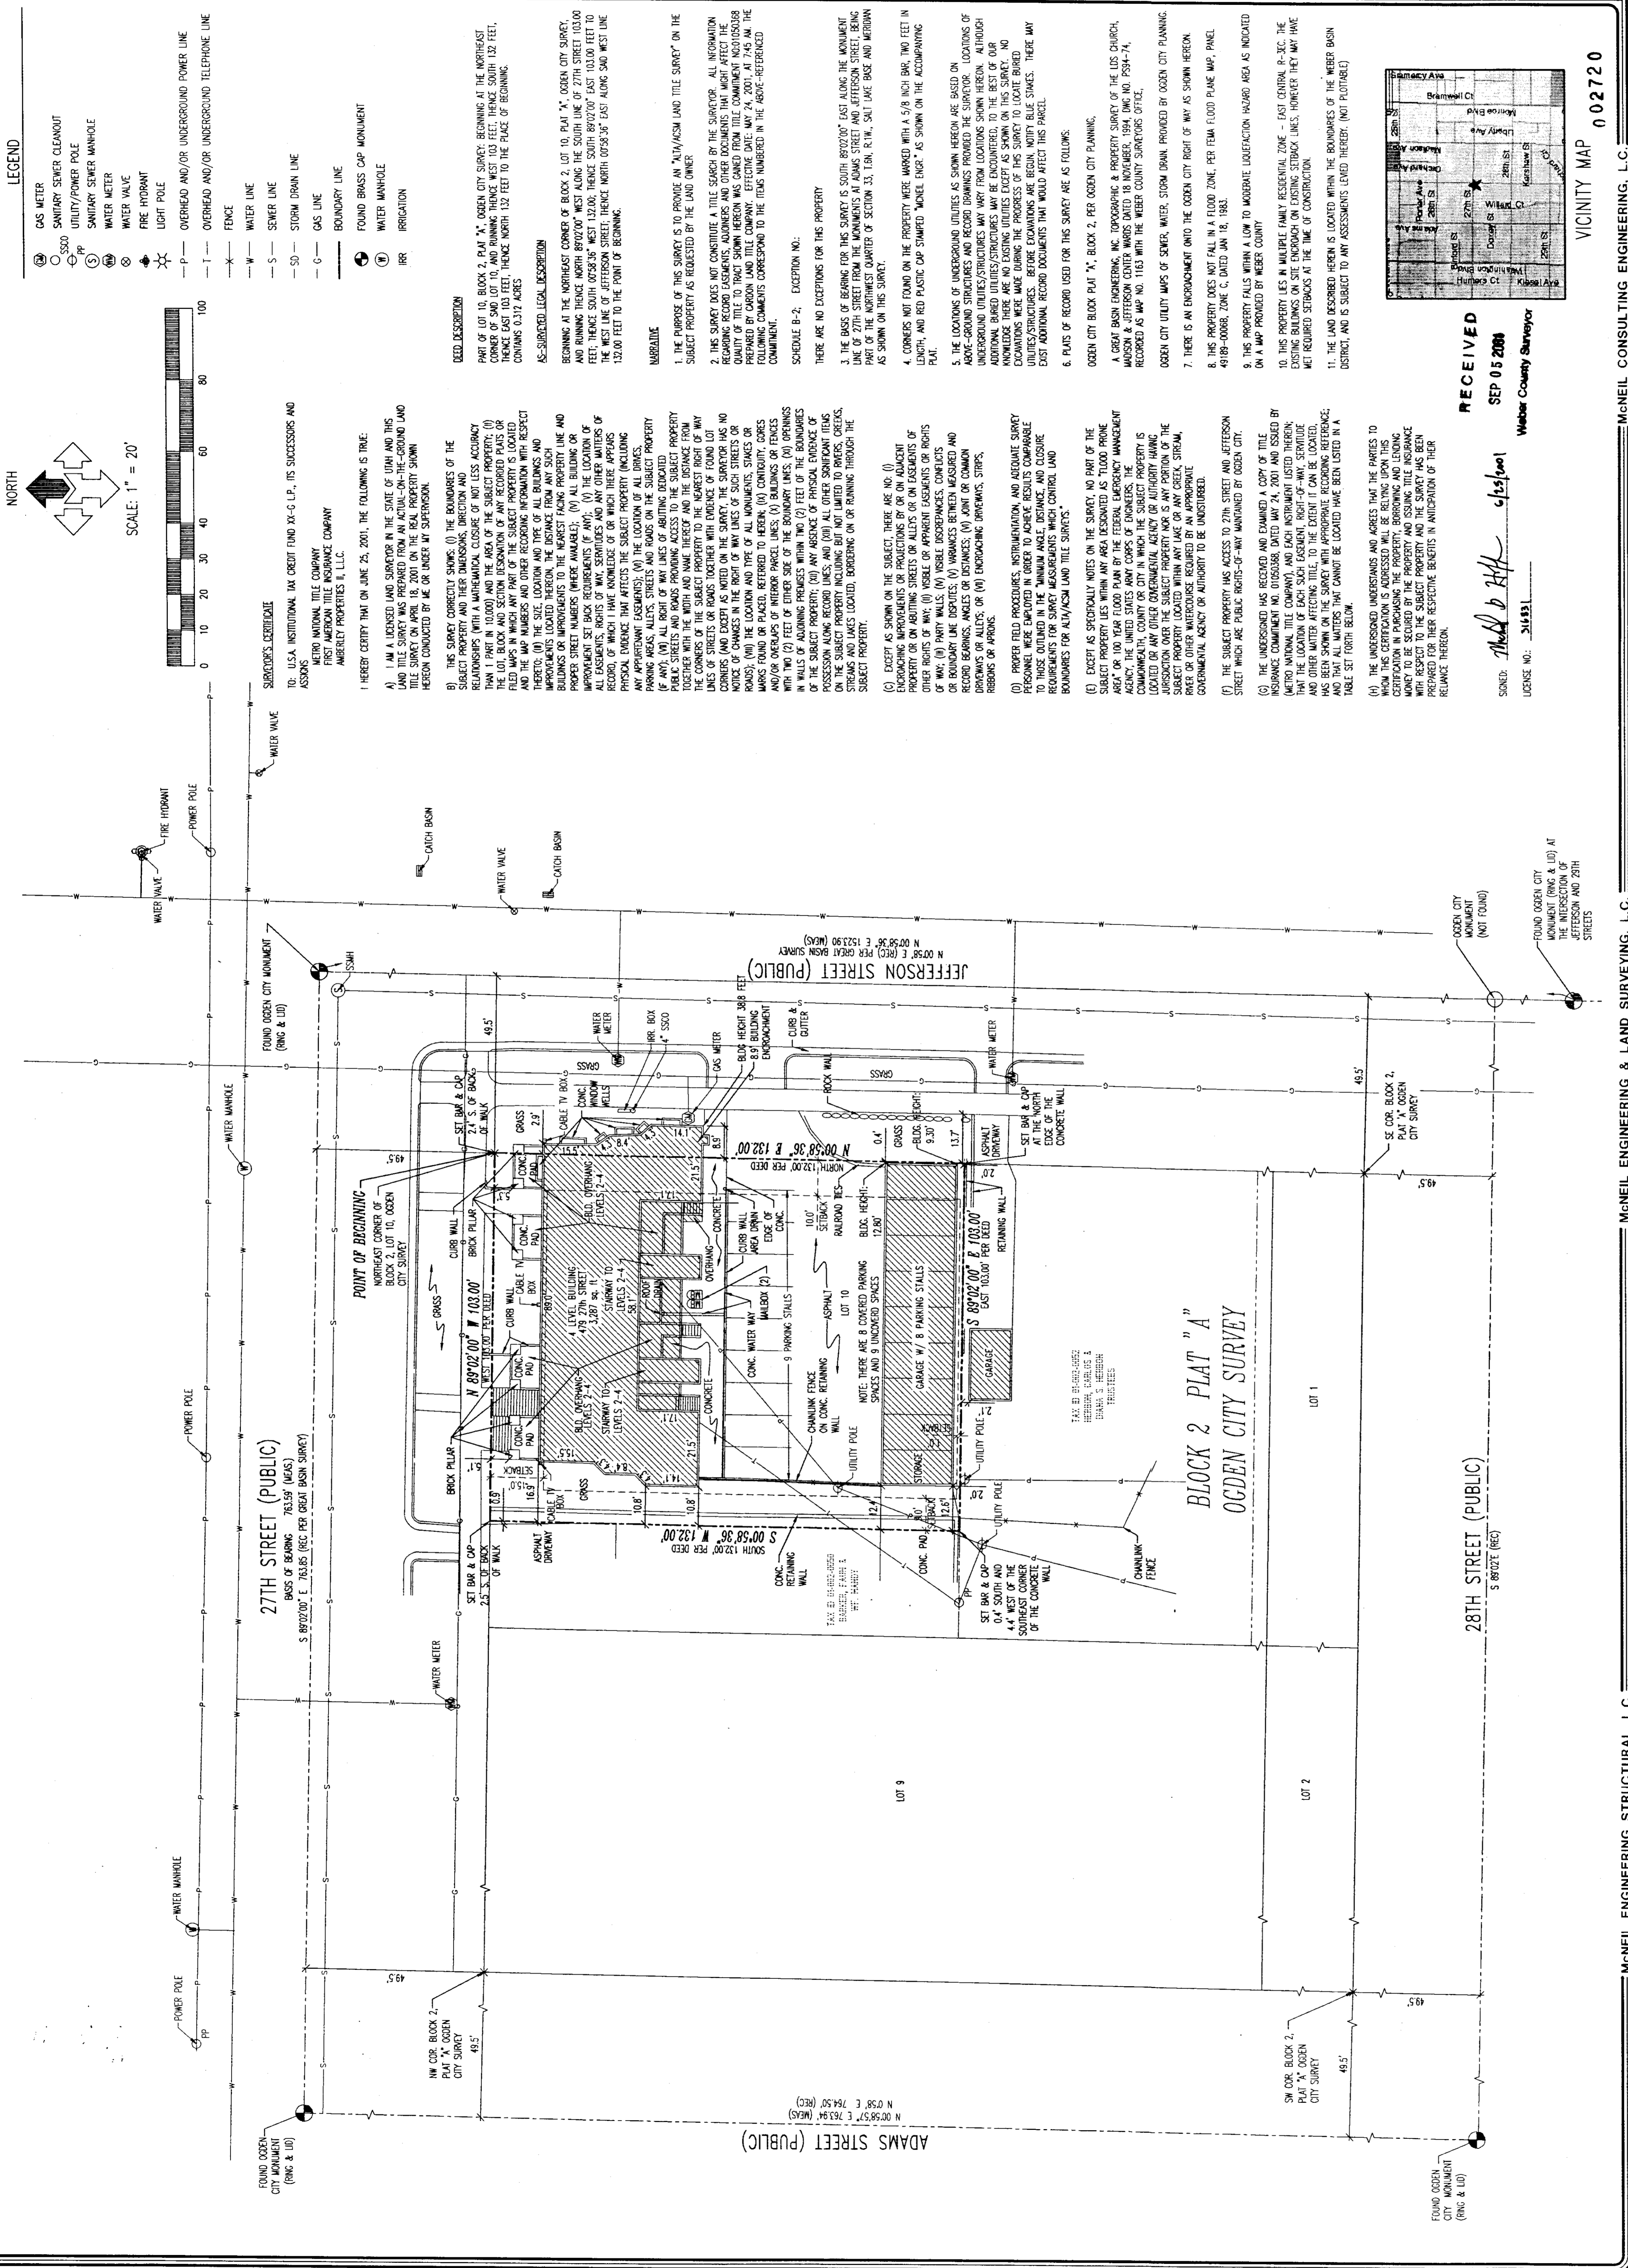

VICINITY MAP
 002720

RECEIVED
 SEP 05 2008
 Weber County Surveyors

LEGEND

- GAS METER
- SANITARY SEWER CLEANOUT
- SANITARY SEWER MANHOLE
- WATER METER
- WATER VALVE
- FIRE HYDRANT
- LIGHT POLE
- OVERHEAD AND/OR UNDERGROUND POWER LINE
- OVERHEAD AND/OR UNDERGROUND TELEPHONE LINE
- FENCE
- WATER LINE
- SEWER LINE
- STORM DRAIN LINE
- GAS LINE
- BOUNDARY LINE
- FOUND BRASS CAP MONUMENT
- WATER MANHOLE
- IRRIGATION

DEED DESCRIPTION


 1. THE PURPOSE OF THIS SURVEY IS TO PROVIDE AN ALTA/CSM LAND TITLE SURVEY ON THE SUBJECT PROPERTY AS REQUESTED BY THE LAND OWNER.
 3. THERE ARE NO EXCEPTIONS FOR THIS PROPERTY.
 4. CORNERS NOT FOUND ON THE PROPERTY WERE MARKED WITH 5/8 INCH IRON RODS TWO FEET IN LENGTH, AND RED PLASTIC CAP STAMPED "MCNEIL ENG." AS SHOWN ON THE ACCOMPANYING PLAN.
 5. THE LOCATIONS OF UNDERGROUND UTILITIES AS SHOWN HEREON ARE BASED ON ABOVE-GROUND STRUCTURES AND RECORD DRAWINGS PROVIDED BY THE SURVEYOR. LOCATIONS OF UNDERGROUND UTILITIES/STRUCTURES MAY VARY FROM LOCATIONS SHOWN HEREON. ALTHOUGH THE SURVEYOR HAS MADE A VISUAL INSPECTION OF THE PROPERTY, HE HAS NO KNOWLEDGE OF ANY UNDERGROUND UTILITIES/STRUCTURES EXCEPT AS SHOWN ON THIS SURVEY, AND NO WARRANTIES ARE MADE DURING THE PROGRESS OF THIS SURVEY TO LOCATE BURIED UTILITIES/STRUCTURES. BEFORE EXCAVATIONS ARE BEGUN, OWNERS SHOULD CONSULT WITH LOCAL AGENCIES TO OBTAIN RECORD DRAWINGS THAT WOULD AFFECT THIS PROJECT.
 6. PLATS OF RECORD USED FOR THIS SURVEY ARE AS FOLLOWS:
 OGDEN CITY BLOCK PLAT "A", BLOCK 2, PER OGDEN CITY PLANNING.

 7. THERE IS AN ENCROACHMENT ONTO THE OGDEN CITY RIGHT OF WAY AS SHOWN HEREON.
 8. THE PROPERTY DOES NOT FALL IN A FLOOD ZONE, PER FEMA FLOOD PLANE MAP PANEL 49189-0008R, ZONE C, DATED JAN. 18, 1983.

RECEIVED
 SEP 05 2008
 Weber County Surveyors