


LOCATED IN THE SW/4 SEC. 32  
T. 6 N. R. 1 W. S.L.B. & M.

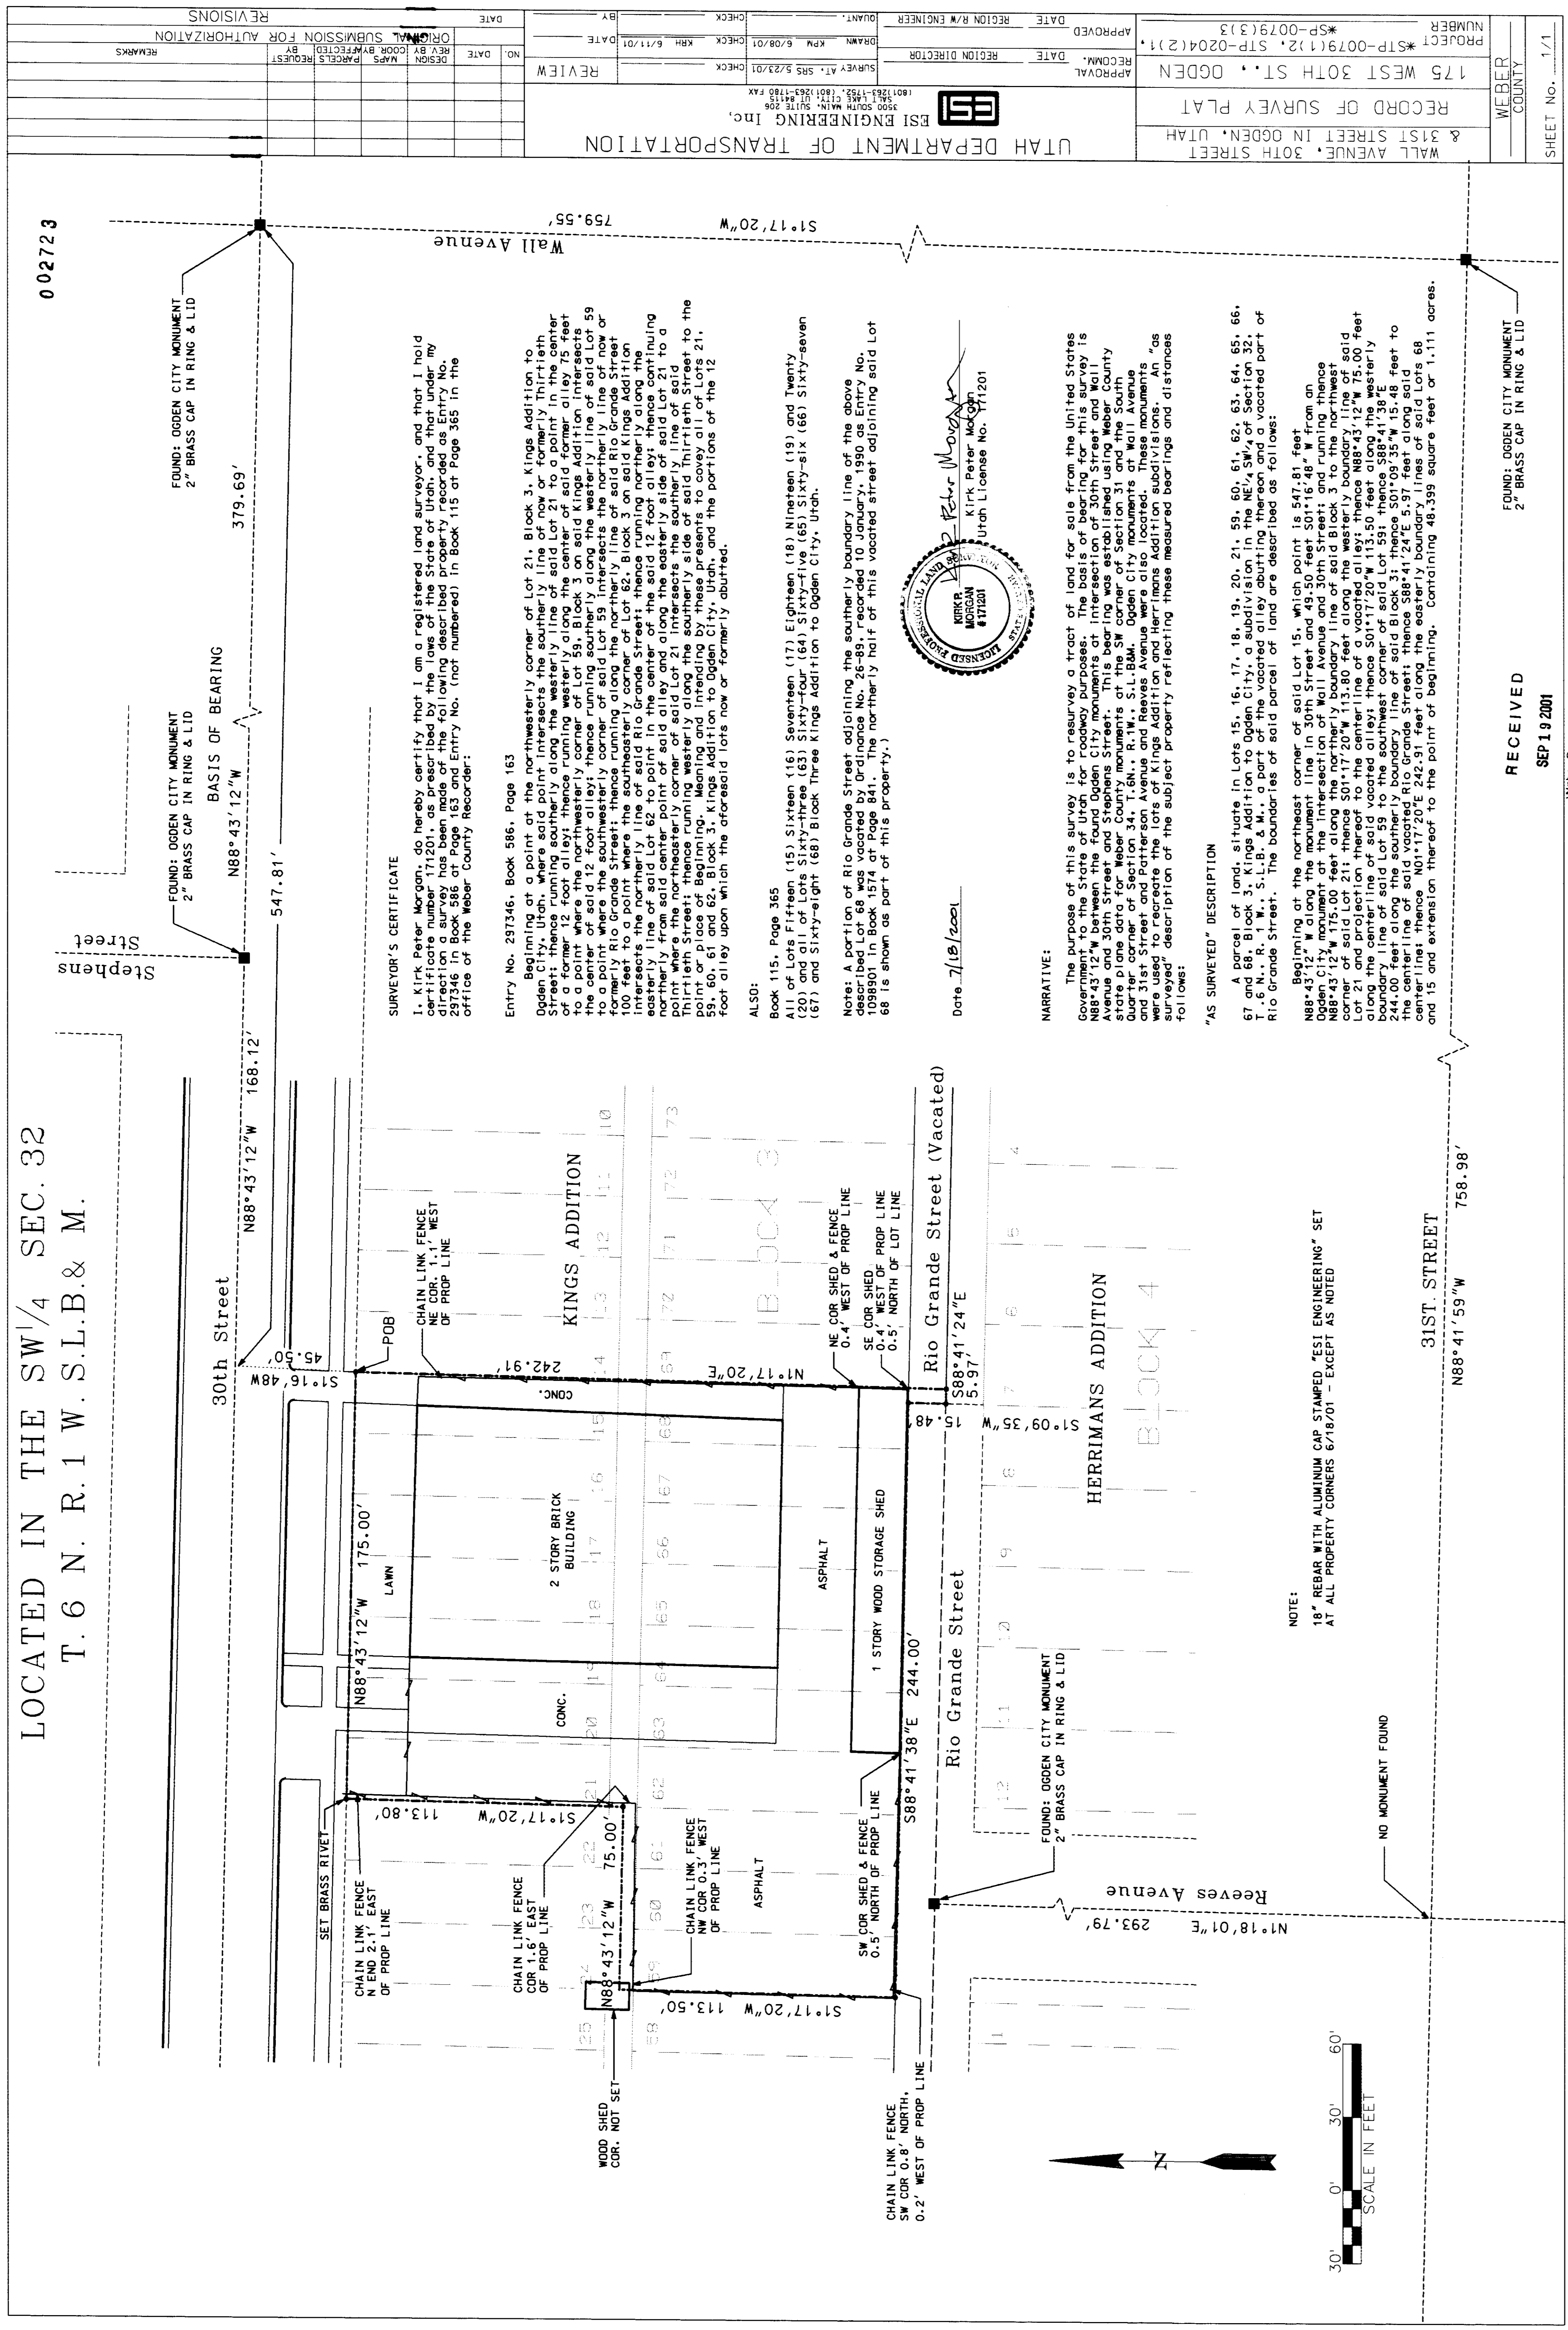


0 0272 3

002723

**SURVEYOR'S CERTIFICATE**  


Entry No. 297346, Book 586, Page 163  


**ALSO:**  
 Book 115, Page 355  


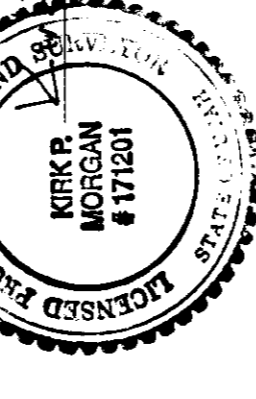

Date: 7/18/2001

**NARRATIVE:**

These monuments were used to recreate the lots of Kings Addition and Herrmans Addition subdivisions. An "as surveyed" description of the subject property reflecting these measured bearings and distances follows:

**"AS SURVEYED" DESCRIPTION**  
 A parcel of land, situate in Lots 15, 16, 17, 18, 19, 20, 21, 59, 60, 61, 62, 63, 64, 65, 66, 67 and 68, Block 3, Kings Addition to Ogden City, a subdivision in the NE 1/4 SW 1/4 of Section 32, T. 6 N., R. 1 W., S. L.B. & M., a part of the vacated alley abutting thereon and a vacated part of Rio Grande Street. The boundaries of said parcel of land are described as follows:  


**NOTE:**  
 18" REBAR WITH ALUMINUM CAP STAMPED "ESI ENGINEERING" SET  
 AT ALL PROPERTY CORNERS 6/18/01 - EXCEPT AS NOTED

RECEIVED  
 SEP 19 2001

0 0272 3

002723