
- NORTHWEST CORNER OF SECTION

8, T.6N., R.1W., S.L.B.&M., U.S.

REVISIONS

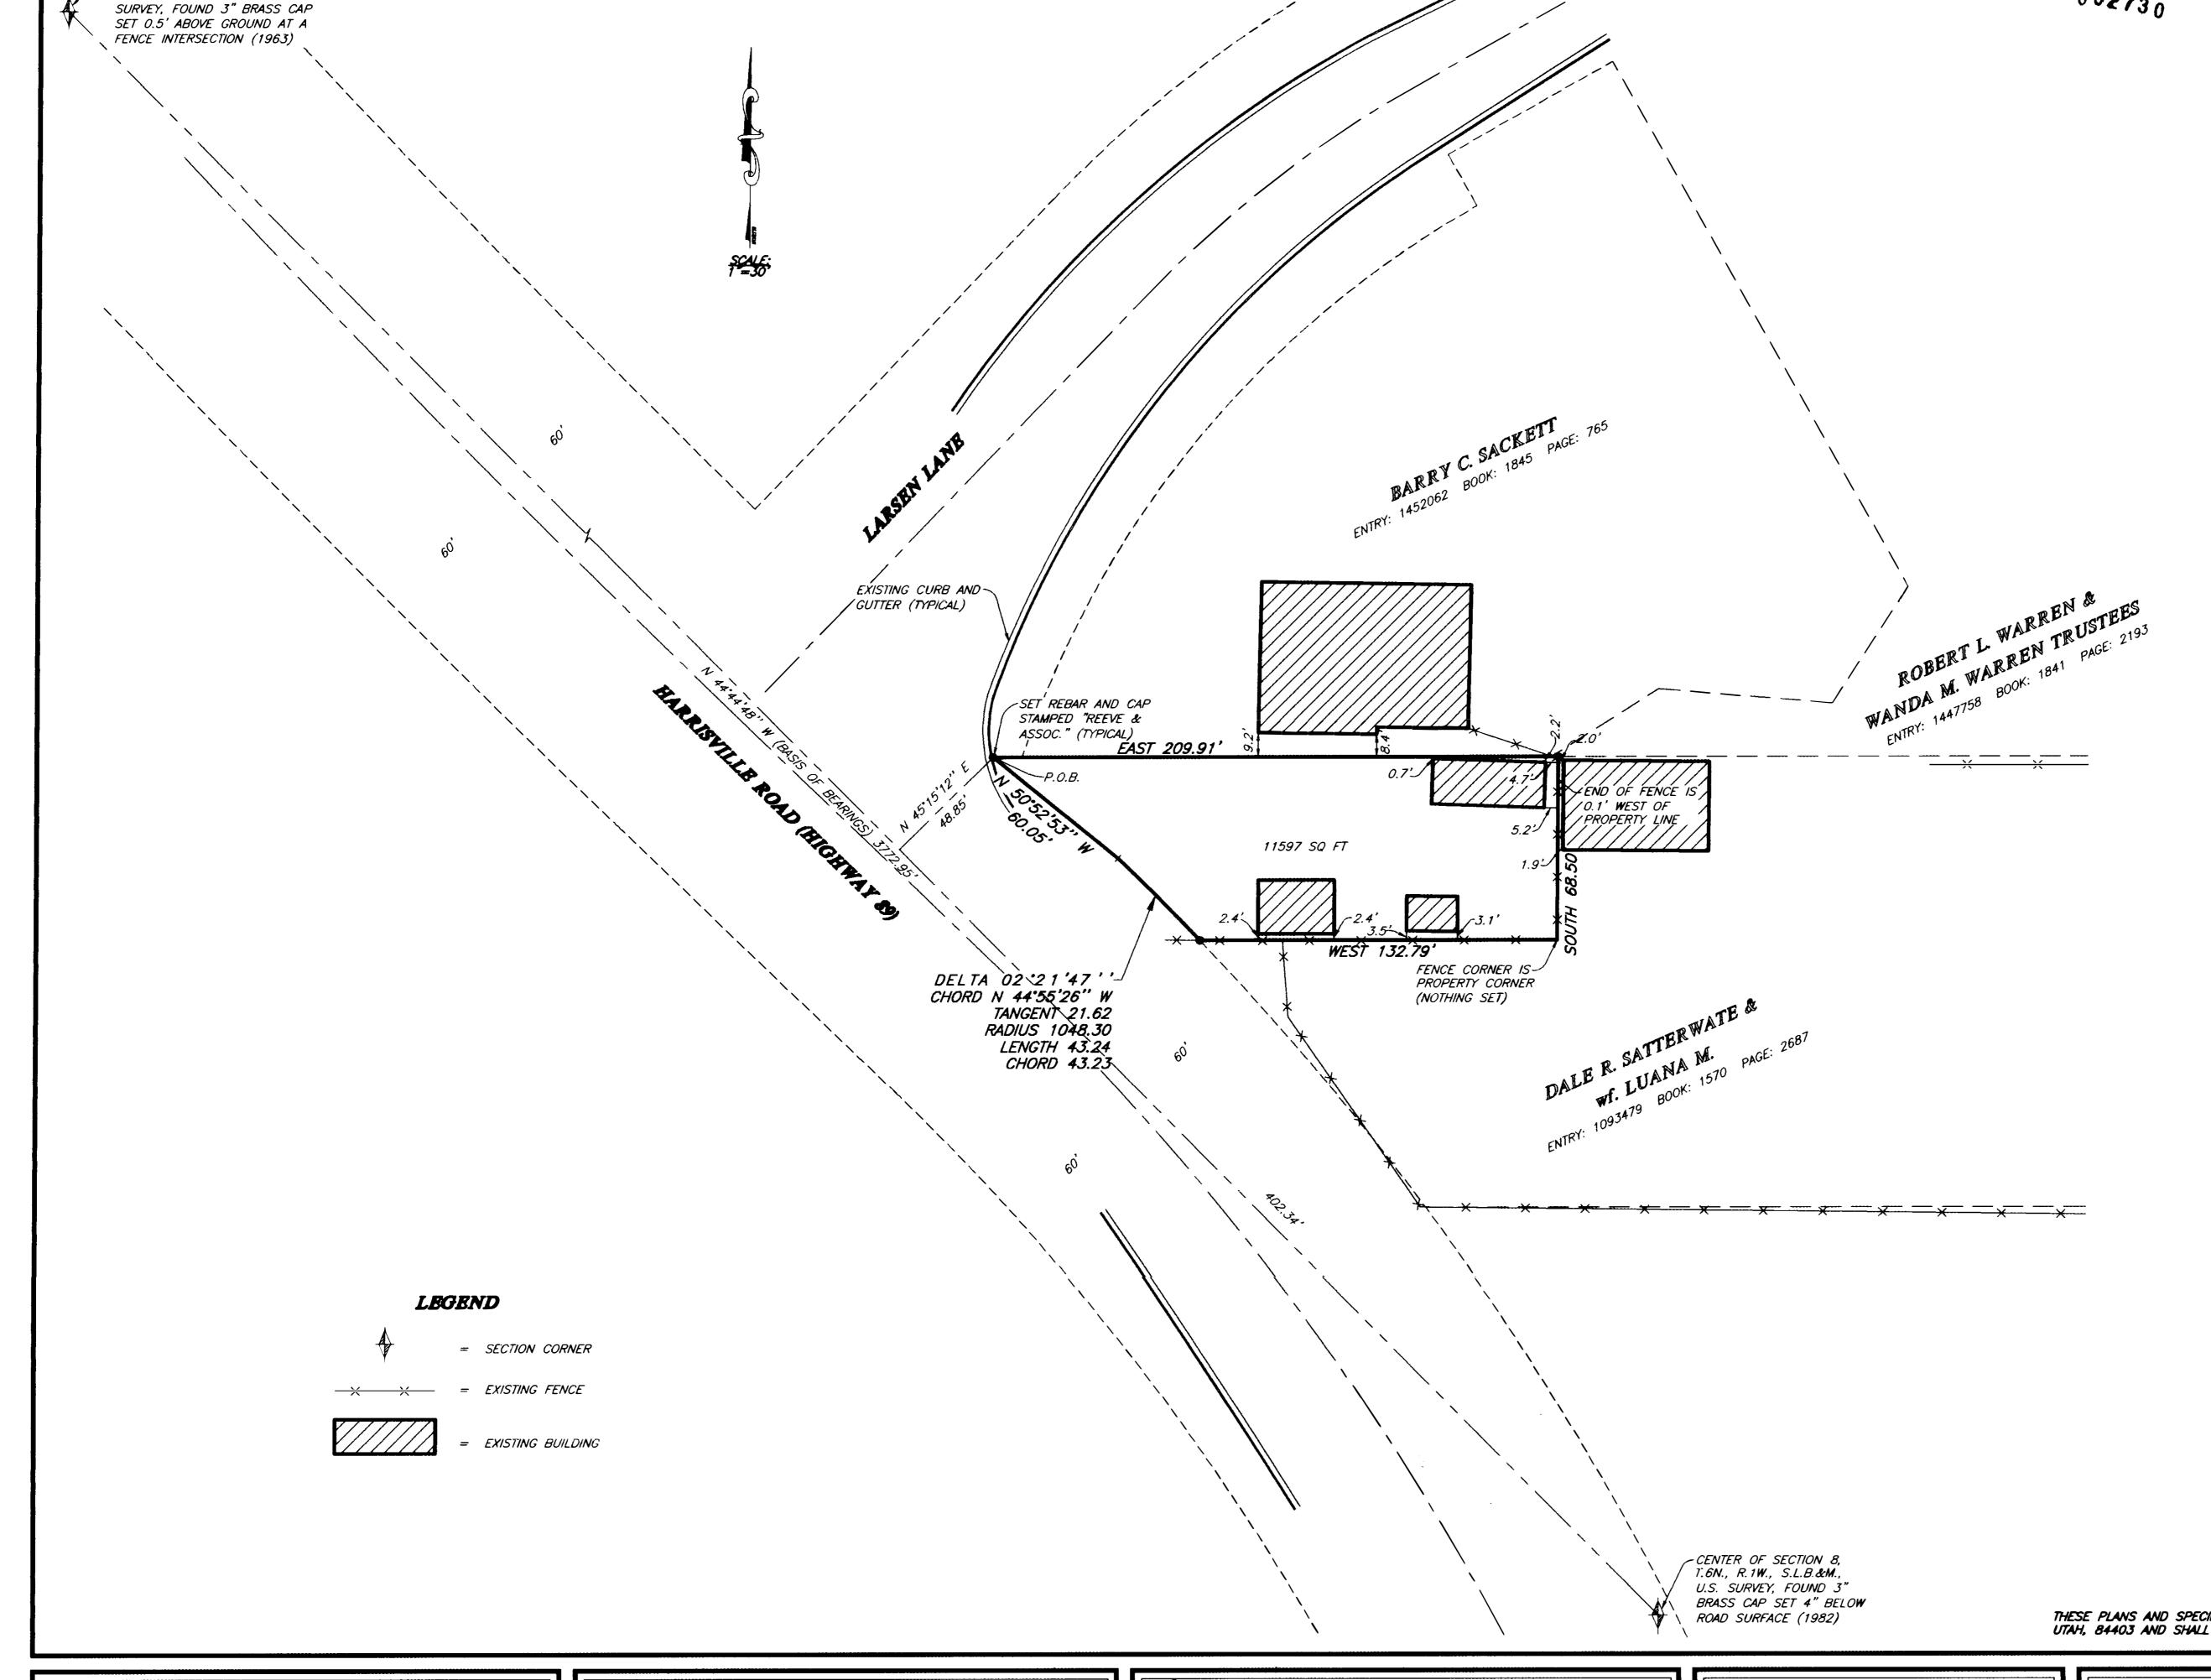

PROJECT NO.: 4155-01 SURVEYOR: R.MILLFORD

SURVEYOR'S CERTIFICATE

I, RANDALL J. WILLIFORD, DEPOSE AND SAY THAT I AM A LICENSED PROFESSIONAL LAND SURVEYOR, HOLDING UTAH LICENSE NUMBER 159437, THAT A SURVEY OF THE PROPERTY DESCRIBED HEREON WAS PERFORMED BY ME OR UNDER MY DIRECTION, AND THAT THIS PLAT CORRECTLY DEPICTS THE FINDINGS OF THAT SURVEY.

BASIS OF BEARINGS

THE BASIS OF BEARINGS FOR THIS PLAT IS THE LINE BETWEEN THE CENTER AND THE NORTHWEST CORNER OF SECTION 8, 1.6N., R.1W., S.L.B.&M., U.S. SURVEY, SHOWN HEREON AS: N44°44'48"W

NARRATIVE

THE PURPOSE OF THIS SURVEY IS TO DEFINE THE DINSDALE PROPERTY FOR NORM DINSDALE. THE WESTERLY LINES WERE FIXED BY THE EAST RIGHT-OF-WAY LINE OF HARRISVILLE ROAD (HIGHWAY 89). THE EAST AND SOUTH LINES WERE FIXED BY AN EXISTING FENCE. ALL OTHER LINES WERE FIXED BY DEED.

SURVEYED DESCRIPTION

PART OF THE NORTHWEST QUARTER OF SECTION 8, T.6N., R.1W., S.L.B.&M., U.S. SURVEY, DESCRIBED AS FOLLOWS:

BEGINNING AT THE INTERSECTION OF THE EAST RIGHT-OF-WAY LINE OF HARRISVILLE ROAD (HIGHWAY 89) AND THE SOUTH RIGHT-OF-WAY LINE OF LARSEN LANE, SAID POINT BEING N44°44'48"W ALONG THE LINE BETWEEN THE CENTER AND THE NORTHWEST CORNER OF SAID SECTION 8 402.34 FEET, AND N45°15'12"E 48.85 FEET FROM SAID CENTER OF SAID SECTION 8; THENCE EAST 209.91 FEET TO AN EXTENSION OF A FENCE; THENCE ALONG SAID EXTENSION AND FENCE SOUTH 68.50 FEET AND WEST 132.79 FEET TO SAID EAST RIGHT-OF-WAY LINE AND A 1048.30 FOOT RADIUS CURVE THE CENTER OF WHICH BEARS \$46°15'27"W; THENCE ALONG SAID EAST LINE AND CURVE TO THE LEFT THROUGH A CENTRAL ANGLE OF 02°21'47" A DISTANCE OF 43.24 FEET AND N50°52'53"W 60.05 FEET TO THE POINT OF BEGINNING.

CONTAINS: 11597 SQUARE FEET

DEED DESCRIPTION

PART OF THE NORTHWEST QUARTER OF SECTION 8, TOWNSHIP 6 NORTH, RANGE 1 WEST, SALT LAKE MERIDIAN, U.S. SURVEY: BEGINNING AT A POINT 331.8 FEET NORTH AND 42.7 FEET WEST FORM THE SOUTHEAST CORNER OF SAID NORTHWEST QUARTER OF SAID SECTION 8; RUNNING THENCE SOUTH 68.5 FEET; THENCE WEST 150 FEET, MORE OR LESS, TO THE EAST LINE OF HARISVILLE ROAD; THENCE NORTH 39*45' WEST ALONG SAID EAST LINE OF SAID ROAD 79.07 FEET, MORE OR LESS, TO A POINT SOUTH 39*45' EAST 118 FEET FROM THE SOUTH LINE OF MONTGOMERY AVENUE; THENCE EAST 201.33 FEET TO THE POINT OF BEGINNING.

EXCEPT THEREFROM THAT PART DEEDED TO UTAH DEPARTMENT OF TRANSPORTATION.

PECEIVED

OCT 1 0 2001
Weber County Surveyor

THESE PLANS AND SPECIFICATIONS ARE THE PROPERTY OF REEVE & ASSOC., INC., 3670 QUINCY AVE., OGDEN, UTAH, 84403 AND SHALL NOT BE COPIED OR REDUCED OR REPRODUCED WITHOUT THEIR WRITTEN PERMISSION.



RECORD OF SURVEY

DINSDALE PROPERTY
PART OF THE NORTHWEST QUARTER OF SECTION 8, T. SN., R. 1 W., S.L.B.&M., U.S. SURVEY
HARRISVILLE CITY, WEBER COUNTY, UTAH
DECEMBER, 2000

