


0 0 2 7 3 1

0 0 2 7 3 1

SURVEYOR'S CERTIFICATE
 I, RANDALL J. WILFORD, DEPOSE AND SAY THAT I AM A LICENSED PROFESSIONAL LAND SURVEYOR, HOLDING UTAH LICENSE NUMBER 159437. THAT THE SURVEY HEREIN SHOWN WAS PERFORMED BY ME OR UNDER MY DIRECTION, AND THAT THIS PLAT CORRECTLY DEPICTS THE FINDINGS OF THAT SURVEY.
 SIGNED THIS 7th DAY OF SEPTEMBER 2001.

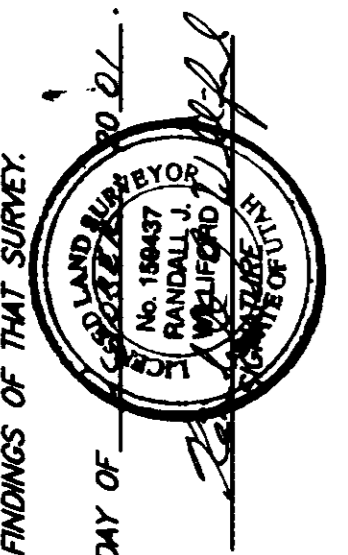

UTAH LICENSE NUMBER
 159437

DATE OF SURVEY
 09/07/01

DATE OF QUARTER CORNER SURVEY
 02/28/00

DATE OF QUARTER CORNER SURVEY
 02/28/00

BASE OF BEARINGS


THE BASIS OF BEARINGS FOR THIS PLAT IS THE UTAH COORDINATE SYSTEM. THE NORTH QUARTER CORNER AND THE EAST QUARTER CORNER OF SECTION 26, T.6N., R.2W., S.16.84N., U.S. SURVEY, SHOWN HEREON AS: 50050713.7

NARRATIVE



SURVEYED DESCRIPTION

PART OF THE NORTHWEST QUARTER OF SECTION 26, T.6N., R.2W., S.16.84N., U.S. SURVEY, DESCRIBED AS FOLLOWS:


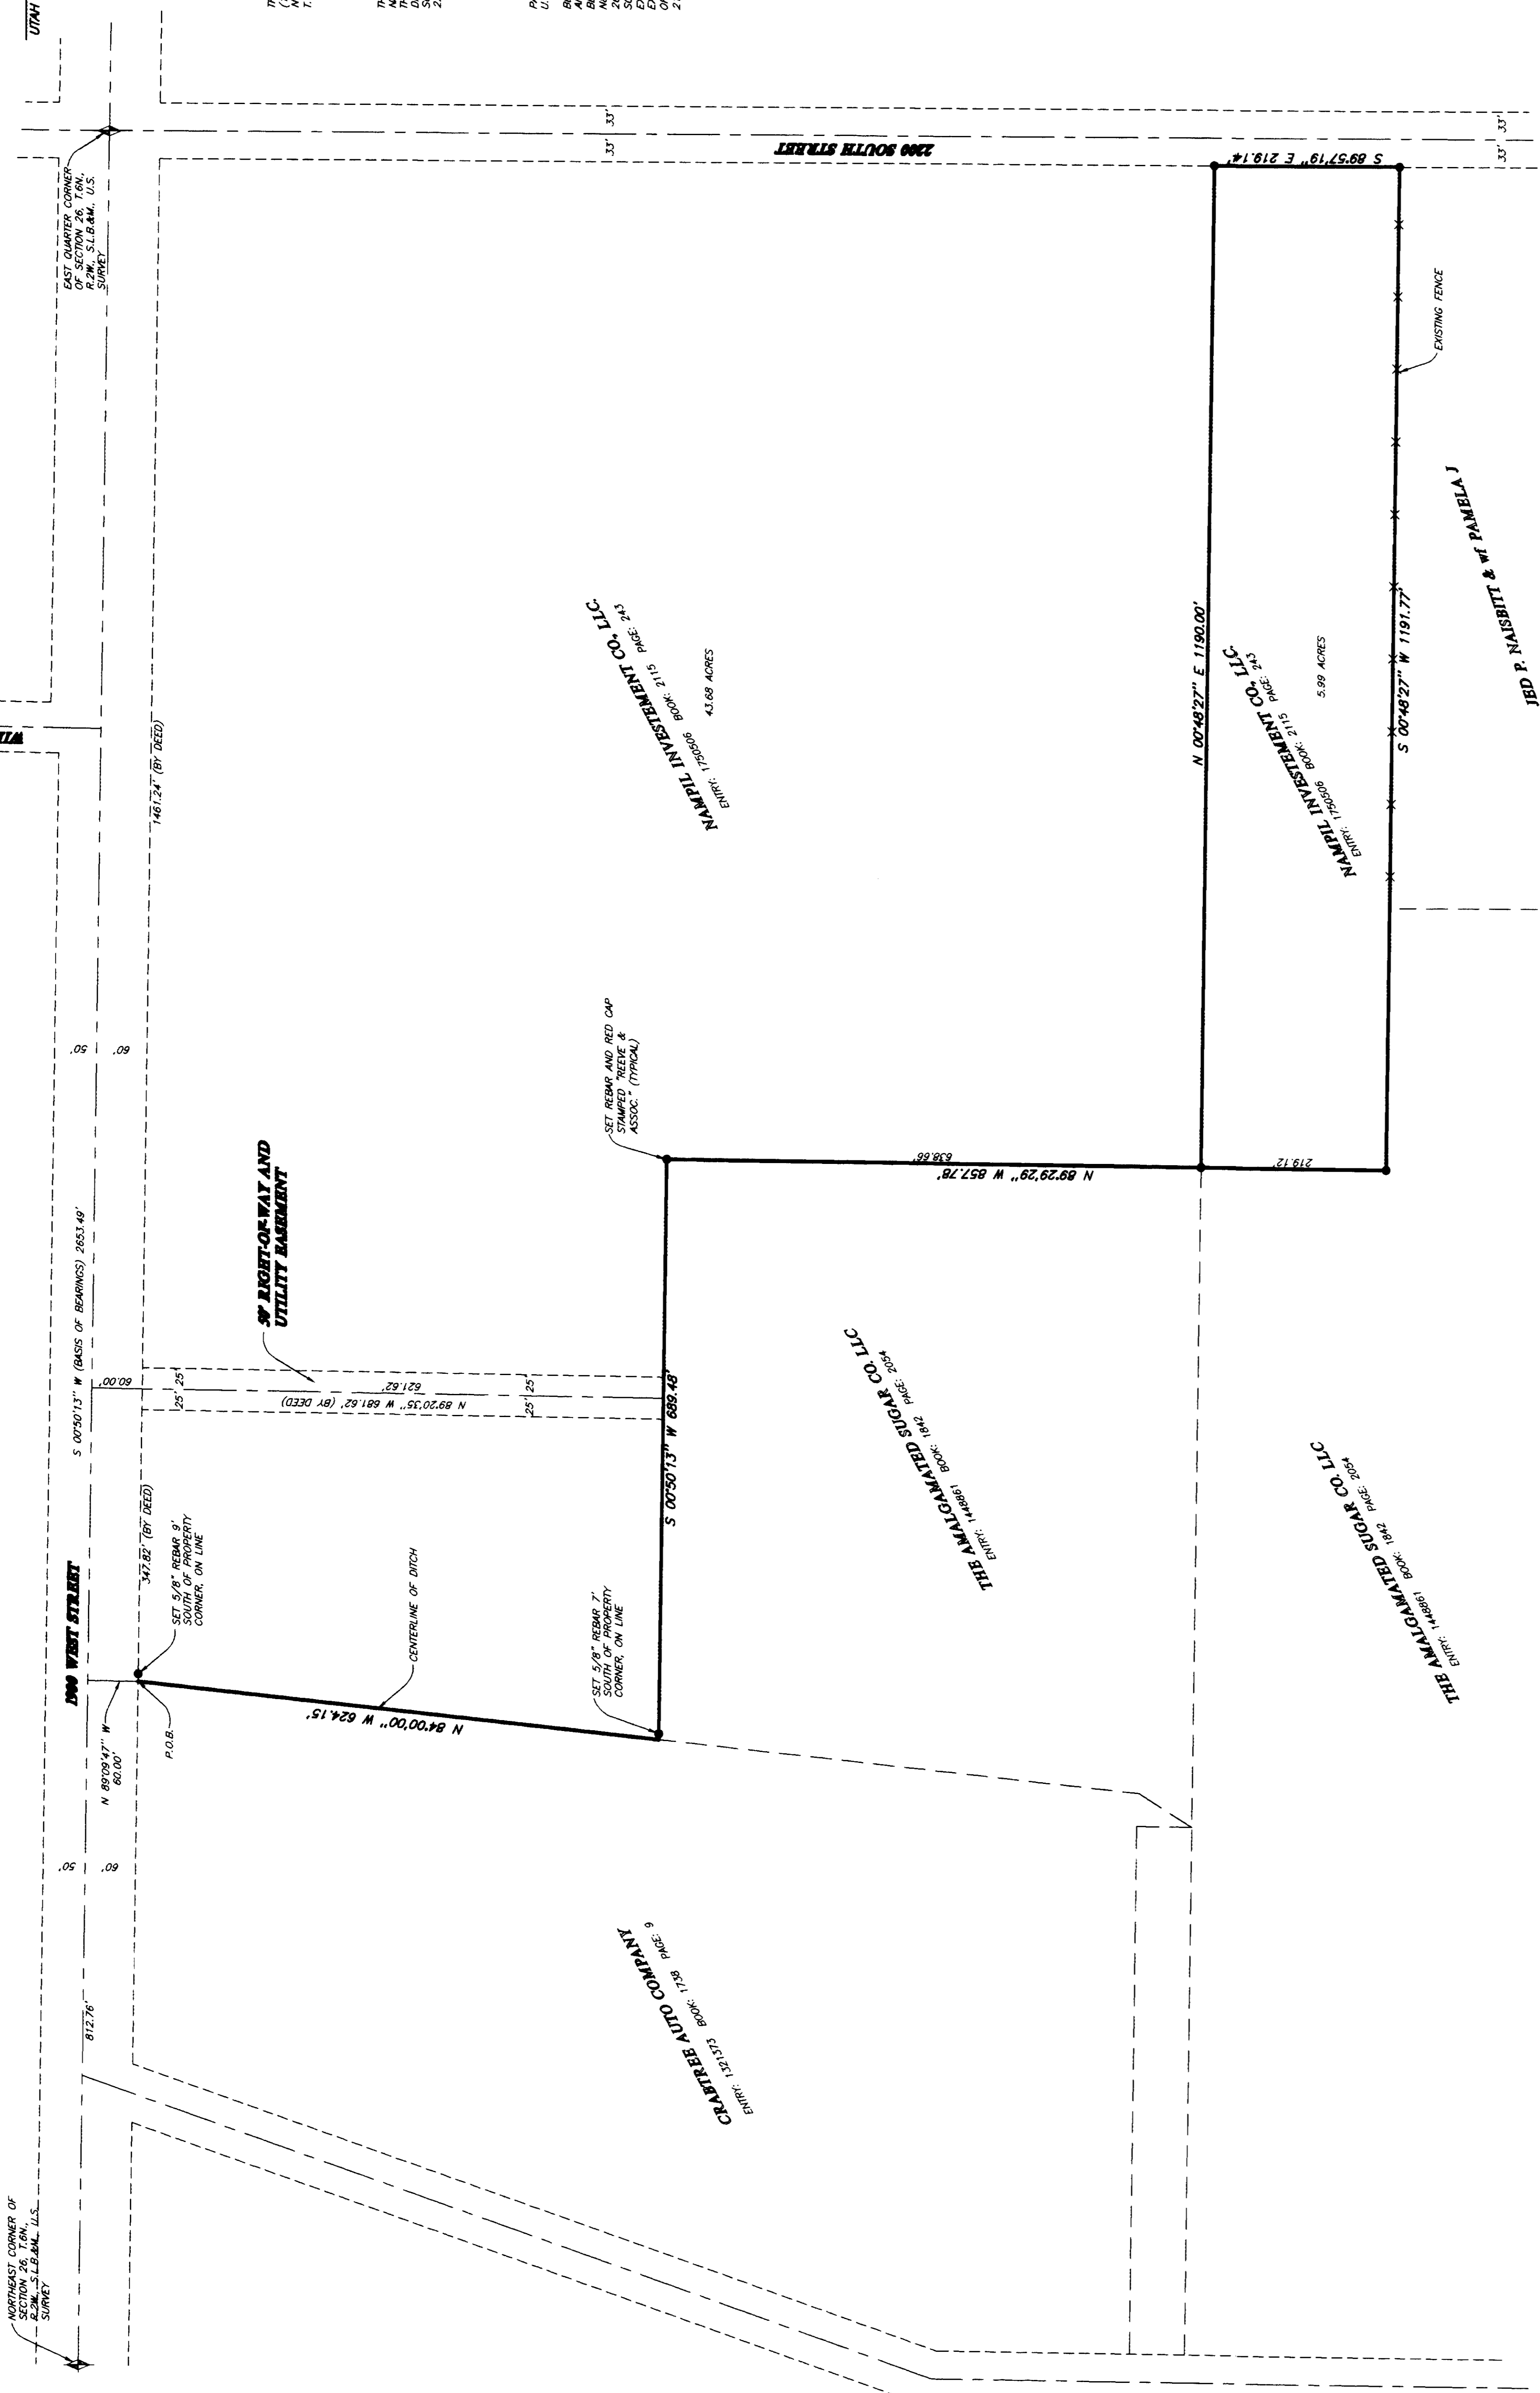

RECEIVED
 OCT 1 0 2001
 Weber County Surveyor

0 0 2 7 3 1

THESE PLANS AND SPECIFICATIONS ARE THE PROPERTY OF REEVE & ASSOCIATES, INC. 3870 DOWNEY AVE. GOSBY, UTAH, 84403 AND SHALL NOT BE COPIED OR REPRODUCED WITHOUT THEIR WRITTEN PERMISSION.

RECORD OF SURVEY
 PART OF THE NORTHWEST QUARTER OF SECTION 26, T.6N., R.2W., S.16.84N., U.S. SURVEY
 MARCH, 2001

RECORD OF SURVEY

REEVE & ASSOCIATES, INC.
 Civil Engineering • Structural Engineering
 Surveying • Planning • Construction
 3870 DOWNEY AVE. STE. #1
 GOSBY, UTAH 84403
 (801) 621-1100 FAX (801) 621-2866 (435) 752-3300 FAX (435) 752-2266

PROJECT NO. _____ SURVEYOR _____
 DATE _____ OWNER _____
 SCALE _____ CHECKED _____

REVISIONS
 1. _____
 2. _____
 3. _____

SHEETS
 1
 1

002731

002731

002731

002731