


**SURVEYOR'S CERTIFICATE**

I, Larry M. Buttars, a registered Land Surveyor as prescribed by the laws of the State of Utah, and holding license No. 2596 do hereby certify that I have made a Survey of the below described property and the plat hereon is a true and correct representation of said survey.

DATE: 9-10-87 SIGN: *Larry M. Buttars*  
LARRY M. BUTTARS

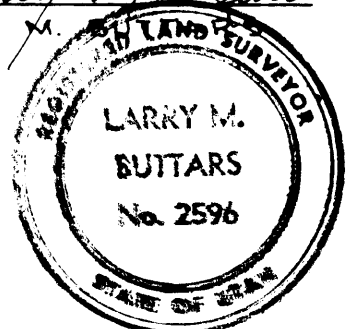

**DESCRIPTION**

A part of lot 1, Block 71, Plat C, Ogden City Survey: Beginning at a point 50 ft. North of the Southeast corner of said lot 1; running thence West 132.00 ft; thence North 52.00 ft.; thence East 132.00 ft; thence South 52.00 ft. to the place of beginning.  
Situat in the N.W. 1/4 of Section 34, T.6 N. R. 1.W. S.L.B. & M.

**NARRATIVE**

The purpose of this Survey was to determine where the property lines were in relation to occupation all bearings were rotated from East-West North-South to conform with the Ogden City Survey Plats and monumentation - Basis: N. 0° 58' E. given in deed as NORTH.

**LEGEND**

- Set 1/2" x 24" re-bar with plastic cap stamped L. Buttars R.L.S. 2596.
- Set P.K. nail with ribbon

RECEIVED  
DEC 03 1990  
Weber County Surveyor

<b>BUTTARS SURVEYING</b>	
1815 26 <sup>TH</sup> STREET-OGDEN, UT. 84401	
PHONE 392-5291	
CLIENT:	MRS. K. WOOD
SURVEY LOCATION:	BLOCK 71, PLAT C, OGDEN CITY SURVEY
	2577 POLK AVE. OGDEN, UTAH
SURVEY DATE:	SEPT. 4, 1987