DRAWING NUMBER
000278

DRAWING NUMBER
000278

DRAWING NUMBER
000278

DRAWING NUMBER
000278

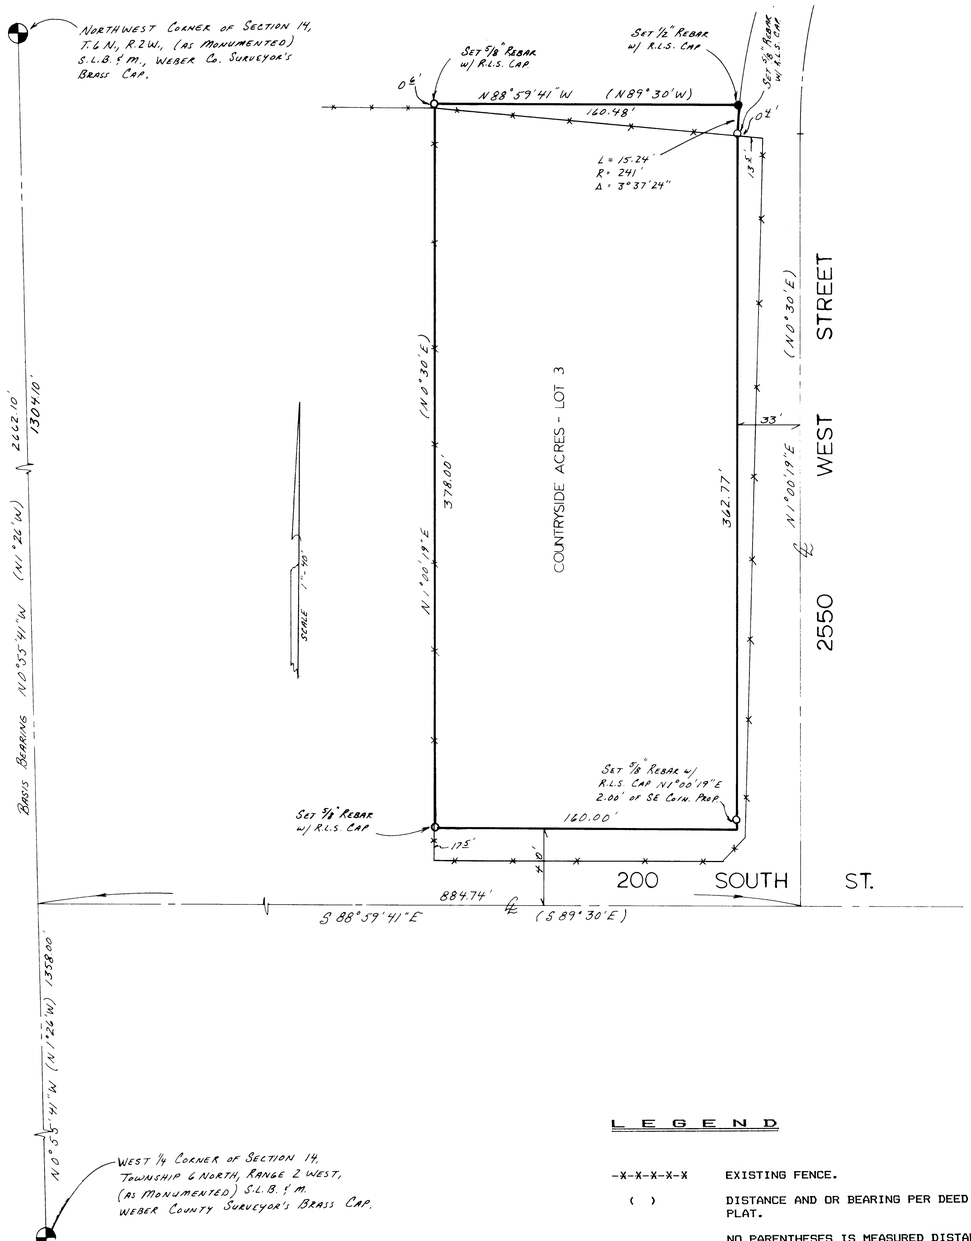

LEGAL DESCRIPTION

ALL OF LOT 3, COUNTRYSIDE ACRES SUBDIVISION, WEBER COUNTY, UTAH.

SURVEYOR'S CERTIFICATE

I CYNTHIA L. ROBINETT, DO HEREBY CERTIFY THAT I AM A REGISTERED LAND SURVEYOR, AND THAT I HOLD CERTIFICATE NO. 7511 AS PRESCRIBED BY THE LAWS OF THE STATE OF UTAH. AND THAT I HAVE MADE A SURVEY ON THE GROUND AND FROM RECORDS OF THE WEBER COUNTY RECORDERS OFFICE AND AS DESCRIBED ABOVE AND SHOWN PER THIS PLAT.

9/27/89
DATE

REGISTERED LAND SURVEYOR NO. 7511 CYNTHIA L. ROBINETT STATE OF UTAH

Cynthia L. Robinett
CYNTHIA L. ROBINETT R.L.S.7511

NARRATIVE

THE PURPOSE OF THIS SURVEY WAS TO RESURVEY A PARCEL OF GROUND LOCATED IN COUNTRYSIDE ACRES SUBDIVISION, WEBER COUNTY, FOR DAVE GRANT. BASIS OF BEARINGS BEING STATE PLANE N. 0° 55' 41" W. ALONG THE WEST LINE OF THE NORTHWEST QUARTER OF SECTION 14, TOWNSHIP 6 NORTH, RANGE 2 WEST, (AS MONUMENTED).

LEGEND

-X-X-X-X-X	EXISTING FENCE.
( )	DISTANCE AND OR BEARING PER DEED OR PLAT.

NO PARENTHESES IS MEASURED DISTANCE OR ROTATED PLAT OR DEED BEARING TO STATE PLANE GRID BEARING.

RECEIVED
JAN 0 5 1990
Weber County Surveyor

CONSTRUCTION & LAND SURVEYORS INC.
1500 N. 5900 W.
OGDEN, UTAH 84404
(801) 731-1131

CLIENT: DAVE GRANT

SURVEY LOCATION:
N.W.1/4 SEC. 14,
TOWNSHIP 6 NORTH, RANGE 2 WEST,
SALT LAKE BASE & MERIDIAN.

SURVEY DATE: 9-25-89

JOB No. P.S.89-26

000278 000278