



SURVEYOR'S CERTIFICATE
 I, RANDALL J. HILLFORD, DEPOSE AND SAY THAT I AM A LICENSED PROFESSIONAL LAND SURVEYOR, HOLDING UTAH LICENSE NUMBER 158937, AND THAT THIS SURVEY WAS PERFORMED BY ME OR UNDER MY DIRECTION, AND THAT THIS PLAT CORRECTLY DEPICTS THE FINDINGS OF THAT SURVEY.

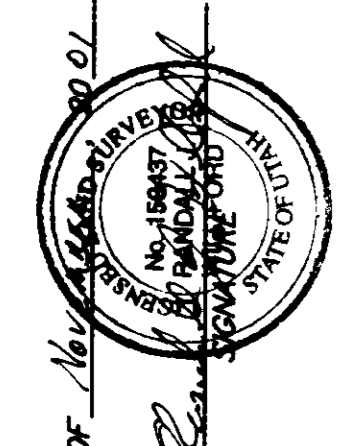

SIGNED THIS 5TH DAY OF Nov 2001.
 RANDALL J. HILLFORD
 UTAH LICENSE NUMBER 158937

SOUTHWEST CORNER OF SECTION 28, T.7N., R.2W., S.L.B.&M., U.S. SURVEY (LOCATION DETERMINED FROM WEBER COUNTY TIE SHEETS)

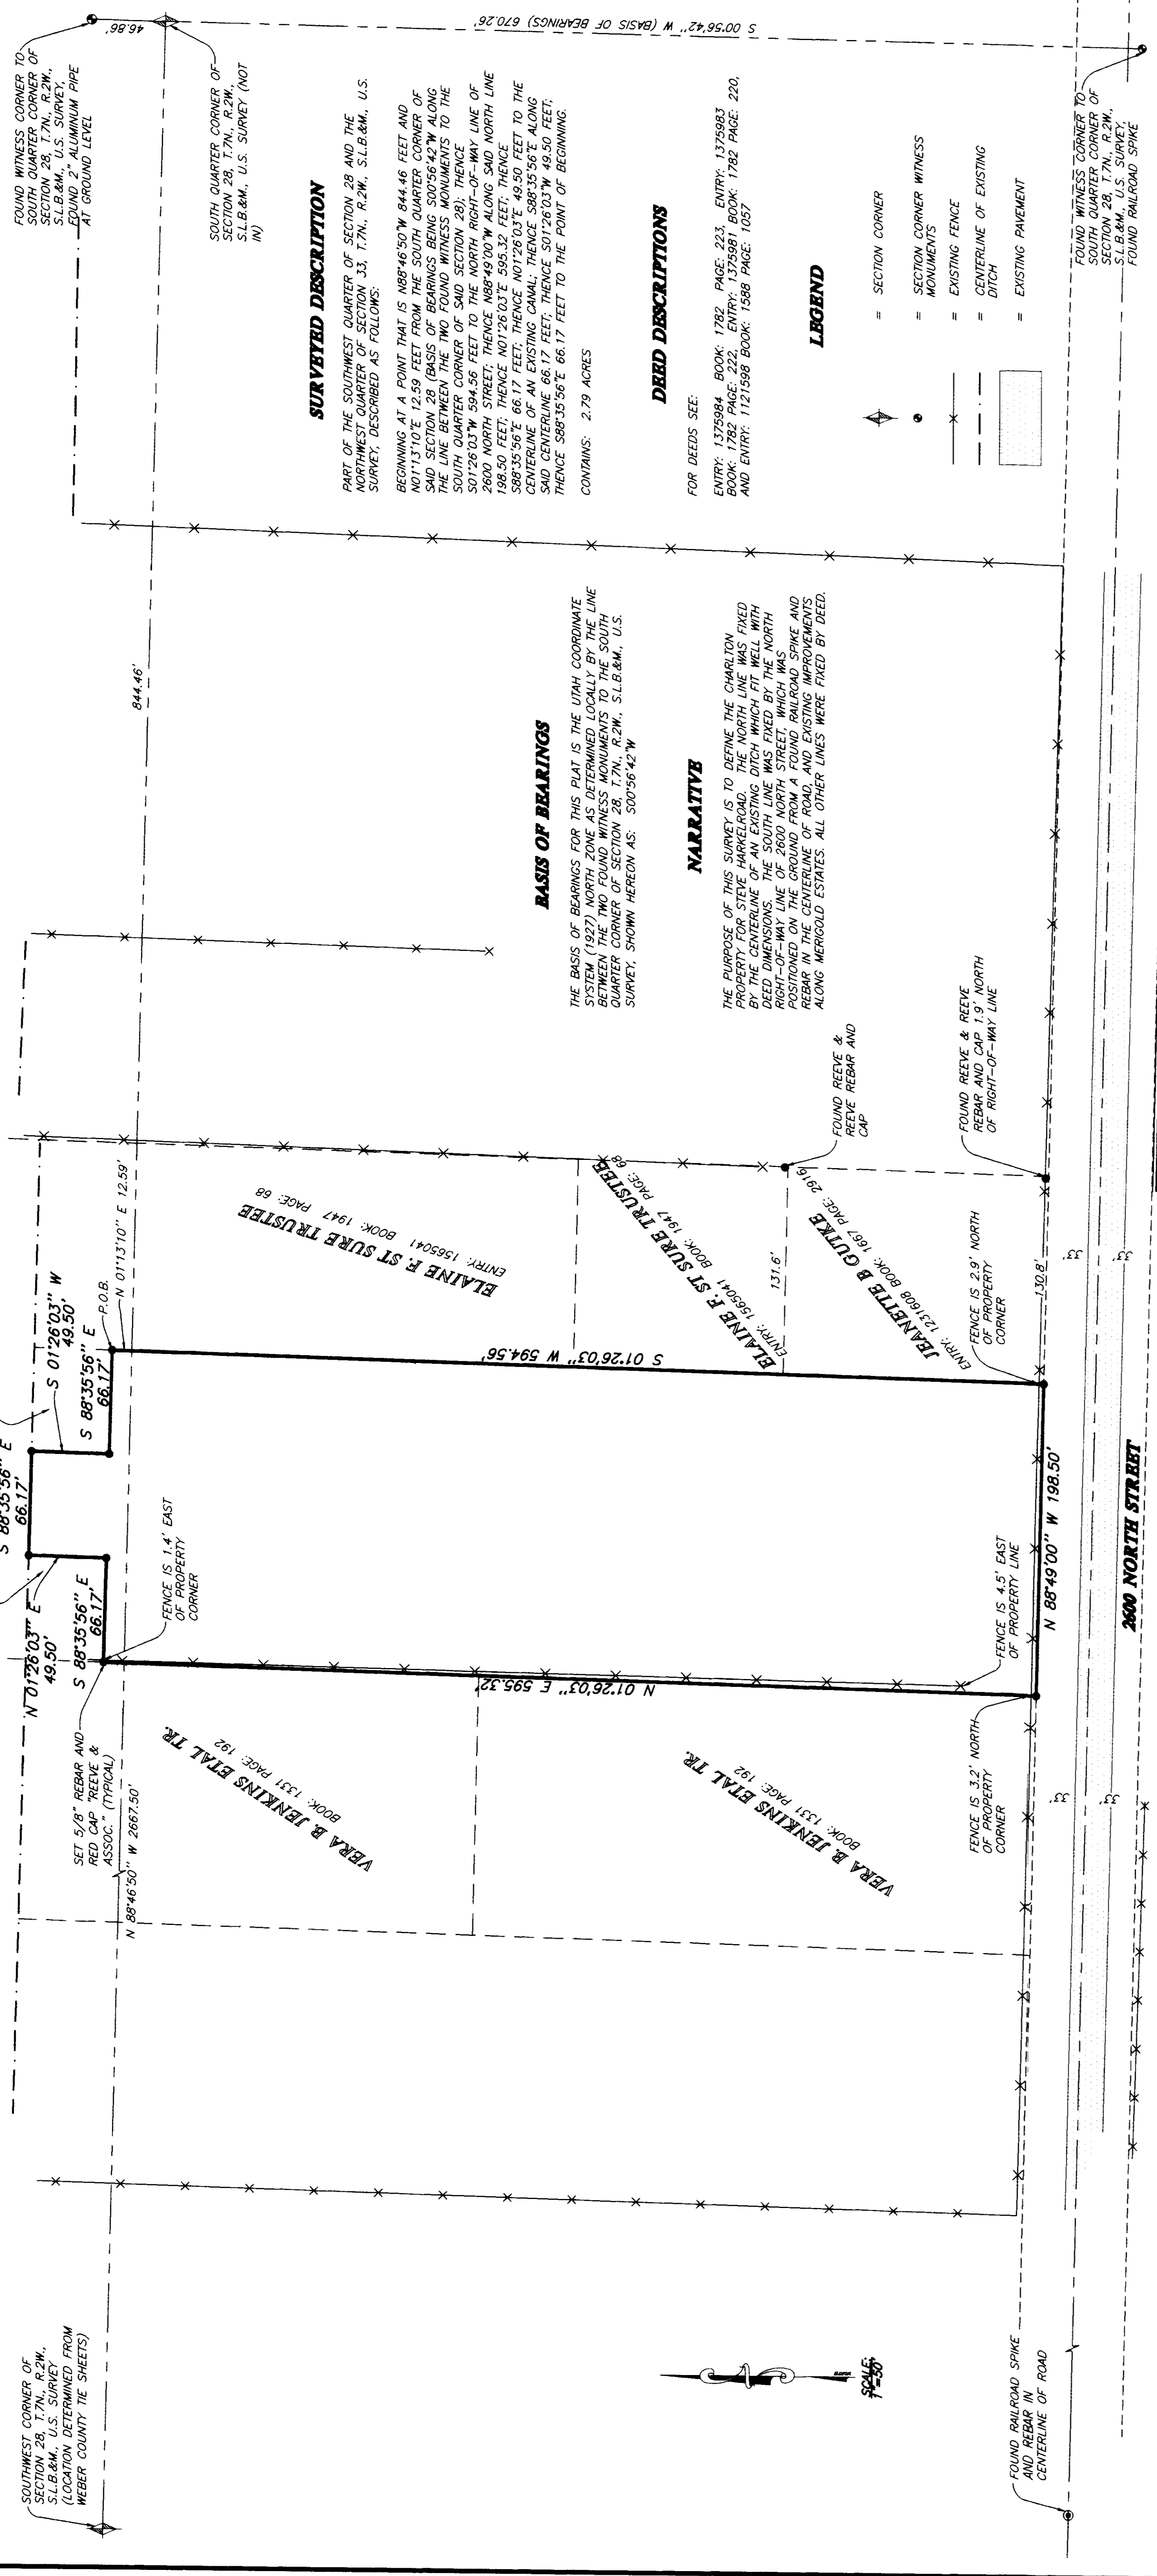

FOUND WITNESS CORNER TO SOUTH QUARTER CORNER OF SECTION 28, T.7N., R.2W., S.L.B.&M., U.S. SURVEY. FOUND 2" ALUMINUM PIPE AT GROUND LEVEL.

SOUTH QUARTER CORNER OF SECTION 28, T.7N., R.2W., S.L.B.&M., U.S. SURVEY (NOT IN)

SURVEYED DESCRIPTION


 CONTAINS: 2.79 ACRES

BASIS OF BEARINGS


NARRATIVE



DEED DESCRIPTIONS

FOR DEEDS SEE:

LEGEND

- SECTION CORNER MONUMENTS
- EXISTING FENCE
- - - CENTERLINE OF EXISTING DITCH
- ▬ EXISTING PAVEMENT

MARI GOLD ESTATES

2600 NORTH STREET

RECEIVED
 NOV 03 2001
 Weber County Surveyor

02786
 THESE PLANS AND SPECIFICATIONS ARE THE PROPERTY OF REEVE & ASSOC., INC. 3670 QUINCY AVE. STE. #110, SALT LAKE CITY, UTAH 84143 AND SHALL NOT BE COPIED OR REPRODUCED OR REPRODUCED WITHOUT THEIR WRITTEN PERMISSION.

REVISIONS

1.	
2.	
3.	
4.	
5.	
6.	

PROJECT NO.	018-01	SURVEYOR	R. HILLFORD
DATE	2-28-01	DRAWN	J. BERRY
SCALE	1"=50'	CHECKED	

REEVE & ASSOCIATES, INC.
 Civil Engineering • Structural Engineering
 Surveying • Land Planning • Landscape Architecture
 3670 QUINCY AVE. STE. #110
 SALT LAKE CITY, UTAH 84143
 (801) 821-7100 FAX (801) 821-2666 (435) 252-3503 FAX (435) 252-2566

RECORD OF SURVEY

DENNIS J. CHARLTON
 PART OF THE SOUTHWEST 1/4 OF SECTION 28, T.7N., R.2W., S.L.B.&M., U.S. SURVEY, PLAIN CITY, WEBER COUNTY, UTAH

SHEET 1
 SHEETS 1