

SURVEYOR'S CERTIFICATE


SKETCHED THIS 30TH DAY OF AUGUST 2001



BASIS OF BEARINGS

SURVEYED DESCRIPTION
 PART OF THE NORTHWEST QUARTER OF SECTION 22, T.6N., R.1W., S.11E.B.M., U.S. SURVEY, DESCRIBED AS FOLLOWS:
 ALL OF LOT 6, HENDERSON SUBDIVISION NO. 4, OGDEN CITY, WEBER COUNTY, UTAH.

NARRATIVE

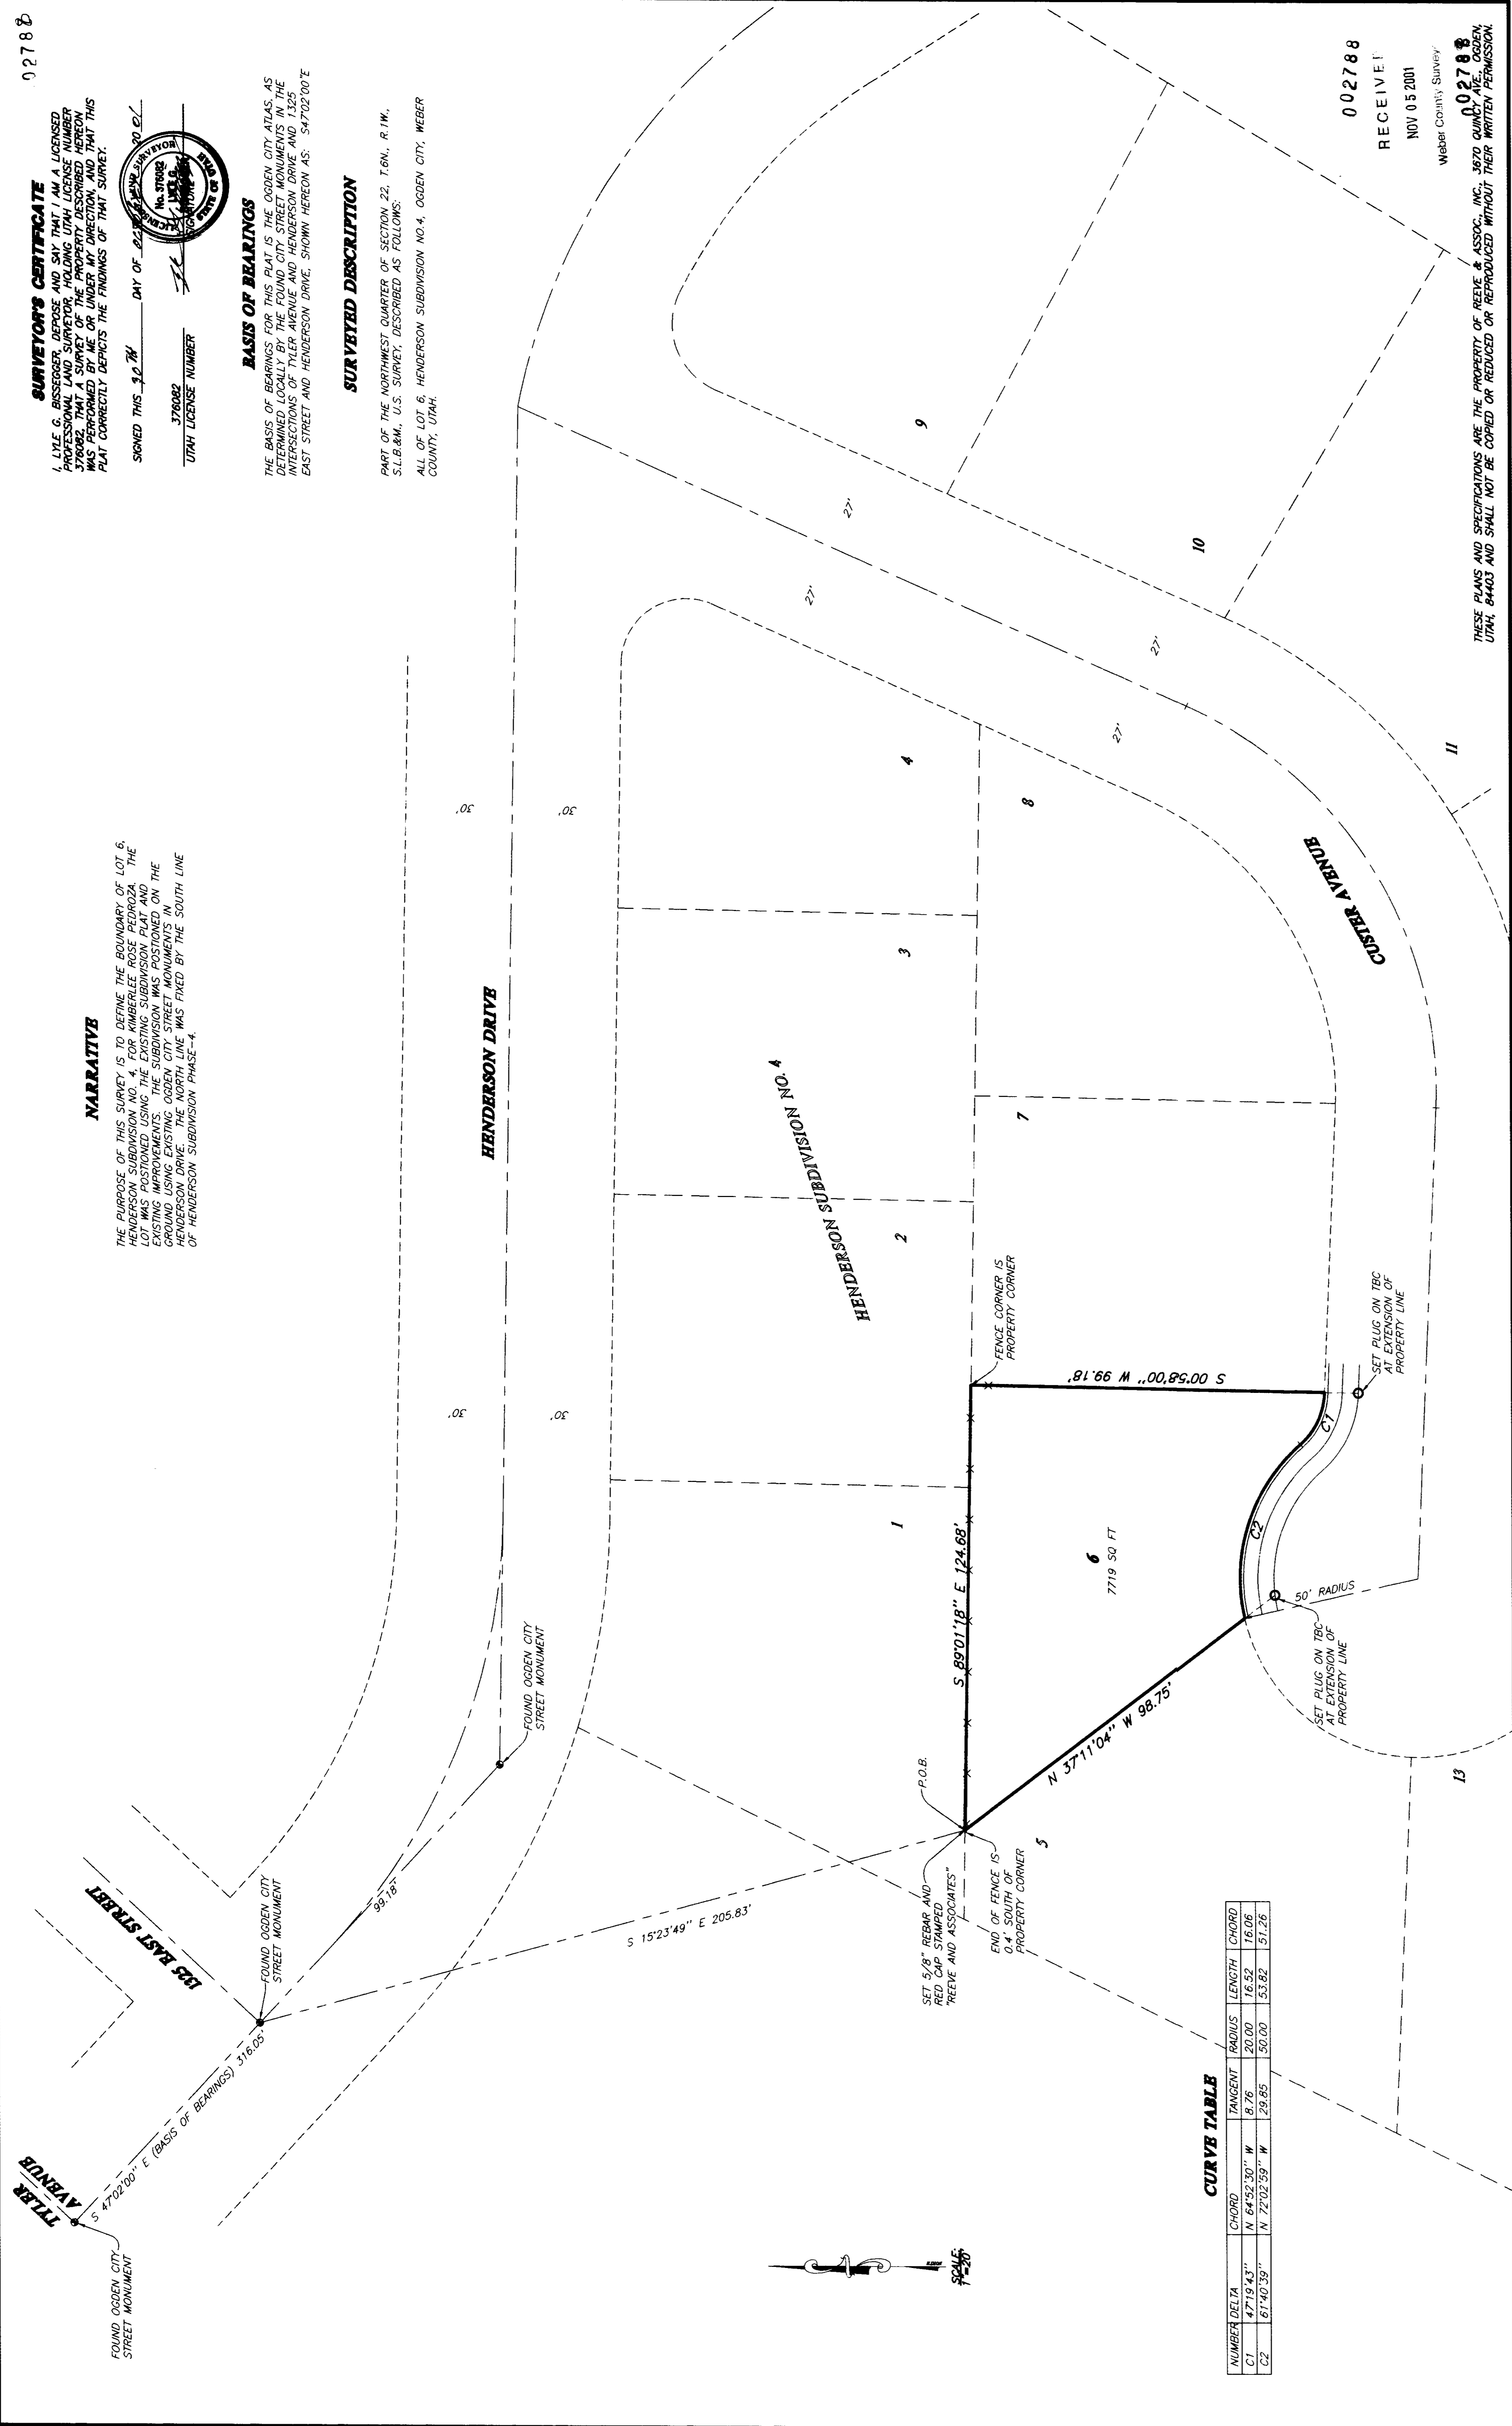

CURVE TABLE

NUMBER	DELTA	CHORD	TANGENT	RADIUS	LENGTH	CHORD
C1	47°19'43"	N 64°52'30" W	8.76	20.00	16.52	16.06
C2	67°40'39"	N 72°02'59" W	29.85	50.00	53.82	51.26

002788
 RECEIVED
 NOV 05 2001
 WEBER COUNTY SURVEY


SHEET 1

LOT 6, HENDERSON SUBDIVISION
 PART OF THE NORTHWEST QUARTER OF SECTION 22, T.6N., R.1W., S.11E.B.M., U.S. SURVEY OGDEN CITY, UTAH, 2001

RECORD OF SURVEY

REEVE & ASSOCIATES, INC.
 Civil Engineering & Structural Engineering
 Surveying & Photogrammetric Structure
 OGDEN, UTAH 84403
 EXECUTIVE BLDG. 435 S. WASHINGTON BLVD. #110 OGDEN, UTAH 84403
 (801) 821-3100 FAX (801) 821-2808 (ISS) 752-3301 FAX (ISS) 752-2266

PROJECT NO. 4284-01 SURVEYOR: L. BRISBERGER
 DATE: 8-16-01 CHECKED: J. GUNN
 SCALE: 1"=30'

REVISIONS
 1. _____
 2. _____
 3. _____
 4. _____
 5. _____
 6. _____