DRAWING NUMBER

000028

PLAN HOLD CORPORATION . IRVINE, CALIFORNIA REORDER BY NUMBER 075AR

WEBER COUNTY SURVEYOR'S

BRASS CAP.

DRAWING NUMBER

PLAN HOLD CORPORATION • IRVINE, CALIFORNIA

REORDER BY NUMBER 075AR

000028

000028


DRAWING NUMBER

PLAN HOLD CORPORATION • IRVINE, CALIFORNIA

DRAWING NUMBER

000028

PLAN HOLD CORPORATION . IRVINE, CALIFORNIA REORDER BY NUMBER 075AR

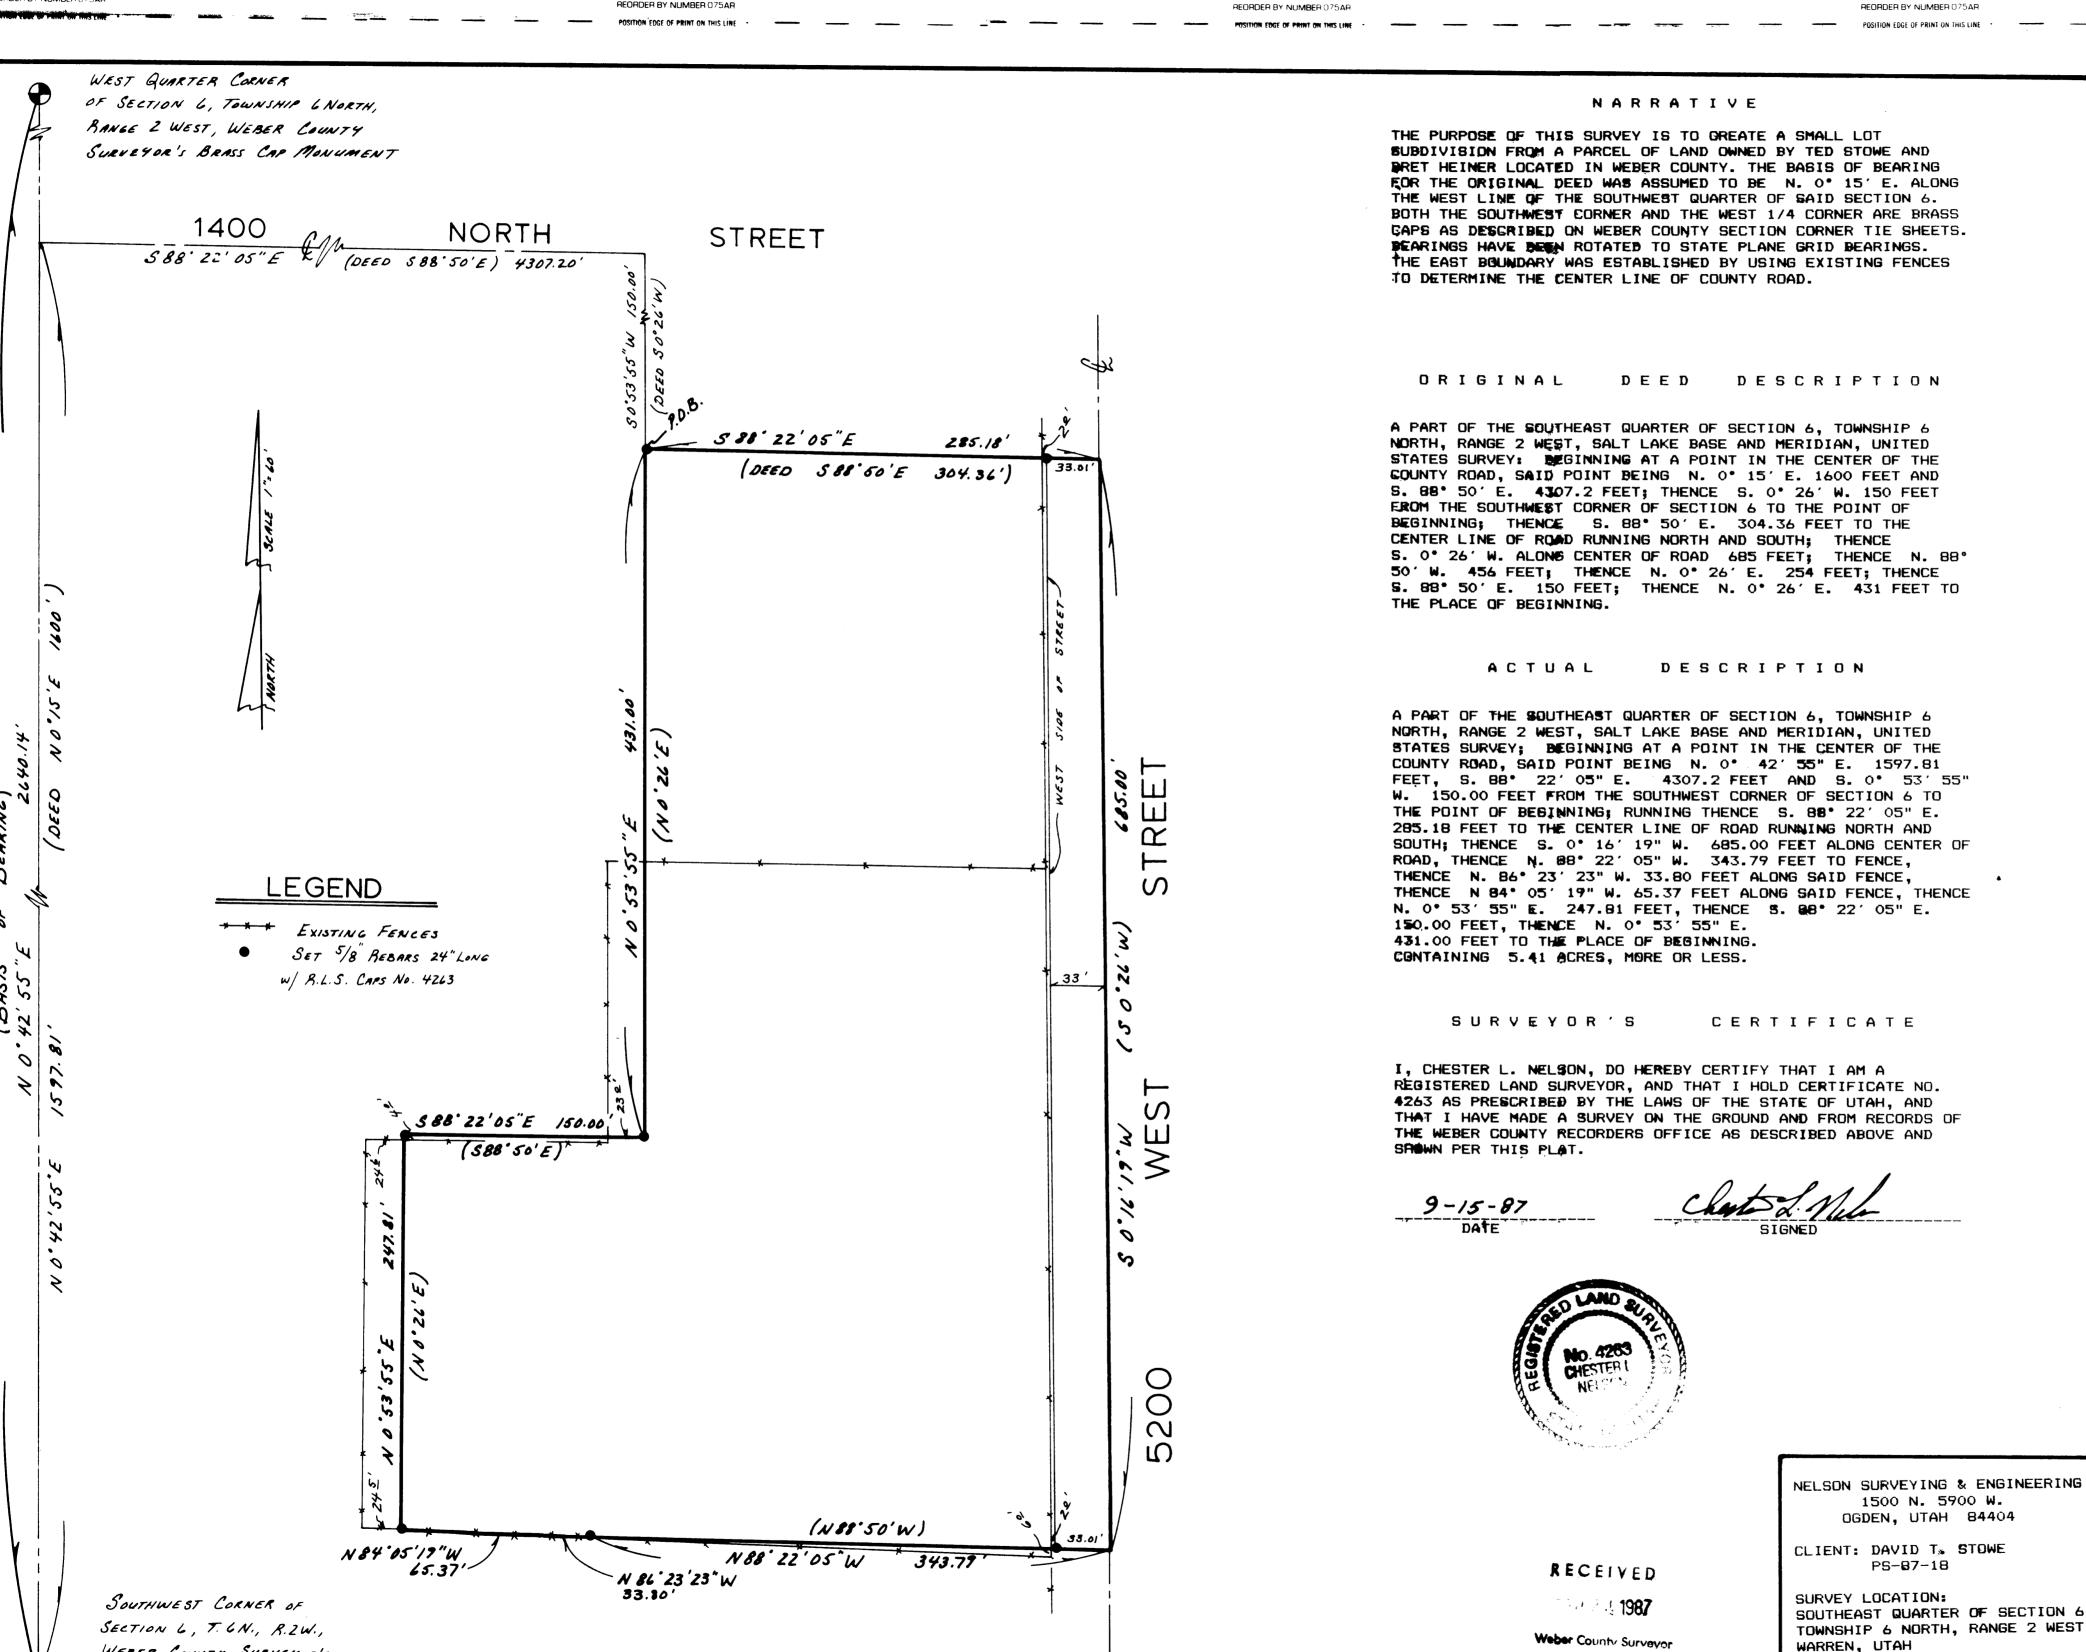

000058

1500 N. 5900 W.

PS-87-18

SURVEY DATE: 08-27-87