








4 of 14


02810



02228

4 of 14

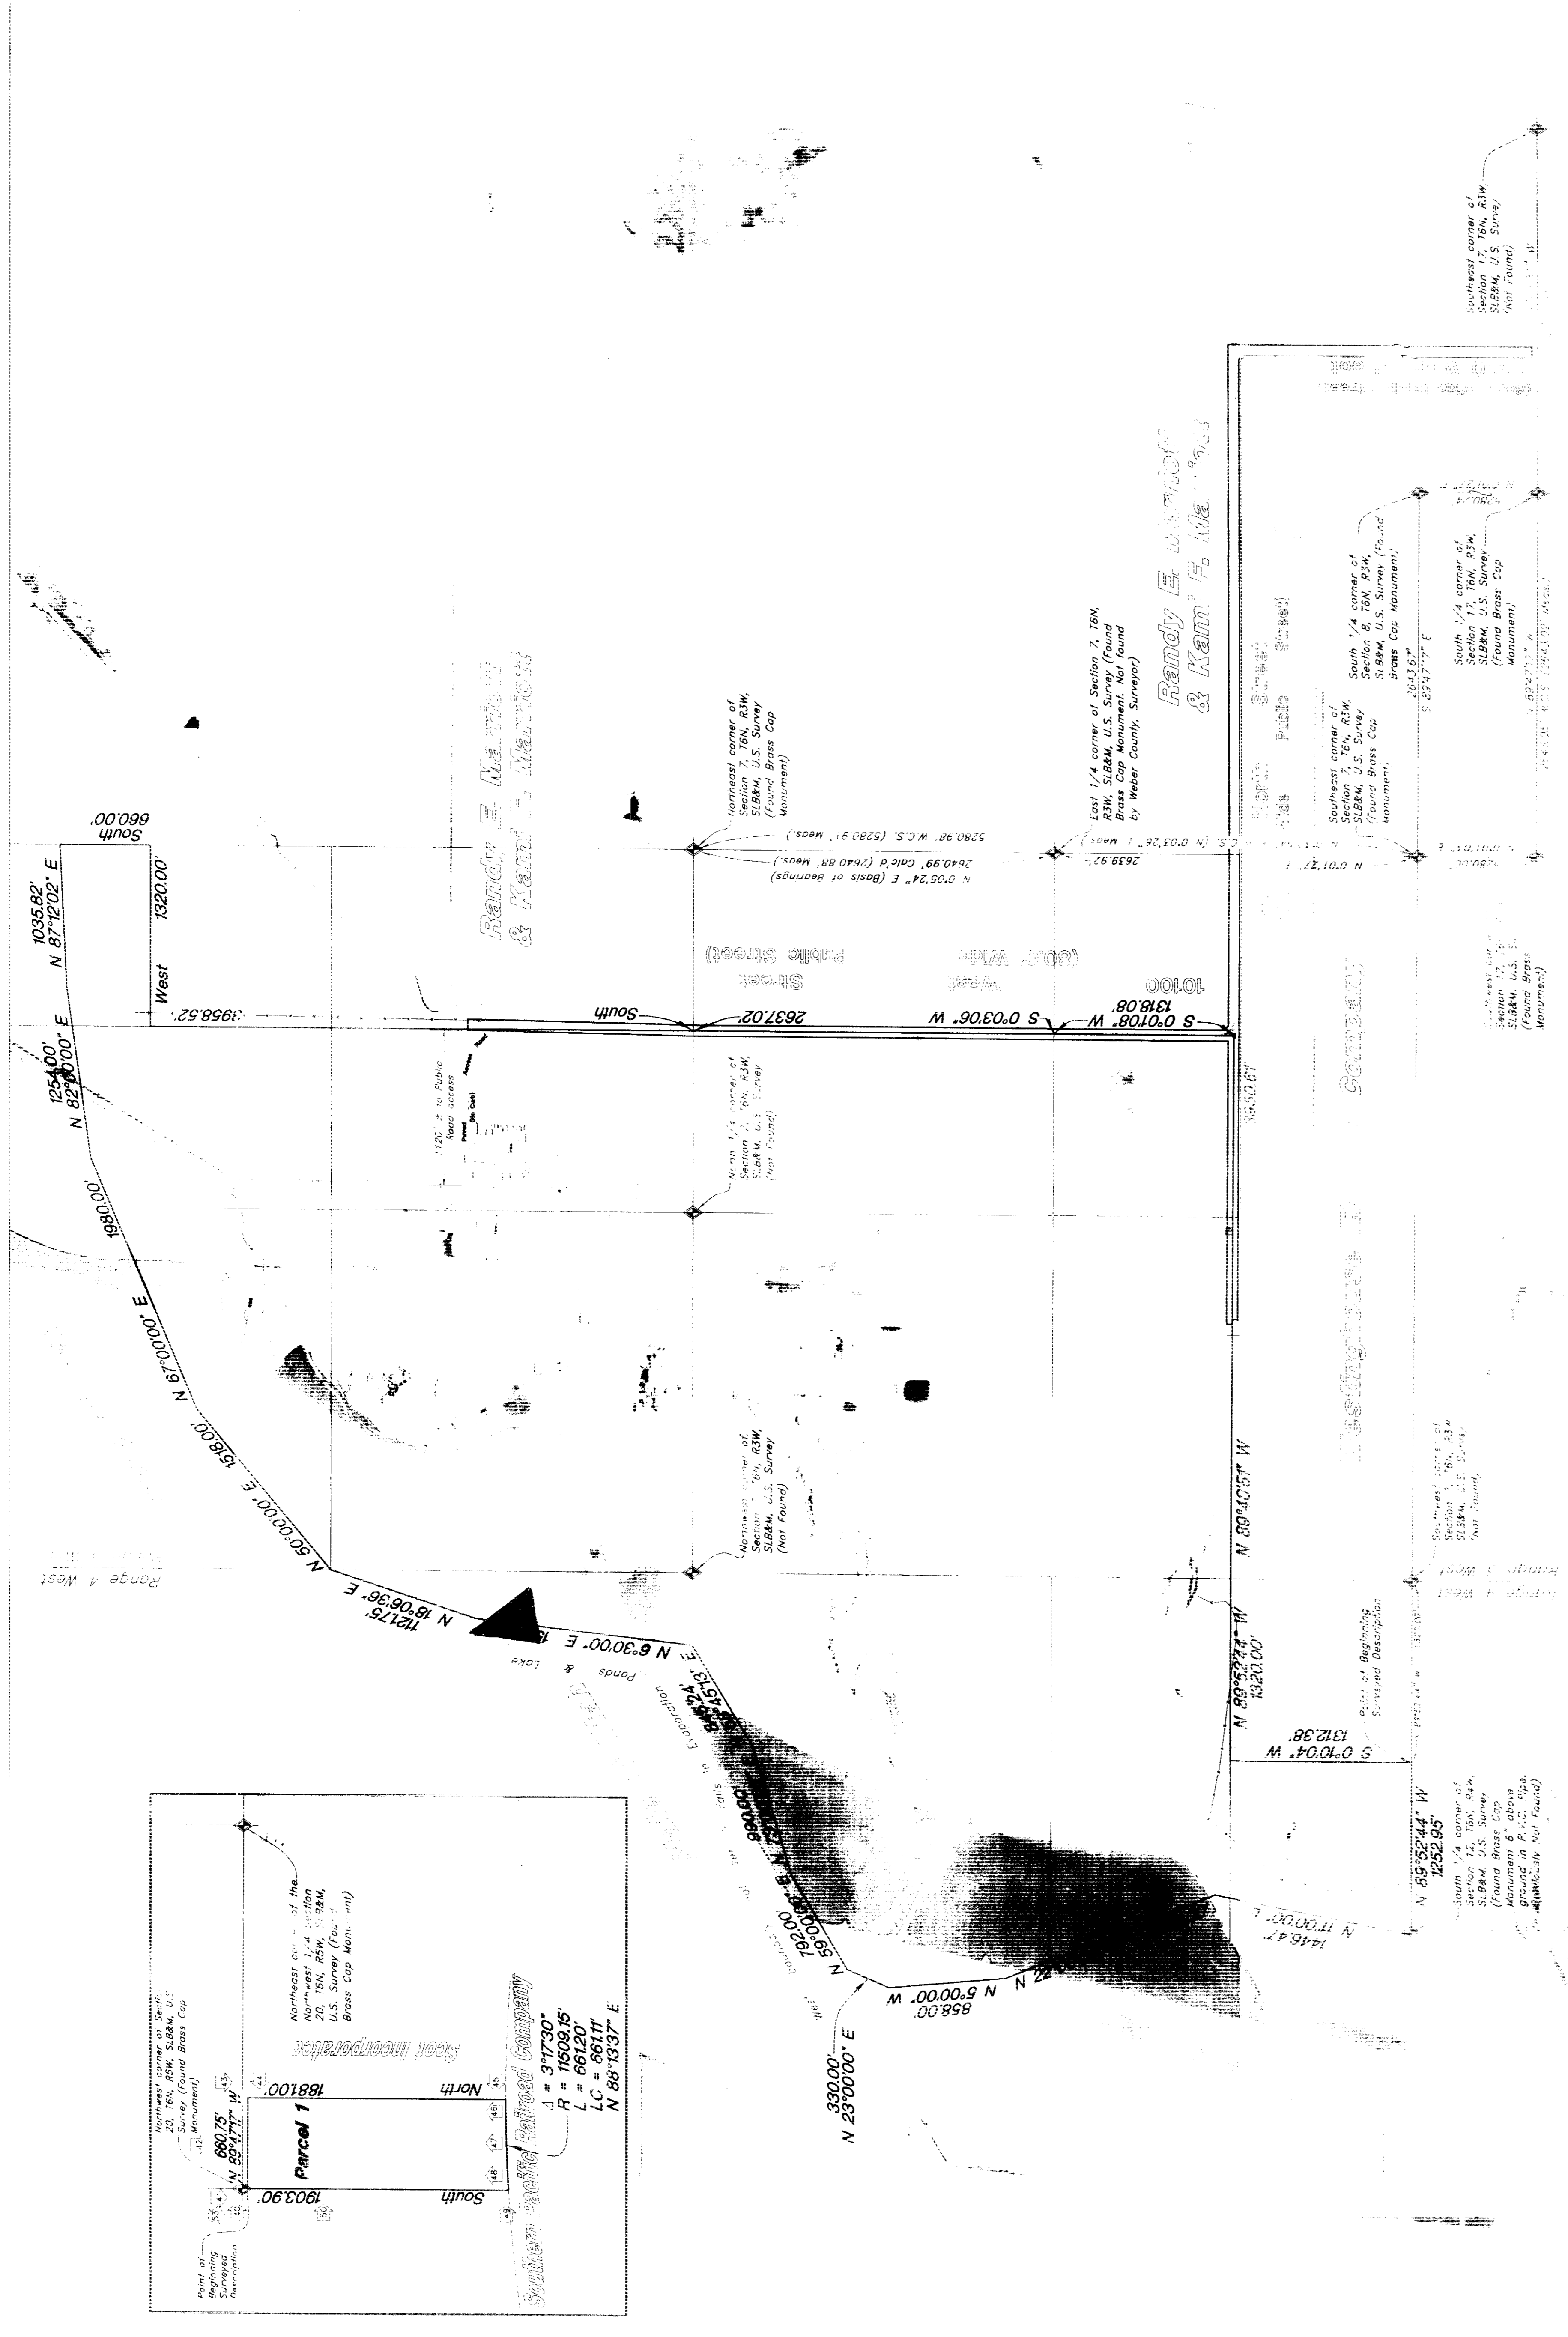

Book & Clark's National Surveyors Network  
National Coordinators of A/T/A/CSM Land Title Surveys

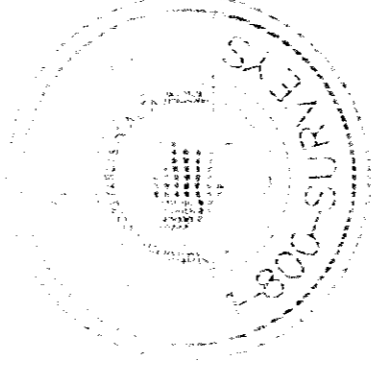

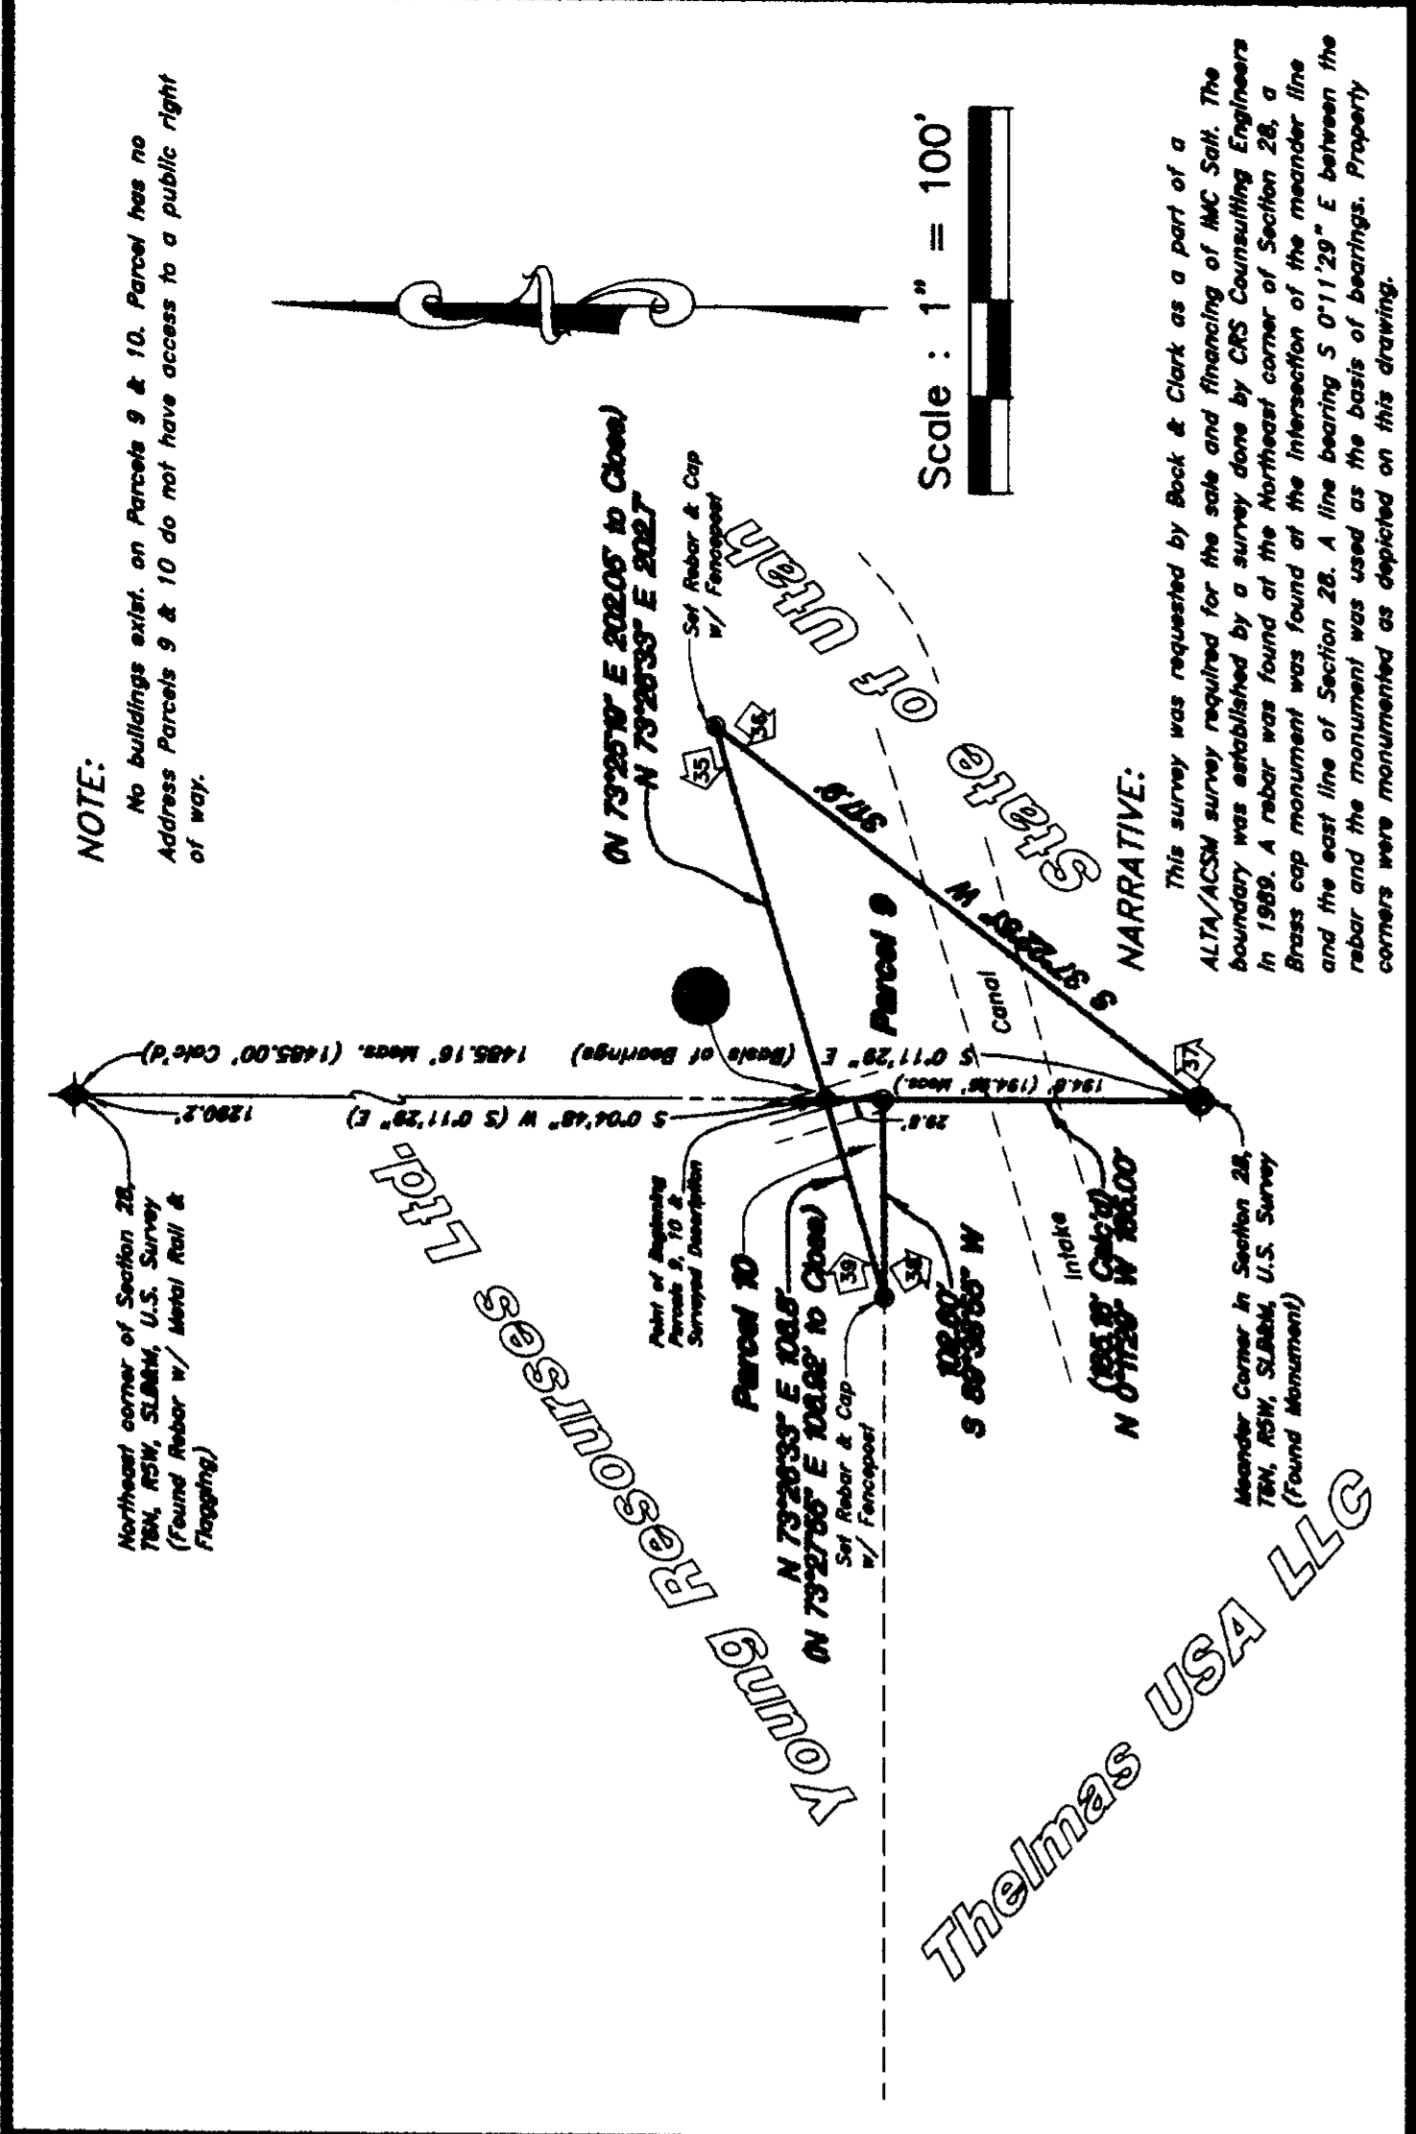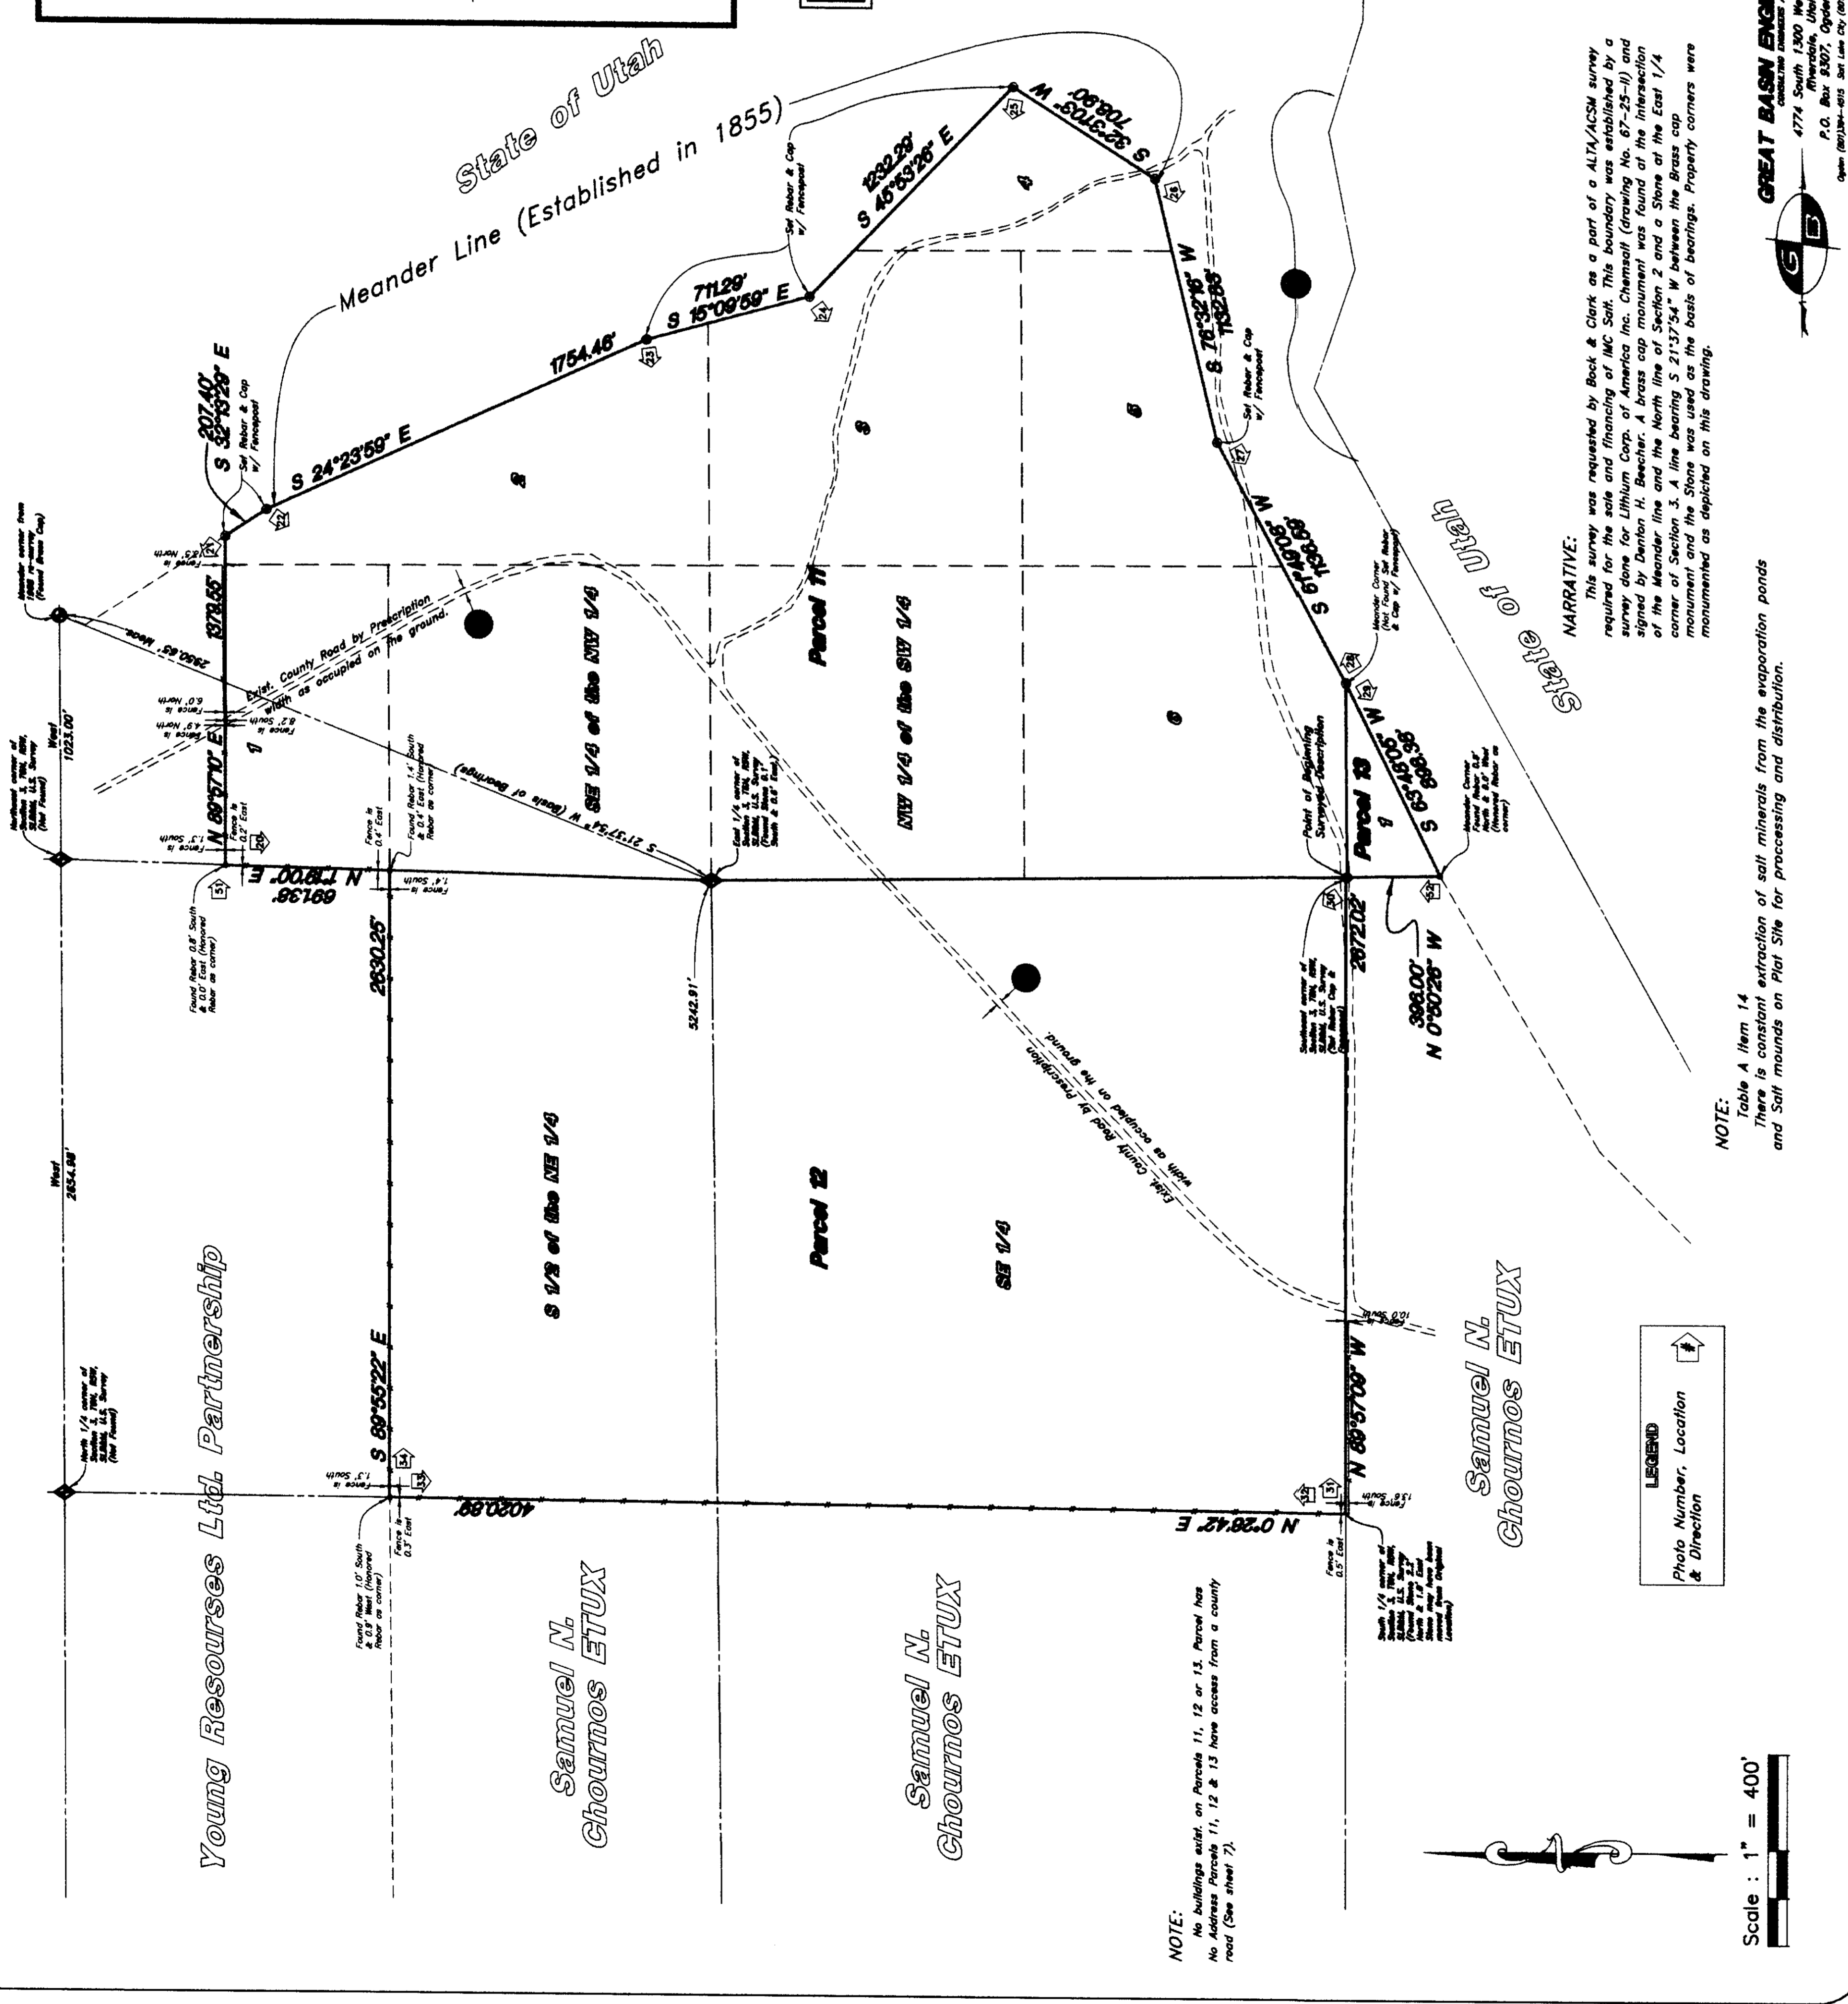

**NOTE:**  
100.

**Thelmas USA LLC**

**NOTE:**  
100.

**NARRATIVE:**  


**NOTE:**  
Table 1, Item 14 extraction of salt minerals from the evaporation ponds and Salt mounds on Plot Site for processing and distribution.

Scale : 1" = 400'

**LEGEND**  
Photo Number, Location & Direction

RECEIVED  
DEC 18 2001  

02810

**Book & Clark's National Surveyors Network**  
537 North Cleveland-Harrison Road  
Cincinnati, Ohio 45333  
Phone: (800) Surveys, Fax: (330) 666-3698  
www.1800surveys.com



**ALTA/ACSM LAND TITLE SURVEY**  
PREPARED FOR:  
**IMC SALT**  
DATE: November 21, 2001  
PROJECT NO. 200102810/2

Sheet 5 of 14

**GREAT BASIN ENGINEERING NORTH**  
4774 South 1300 West - Suite 102  

Scale : 1" = 400'

002810



6 of 14

002510


002810

002310

6 of 14

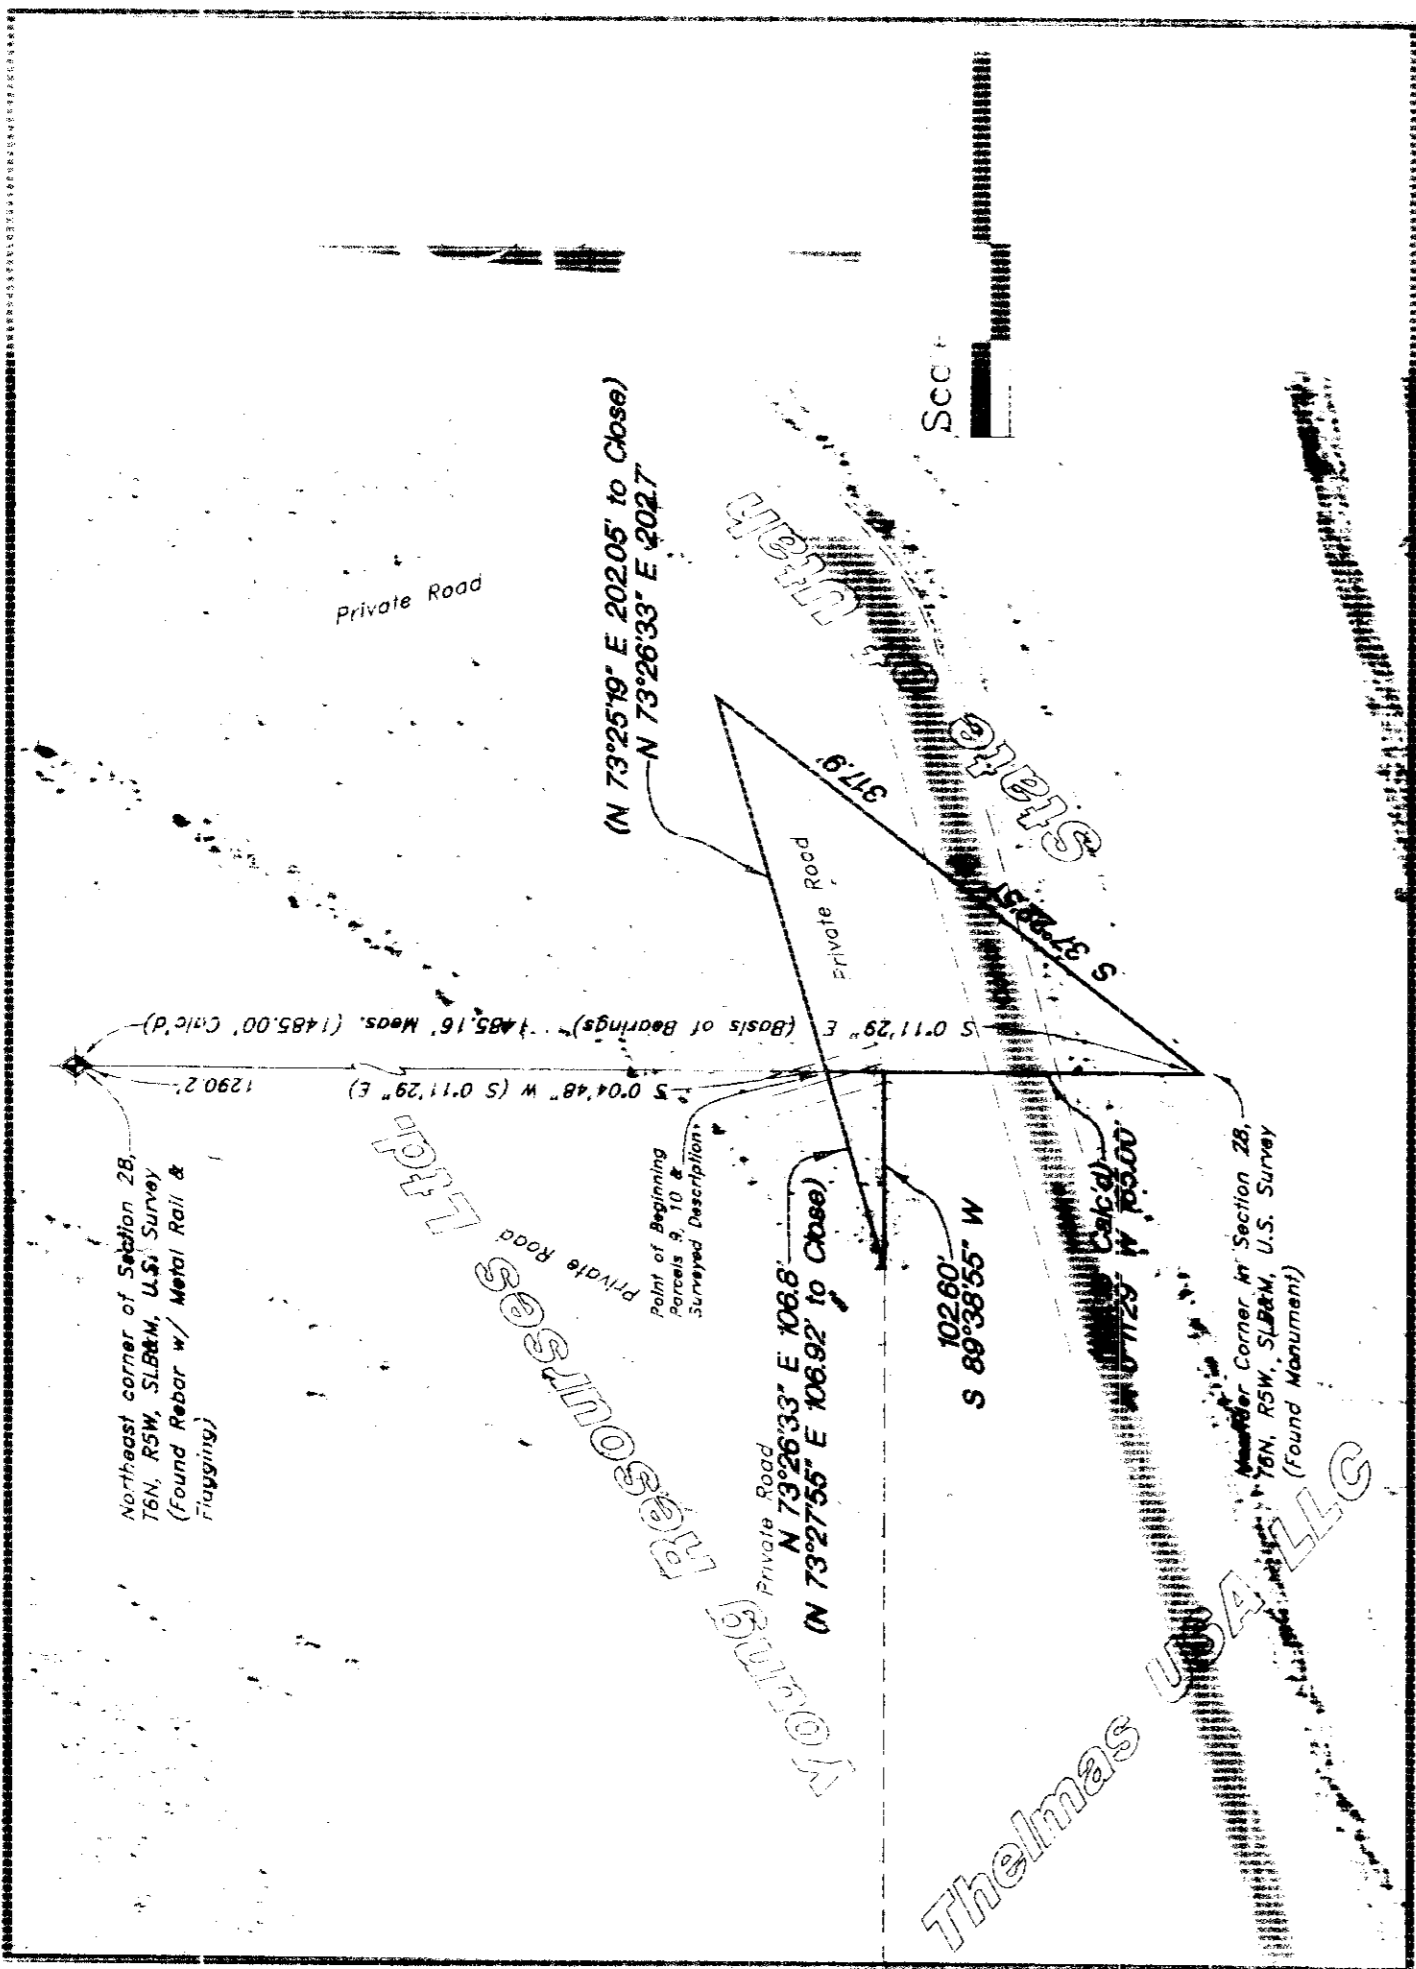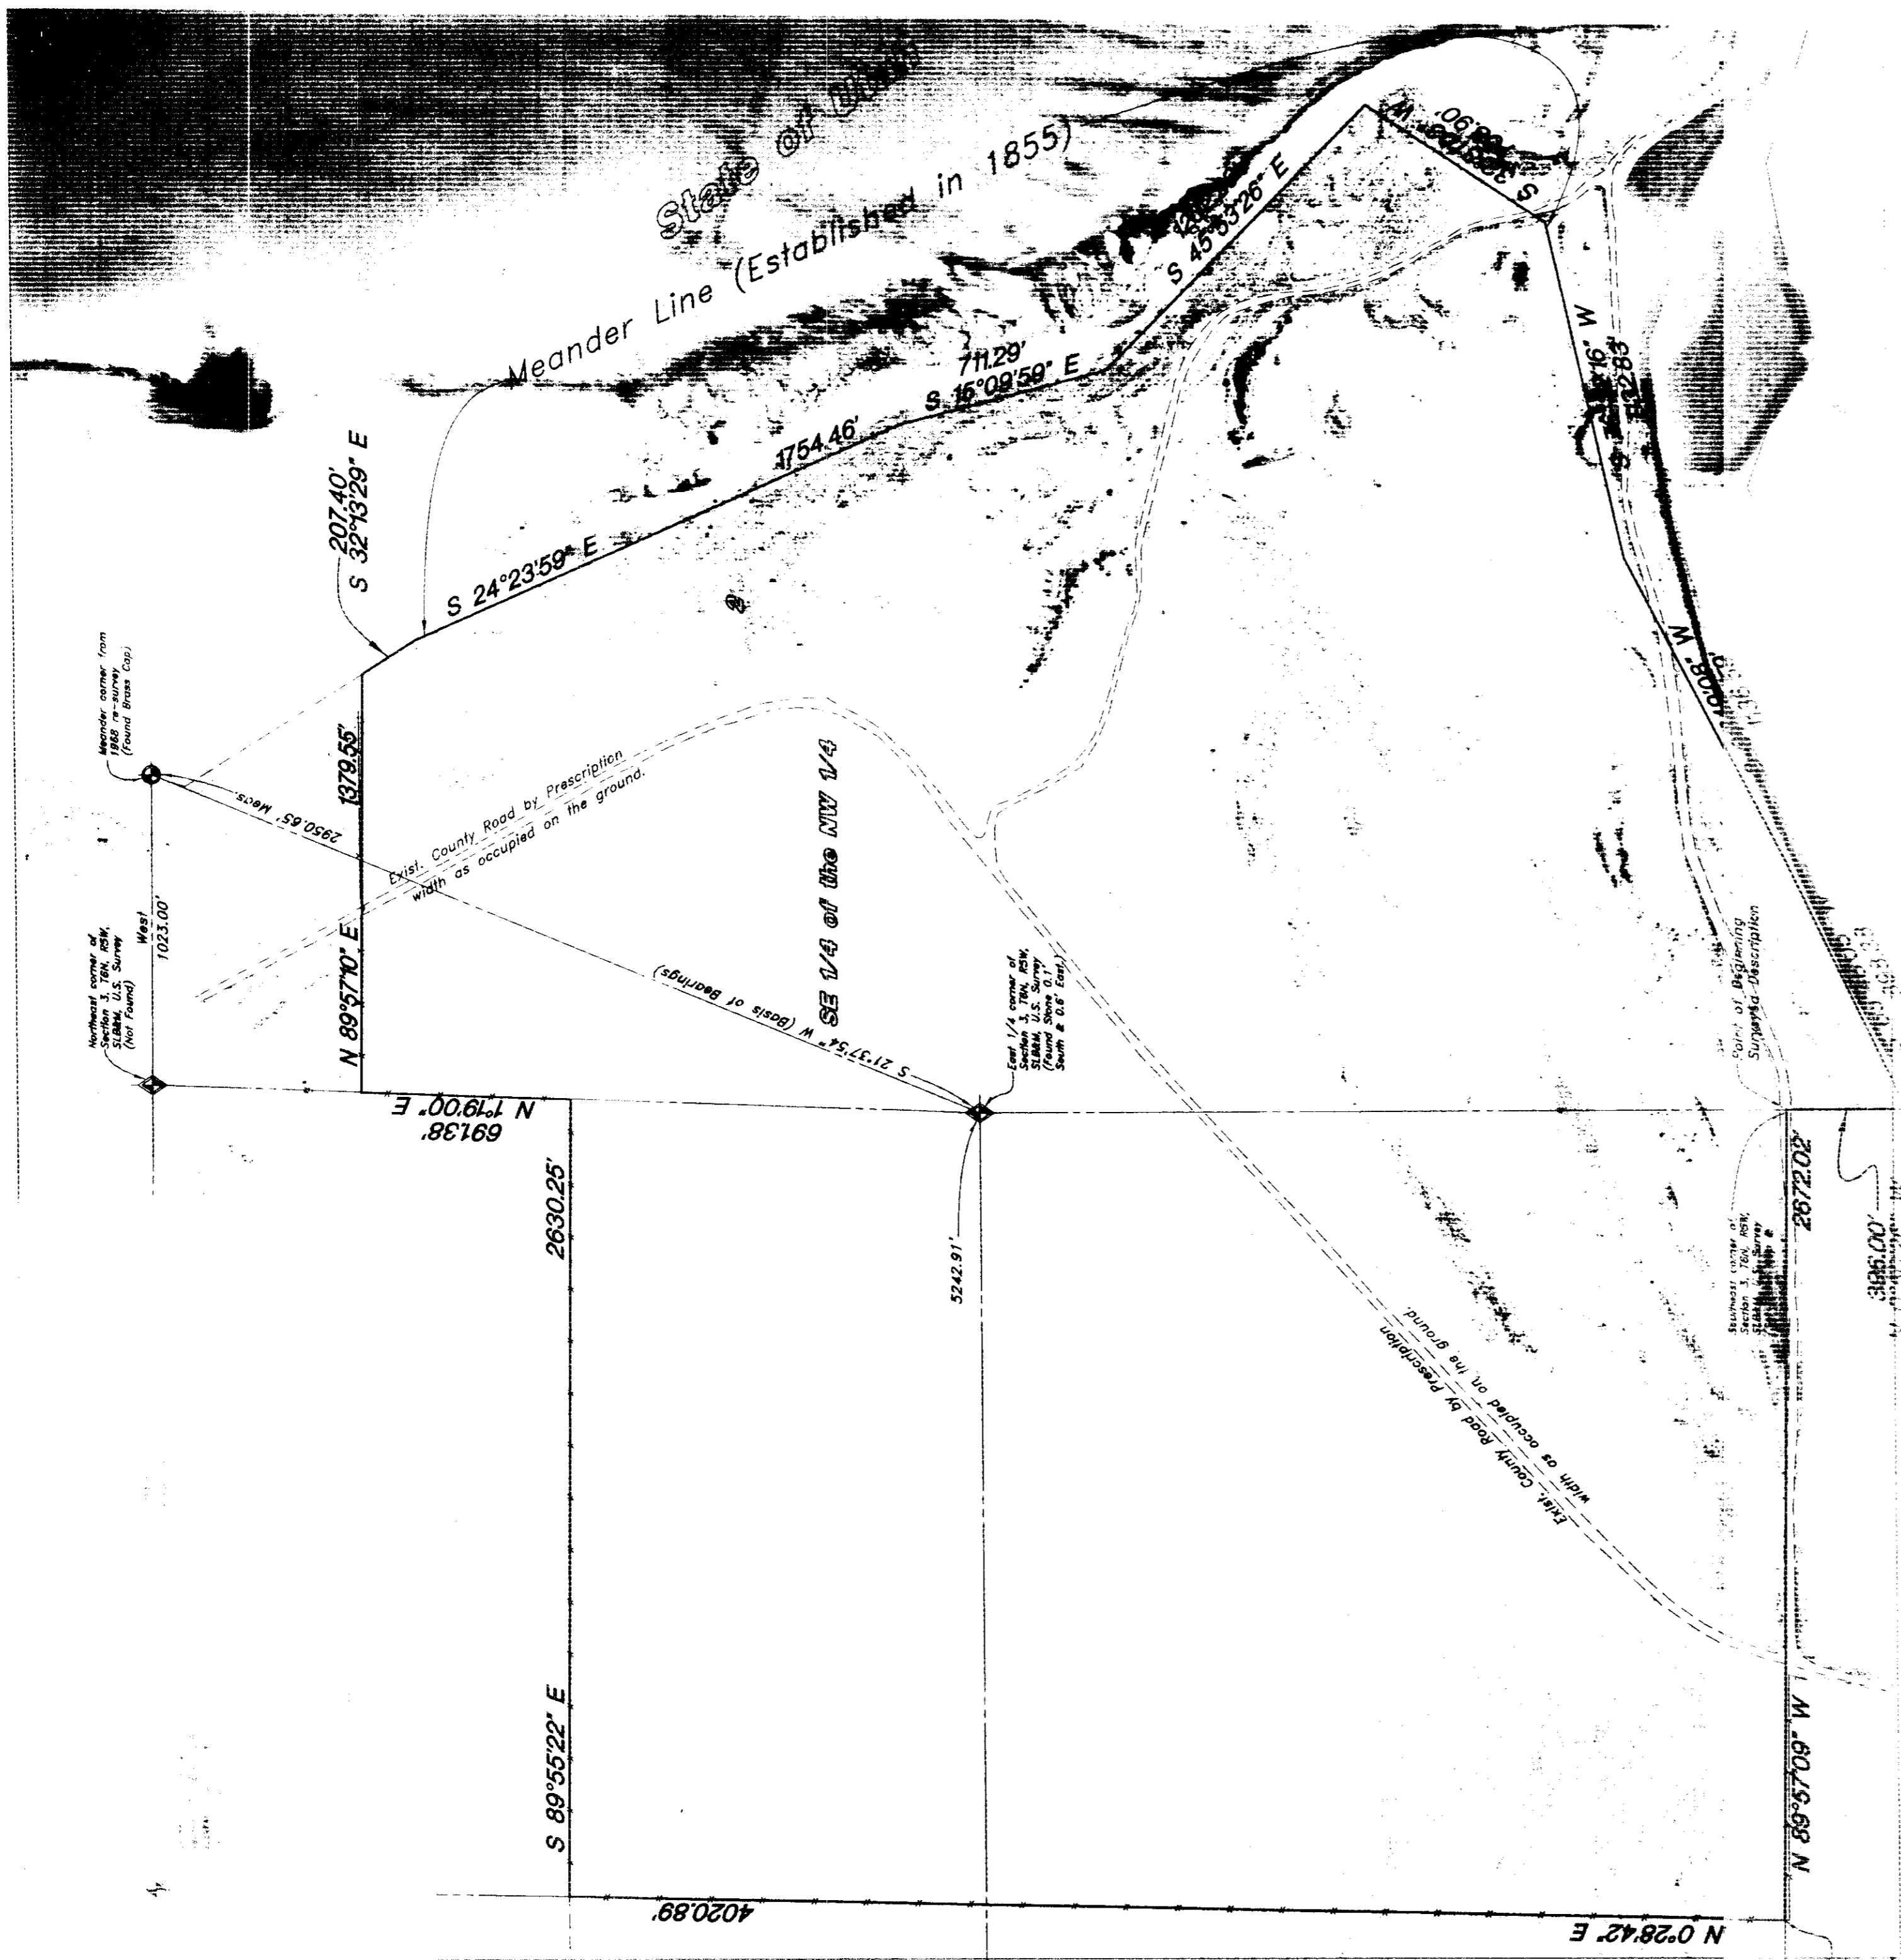

Book & Clark's National Surveyors Network  
 National Coordinators of AIA/ACSM Land Title Surveys

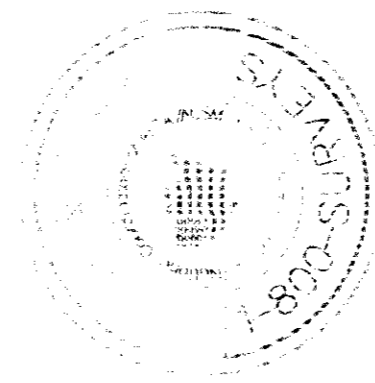

Book & Clark's National Surveyors Network  
 National Coordinators of AIA/ACSM Land Title Surveys

7 of 14

02810


02810

02810

02810

7 of 14

W:\10131616\10131616.dwg, 12/04/2001 04:53:53 PM, A1

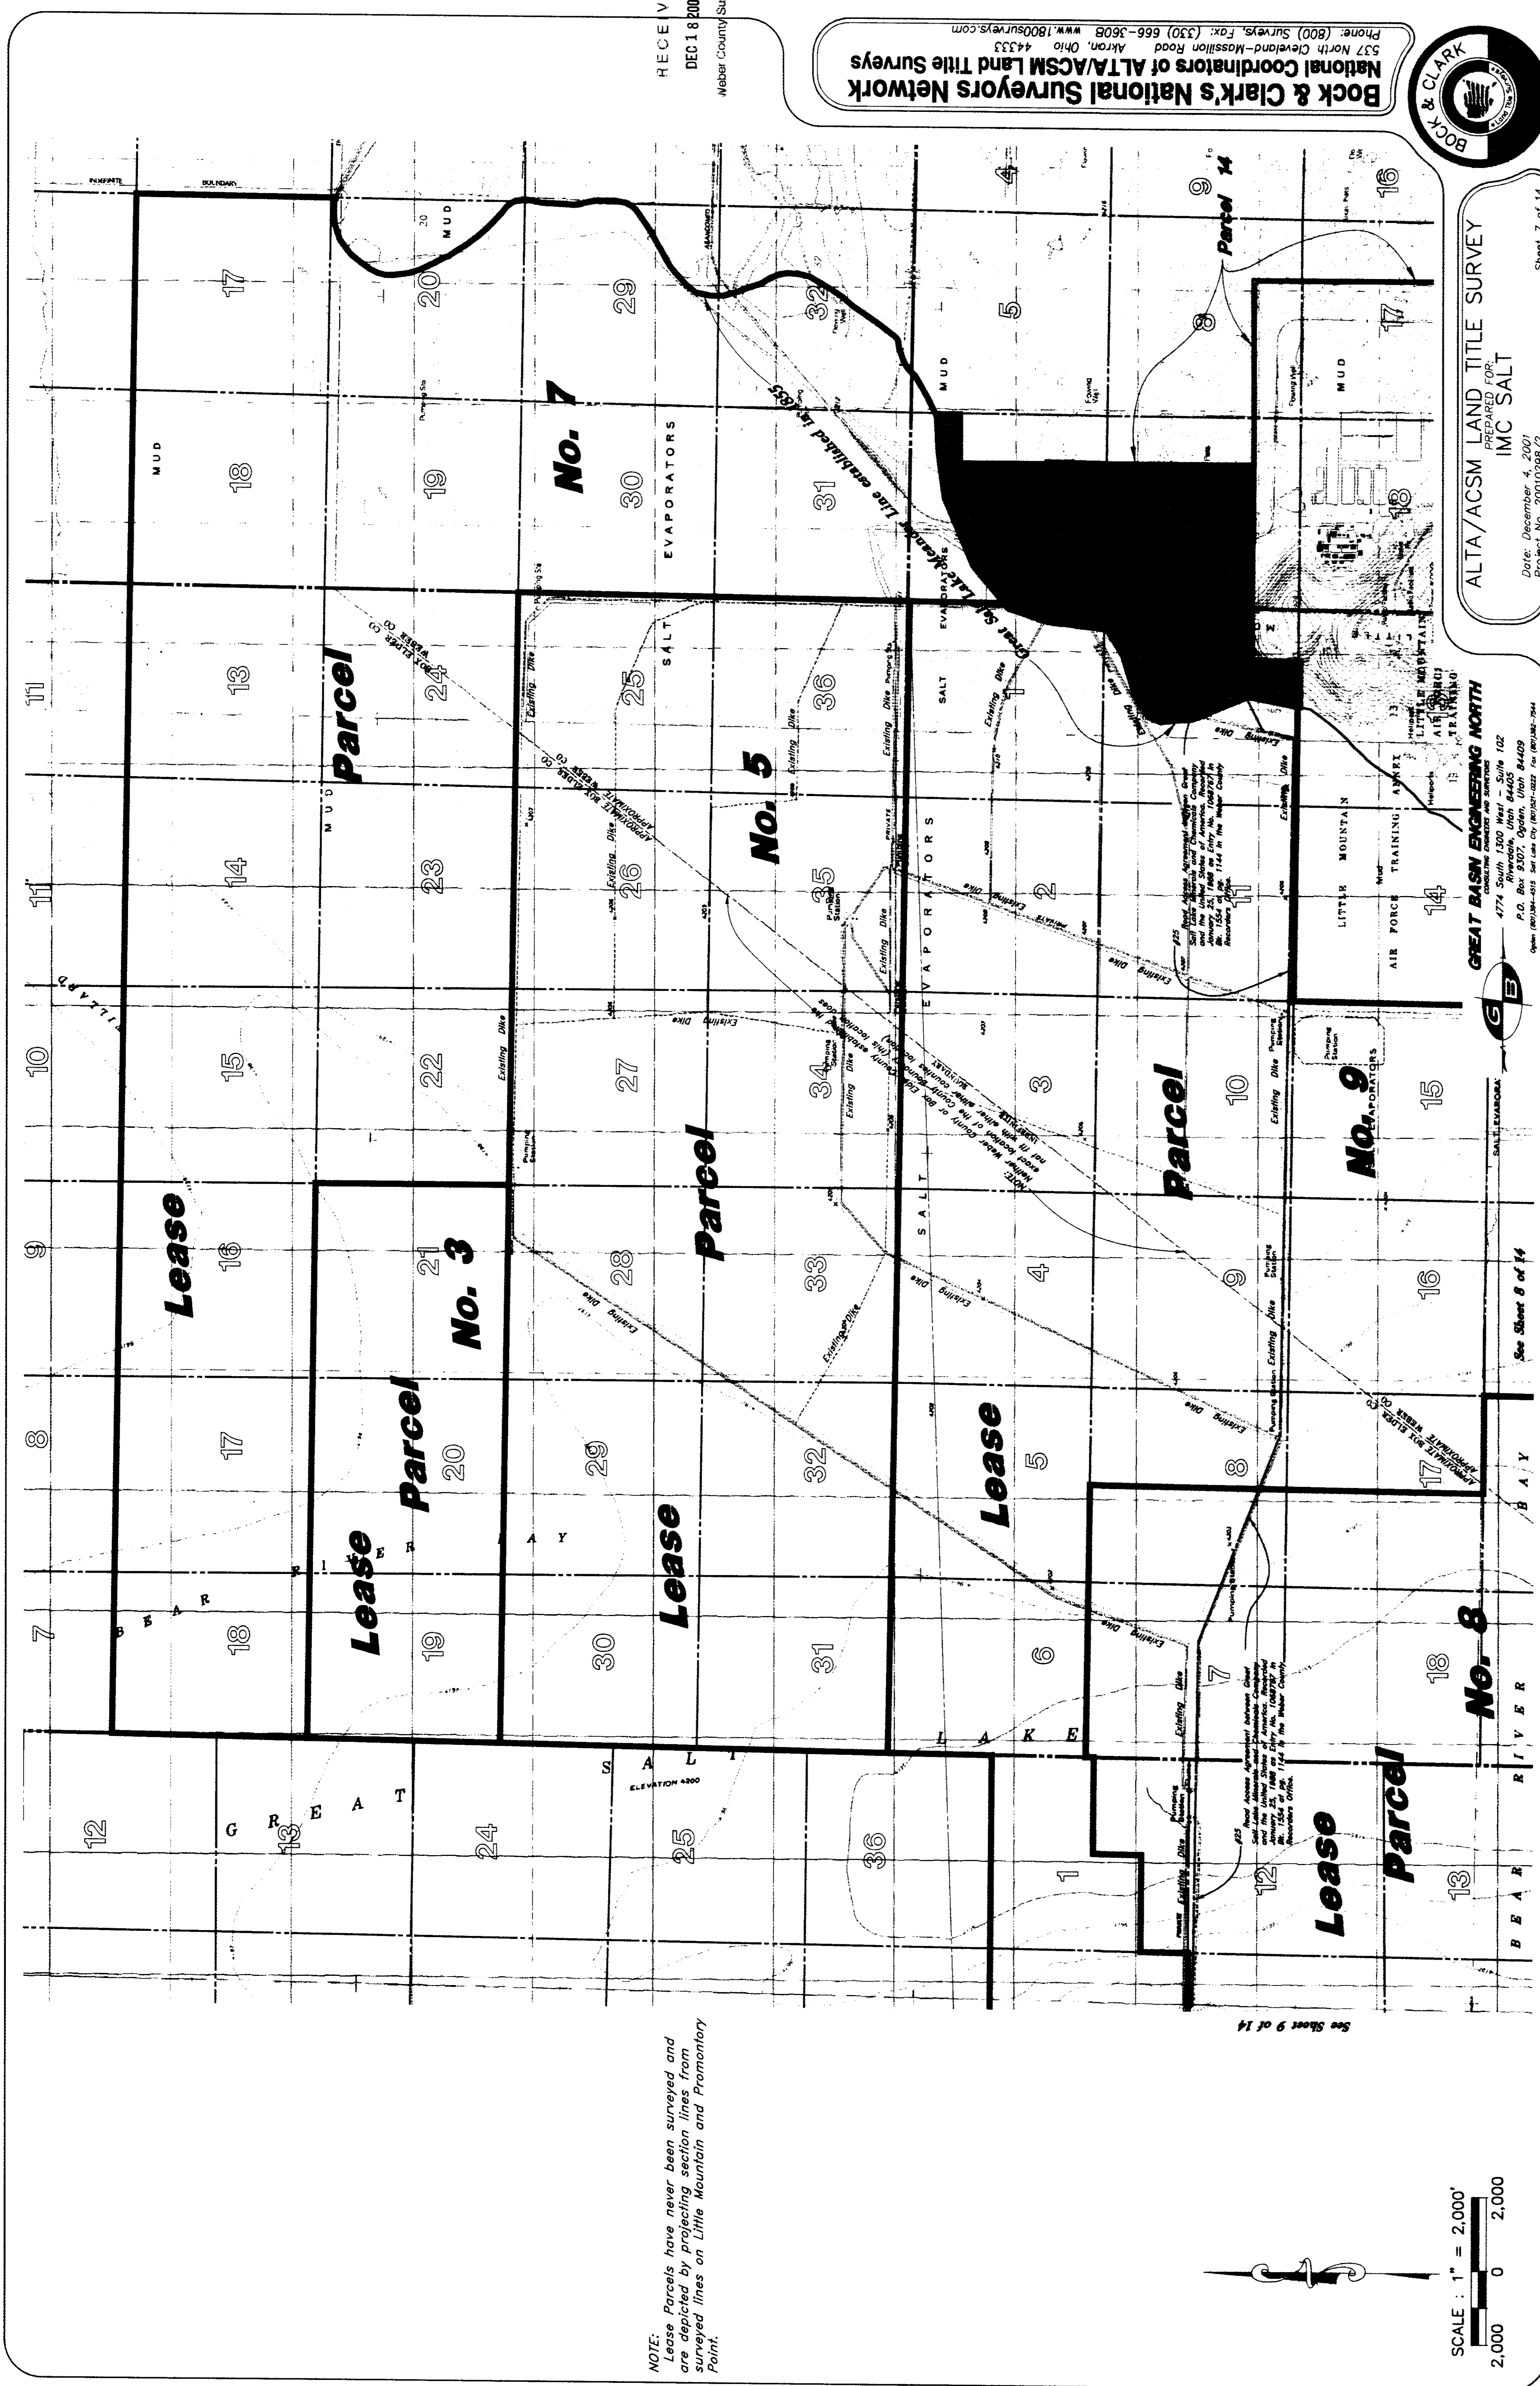

NOTE:  
 Lease Parcels have never been surveyed and  
 are depicted by projecting section lines from  
 surveyed lines on Little Mountain and Promontory  
 Point.



SCALE : 1" = 2,000'  
 2,000 0 2,000

RECEIVED  
 DEC 18 2001  

**Bock & Clark's National Surveyors Network**  
 National Coordinators of ALTA/ACSM Land Title Surveys  
 Phone: (800) Surveys, Fax: (330) 666-3608  
 537 North Cleveland-Mission Road Akron, OH 44333  
 www.1800surveys.com



ALTA/ACSM LAND TITLE SURVEY  
 PREPARED FOR:  
 IMC SALT  
 Date: December 4, 2001  
 Project No. 200102952/2

**GREAT BASIN ENGINEERING NORTH**  
 CONSULTING ENGINEERS AND SURVEYORS  
 4774 South 1320 West, Suite 102  
 P.O. Box 9307, Ogden, Utah 84409  

Sheet 7 of 14

See Sheet 8 of 14

See Sheet 9 of 14






9 of 14

9 of 14

02810

02810

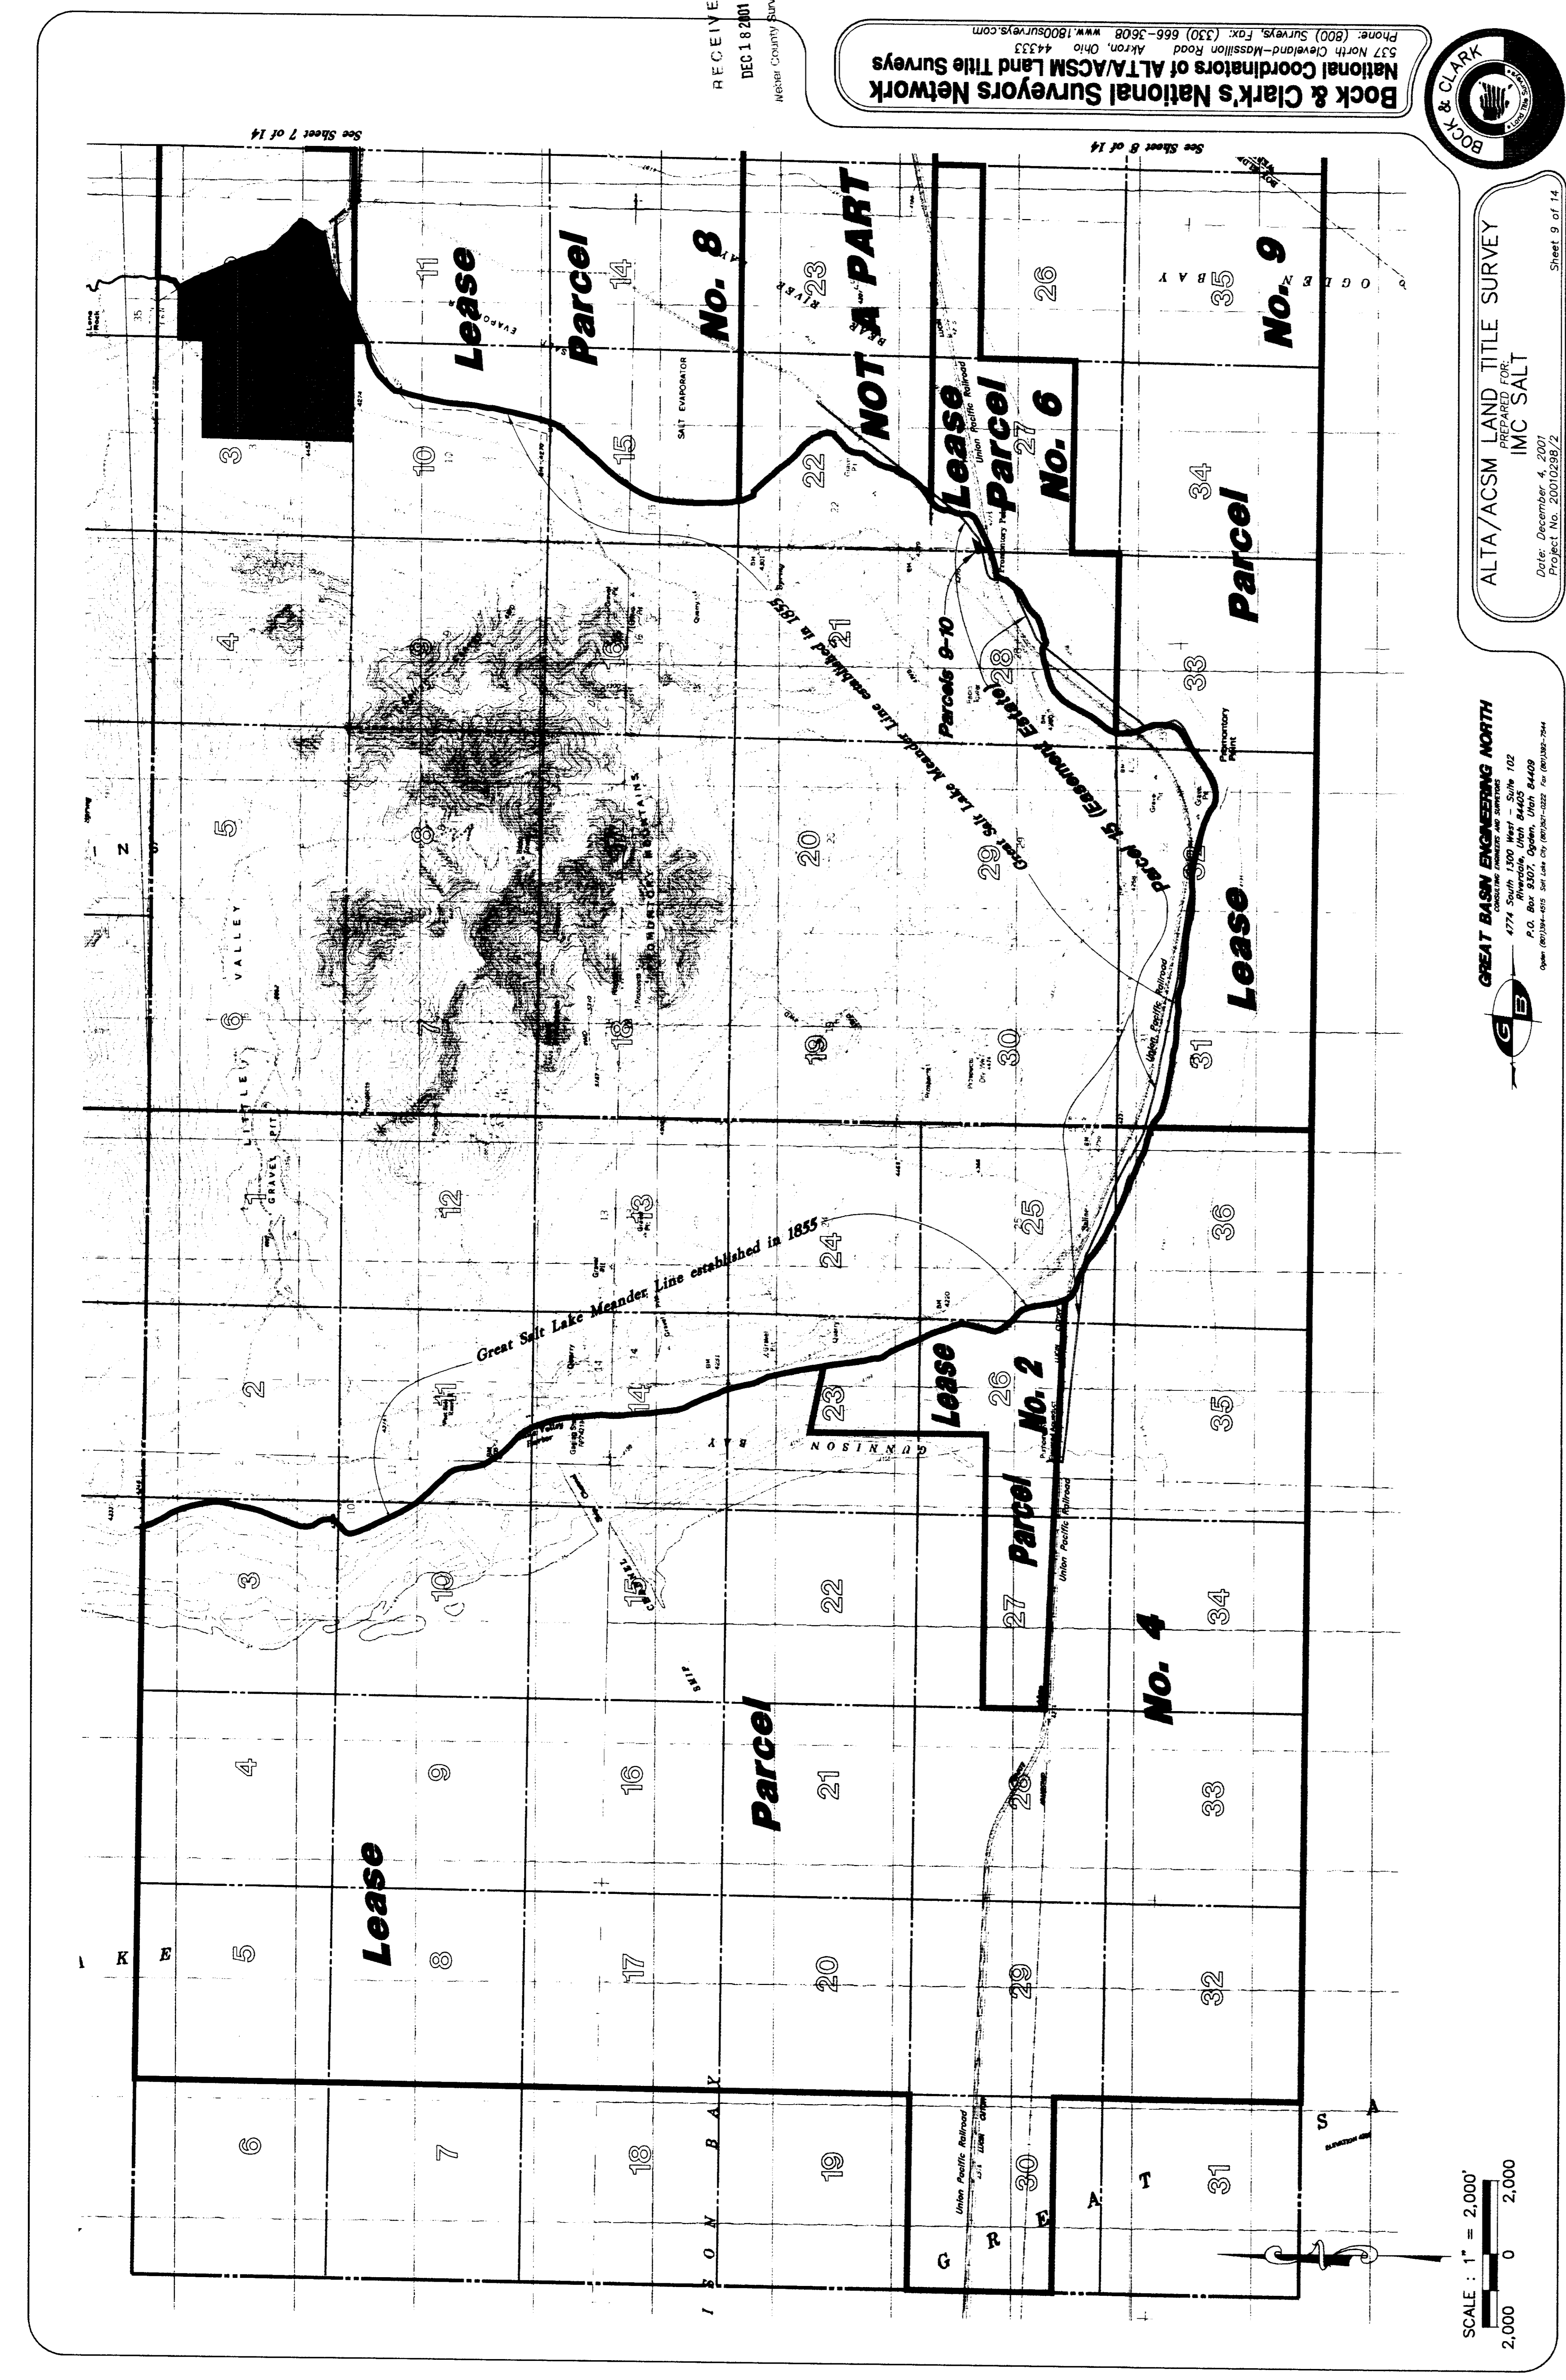

See Sheet 7 of 14

See Sheet 8 of 14

RECEIVED  
 DEC 18 2001  

**Bock & Clark's National Surveyors Network**  
 National Coordinators of ALTA/ACSM Land Title Surveys  
 Phone: (800) Surveys, Fax: (330) 666-3608  
 537 North Cleveland-Mossillon Road Akron, Ohio 44333  
 www.1800surveys.com



ALTA/ACSM LAND TITLE SURVEY  
 PREPARED FOR:  
 IMC SALT  
 Date: December 4, 2001  
 Project No. 20010289/2  
 Sheet 9 of 14

**GREAT BASIN ENGINEERING NORTH**  
 CONSULTING ENGINEERS AND SURVEYORS  
 4774 W. 112th St., Suite 102  
 P.O. Box 9307, Ogden, Utah 84409  

SCALE: 1" = 2,000'  
 2,000 0 2,000

02810


02810

02810

02810

W:\101310\101310.dwg, 12/04/2001 04:07:59 PM, AH



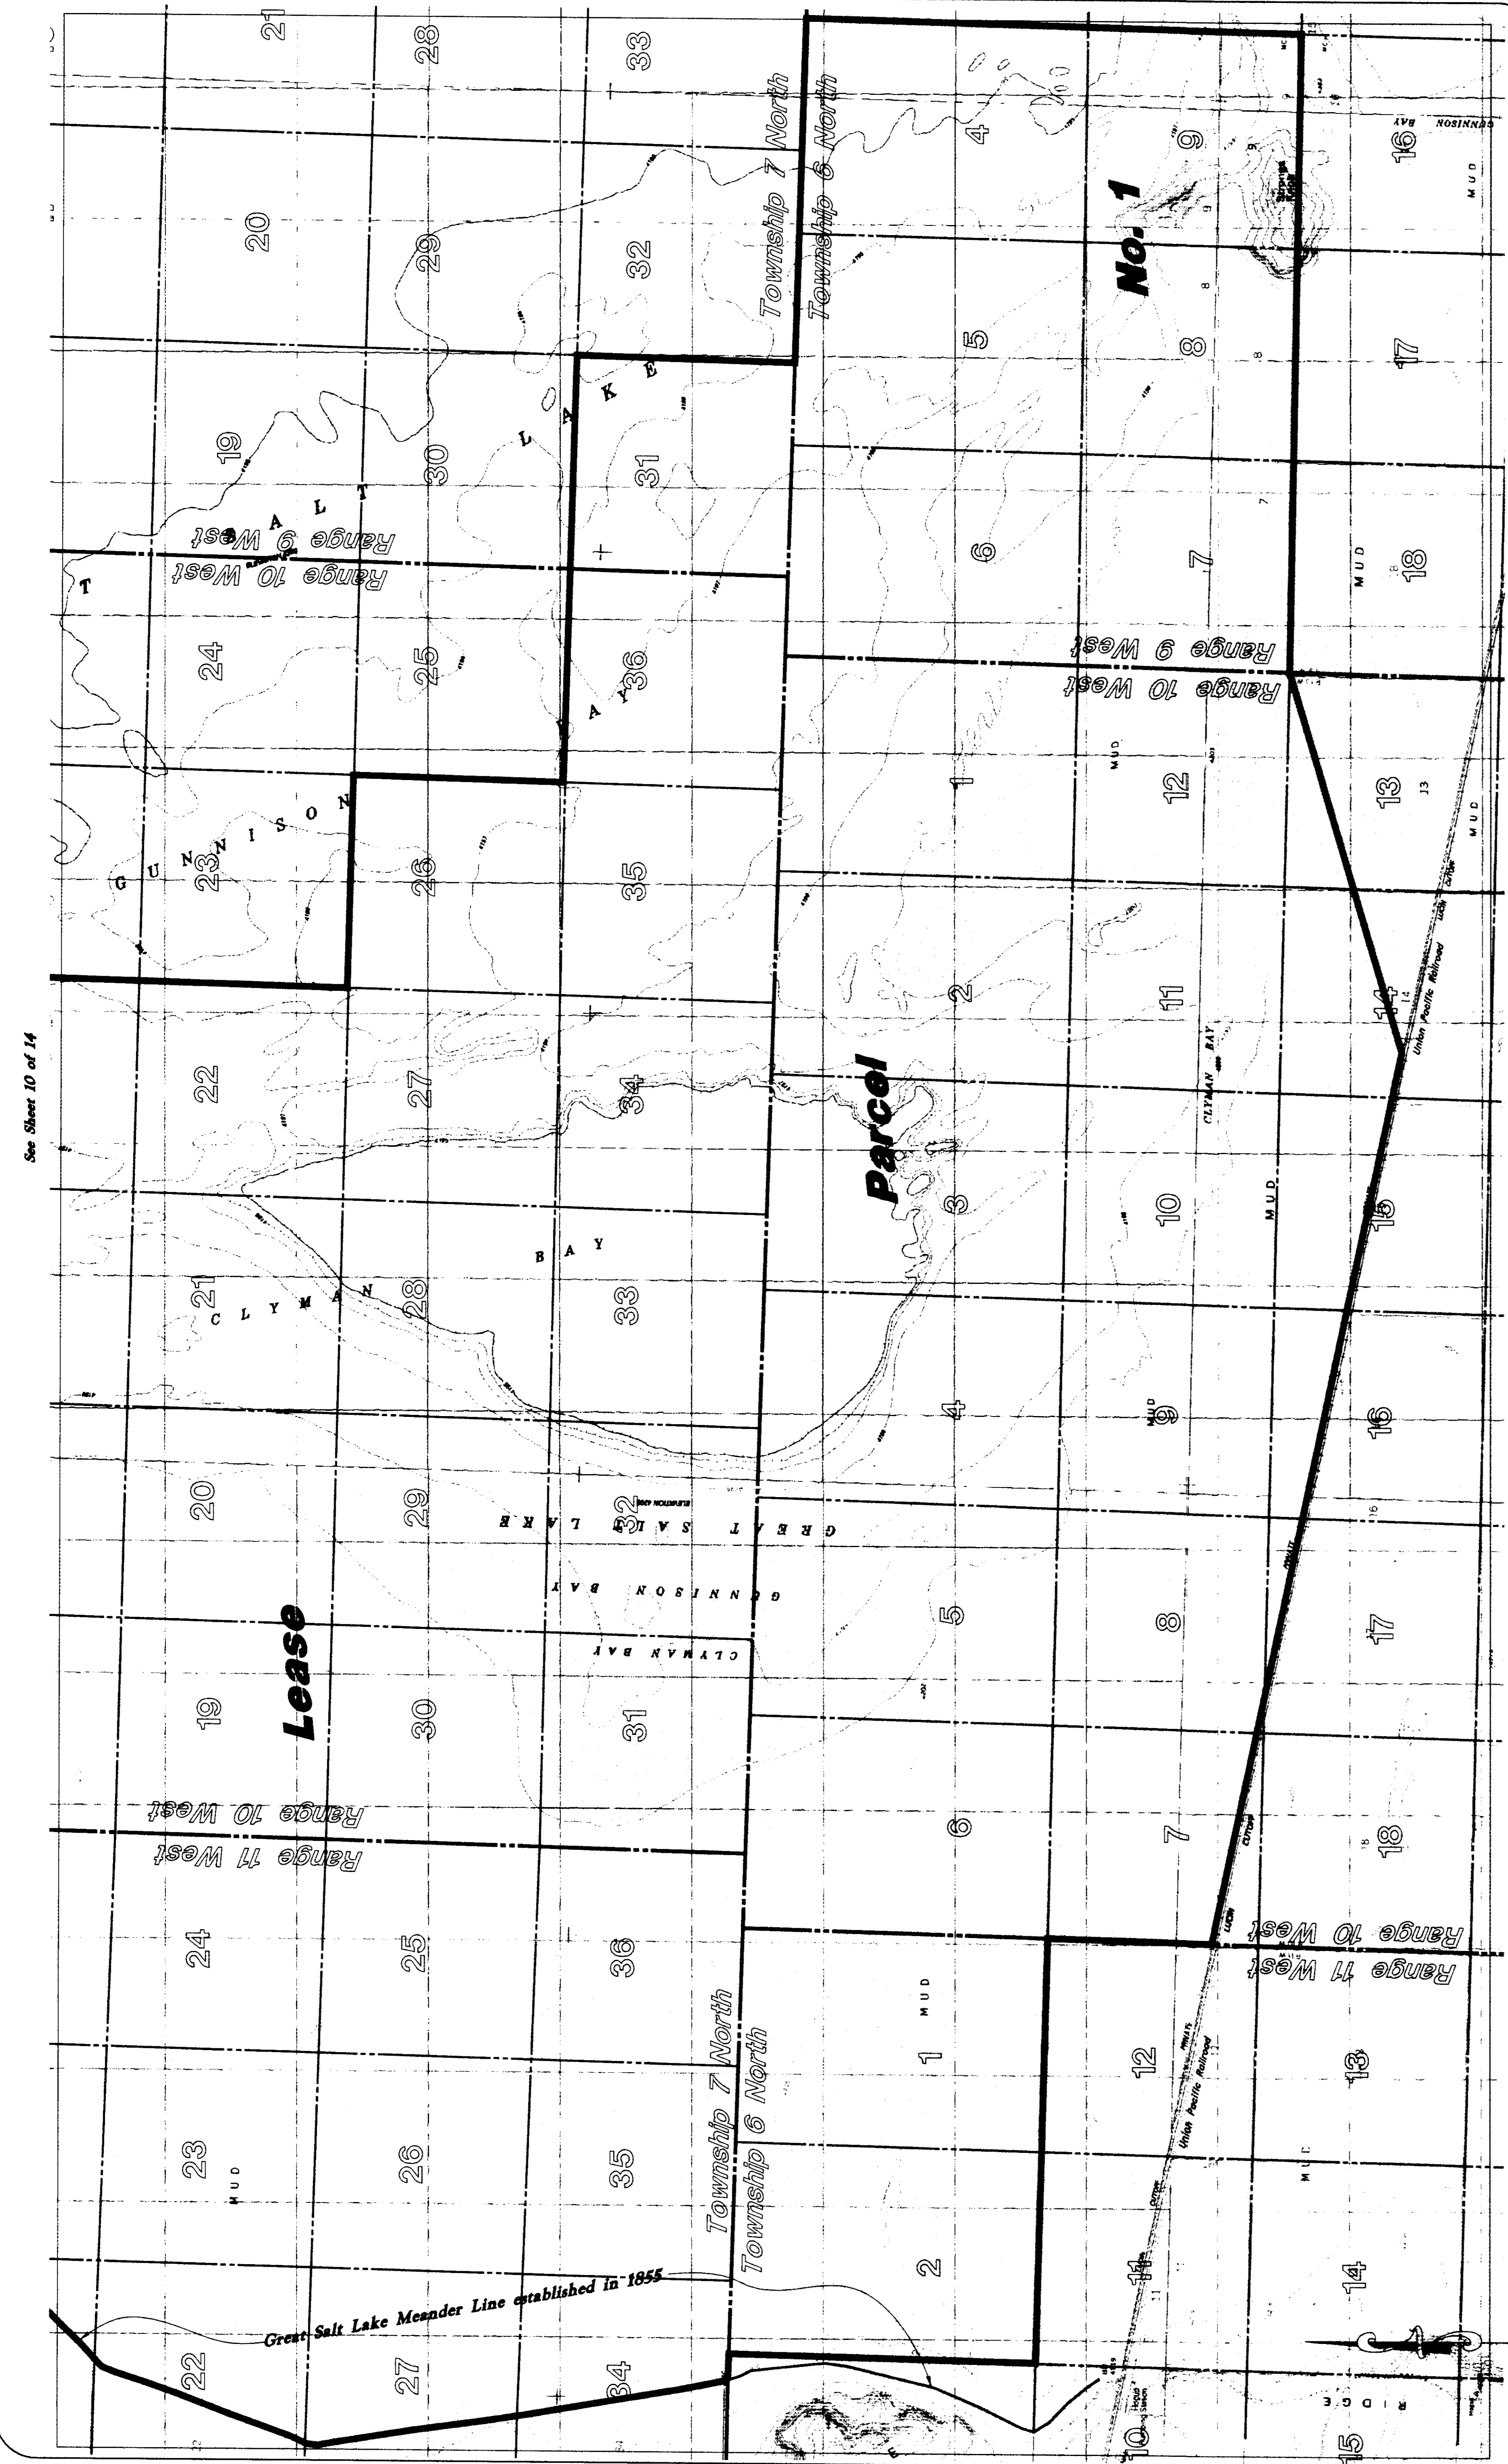

See Sheet 10 of 14

Lease

Parcel

No. 1

SCALE : 1" = 2,000'  
 2,000 0 2,000

**GREAT BASIN ENGINEERING NORTH**  
 CONSULTING ENGINEERS AND SURVEYORS  
 4774 S. WILSON BLVD. SUITE 102  
 P.O. BOX 3307, OGDEN, UTAH 84409  
 UTAH PROFESSIONAL ENGINEER LICENSE NO. 12444  
 UTAH PROFESSIONAL SURVEYOR LICENSE NO. 12444

**ALTA/ACSM LAND TITLE SURVEY**  
 PREPARED FOR:  
**IMC SALT**  
 Date: December 4, 2001  
 Project No. 20010298/2



**Bock & Clark's National Surveyors Network**  
 National Coordinators of ALTA/ACSM Land Title Surveys  
 537 North Cleveland-Mission Road Akron, OH 44333  
 Phone: (800) Surveys, Fax: (330) 666-3608, WWW: 1800surveys.com

RECEIVED  
 DEC 18 2001  
 ALTA/ACSM Land Title Surveys

Sheet 11 of 14



13 of 14


02810

02810

13 of 14

02810

W:\01\ENR\dwg\pnc\pnc.dwg, 12/04/2001 04:21:46 PM, AH

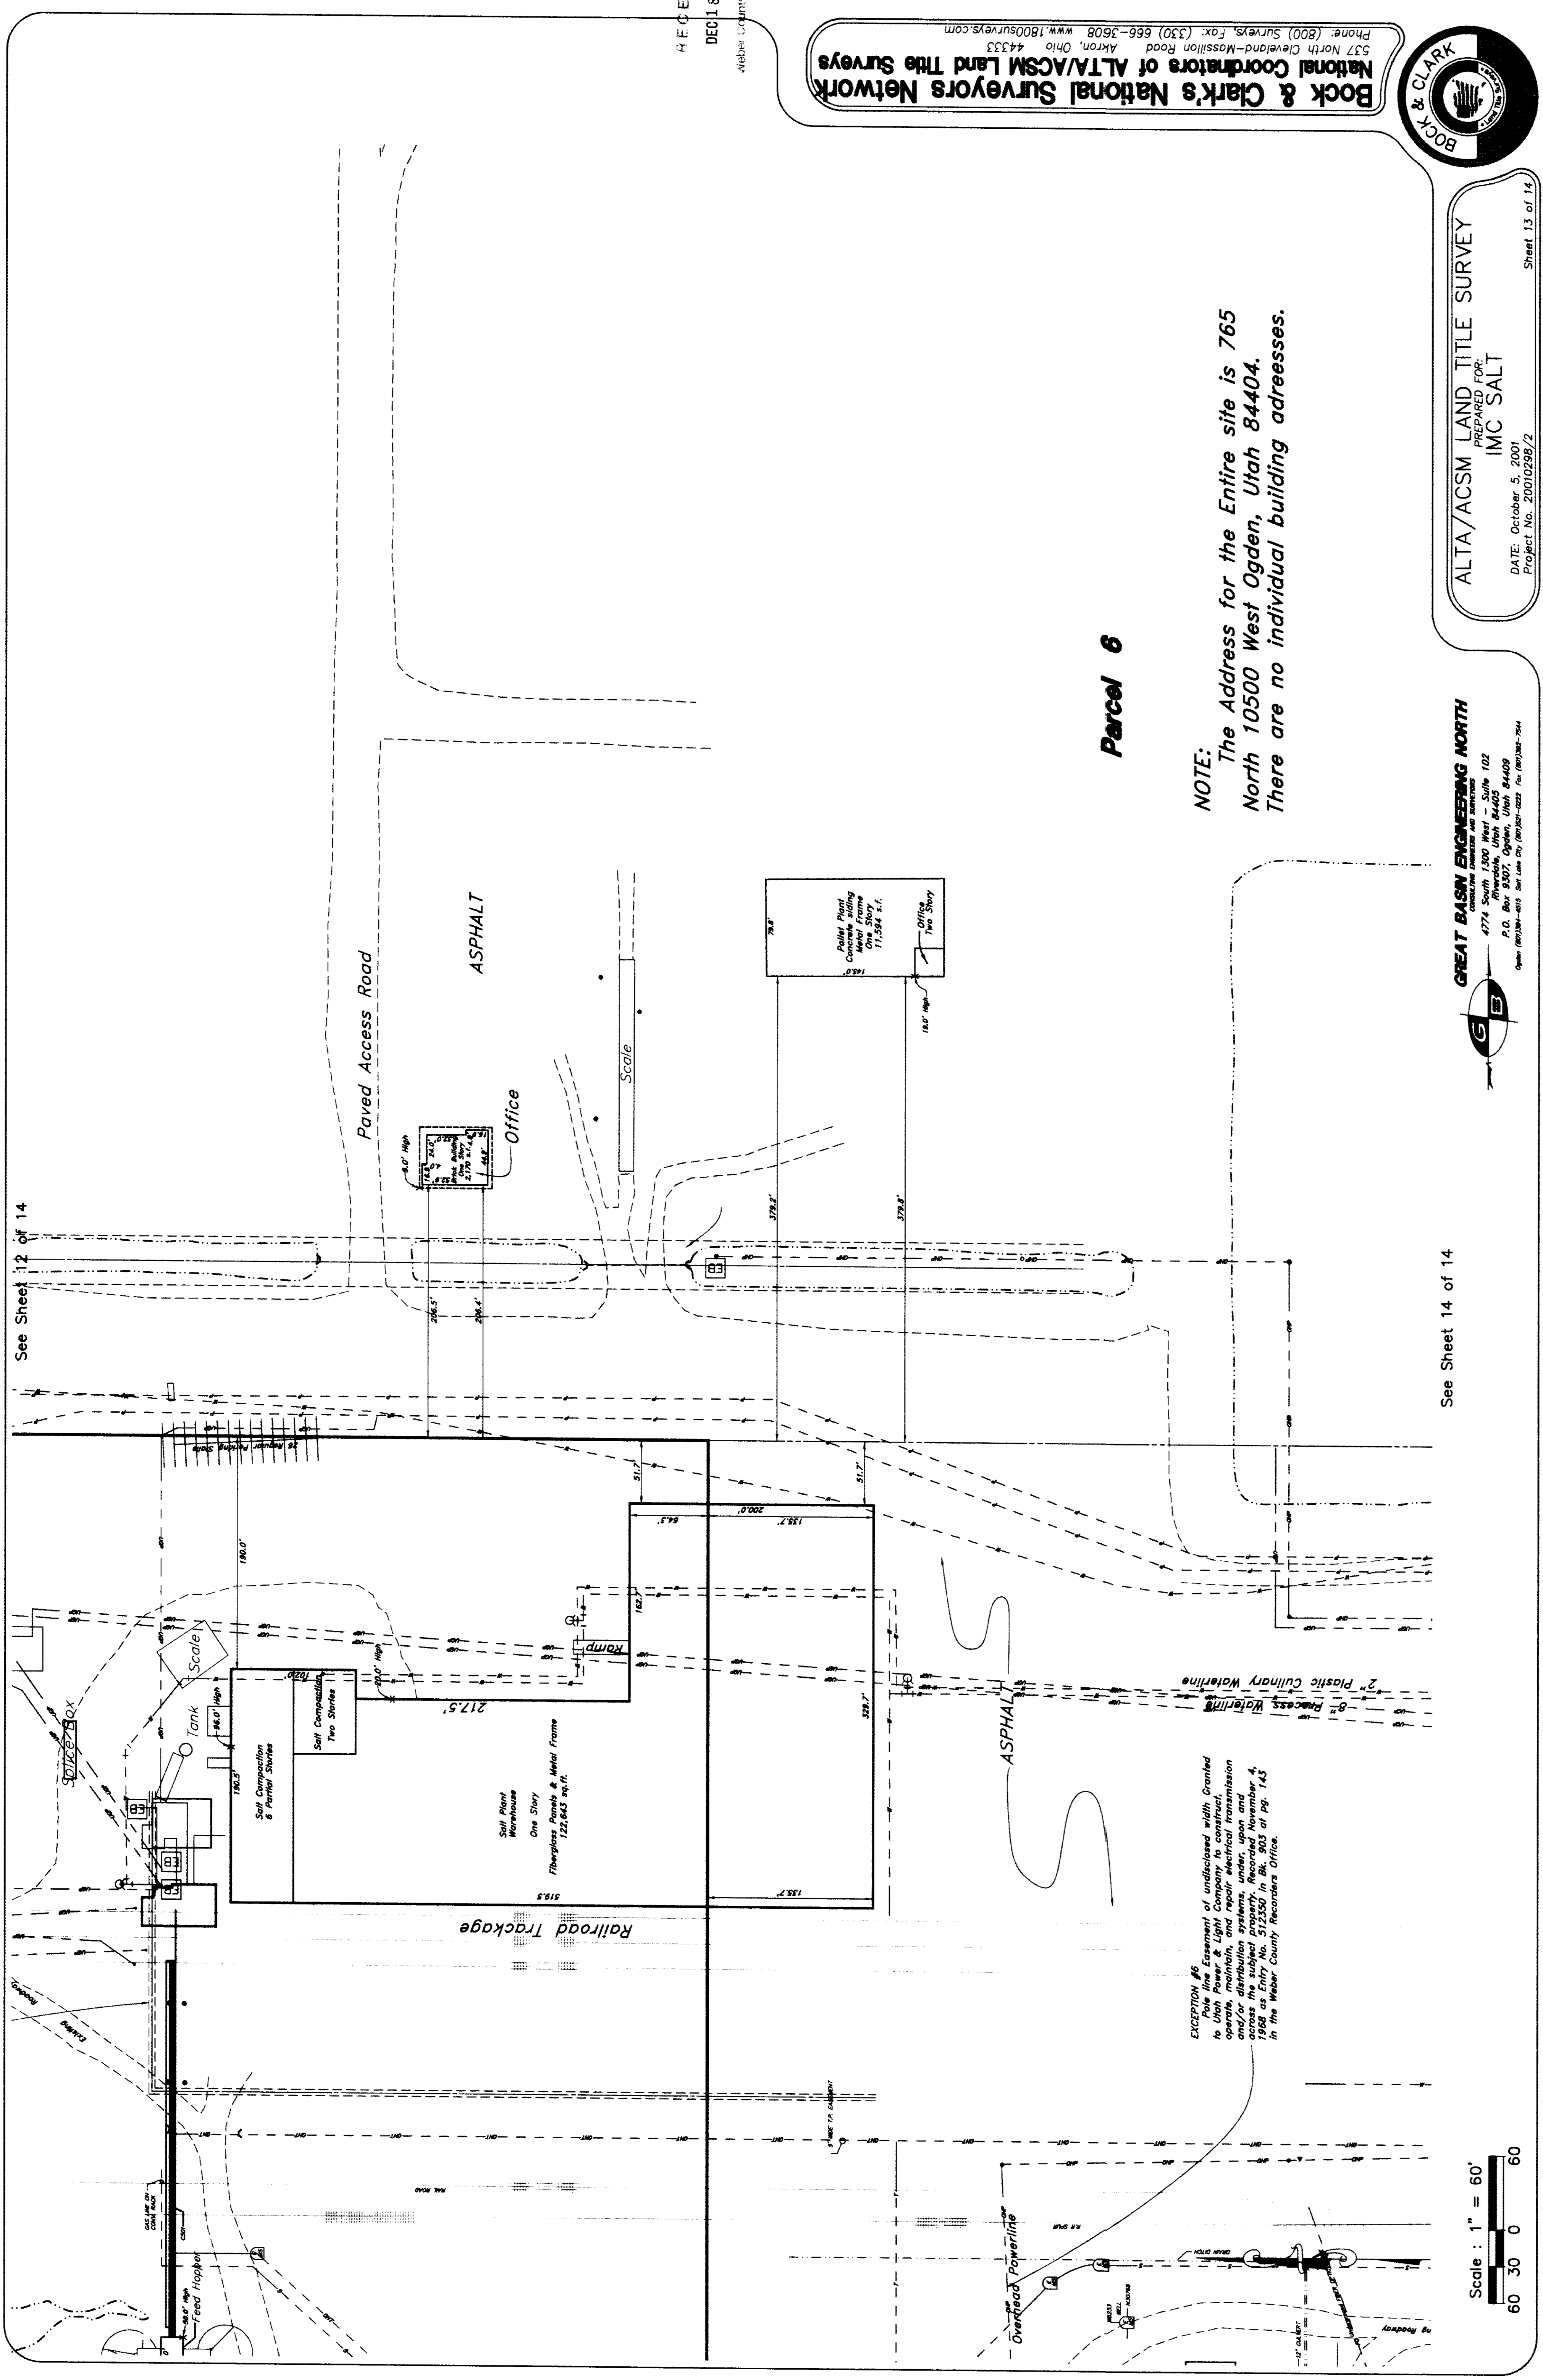

Parcel 6

NOTE:  
The Address for the Entire site is 765 North 10500 West Ogden, Utah 84404. There are no individual building addresses.

ALTA/ACSM LAND TITLE SURVEY  
PREPARED FOR  
IMC SALT  
DATE: October 5, 2001  
Project No. 20010298/2  
Sheet 13 of 14

GREAT BASIN ENGINEERING NORTH  
Scale: 1" = 60'

Bock & Clark's National Surveyors Network  
National Coordinators of ALTA/ACSM Land Title Surveys  
537 North Cleveland-Mission Road Akron, Ohio 44333  
Phone: (800) Surveys, Fax: (330) 666-3608 www.1800surveys.com


RECEIVED  
DEC 18 2001  
Weber County Surveyors

Scale: 1" = 60'  
60 30 0 60

See Sheet 14 of 14

See Sheet 12 of 14

See Sheet 13 of 14

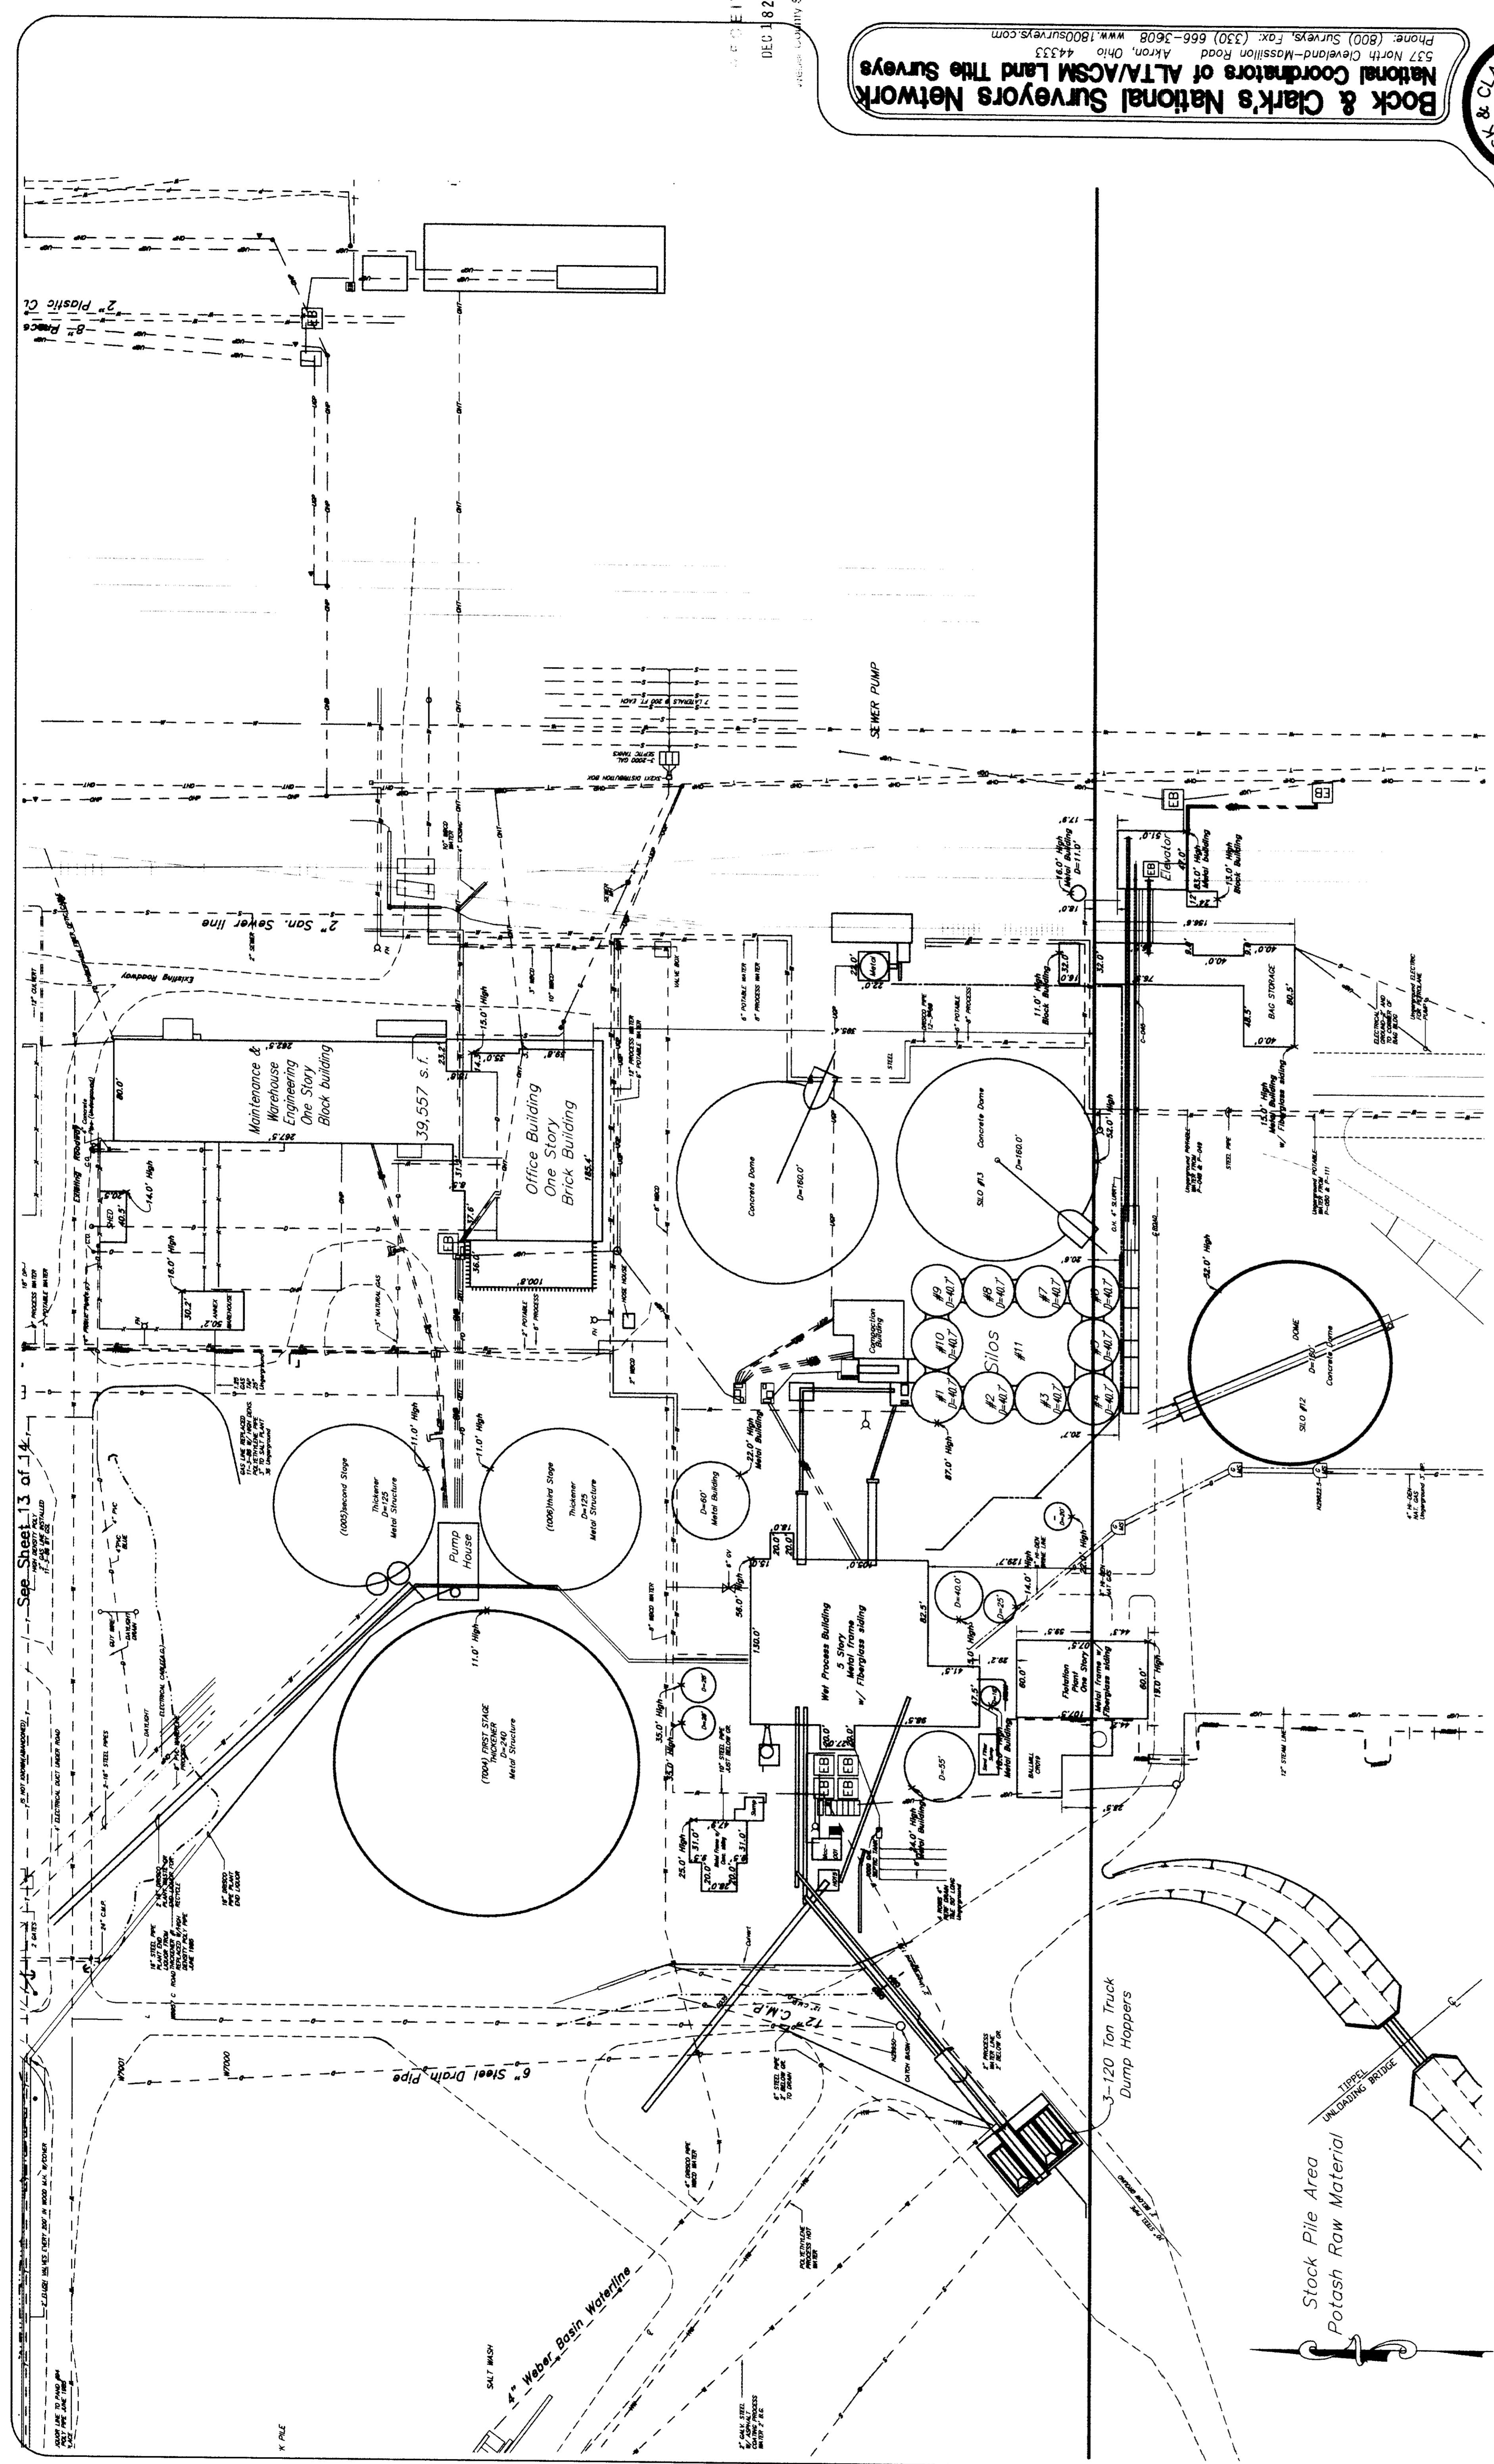

ALTA/ACSM LAND TITLE SURVEY  
 PREPARED FOR:  
 IMC SALT  

GREAT BASIN ENGINEERING NORTH  
 4774 South 1500 West - Suite 102  



BOCK & CLARK'S National Surveyors Network  
 National Coordinators of ALTA/ACSM Land Title Surveys  
 Phone: (800) Surveys, Fax: (330) 666-3608  
 537 North Cleveland-Mission Road, Akron, Ohio 44333  
 www.1800surveys.com



RECEIVED  
 DEC 18 2001  
