

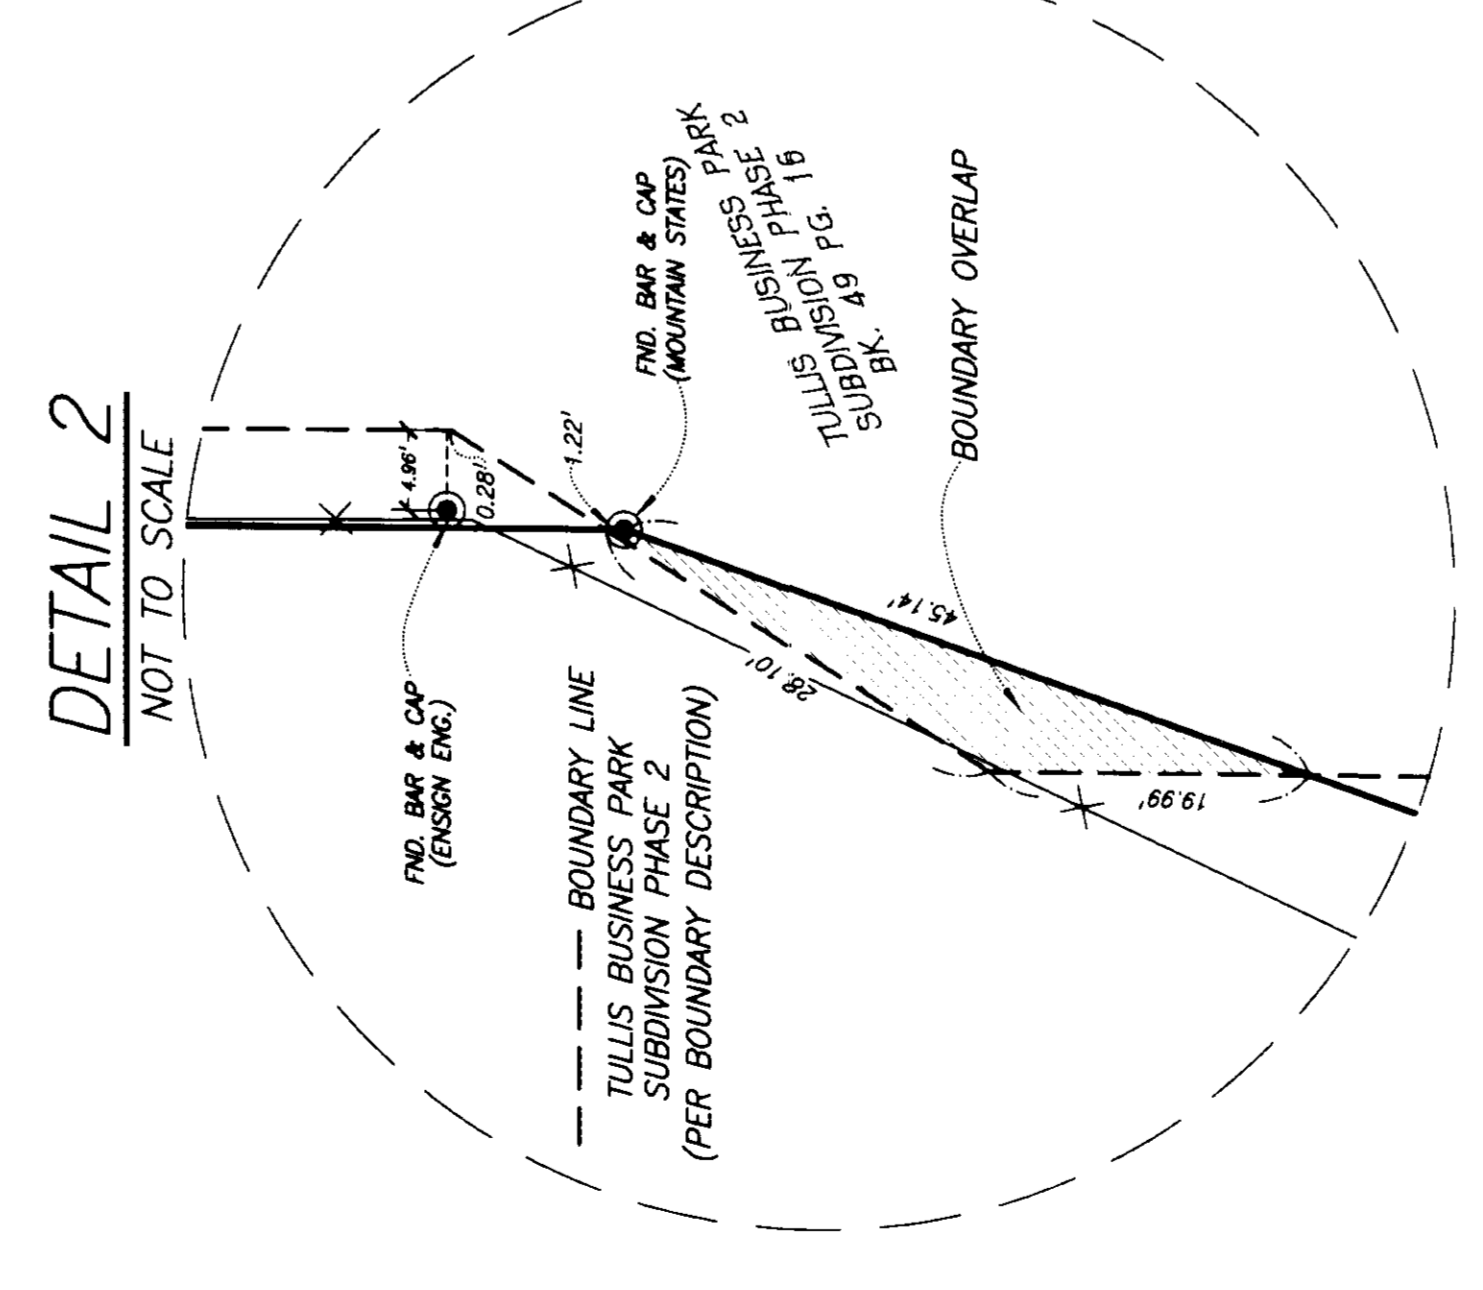
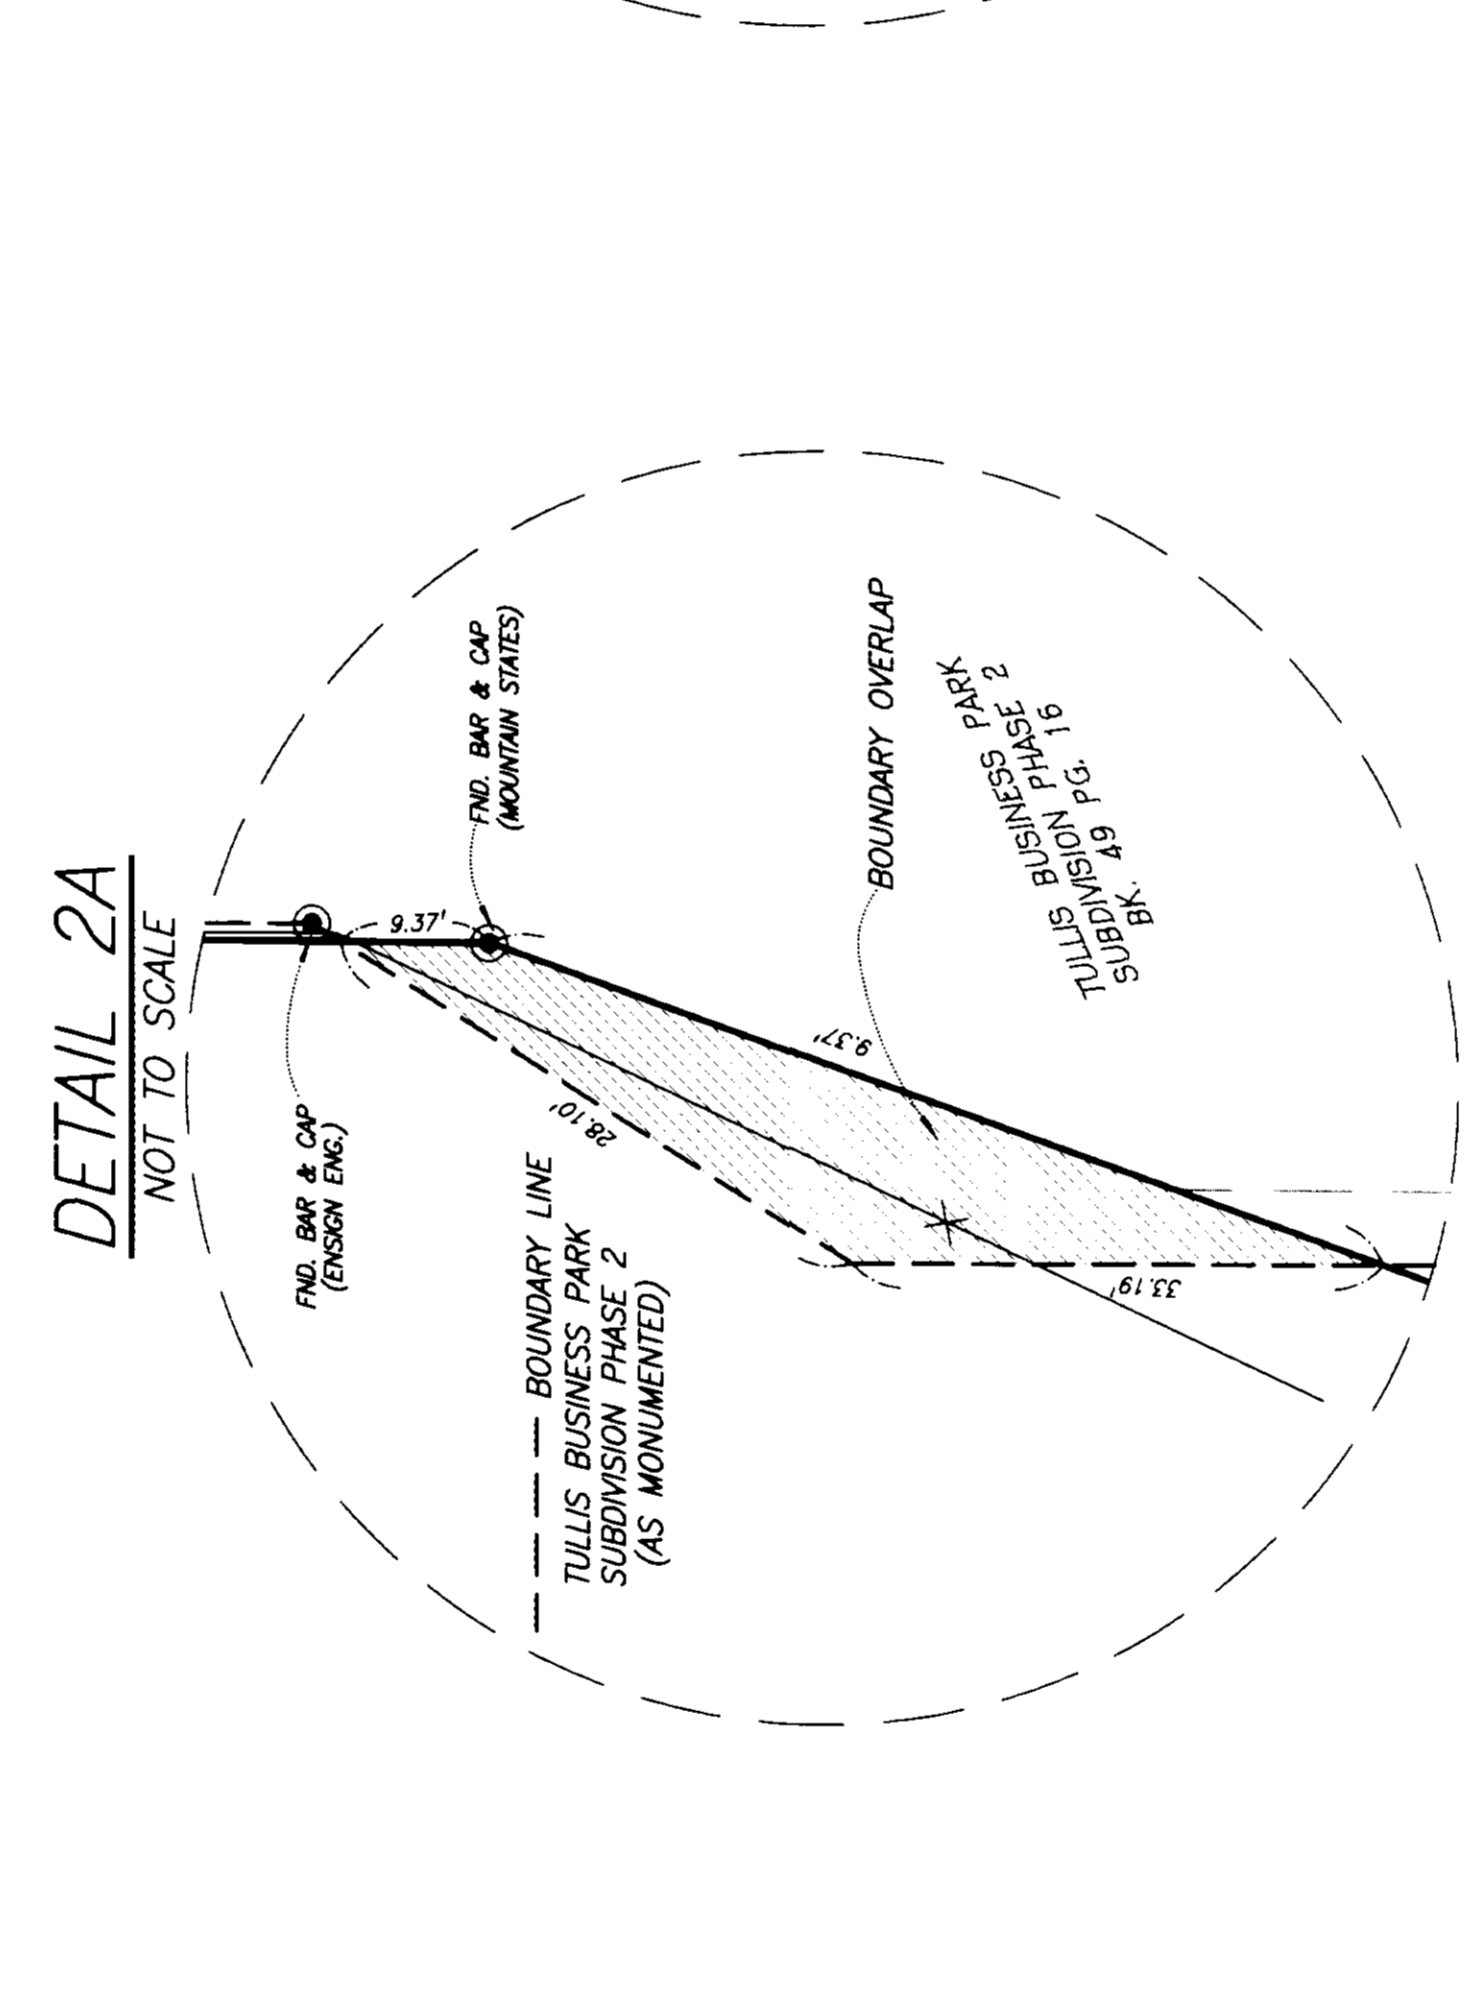
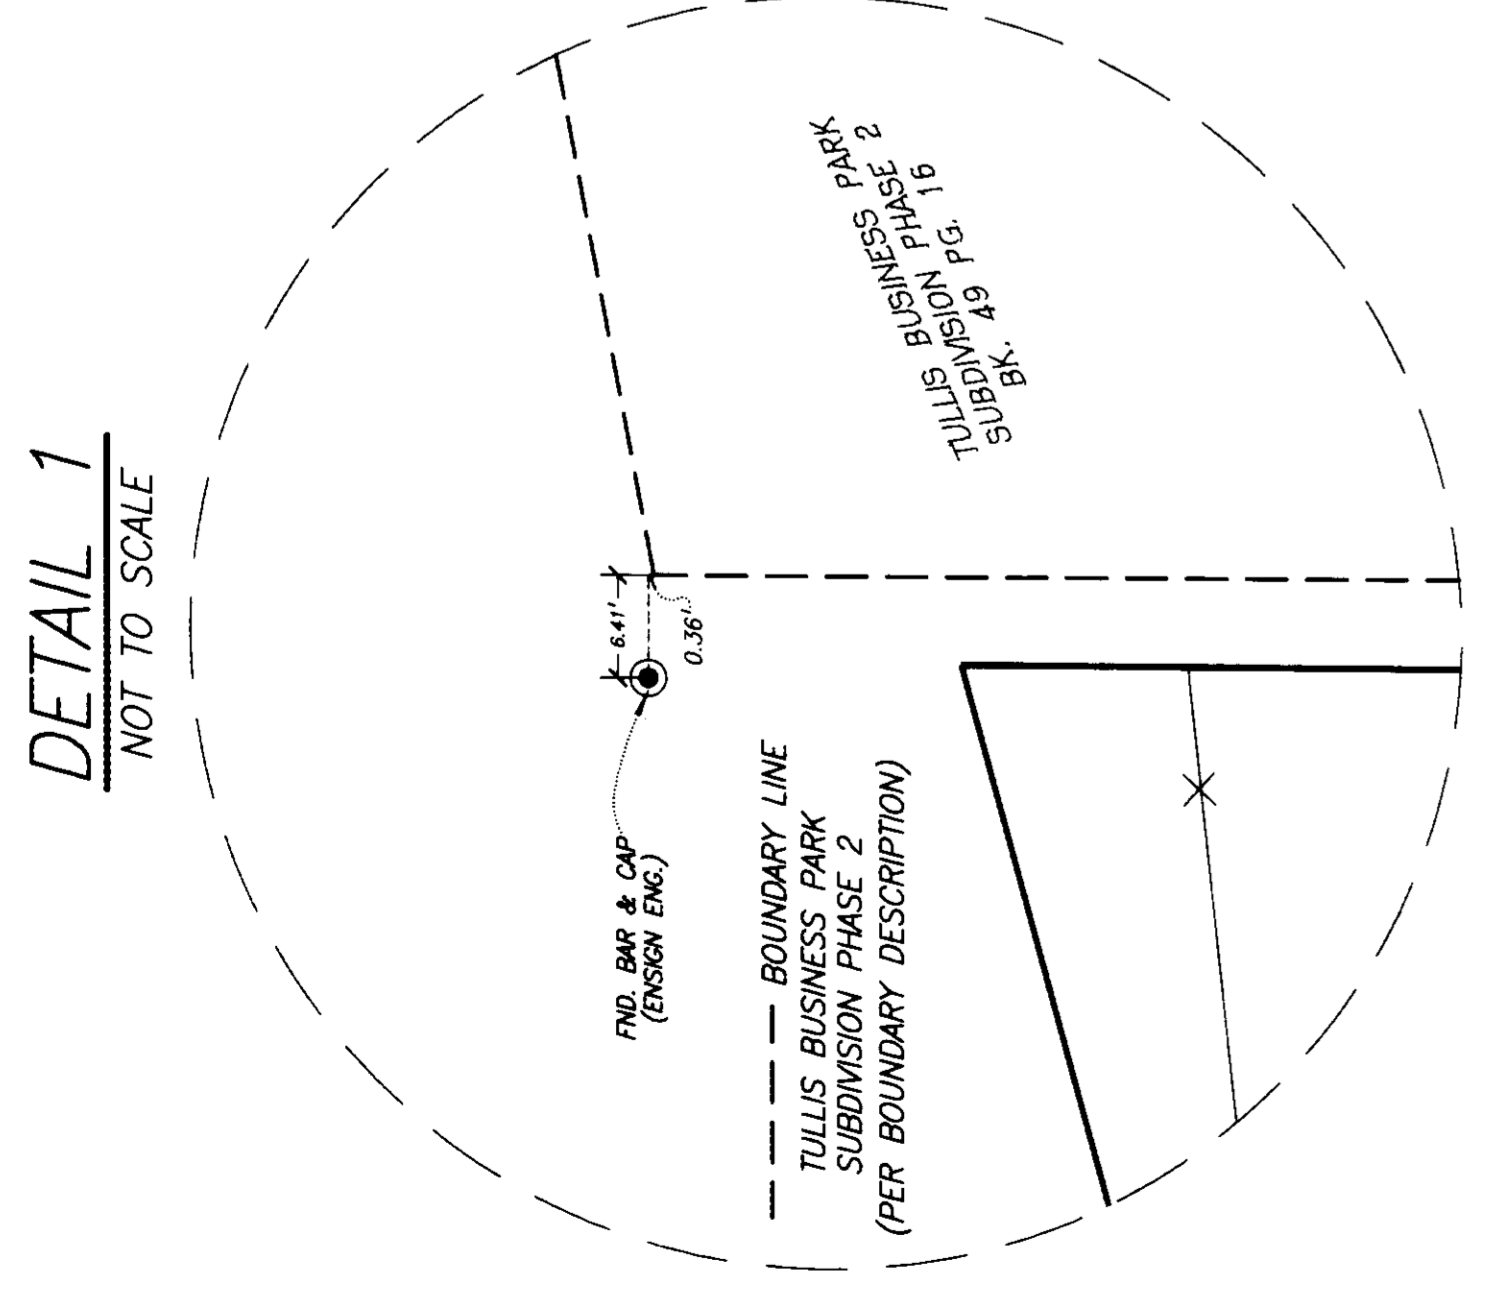
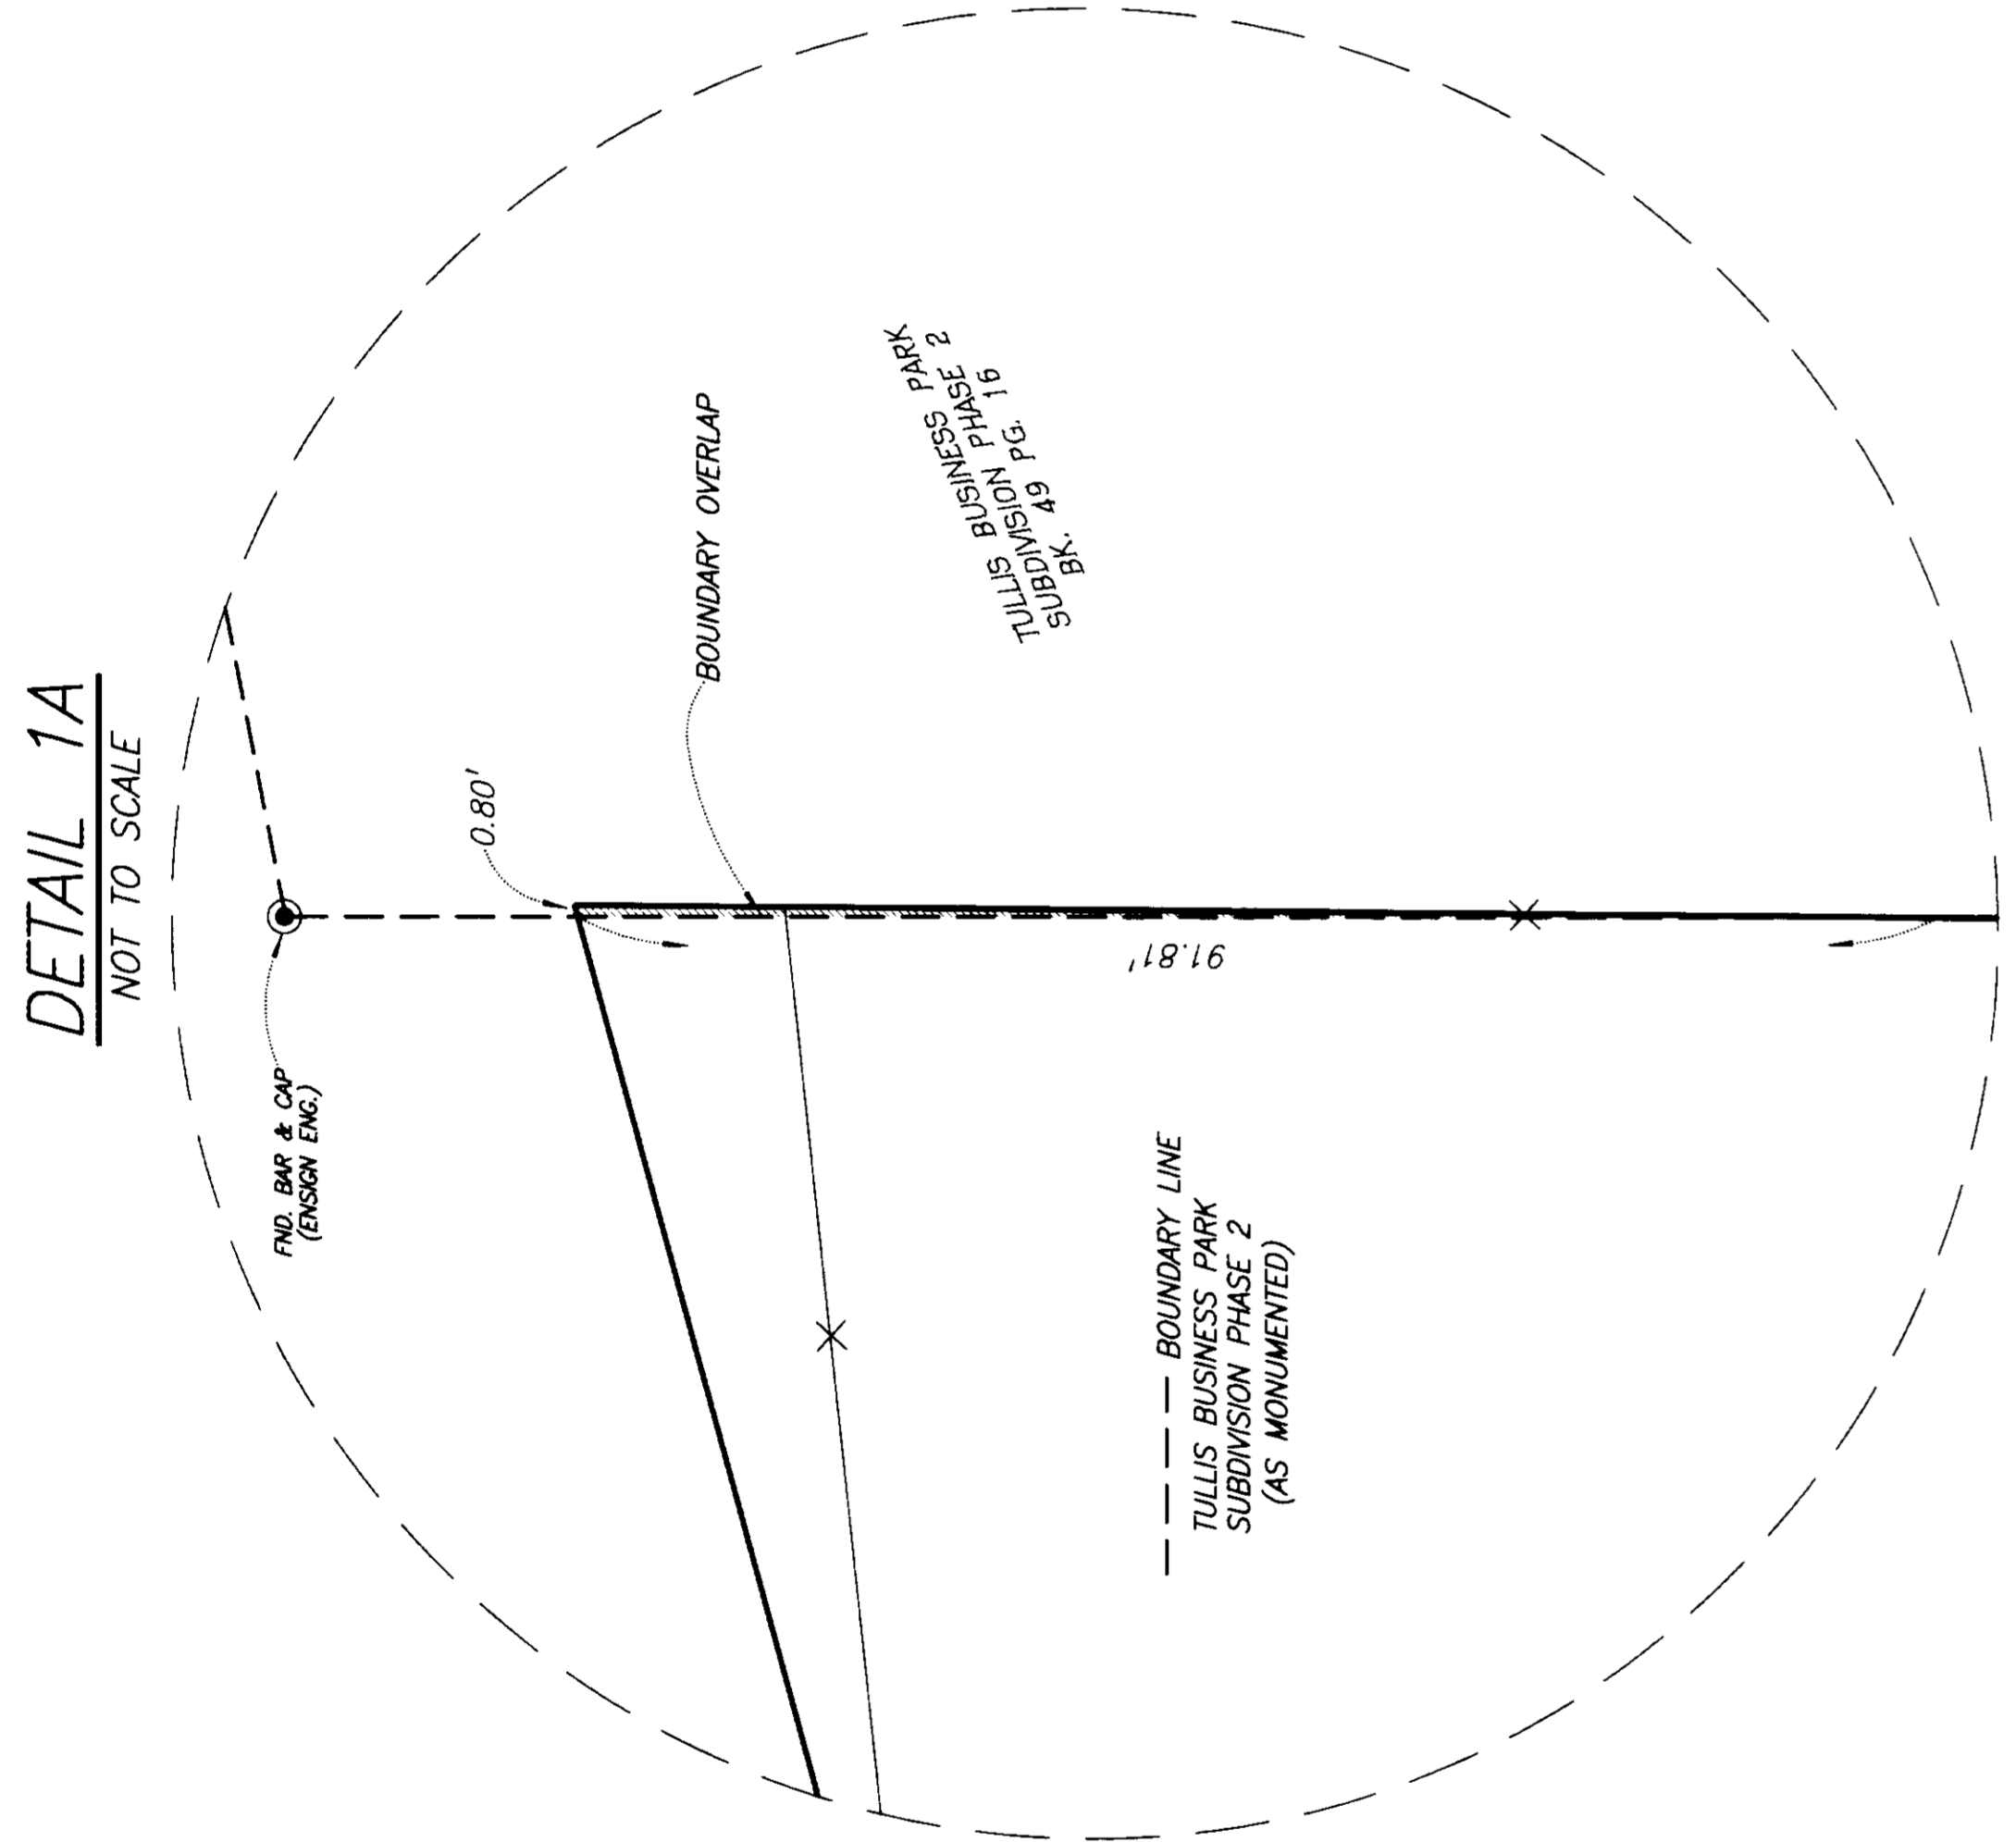


RECEIVED
JAN 03 2000
Weber County Surveyor

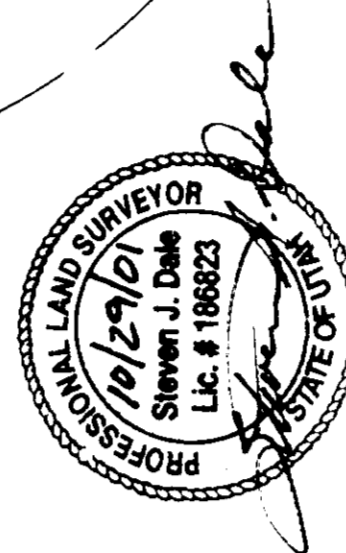

DETAIL 4
NOT TO SCALE

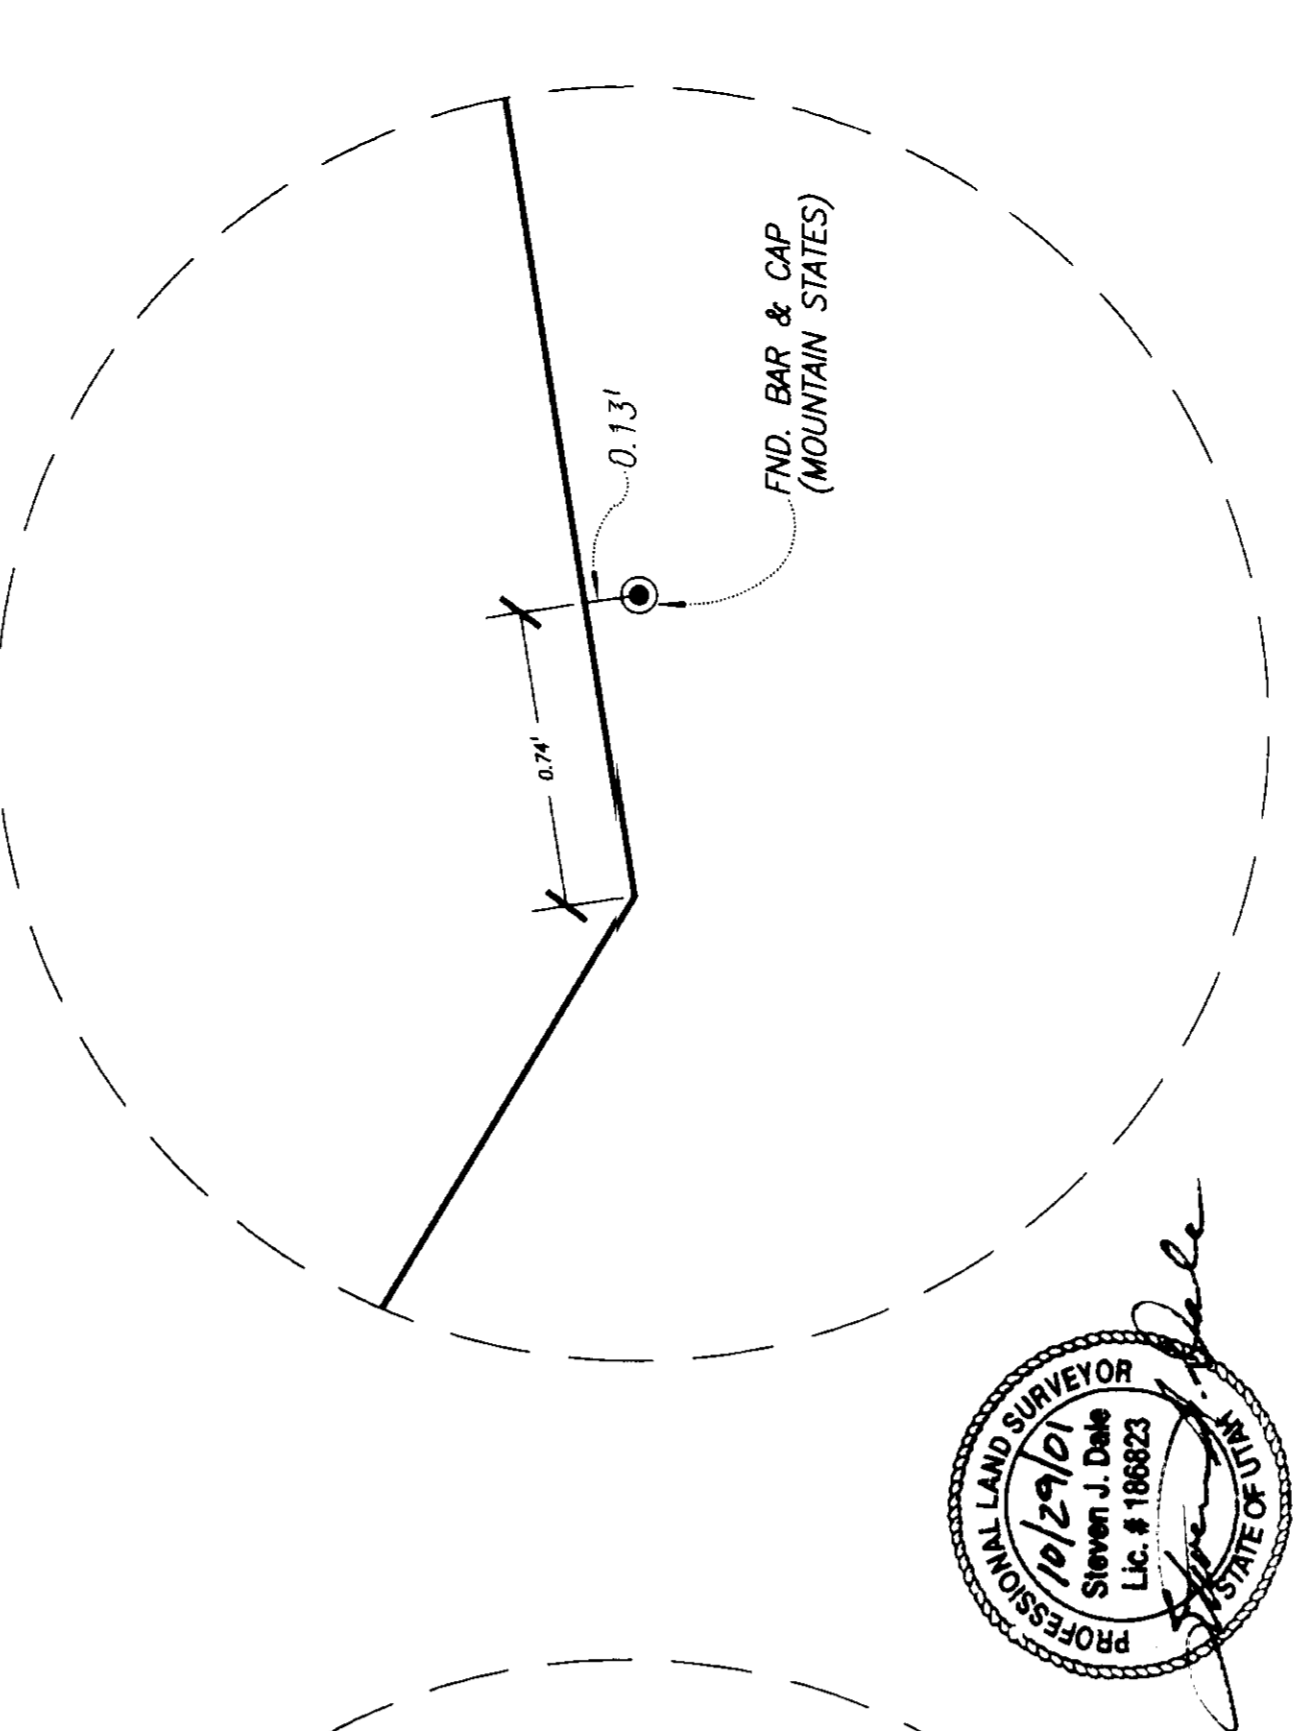

NO.	REVISIONS	DESCRIPTIONS	DATE

CHERRY CREEK ASSOCIATES, LLC.
1557 WEST RIVERDALE ROAD
RIVERDALE UTAH

CHERRY CREEK APARTMENTS
1557 WEST RIVERDALE ROAD

CHERRY CREEK ASSOCIATES, LLC.
1557 WEST RIVERDALE ROAD
RIVERDALE UTAH

THOMPSON-HYSELL ENGINEERS
A DIVISION OF THE KETHL COMPANIES
590 WEST LENOX DRIVE, SUITE 100, TAYLORSVILLE, UTAH 84143 (801) 745-0908

APPROVED BY:
SCALE: 1"=40'
DATE: 10-29-01
FILE: 11.281500 (S)P/ALZ-HO.DWG

SHEET NUMBER
2
OF **2**

5N2W.13

002812

