002813

002813

002813

002813

C:\01\01-3-228\drawings\01-3-228.dwg Wed Dec 19 08:08:16 2001 Greg

## Narrative

The control used to establish the property corners was the existing Ogden City Survey Monumentation along 24th street from "B" Ave, "C" Ave and "D" Ave. which line is the basis of bearing assumed to bear North 89°02'00" West. The North Property line is a line perpendicular and 50' south of the centerline of the O.S.L.R.R.

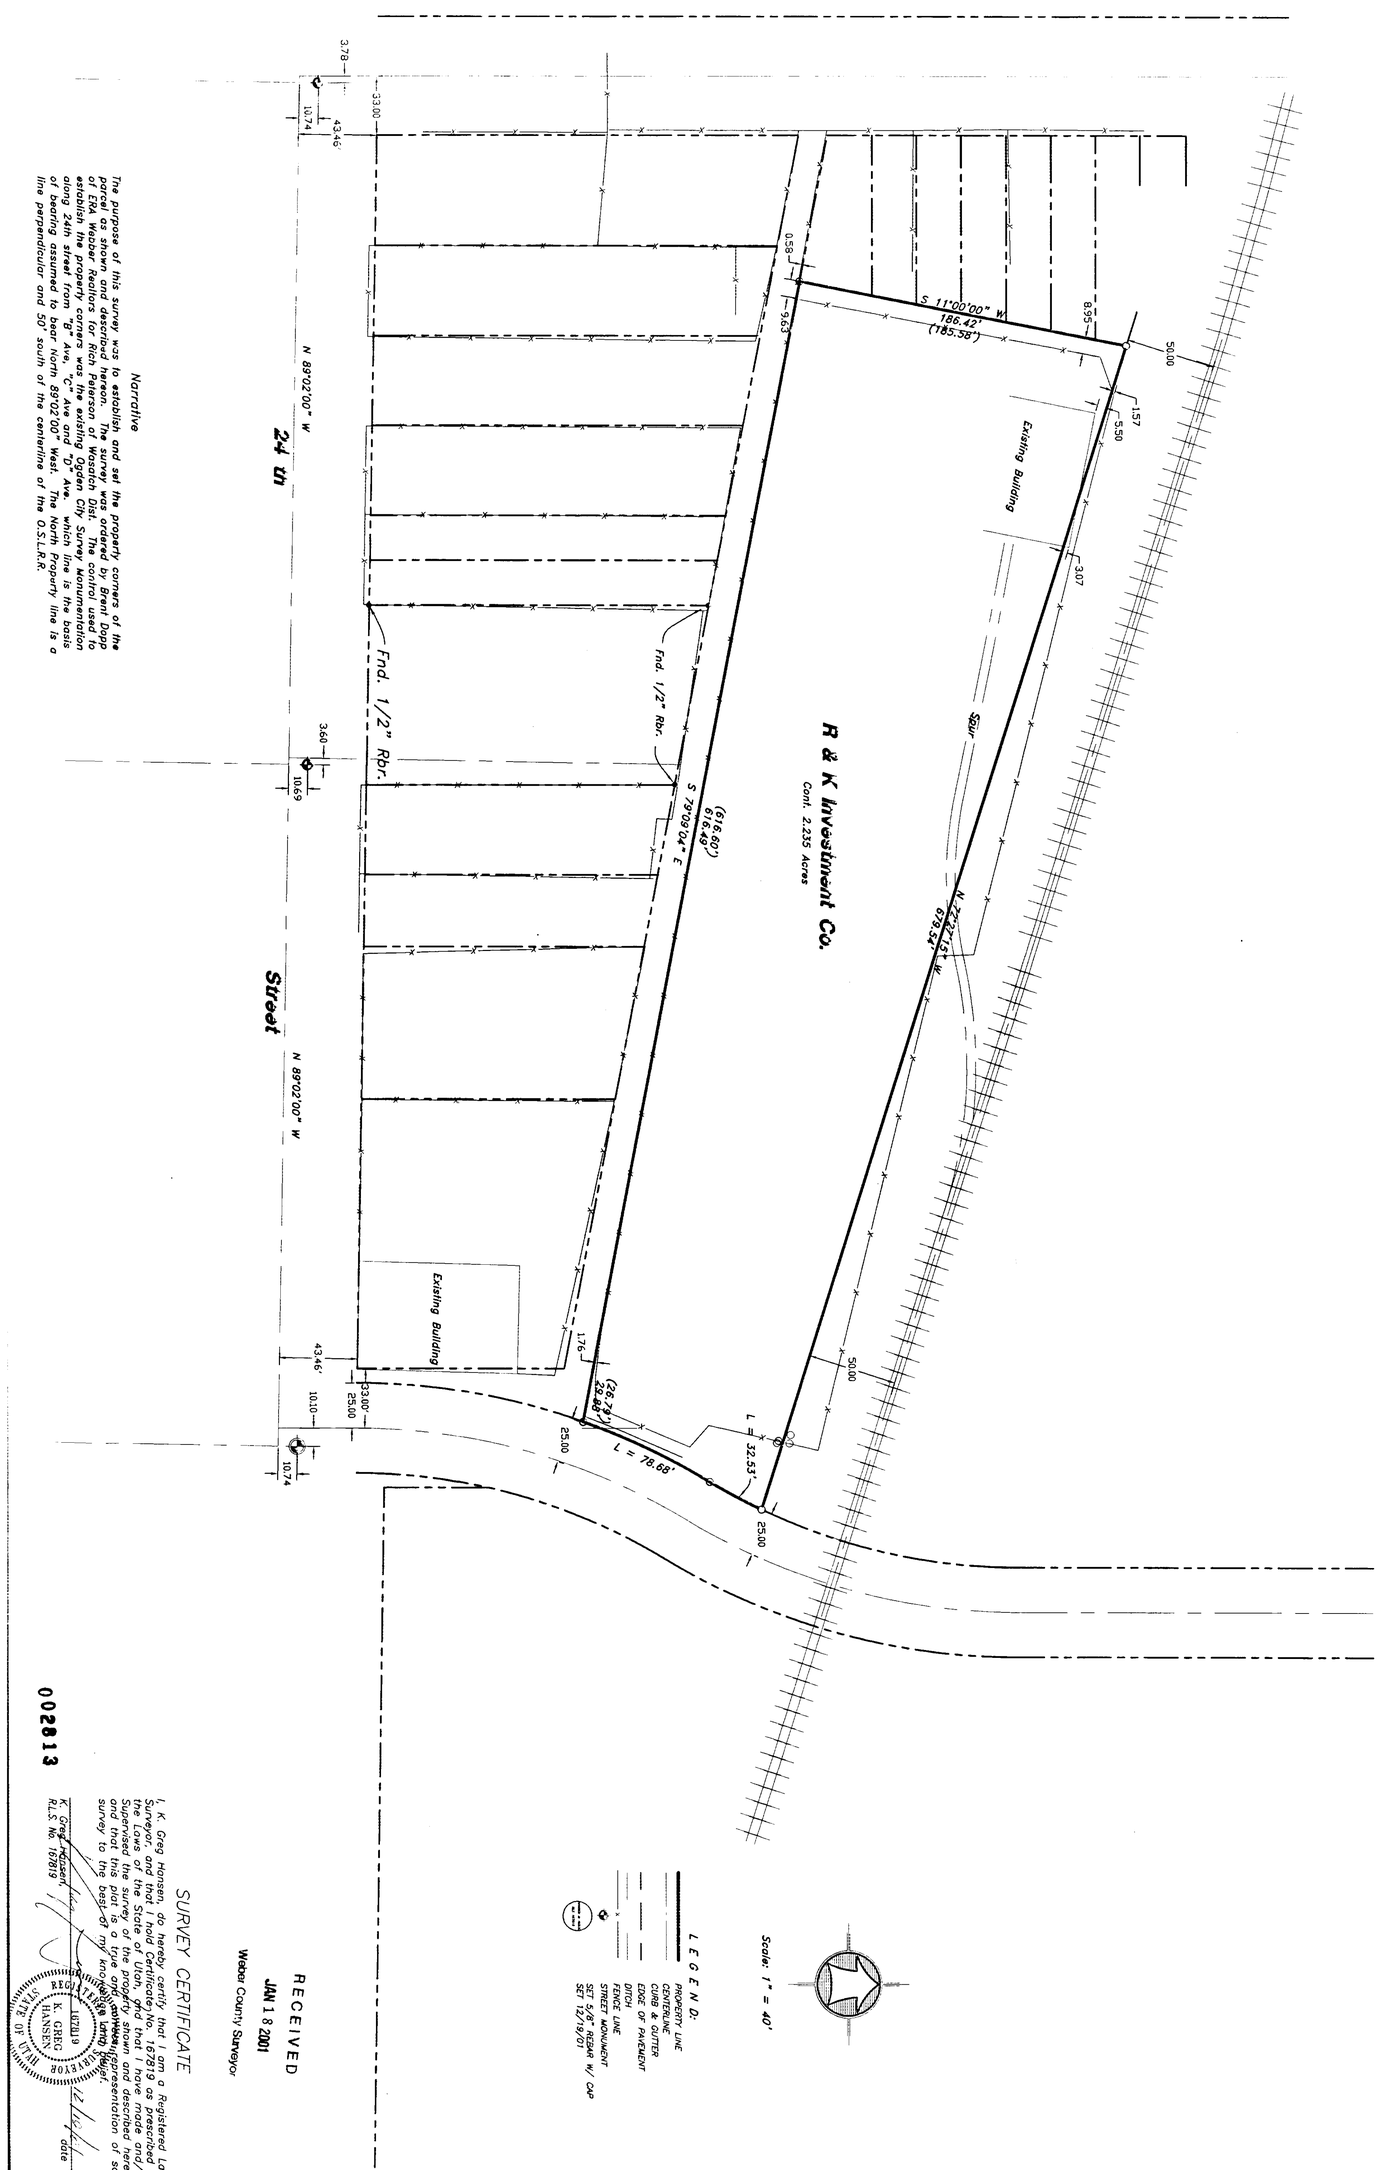


RECEIVED
JAN 18 2001
Weber County Surveyor

## SURVEY CERTIFICATE

I, K. Greg Hansen, do hereby certify that I am a Registered Land Surveyor, and that I hold Certificate No. 167819 as prescribed by the Laws of the State of Utah, and that I have made and/or Supervised the survey of the property shown and described hereon and that this plat is a true and correct representation of said survey to the best of my knowledge and belief.

K. Greg Hansen, R.L.S. No. 167819

12/19/01
date

002813

| | | | |
|---|---|---|---|
| PROPERTY SURVEY FOR **Wasatch Distributing** 2361 "B" Ave. Ogden, Weber County, Utah A PART OF THE SOUTHEAST QUARTER OF SECTION 30, TOWNSHIP 6 NORTH, RANGE 1 WEST, S.L.B.& M. | Drawn By: KGH Date: 12/17/01<br>Designed By:<br>Checked By:<br>Approved By:<br>Scale: 1" = 40'<br>Drawing File: 01-3-228.DWG<br>JOB NUMBER: 01-3-228 | HANSEN & ASSOCIATES, INC. Consulting Engineers and Land Surveyors<br>538 North Main Brigham City, Utah 84302<br>Brigham City 723-3491 Ogden 399-4905 Logan 752-8272 | SHEET 1 OF 1 SHEETS |

| No. | Date | By | Revision |
|---|---|---|---|