


McNEIL ENGINEERING AND LAND SURVEYING, L.C. PROFESSIONAL CIVIL ENGINEERING & LAND SURVEYING SERVICES

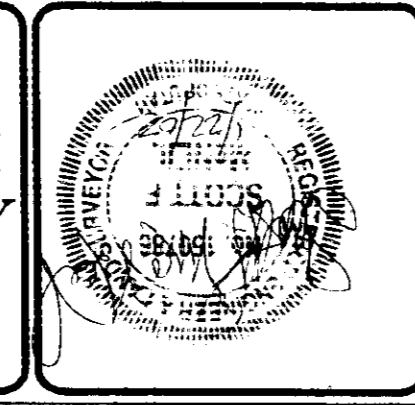

WORTH WILLIAMS 12TH SOUTH STREET & WALL AVENUE OGDEN UTAH BOUNDARY TOPOGRAPHIC SURVEY

Table with columns: REV. NO., DATE, DESCRIPTION. Includes Job No. 0020495, Scale 1" = 20', and Date 11/16/01.

002826 NORTH SCALE: 1" = 20'


- LEGEND: WATER METER, WATER VALVE, FIRE HYDRANT, LIGHT POLE, OVERHEAD AND/OR UNDERGROUND POWER LINE, etc.

BOUNDARY DESCRIPTION: ALL OF LOT 2 OF OGDEN HOME DEPOT SUBDIVISION AS RECORDED WITH THE OFFICE OF THE WEBER COUNTY RECORDER.

SUBDIVISION CERTIFICATE: SCOTT F. McNEIL, CIVIL ENGINEER AND SURVEYOR, LICENSE NO. 150786.

Signature of Scott F. McNeil, License No. 150786.

NOTICE: THE SURVEY WAS PREPARED FOR WORTH WILLIAMS FOR THE PURPOSE OF ESTABLISHING THE BOUNDARY OF THE ABOVE DESCRIBED PARCELS OF LAND...

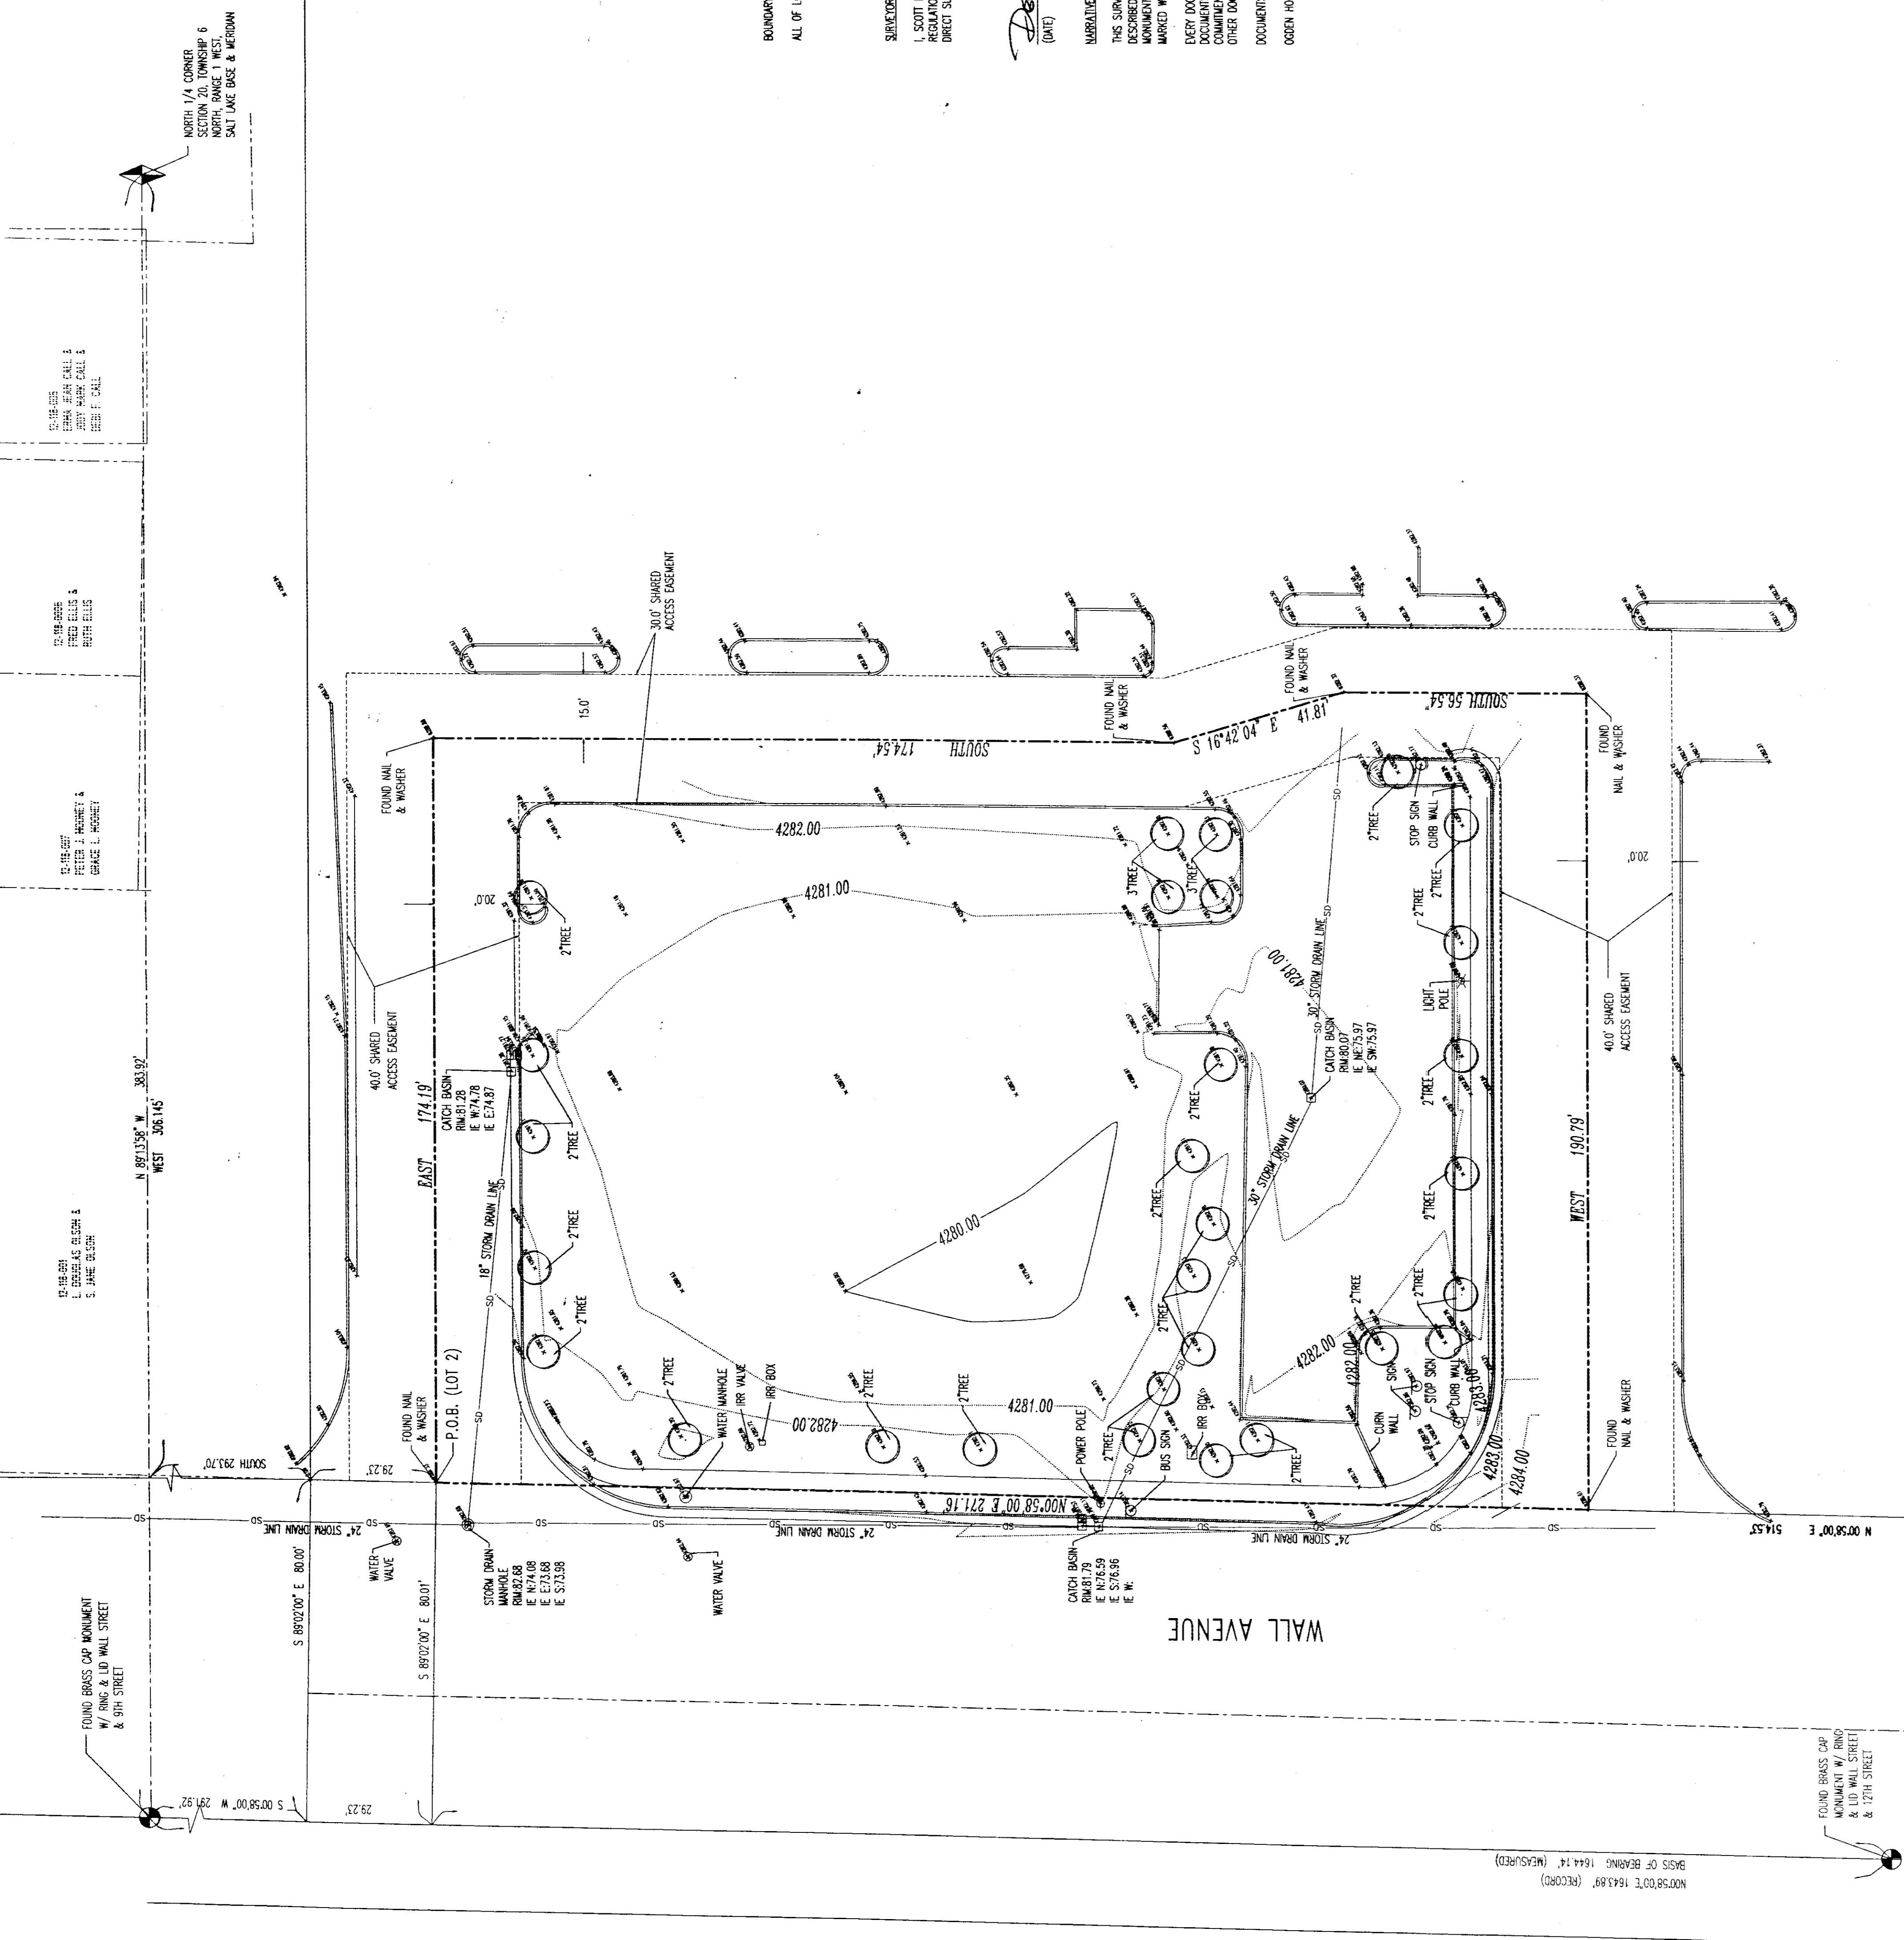

RECEIVED FEB 19 2002 Weber County Surveyor

002826