


**SURVEYOR'S CERTIFICATE**  
 I, LYLE C. REEVE, A LICENSED PROFESSIONAL LAND SURVEYOR, HOLDING UTAH LICENSE NUMBER 37602, THAT A SURVEY OF THE PROPERTY DESCRIBED HEREON WAS ACCURATELY MADE AND THAT THE PLAT ACCURATELY REPRESENTS THE FINDINGS OF THIS SURVEY.

SIGNED THIS 25<sup>TH</sup> DAY OF JULY 2002  
 UTAH LICENSE NUMBER 37602  
 UTAH LICENSE NUMBER

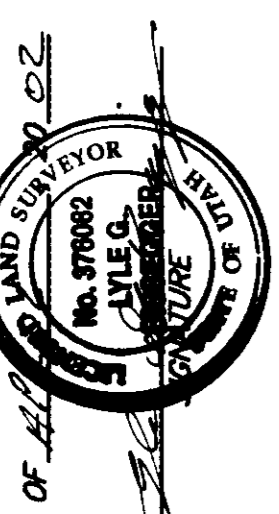

**BASIS OF BEARINGS**

THE BASIS OF BEARINGS FOR THIS PLAT IS THE OGDEN CITY ATLAS PLAT AS DETERMINED LOCALLY BY THE LINE BETWEEN THE TWO FOUND OGDEN CITY STREET MONUMENTS IN THE 30th STREET AND MADISON AVENUE, SHOWN HEREON AS: S00°58'00"W

**NARRATIVE**

THE PURPOSE OF THIS SURVEY IS TO DEFINE THE BOUNDARY OF THE PROPERTY OF ED LUSK. THE LINE WAS FIXED BY DEED WHICH WAS PLACED ON THE GROUND USING THE OGDEN CITY ATLAS AND FOUND OGDEN CITY STREET MONUMENTS.

**SURVEYED DESCRIPTION**

PART OF THE SOUTHWEST QUARTER OF SECTION 33, T.8N. R.11W, S.L.B.M., U.S. SURVEY, DESCRIBED AS FOLLOWS:  
 BEGINNING AT A POINT ON THE SOUTH RIGHT-OF-WAY LINE OF 29th STREET, SAID POINT BEING S00°58'00"W ALONG THE INTERSECTION OF 29th STREET AND MADISON AVENUE, 124.50 FEET FROM THE FOUND OGDEN CITY STREET MONUMENT AT THE INTERSECTION OF 29th STREET AND SAID MADISON AVENUE; THENCE S00°58'00"W 87.50 FEET

RECEIVED  
 APR 29 2002  
 Weber County Surveyors

THESE PLANS AND SPECIFICATIONS ARE THE PROPERTY OF REEVE & ASSOC., INC. 1620 QUINCY AVE. OGDEN, UTAH, 84403 AND SHALL NOT BE COPIED OR REPRODUCED WITHOUT THEIR WRITTEN PERMISSION.

**RECORD OF SURVEY**  
**LUSK PROPERTY**  
 PART OF THE SOUTHWEST QUARTER OF SECTION 33, T.8N. R.11W, S.L.B.M., U.S. SURVEY OGDEN, FEBRUARY, 2002

**REEVE & ASSOCIATES, INC.**  
 Civil Engineering, Structural Engineering, Surveying, and Construction Management  
 EXECUTIVE BLDG. 4155 S. MADISON BLVD., #110  
 OGDEN, UTAH 84403  
 (801) 621-2100 FAX (801) 621-2666

PROJECT NO.: 4802-01 SURVEYOR: A. LUSK  
 DATE: 2-21-02 DRAWN: A. LUSK  
 SCALE: 1"=50' CHECKED:

REVISIONS  
 1. \_\_\_\_\_  
 2. \_\_\_\_\_  
 3. \_\_\_\_\_  
 4. \_\_\_\_\_  
 5. \_\_\_\_\_  
 6. \_\_\_\_\_

