


SURVEYOR'S CERTIFICATE
 I, LYLE G. BESSERER, DEPOSE AND SAY THAT I AM A LICENSED PROFESSIONAL LAND SURVEYOR, HOLDING UTAH LICENSE NUMBER 178982. THAT I AM THE SURVEYOR OF THE PROPERTY DESCRIBED HEREON AND THAT THIS SURVEY AND THE PLAT THEREON WERE MADE AND THIS PLAT CORRECTLY DEPICTS THE FINDINGS OF THAT SURVEY.

SIGNED THIS 15TH DAY OF JULY, 2002.
 LYLE G. BESSERER
 UTAH LICENSE NUMBER 178982

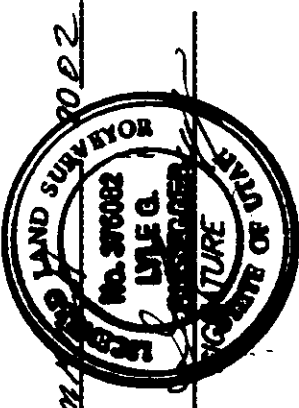

BASIS OF BEARINGS
 THE BASIS OF BEARINGS FOR THIS PLAT IS THE OGDEN CITY ATLAS PLAT AS DETERMINED LOCALLY BY THE LINE BETWEEN THE INTERSECTIONS OF 29th STREET AND MADISON AVENUE AND 30th STREET AND MADISON AVENUE, SHOWN HEREON AS: S00°58'00"W

NARRATIVE
 THE PURPOSE OF THIS SURVEY IS TO DEFINE THE BOUNDARY LINE BETWEEN THE LUSK PROPERTY AND THE LONG PROPERTY FOR ED LUSK. THE LINE WAS FIRED BY BEED WHICH WAS FOUND TO BE THE CORNER OF THE OGDEN CITY ATLAS AND FOUND OGDEN CITY STREET MONUMENTS.

SURVEYED DESCRIPTION
 PART OF THE SOUTHWEST CORNER OF SECTION 33, T.6N. R.1W, S.18.6M, U.S. SURVEY, DESCRIBED AS FOLLOWS:
 BEGINNING AT A POINT ON THE SOUTH RIGHT-OF-WAY LINE OF 30th STREET, BEARING S00°58'00"W 87.50 FEET TO THE CENTERLINE OF MADISON AVENUE 40.00 FEET AND N87°02'00"W 124.50 FEET FROM THE FOUND OGDEN CITY STREET MONUMENT AT THE INTERSECTION OF 29th STREET AND SAID MADISON AVENUE, THENCE S00°58'00"W 87.50 FEET

RECEIVED
 APR 29 2002
 Weber County Surveyor

THESE PLANS AND SPECIFICATIONS ARE THE PROPERTY OF REEVE & ASSOC., INC., 3870 QUINCY AVE., OGDEN, UTAH, 84403 AND SHALL NOT BE COPIED OR REDUCED OR REPRODUCED WITHOUT THEIR WRITTEN PERMISSION.

LUSK PROPERTY
 PART OF THE SOUTHWEST CORNER OF SECTION 33, T.6N. R.1W, S.18.6M, U.S. SURVEY OGDEN CITY, WEBER COUNTY, UTAH, FEBRUARY, 2002

RECORD OF SURVEY

REEVE & ASSOCIATES, INC.
 Surveying & Land Planning • Landscape Architecture
 EXECUTIVE BLDG., #100 S. HARRISON BLVD., #210
 OGDEN, UTAH 84403
 (801) 467-3399 FAX (801) 467-2866

PROJECT NO.: 446-01 SURVEYOR: J. BESSERER
 DATE: 7-21-02 DRAWN: H. GARD
 SCALE: 1"=50' CHECKED:

REVISIONS
 1. _____
 2. _____
 3. _____
 4. _____
 5. _____
 6. _____

