


SURVEYOR'S CERTIFICATE
I, RANDALL J. WILFORD, DEPOSE AND SAY THAT I AM A LICENSED PROFESSIONAL LAND SURVEYOR...

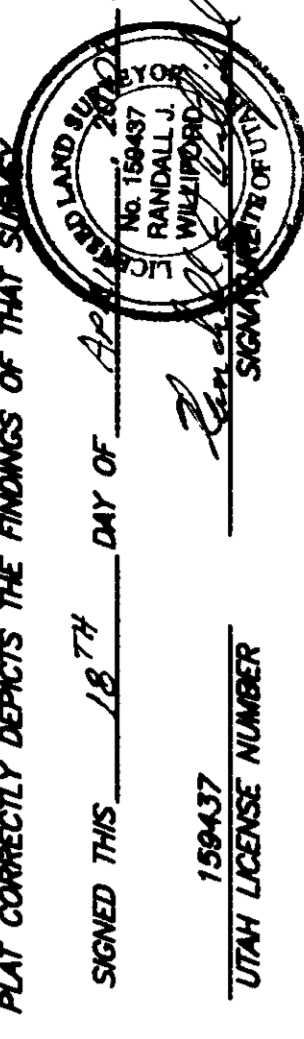


SURVEYED DESCRIPTION PARCEL 'A'

PART OF THE SOUTHWEST QUARTER OF SECTION 15, T.3N., R.1W., S.L.B.8M., U.S. SURVEY, DESCRIBED AS FOLLOWS: BEGINNING AT THE NORTHWEST CORNER OF LOT 1, BURCH HOLLOW SUBDIVISION NO. 1...

SURVEYED DESCRIPTION PARCEL 'B'

PART OF THE SOUTHWEST QUARTER OF SECTION 15, T.3N., R.1W., S.L.B.8M., U.S. SURVEY, DESCRIBED AS FOLLOWS: BEGINNING AT A POINT ON THE WESTERLY LINE OF LOT 4, BURCH HOLLOW SUBDIVISION...

LEGEND

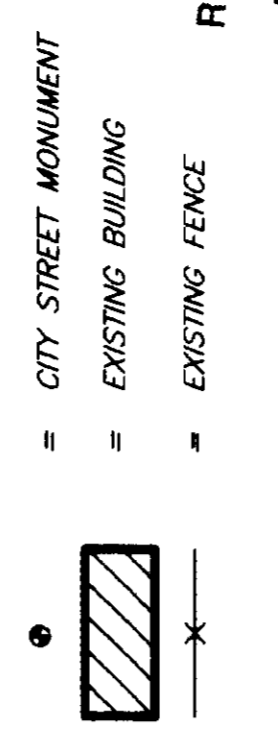

RECEIVED APR 29 02 Weber County Surveyor


RICHARDS PROPERTY PART OF THE SOUTHWEST QUARTER OF SECTION 15, T.3N., R.1W., S.L.B.8M., U.S. SURVEY

RECORD OF SURVEY

REEVE & ASSOCIATES, INC. Civil Engineers, Structural Engineers, Surveying & Land Planning & Landscape Architecture



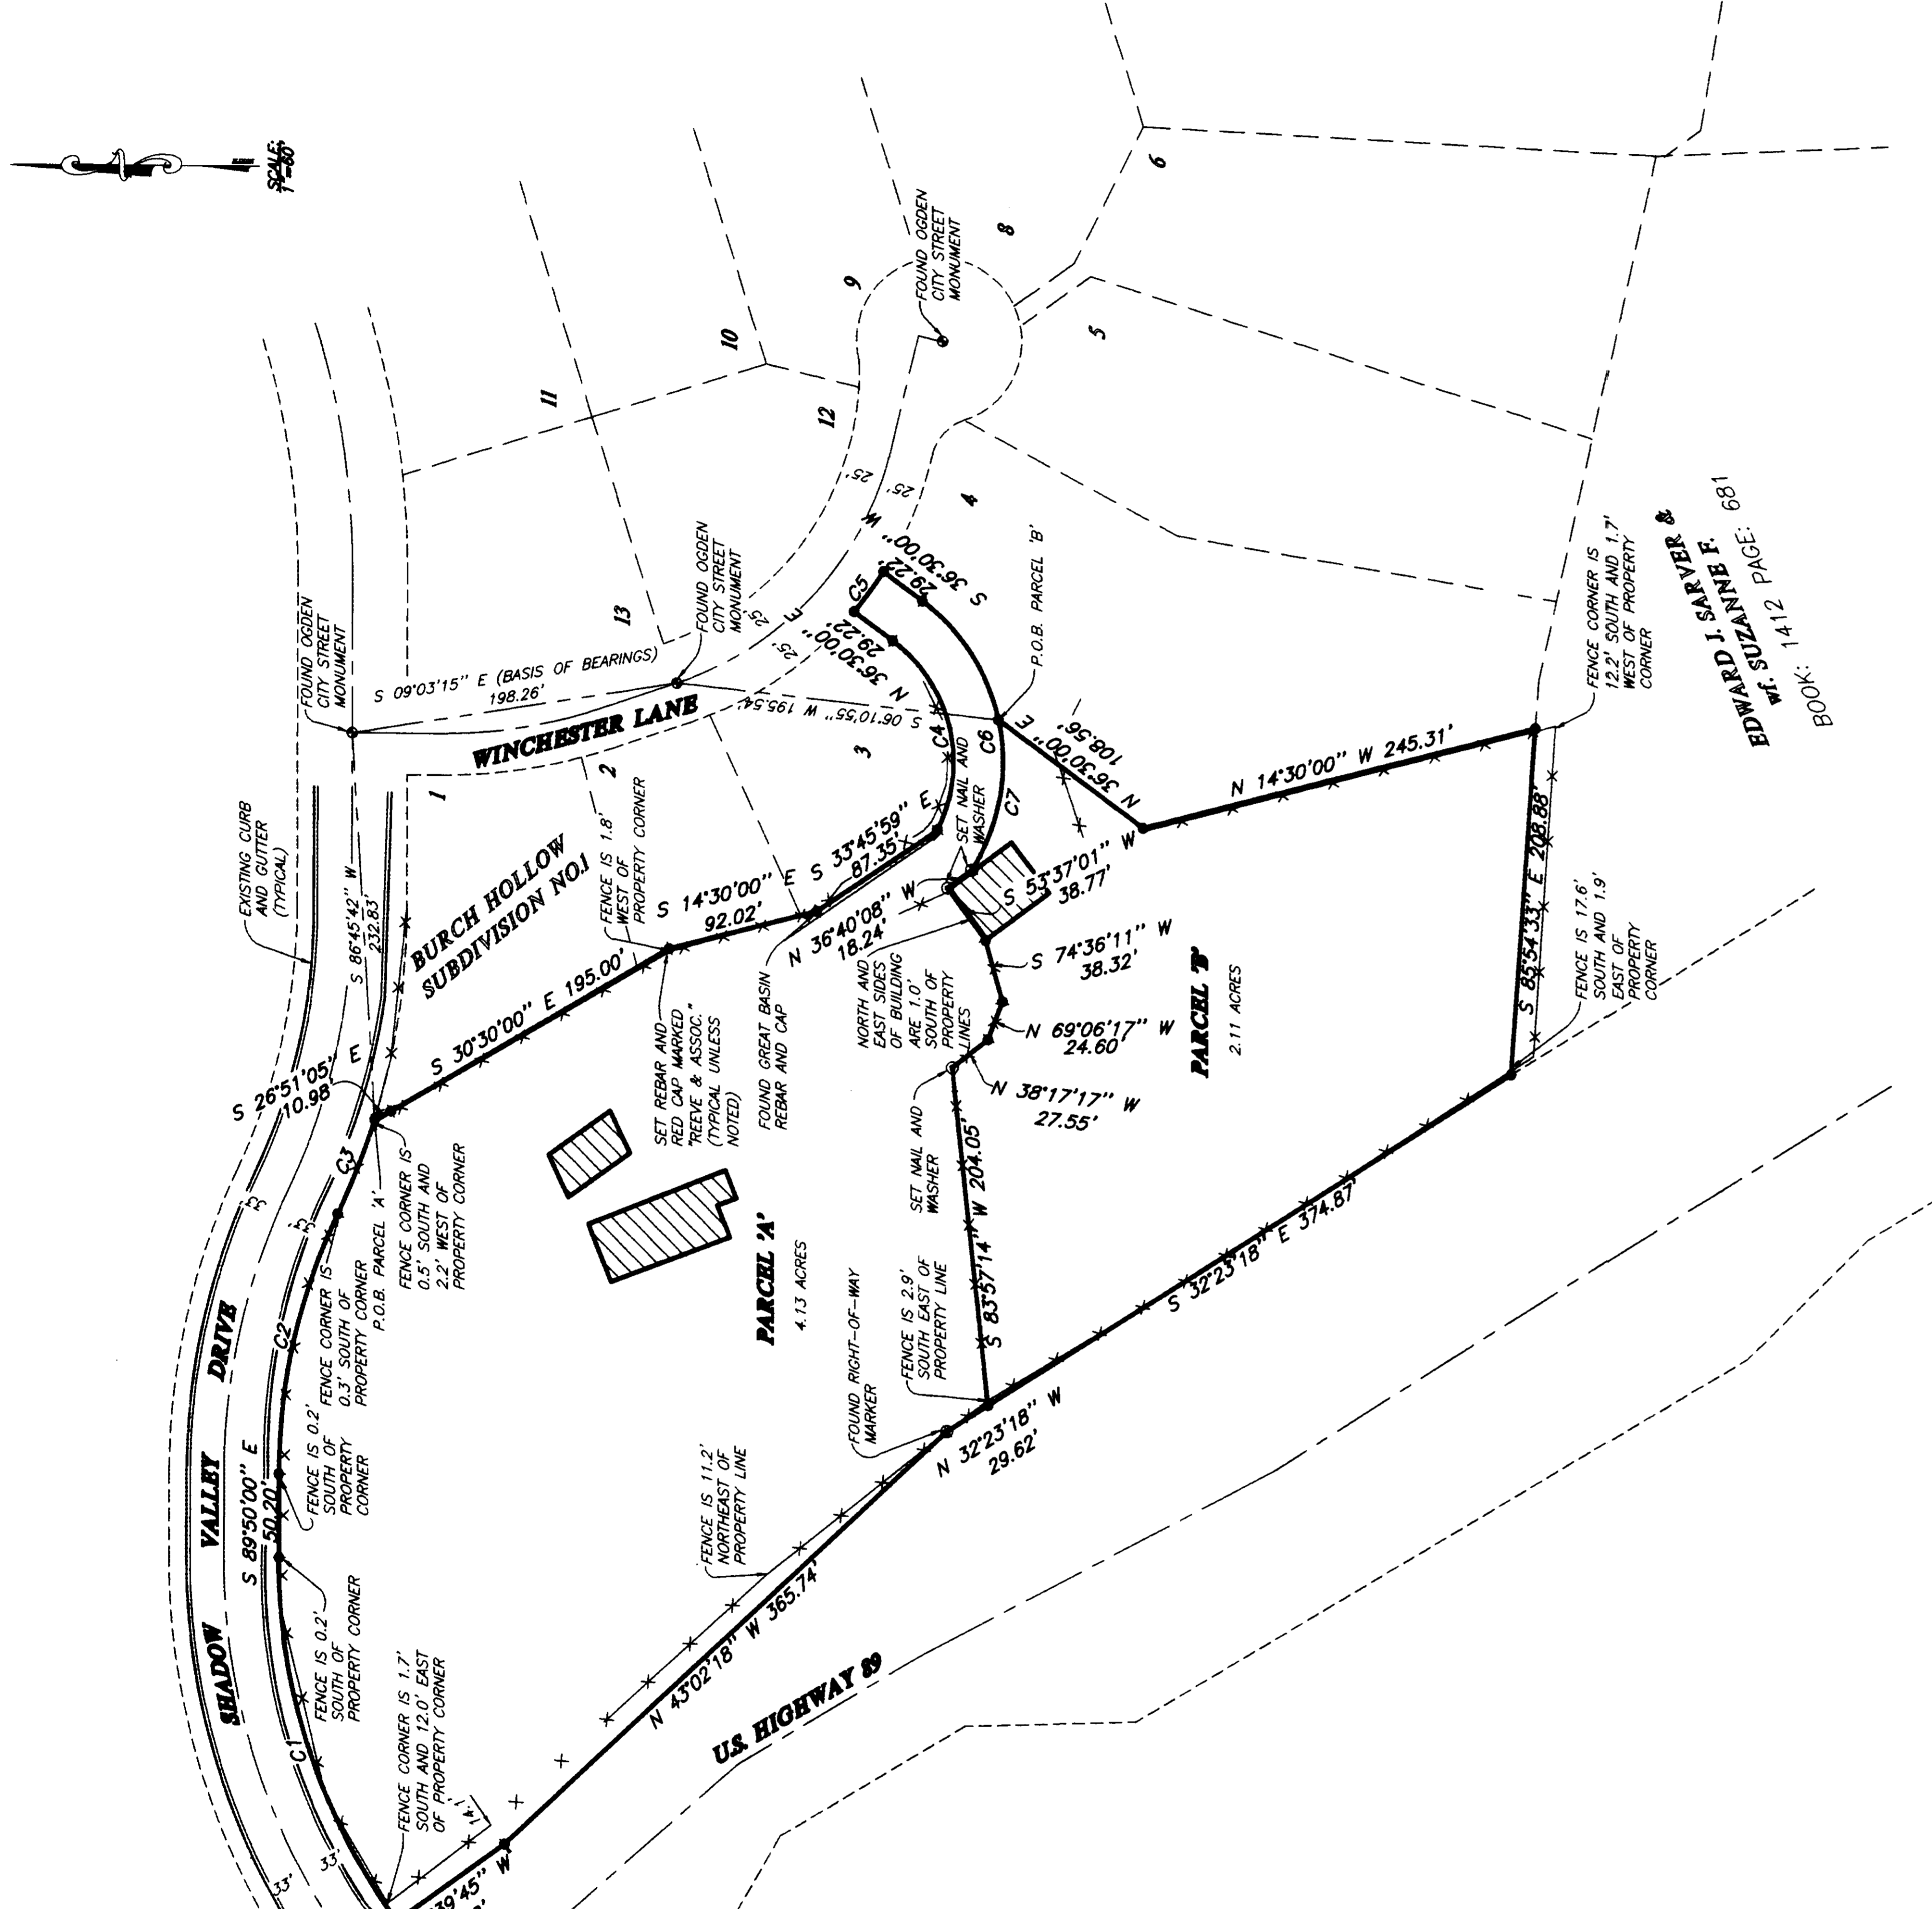


BASES OF BEARINGS THE BASIS OF BEARINGS FOR THIS PLAT IS THE LINE BETWEEN THE FOUND OGDEN CITY STREET MONUMENTS ALONG THE CENTERLINE OF WINCHESTER LANE, SHOWN HEREOF AS: S09°03'15\"/>

DEED DESCRIPTION PARCEL 'A' BEGINNING AT A POINT WHICH IS SOUTH 89°49'34\"/>

DEED DESCRIPTION PARCEL 'B' BEGINNING AT A POINT WHICH IS SOUTH 89°49'34\"/>

CURVE TABLE

Table with columns: NUMBER, DELTA, CHORD, TANGENT, RADIUS, LENGTH, CHORD. Rows C1 through C7.

