


002866

SURVEYOR'S CERTIFICATE




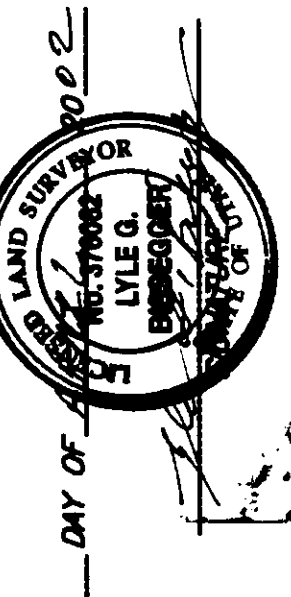

BASE OF BEARINGS




SURVEYED DESCRIPTION




RECEIVED
APR 29 2005

Welder County Surveyor



SHEET 1 OF 1 SHEETS

SOUTH LINE OF FOWERS PROPERTY
PART OF THE SOUTHWEST QUARTER OF SECTION 11, T.5N., R.2W., S.18R.M., U.S. SURVEY
RECORDED JULY 2001

RECORD OF SURVEY


REEVE & ASSOCIATES, INC.
Civil Engineering • Structural Engineering
Surveying • Land Planning • Landscape Architecture


REVISIONS

1.	
4.	
5.	
6.	

002866

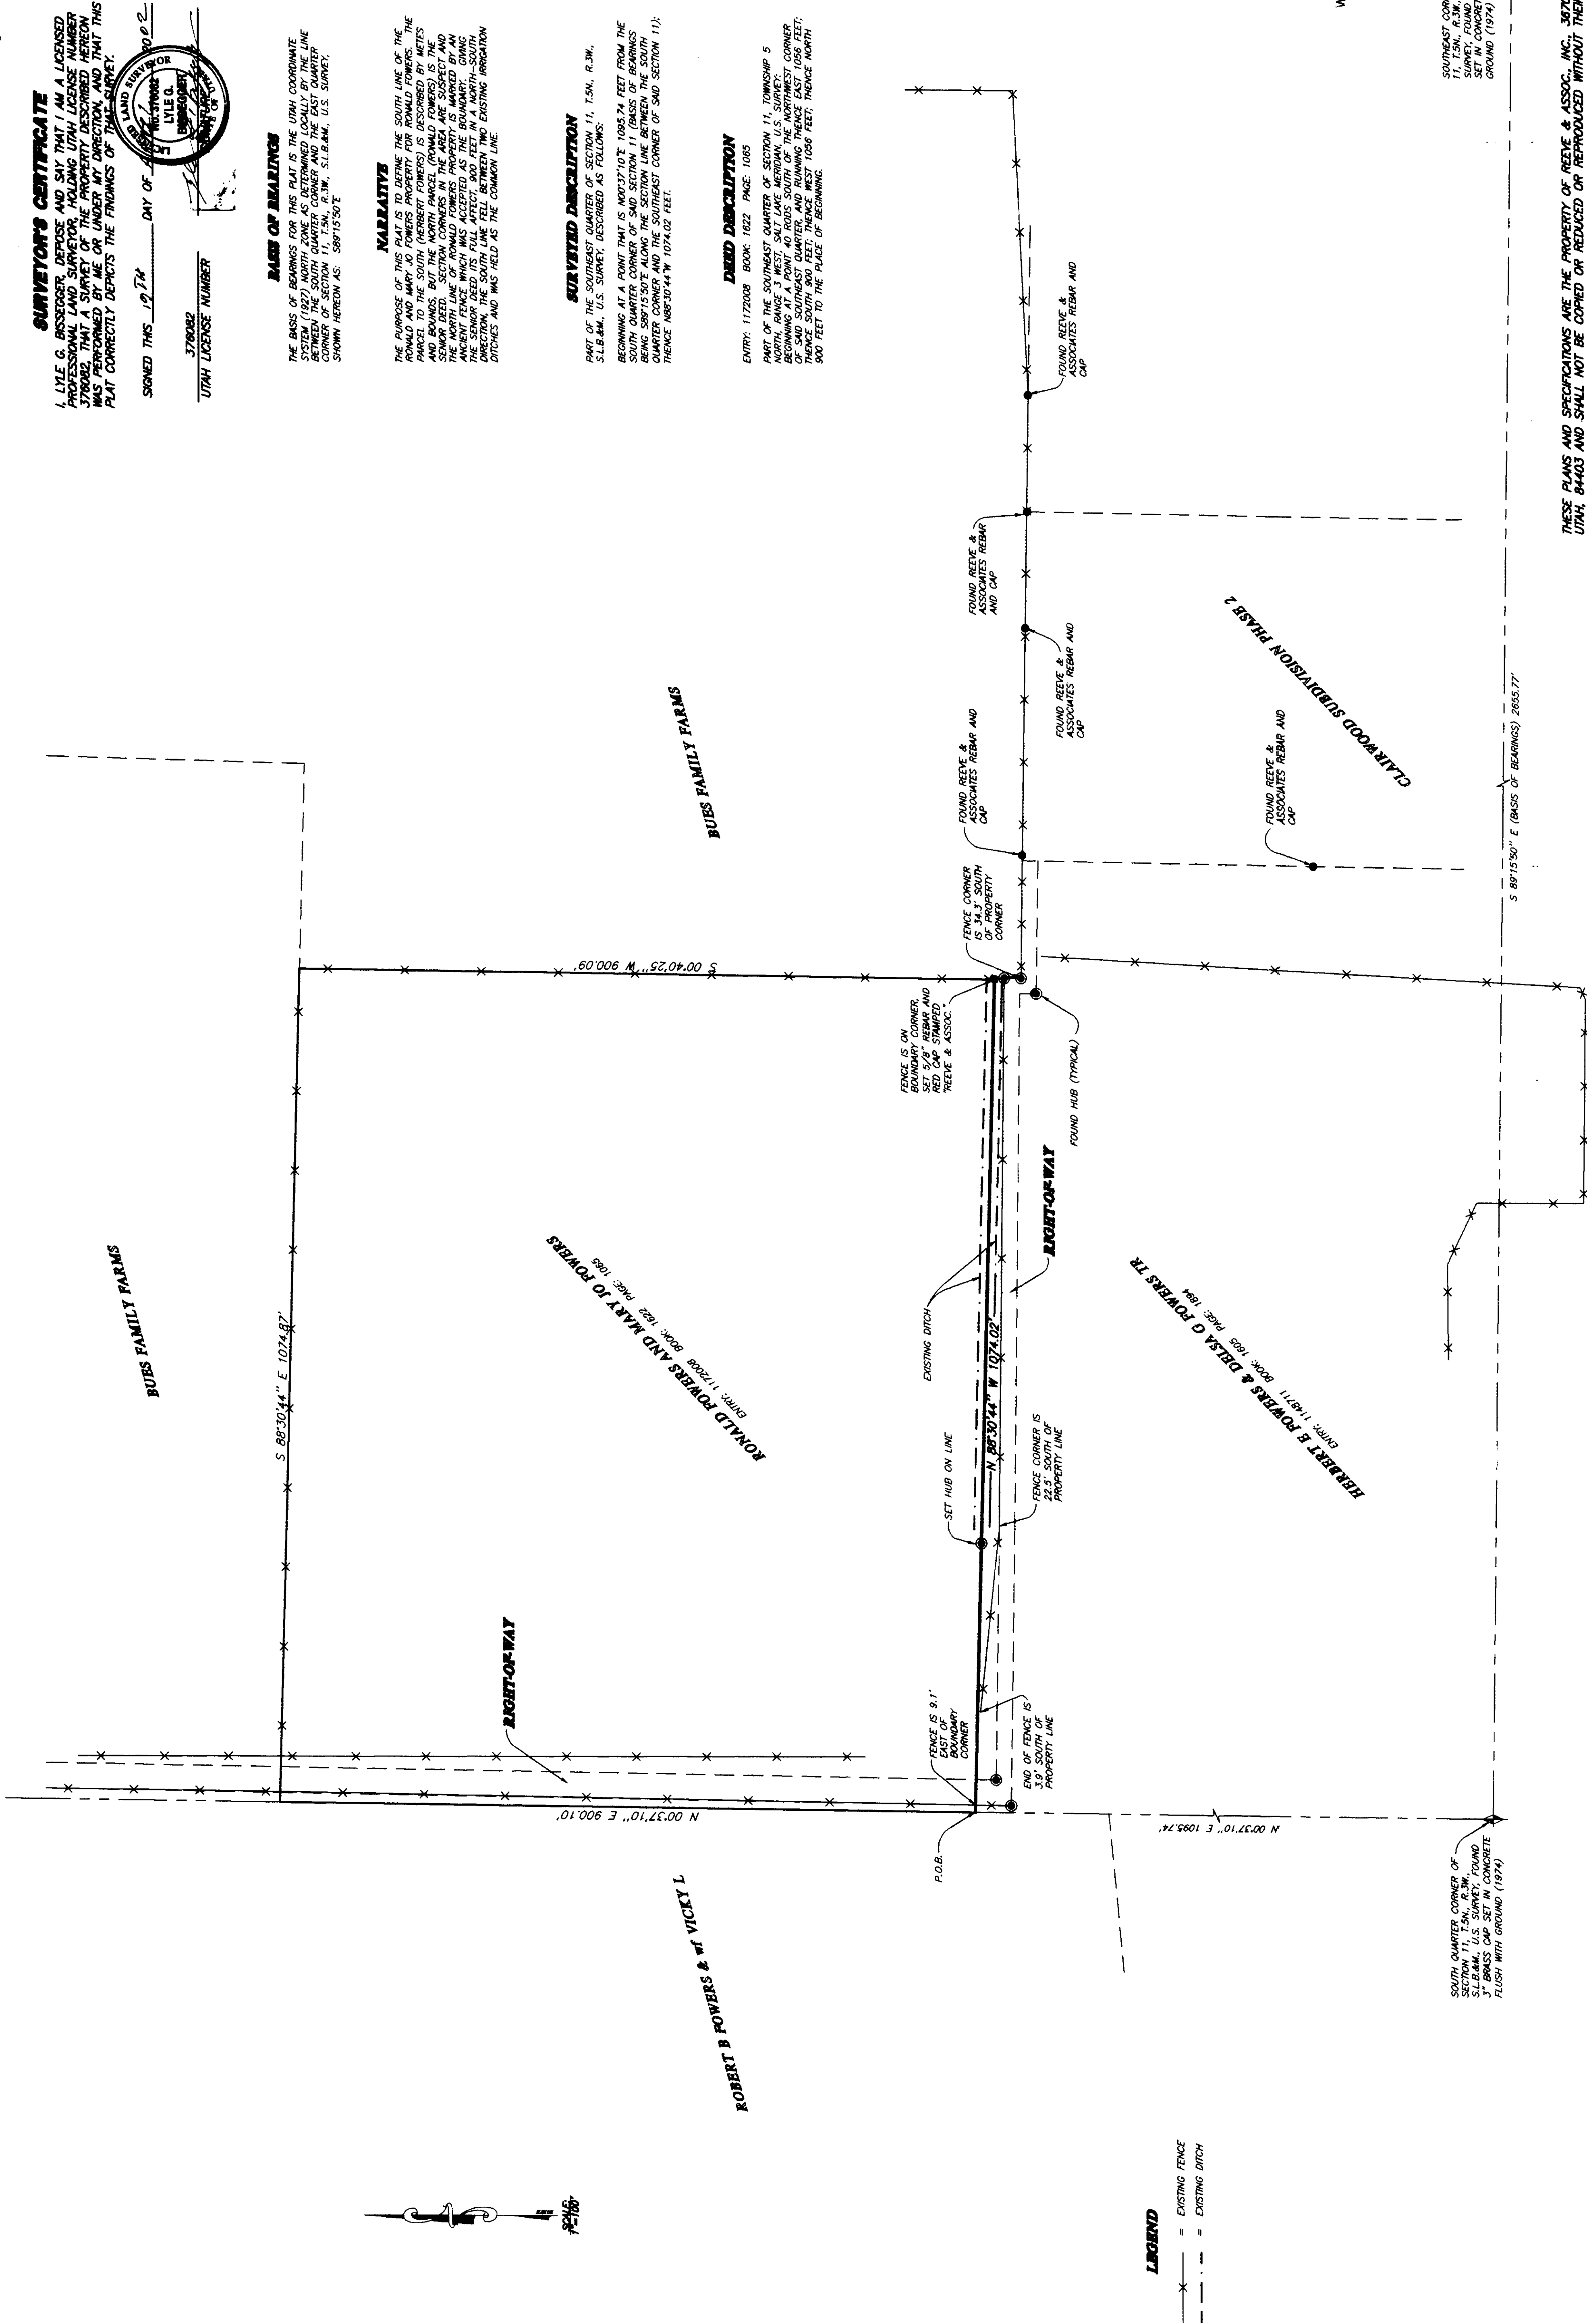

LEGEND
- - - EXISTING FENCE
- - - EXISTING DITCH

002866



