


Revision		HANSEN & ASSOCIATES, INC. Consulting Engineers and Land Surveyors 538 North Main Brigham City, Utah 84302 Ogden 399-4905 Logan 752-8272	JOB NUMBER: 02-3-5 Drawing File: 02-3-5.DWG Scale: 1"=60' Checked By: [Signature] Designed By: [Signature]	Drawn By: JH Date: 1/28/02	A PART OF BLOCK 1 AND 2 PLAT A, OGDEN CITY SURVEY <b>OGDEN UNION RAILWAY</b> PROPERTY SURVEY FOR OGDEN UTAH	SHEET <b>1</b> OF <b>1</b>
No.	Date					

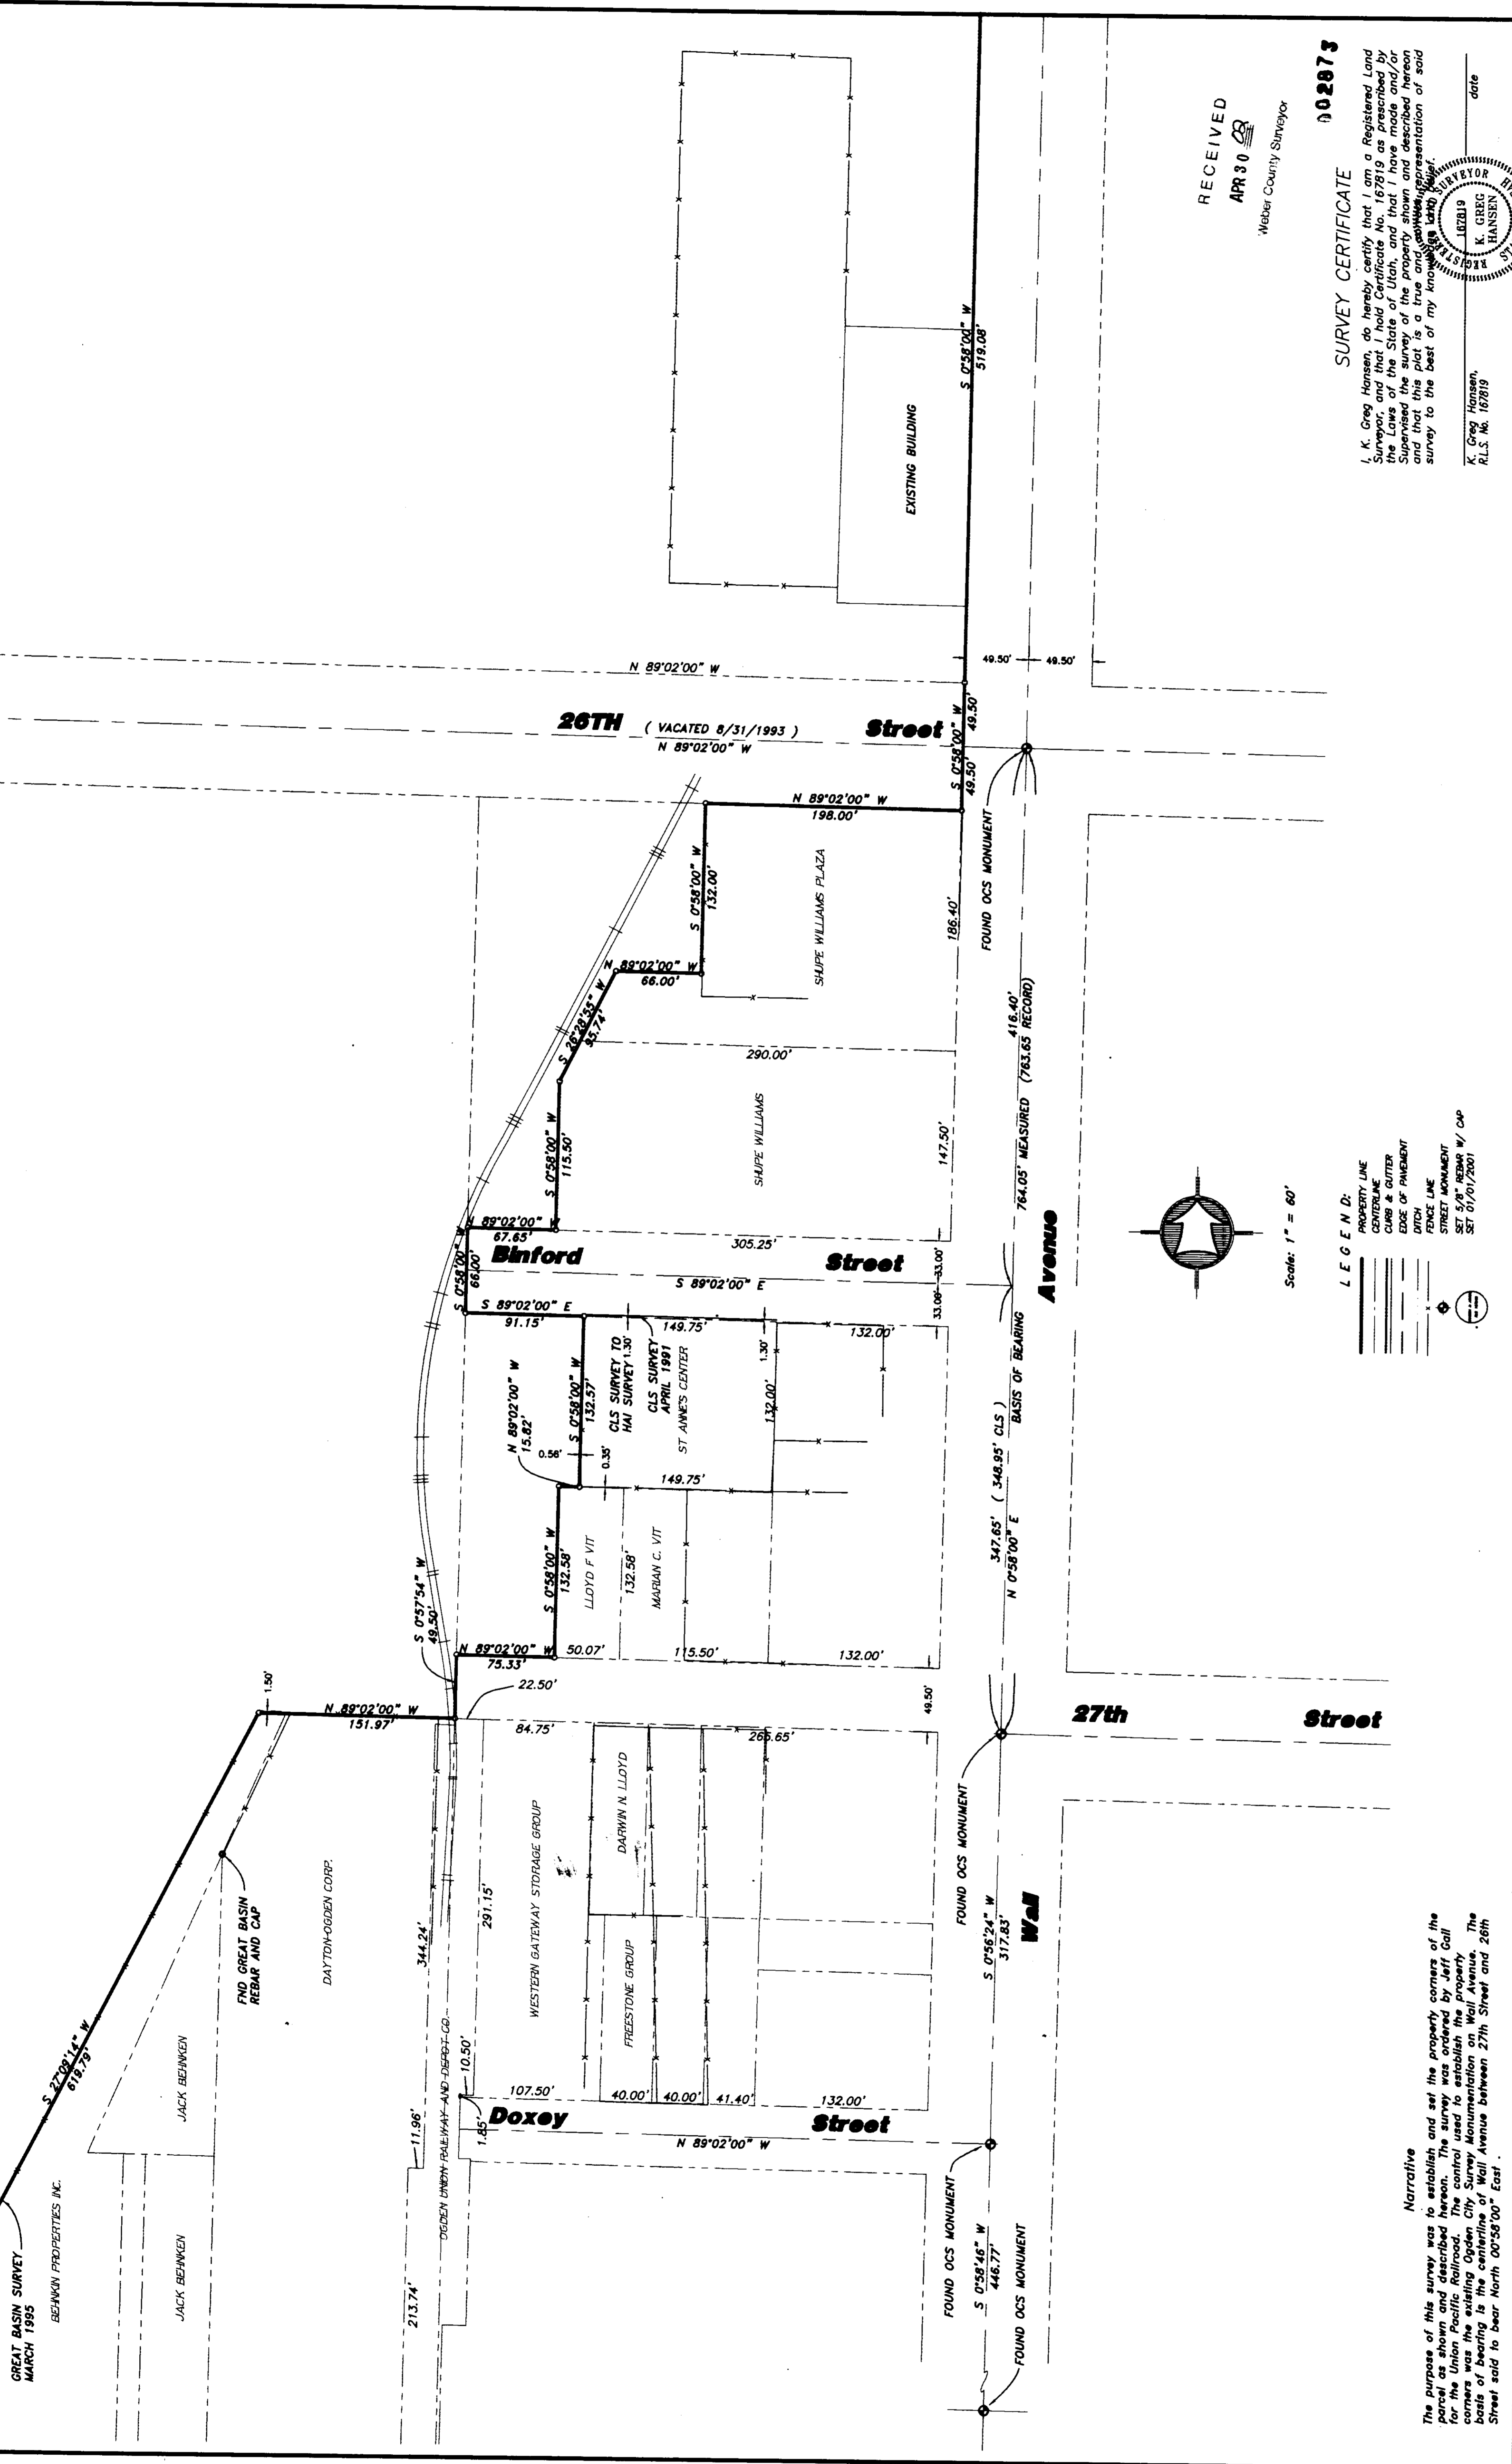

RECEIVED  
 APR 30  
 Weber County Surveyor

**002873**

**SURVEY CERTIFICATE**

I, K. Greg Hansen, do hereby certify that I am a Registered Land Surveyor, and that I hold Certificate No. 16719 as prescribed by the Laws of the State of Utah, and that I have made and/or supervised the making of the property shown and described herein and that the plat is a true and correct representation of said survey to the best of my knowledge and belief.

K. Greg Hansen,  
 R.L.S. No. 16719

date

**LEGEND:**

- PROPERTY LINE
- CENTERLINE
- CURB & GUTTER
- EDGE OF PAVEMENT
- DITCH
- FENCE LINE
- STREET MONUMENT

**Narrative**

