



RECORD OF SURVEY
AMENDED LOT 16, WEST HAVEN INDUSTRIAL PARK
 A PART OF THE S.E. 1/4 OF SECTION 35, T.6N., R.2W., S.L.B.&M.
 WEST HAVEN CITY, WEBER COUNTY, UTAH
 DECEMBER 2001

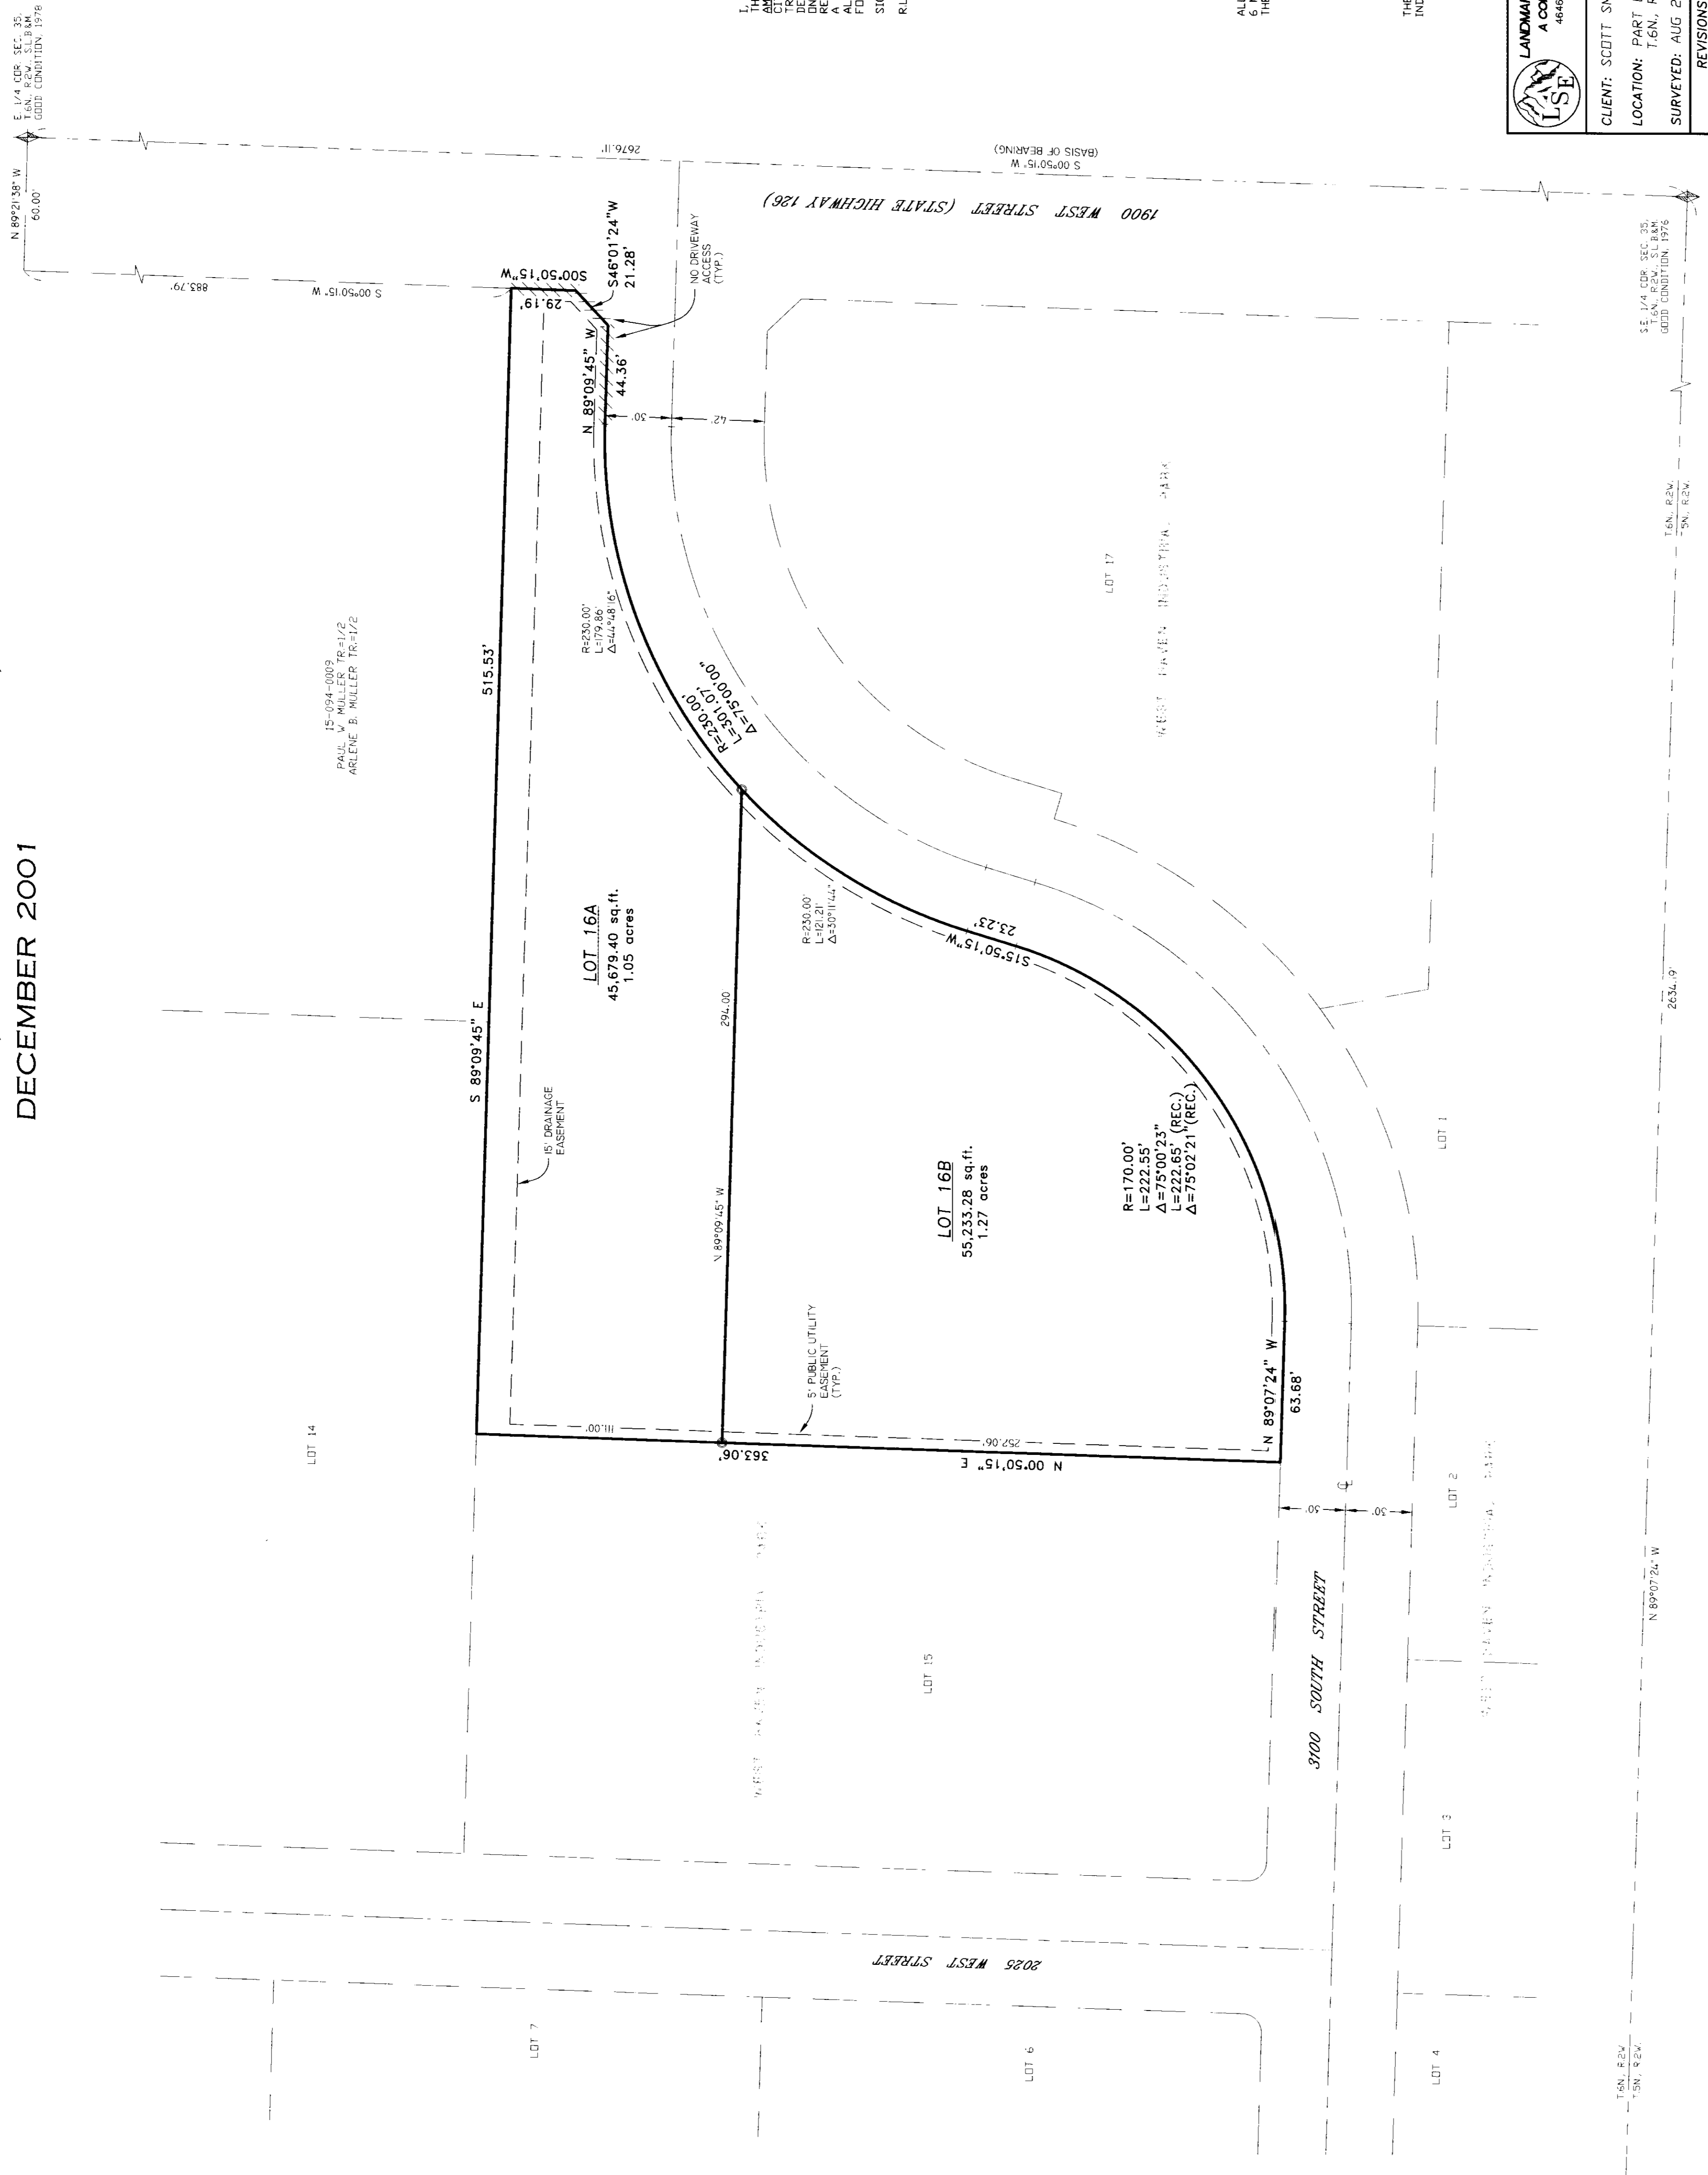


RECEIVED
 MAY 02 2002
 Weber County Surveyor

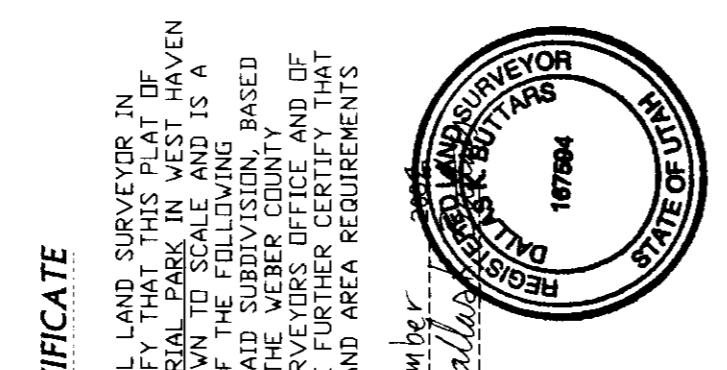

SURVEYOR'S CERTIFICATE
AND I FURTHER CERTIFY THAT THIS SURVEY WAS MADE IN ACCORDANCE WITH THE REQUIREMENTS FOR WEST HAVEN CITY ZONING.
 SIGNED THIS 10th DAY OF DECEMBER 2001.
 R.L.S. # 167394
 SIGNATURE

BOUNDARY DESCRIPTION
 ALL OF LOT 16 OF WEST HAVEN INDUSTRIAL PARK, SECTION 35, TOWNSHIP 6 NORTH, RANGE 2 WEST, SALT LAKE BASE AND MERIDIAN, ACCORDING TO THE OFFICIAL PLAN THEREOF.

NARRATIVE
 THE PURPOSE OF THIS SURVEY WAS TO AMEND LOT 16 OF WEST HAVEN INDUSTRIAL PARK.

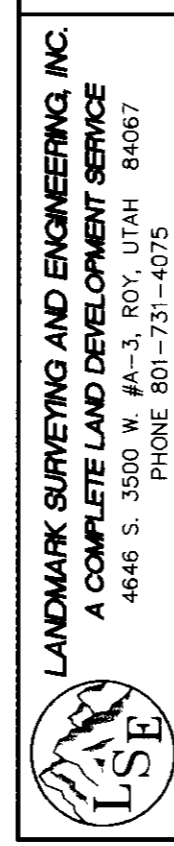

LANDMARK SURVEYING AND ENGINEERING, INC.
 A COMPLETE LAND DEVELOPMENT SERVICE
 CLIENT: SCOTT SMIDT
 LOCATION: PART OF THE S.E. 1/4 OF SEC. 35, T.6N., R.2W., S.L.B.&M.
 SURVEYED: AUG 2001
 DRAWN BY: L.A.
 CHECKED BY: J.B.
 DATE: 08-18-01
 FILE: 2306AKNDG

WEBER COUNTY RECORDER
 ENTRY # _____ FEE _____
 FILED FOR RECORD & RECORDED
 THIS _____ DAY OF _____ 20____
 AT _____ IN BOOK _____ OF _____
 PAGE _____
 BY _____
 WEBER COUNTY RECORDER
 DEPUTY

SCALE: 1" = 40'

0 = 3/8" x 24" LENGTH REBAR WITH CAP STAMPED 107394