


LEGEND:

- DENOTES A SET #5 CAPPED REBAR, 24" LONG
- DENOTES A FOUND CAPPED REBAR
- EXISTING FENCE
- - - DEED LINES

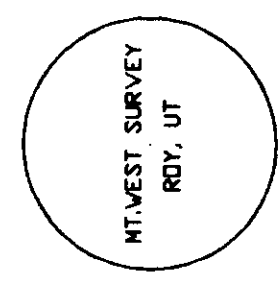

**RECORD OF SURVEY**

for  
**SOUTH OGDEN CITY CORP.**  
 Located in The Northwest One-Quarter of Section 10,  
 Township 5 North, Range 1 West, S.1.B.M.

DATE: June, 2008 BY: J.M. JRM / J.M. JRM / J.M. JRM  
 PROJECT: 002898

**PROPERTY DESCRIPTION**


BEING A PART OF THE NORTHWEST QUARTER OF SECTION 10, TOWNSHIP 5 NORTH, RANGE 1 WEST, SALT LAKE BASE AND MERIDIAN, BEGINNING AT A POINT 252.77 FEET SOUTH AND 685.04 FEET EAST FROM THE NORTHWEST CORNER OF QUARTER SECTION 10, AND RUNNING: 1. S.23°42'08" W., 101.70 FEET TO THE NORTHWEST CORNER OF THE OGDEN CITY RIGHT OF WAY, SAID NORTHWEST CORNER BEING S.86°17'52" E., 100.00 FEET, THENCE, N.89°57'35" E., ALONG SAID SOUTH LINE, 460.64 FEET TO THE NORTHWEST CORNER OF THE OGDEN CITY RIGHT OF WAY, SAID NORTHWEST CORNER BEING S.86°17'52" E., 100.00 FEET, THENCE, S.23°42'08" W., 101.70 FEET AND S.89°57'35" W., 32.77 FEET FROM THE OGDEN CITY SURVEY ALONG SAID RIGHT OF WAY THE FOLLOWING TWO COURSES: 1) S.23°42'08" W., 30.45 FEET 2) S.03°32'00" W., 138.48 FEET, THENCE, S.89°57'35" W., 447.19 FEET, THENCE, N.00°22'25" E., 50.00 FEET TO THE POINT OF BEGINNING, CONTAINING, 1.71 ACRES, MORE OR LESS.

**NARRATIVE AND STATEMENT OF PURPOSE**

THIS SURVEY WAS PERFORMED AT THE REQUEST OF SOUTH OGDEN CITY TO DETERMINE THE FOUNDATION OF THE HEREIN DESCRIBED PROPERTY MONUMENTS ALONG THE HILLS DRIVE PROPERTY AND TO RECONSTRUCT THE MONUMENTS TO THE PROPERTY CALLS FOR HALVERSON SUBDIVISION, A SECONDARY TIE TO THE MONUMENT IN THE INTERSECTION OF COUNTRY HILLS DRIVE AND 1350 EAST STREET WAS ADDED TO IT. THIS WILL ALSO FACILITATE RECONSTRUCTION OF THE SURVEY.

**SURVEYOR'S CERTIFICATE**

I HAVE PERSONALLY CONDUCTED THE SURVEY AND I HAVE PERSONALLY RE-TRACED AND OCCUPY THE POSITIONS INDICATED, AND AM SUFFICIENT TO ENABLE THE SURVEY TO BE RE-TRACED.

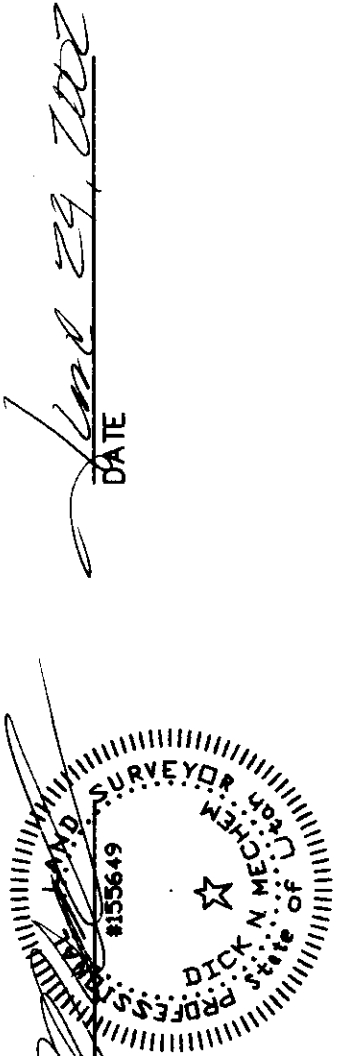

RECEIVED  
 JUN 23 2008  
 Weber County Surveyor

002898