

BASIS OF BEARINGS


NARRATIVE





SURVEYED DESCRIPTION

 BEGINNINGS AT THE INTERSECTION OF A FENCE AND THE EAST RIGHT-OF-WAY LINE OF 5500 WEST STREET, SAID INTERSECTION BEING S89°30'11"E ALONG THE EXTENSION OF THE SECTION LINE BETWEEN THE NORTHWEST AND THE NORTH QUARTER CORNER OF SECTION 7, T.5N, R.2W, S.L.B.&M., U.S. SURVEY, TO THE NORTH QUARTER CORNER OF SAID SECTION 7, THENCE N89°30'31"E ALONG SAID FENCE 519.81 FEET; THENCE S00°44'11"W 223.63 FEET; THENCE N89°15'49"W 519.75 FEET TO A POINT ON SAID FENCE; THENCE S00°44'11"E ALONG SAID FENCE 215.52 FEET TO THE POINT OF BEGINNING.

DEED DESCRIPTIONS

ENTRY: 1227175 BOOK: 1664 PAGE: 1574

CONTAINS: 2.62 ACRES

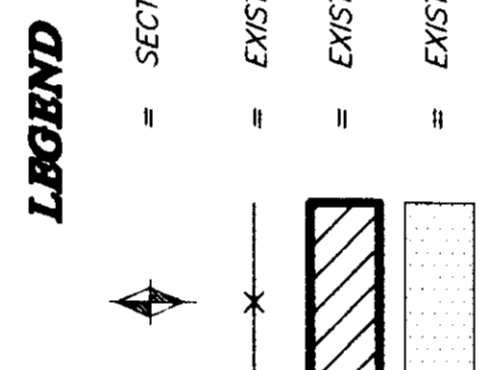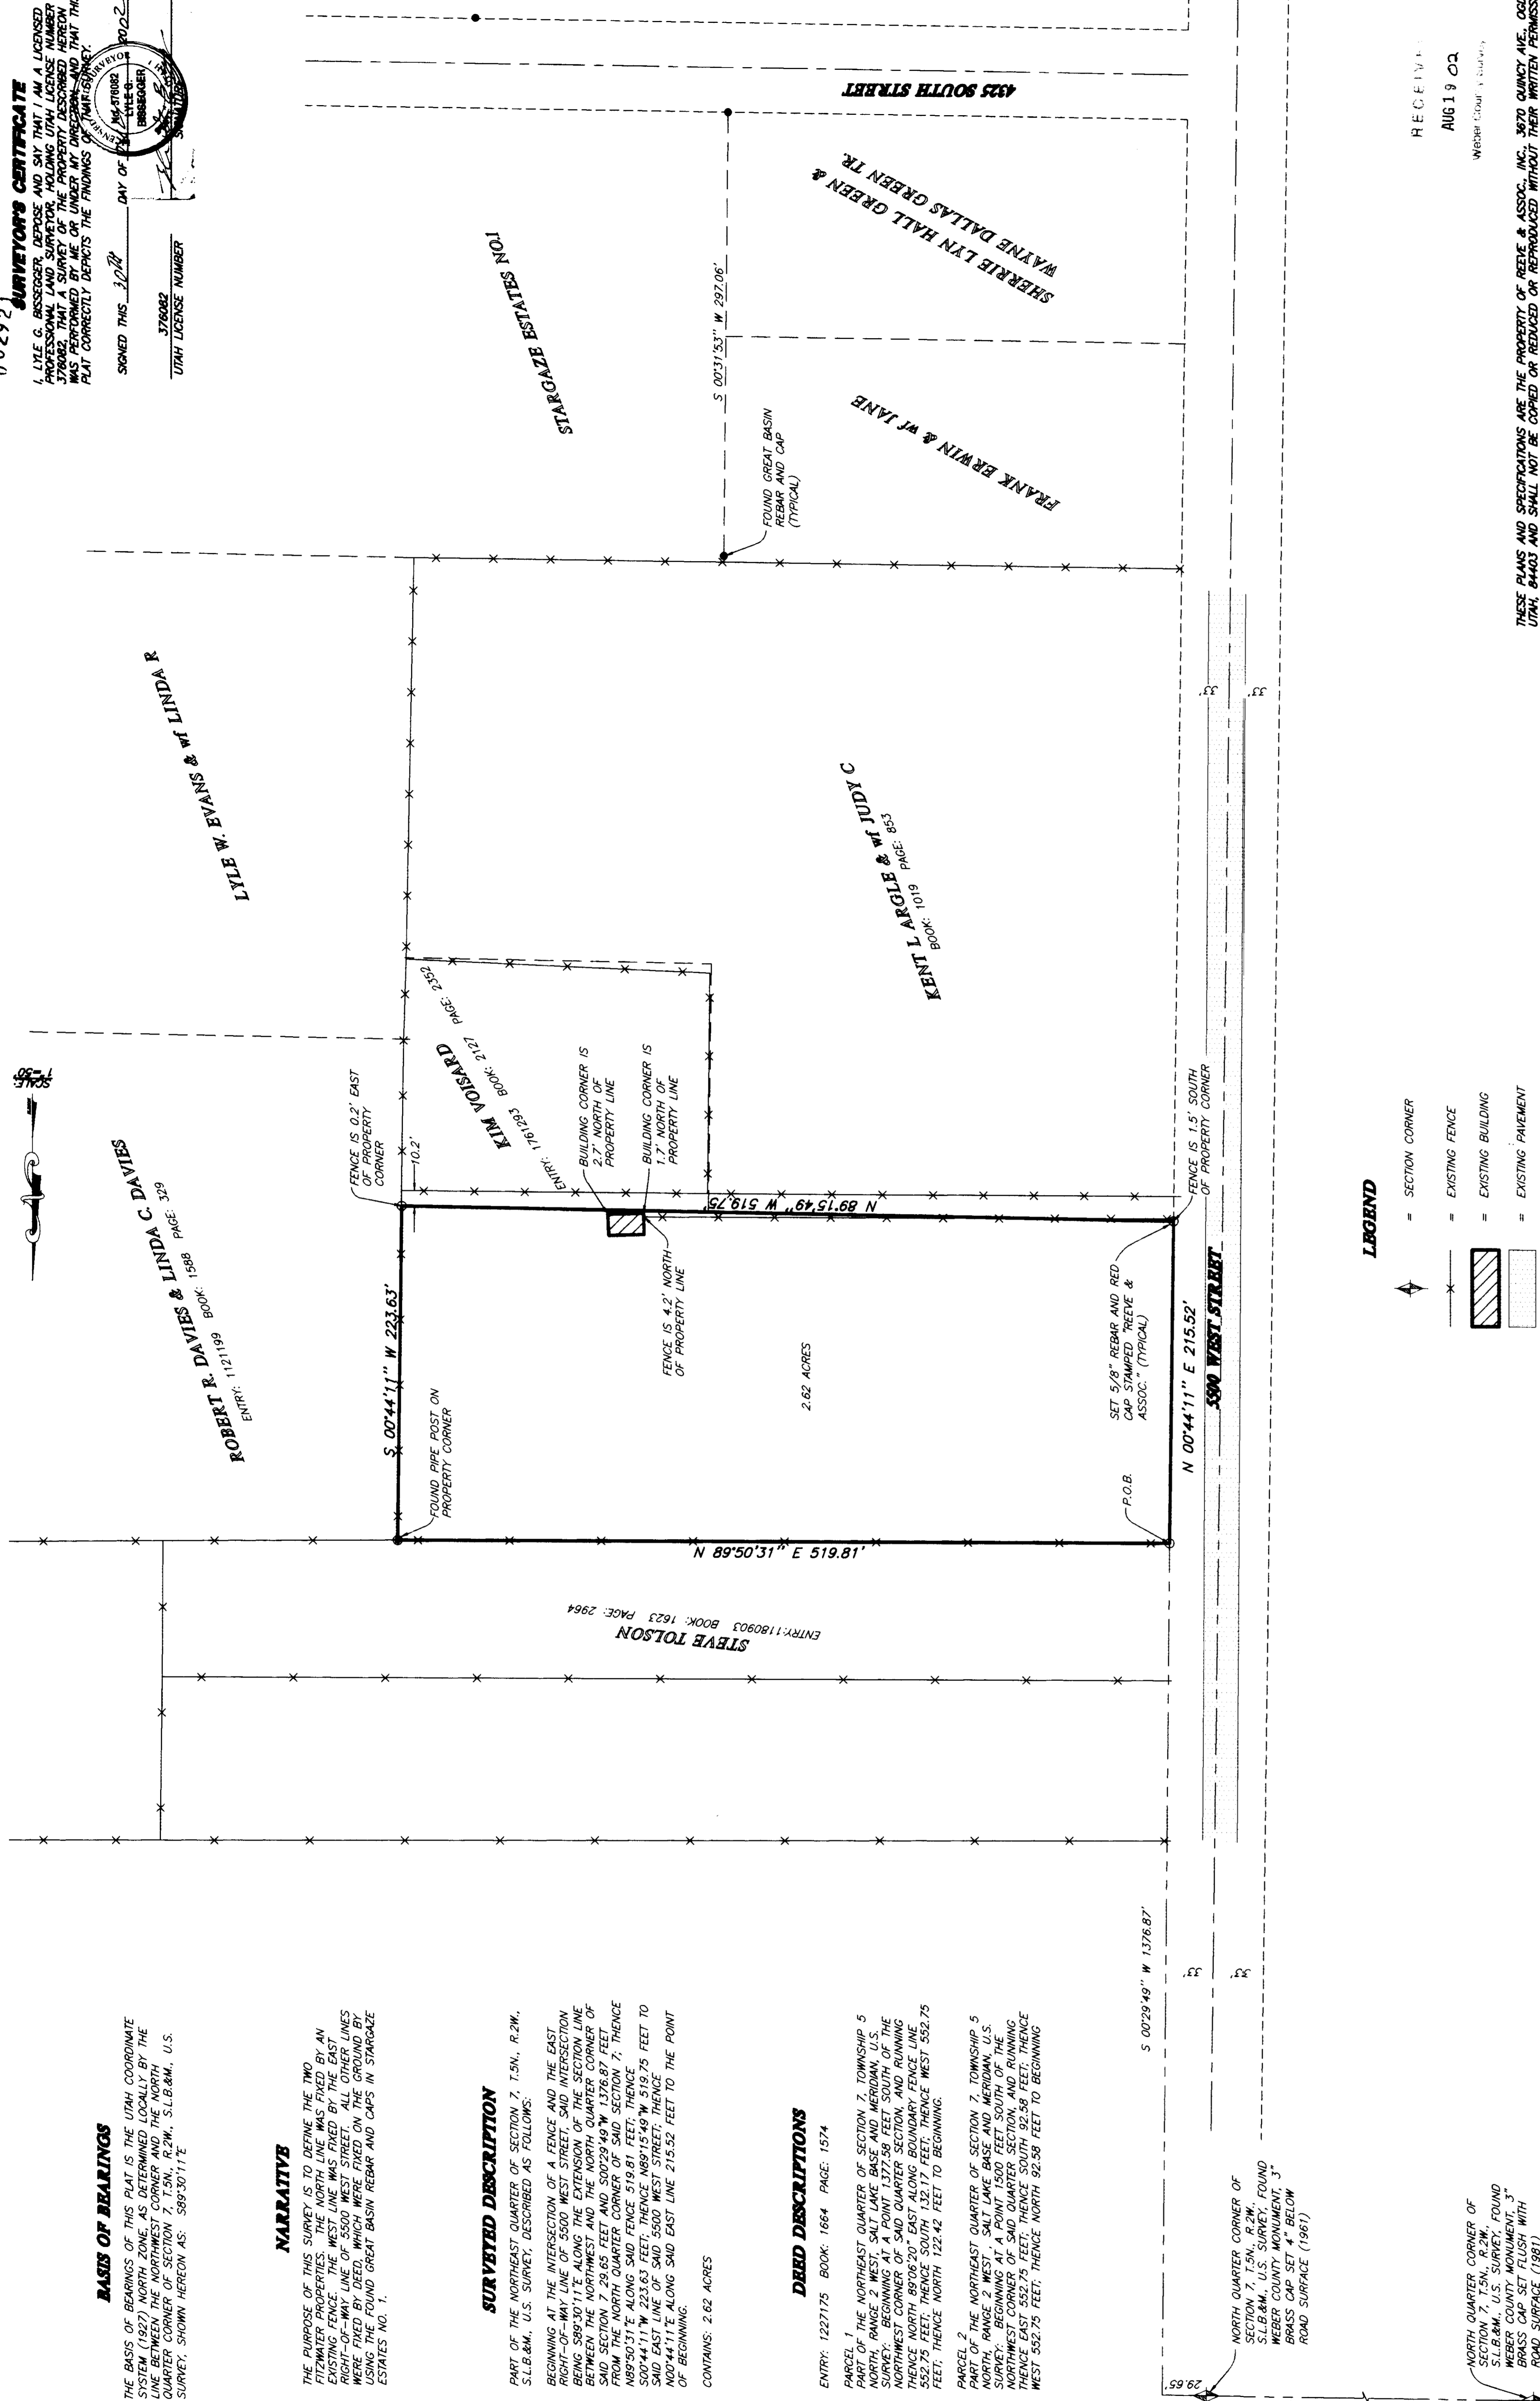

REEVE & ASSOCIATES, INC.
 Civil Engineering • Structural Engineering
 Surveying • Land Use Planning • Architecture
 REG. ENGINEERS: 00828, UTAH 94403
 (801) 621-3100 FAX (801) 621-3668

PROJECT NO.: 4531-01 SURVEYOR: L. REEVE
 DATE: JULY 11, 2002 DRAWN: J. GAIN
 SCALE: 1"=50' CHECKED:
 REVISIONS:
 1. _____
 2. _____
 3. _____
 4. _____
 5. _____
 6. _____

RECORD OF SURVEY

FITZWATER PROPERTY
 PART OF THE NORTHWEST QUARTER OF SECTION 7, T.5N, R.2W, S.L.B.&M., U.S. SURVEY
 HOOVER CITY, UTAH
 JULY, 2002

002921
 SURVEYOR'S CERTIFICATE

RECEIVED
 WEBER COUNTY CLERK

THESE PLANS AND SPECIFICATIONS ARE THE PROPERTY OF REEVE & ASSOCIATES, INC. NO COPY, REPRODUCTION, OR DISSEMINATION OF THESE PLANS OR SPECIFICATIONS SHALL BE MADE OR REPRODUCED WITHOUT THEIR WRITTEN PERMISSION.

002921





0:\V\RM\IN\SS\14602\04521015\494.dwg [plotted 08/22/02 11:02:41 AM H. RAIN]