

SURVEYOR CERTIFICATE

I, PAUL C. FERRY, A PROFESSIONAL LAND SURVEYOR AS DESCRIBED BY THE LAWS OF THE STATE OF UTAH AND HOLDING LICENSE NO. 36834 DO HEREBY CERTIFY THAT I AM THE MAJOR AND THAT THE PLAT HEREON IS A TRUE AND CORRECT REPRESENTATION OF SAID SURVEY



Date: July 02, 2022  
Paul C. Ferry

DEED DESCRIPTIONS




SURVEY DESCRIPTIONS

PARCEL NO. 1  


NOTES





- 1. THE COUNTY ROAD RIGHT-OF-WAY LINE SHOWN ON THIS MAP WAS CREATED BY EXTENDING THE EXISTING RIGHT-OF-WAY FENCE LINES.
- 2. THE ACREAGE OF THE ABOVE SURVEYED PARCELS DESCRIBED INCLUDES THOSE PORTIONS LYING WITHIN THE COUNTY ROAD RIGHT-OF-WAY.

LEGEND

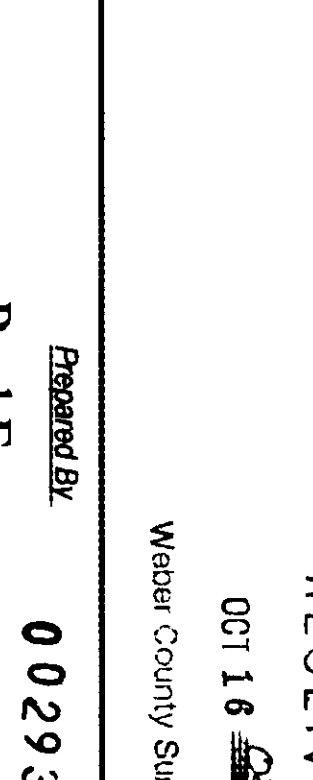

Prepared By: Paul Ferry  
P O Box 362  
Henriev, Utah  
(435) 336-8650

RECORD OF SURVEY  
WEBER COUNTY, UTAH

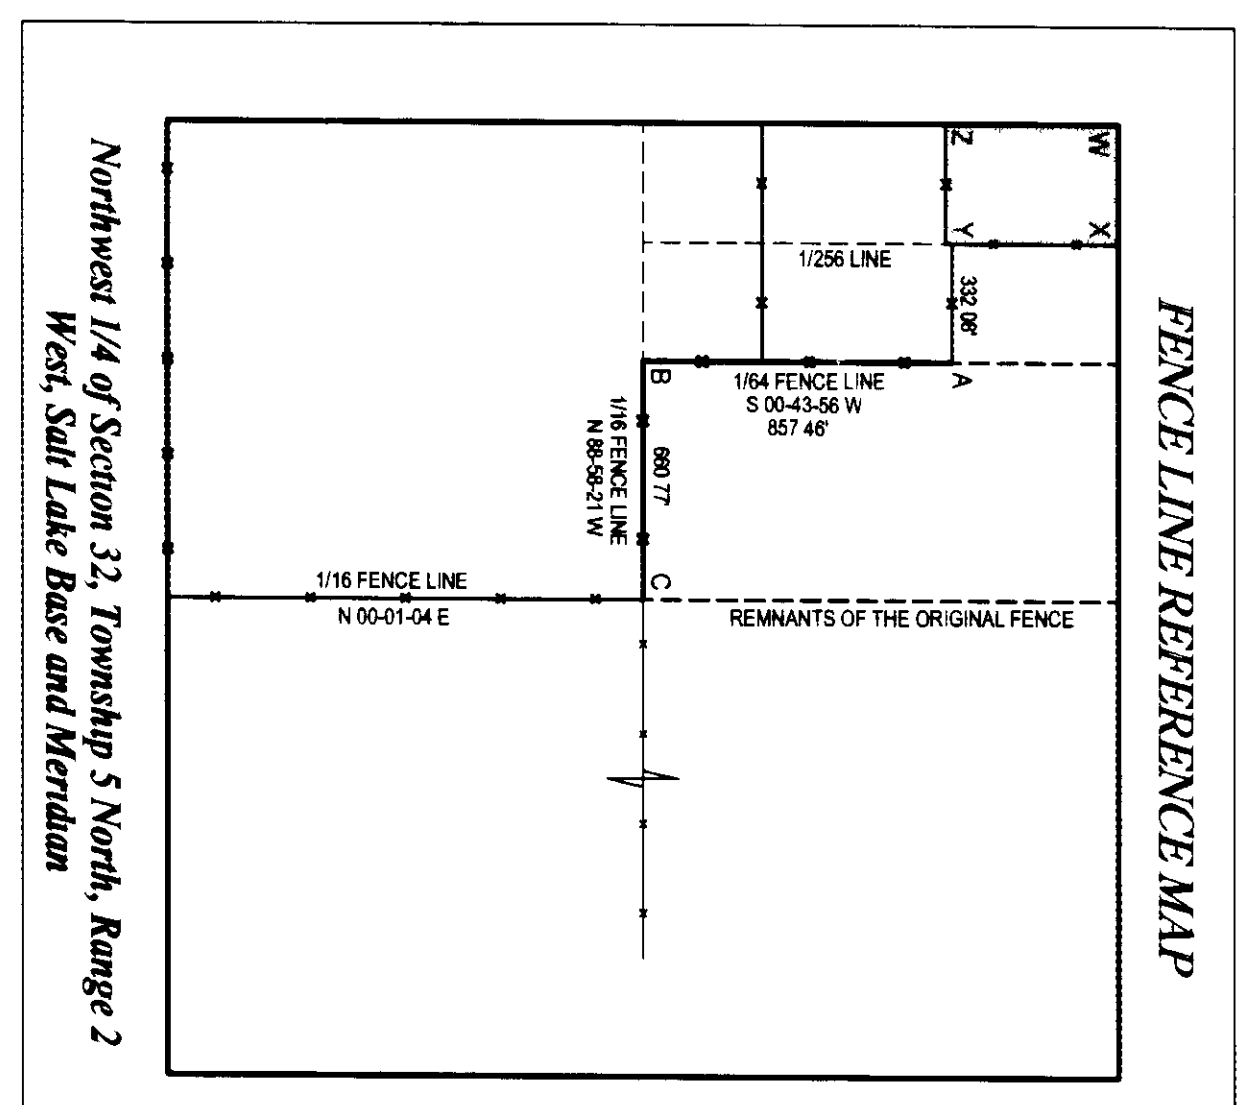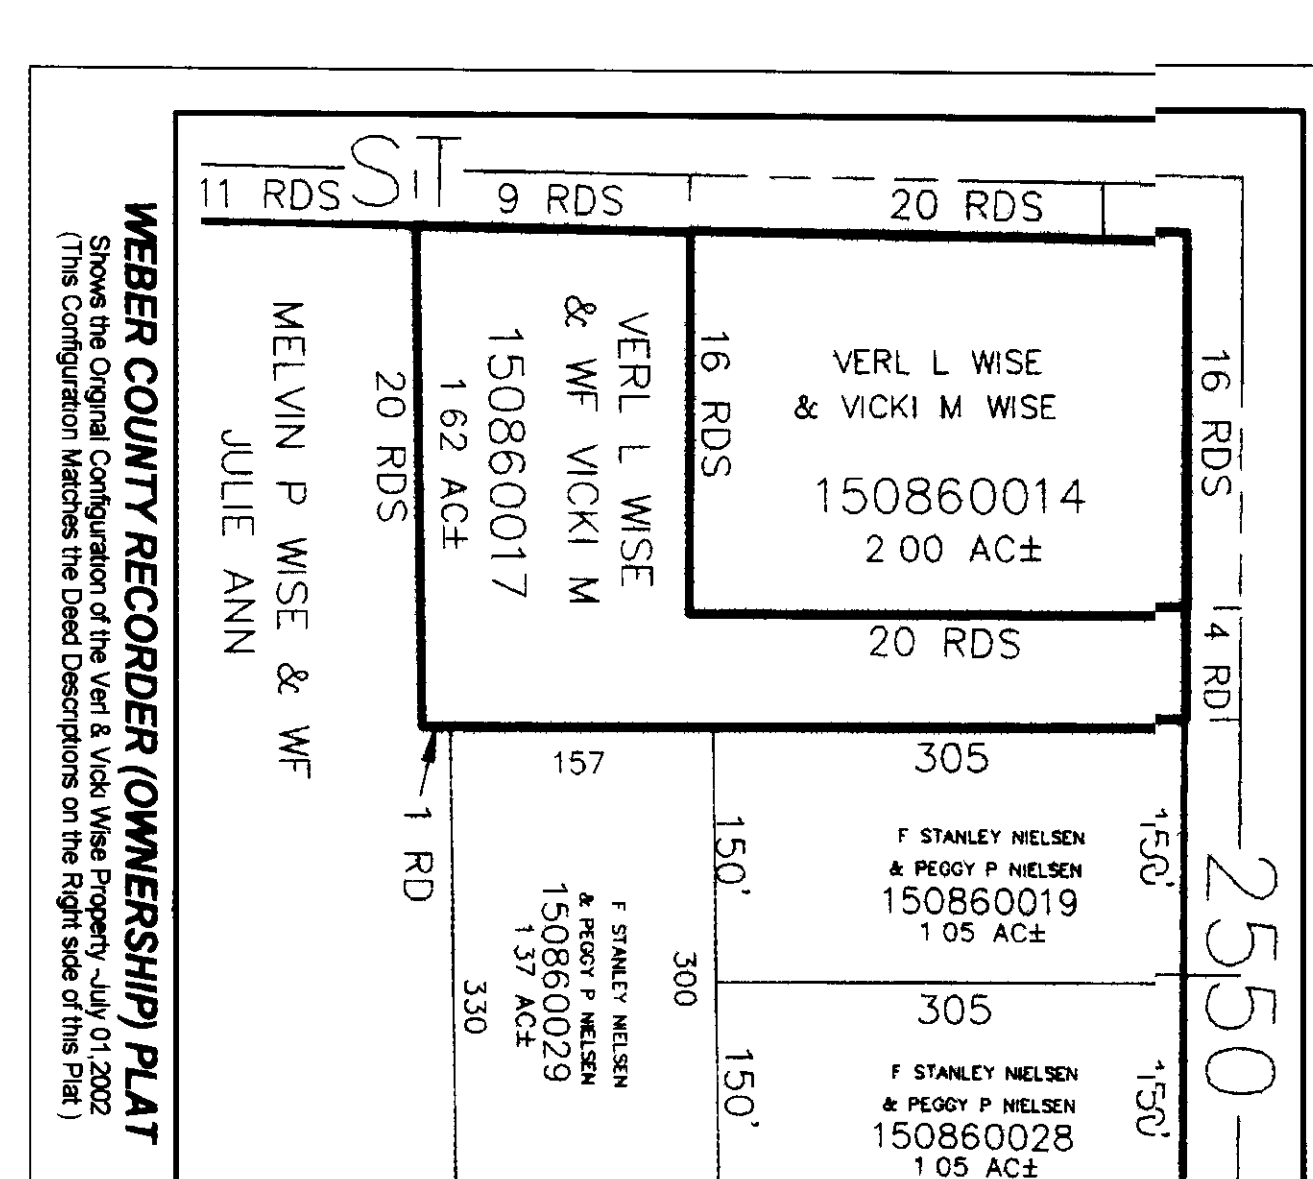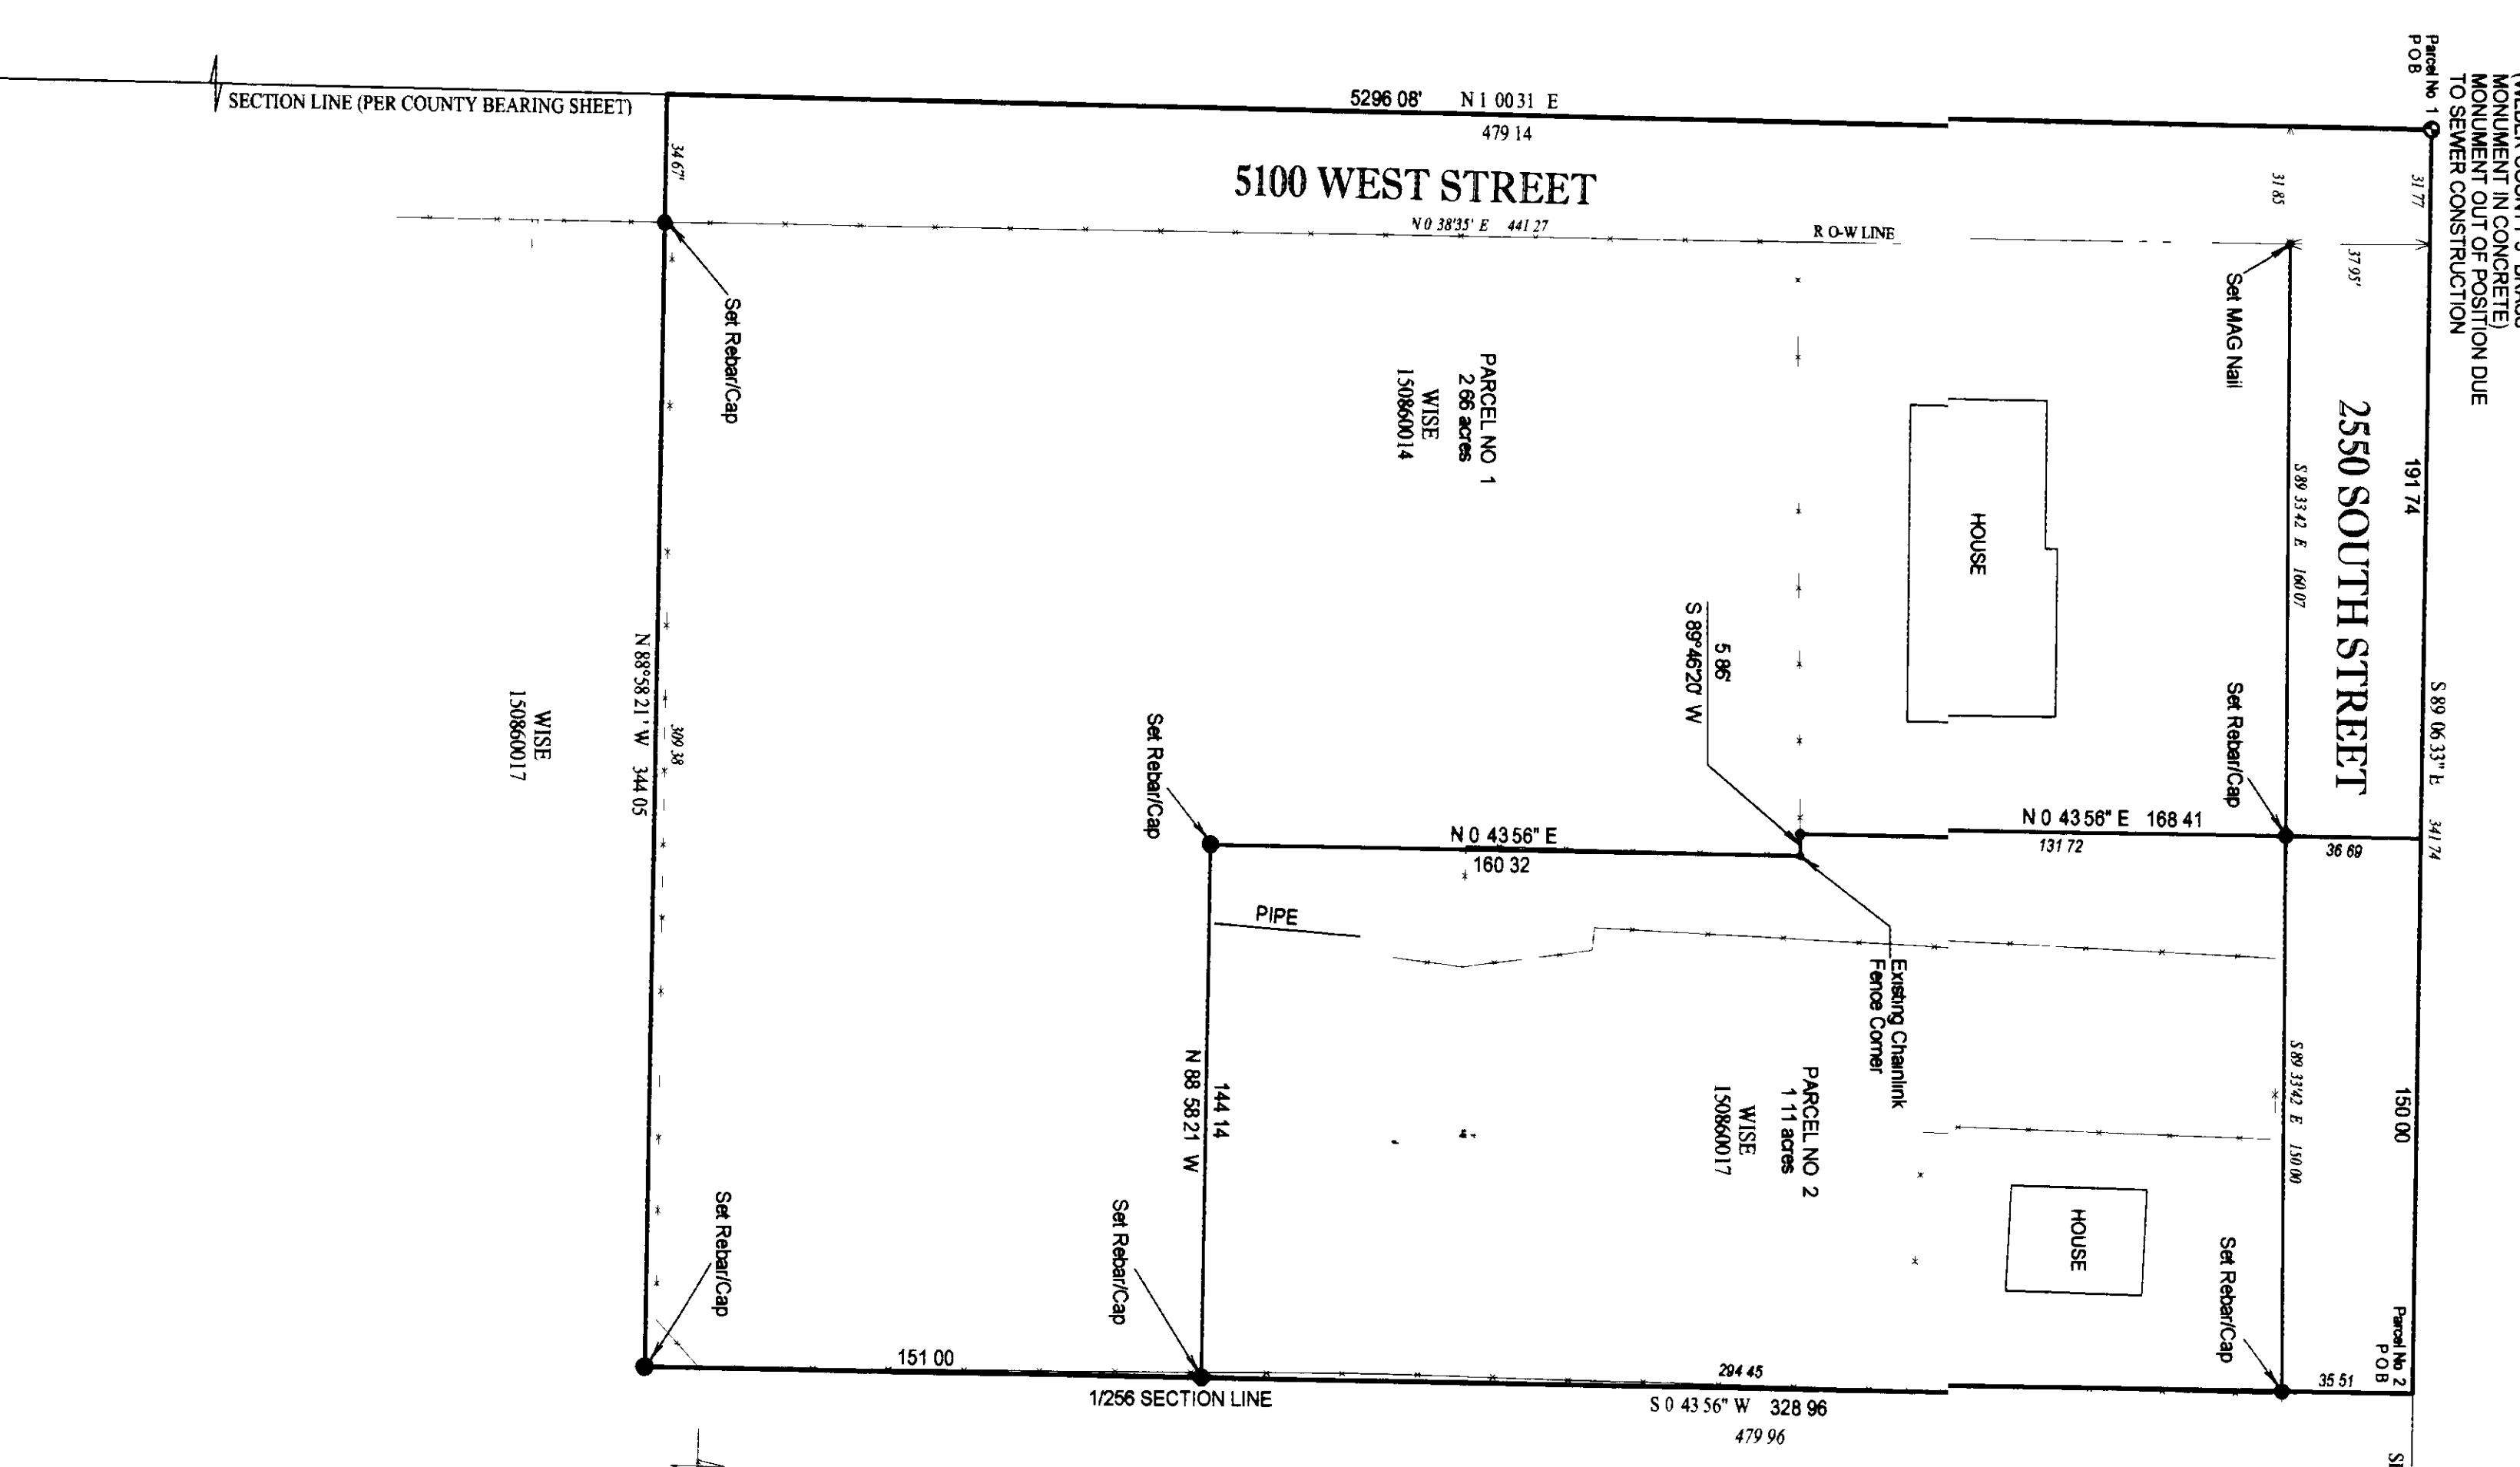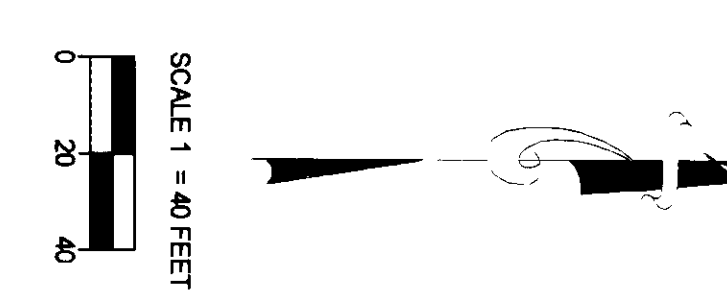

NARRATIVE  
1. VERL WISE REQUESTED A SURVEY OF THE MONUMENTS LOCATED IN SECTIONS 32, 33, 34, 1000.