

North

The purpose of this survey was to establish and set the property corners of the parcel as shown and described hereon. The survey control used to establish the property corners was the existing Ogdens City Survey Monumentation surrounding block 10 of the Kings Ogdens City Survey located on the Ogdens City Property as shown by the dimensioning hereon. The corner property and the adjacent to the east and west were tied to the intersection of the centerline of the 30th Street and the centerline of the 29th Street from the monument of the original Reeves Ave. to the monument of the new Reeves Ave. assumed to be on South 89°24'19\"/>

As Surveyed Description


A PART OF LOT 15, BLOCK 10, KINGS OGDENS CITY SURVEY, WEBER COUNTY, UTAH BEGINNING AT A POINT ON THE SOUTH RIGHT-OF-WAY OF 29th STREET LOCATED SOUTH 89°24'19\"/>

SURVEY CERTIFICATE

I, K. Greg Hansen, do hereby certify that I am a Registered Land Surveyor in the State of Utah, and that I have made and/or supervised the survey of the property shown and described hereon in accordance with the laws of the State of Utah, and that the survey is the true and correct survey of the property as shown and described hereon.

K. Greg Hansen
 Registered Land Surveyor
 No. 19919
 State of Utah
 My Comm. Expires 03/31/2012

- LEGEND**
- PROPERTY LINE
 - CONTRIBUTIVE
 - OWNER & OWNER
 - ADJ. PROPERTY
 - ADJ. STREET
 - STREET MONUMENT
 - SET 01/01/2009 W/ GPS

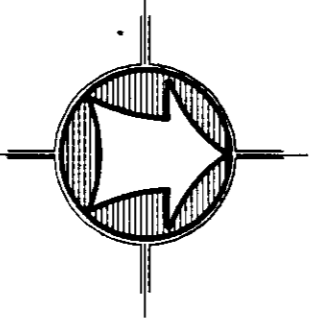

Scale: 1" = 40'

RECEIVED
 NOV 07 2002
 WEBER COUNTY SURVEY

002962

SHEETS	1	PROPERTY SURVEY FOR Javier Chavez 205 West 29th Ogdens, Weber County, Utah A PART OF THE NORTHEAST QUARTER OF SECTION 14, TOWNSHIP 9 NORTH, RANGE 2 WEST, S.L.B. & M.	Drawn By: kah Date: 09/24/02	HANSEN & ASSOCIATES, INC. Consulting Engineers and Land Surveyors 538 North Main Brigham City, Utah 84302 Brigham City Ogdens Logan 723-3491 399-4905 752-8272	No.	Date	By	Revision
	1		Designed By:					