

# OLSEN ESTATES SUBDIVISION PHASE 2


## A PART OF THE SOUTHEAST QUARTER OF SECTION 29, T 6N., R. 2W., S L B & M.

### WEBER COUNTY, UTAH

JUNE 2001  
RECORD OF SURVEY

LETA 2000C  
NO. 5111

NOTE  
OLSEN ESTATES SUBDIVISION SHOWN  
THIS AS GENERAL INFORMATION  
AND IS NOT NECESSARILY INCLUDED  
AT THIS TIME

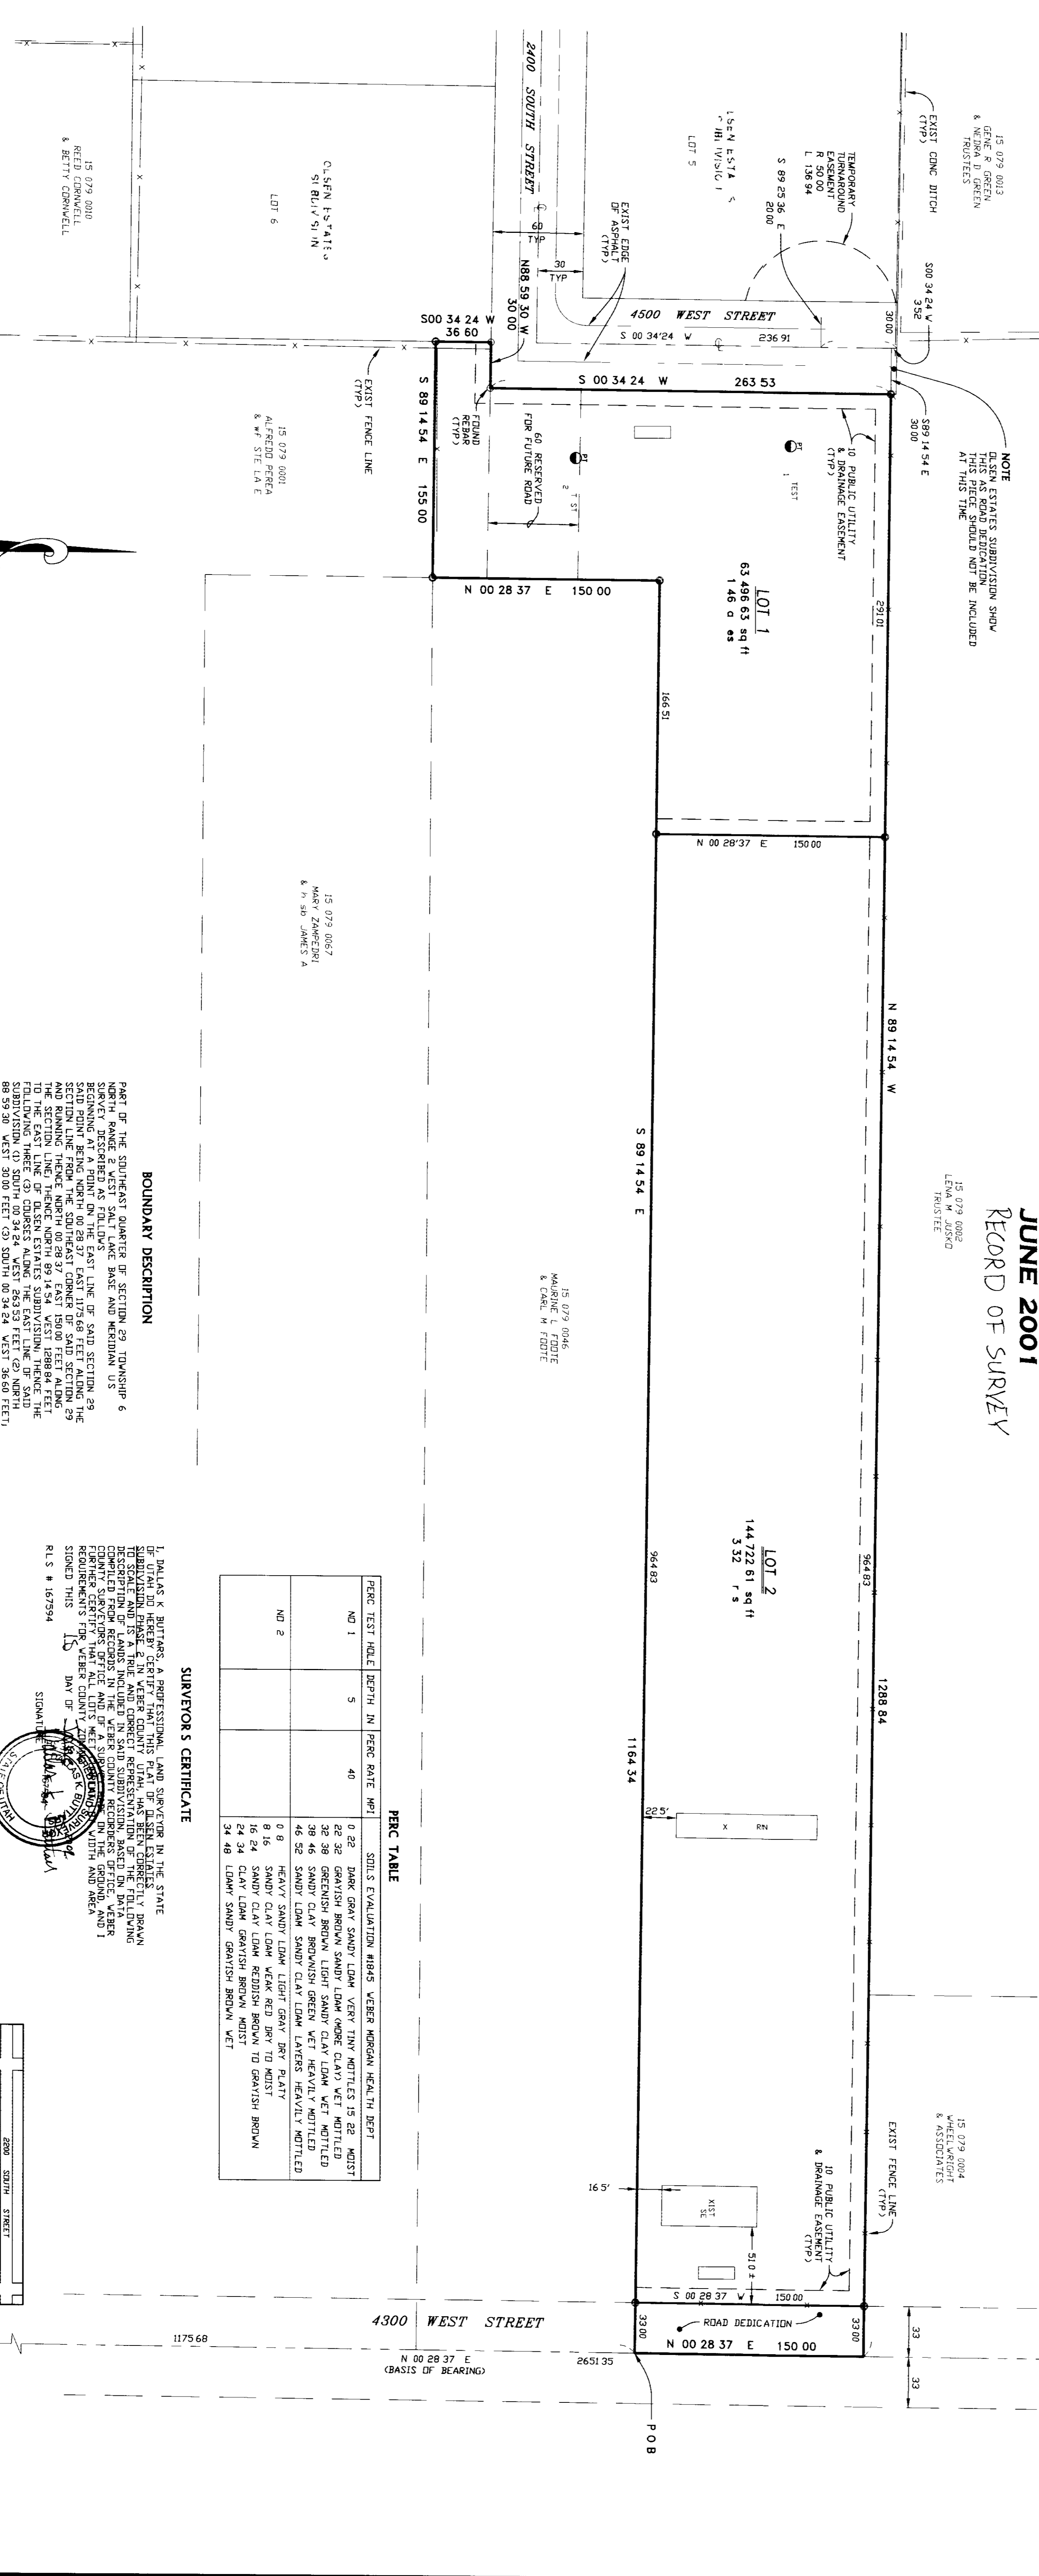

**AGRICULTURAL NOTE**

AGRICULTURE IS THE PREFERRED USE IN THE AGRICULTURE ZONE. THE AGRICULTURE ZONE IS THE AGRICULTURE ZONE AS SHOWN ON THE ZONING MAP. 

**WEBER/ORGANIC HEALTH DEPARTMENT**

I HEREBY CERTIFY THAT THE SOILS REGULATION MAPS INVESTIGATED BY THIS OFFICE AND ARE DEPENDENT FOR ON SITE WASTEWATER DISPOSAL SYSTEMS.

**BOUNDARY DESCRIPTION**


**OWNER'S DEDICATION**

WE THE UNDERSIGNED OWNERS OF THE HEREIN DESCRIBED TRACT OF LAND DO HEREBY SEVER AND SURVIVE THE SAME INTO LOTS AND STREETS AS SHOWN ON THIS PLAT...

**SURVEYOR'S CERTIFICATE**


**RECEIVED**  
JAN 31 2003  
Webber County Surveyor

**WEBER COUNTY PLANNING COMMISSION APPROVAL**

THIS IS TO CERTIFY THAT THIS SUBDIVISION IS IN ACCORDANCE WITH THE PLANNING COMMISSION'S POLICIES AND PROCEDURES FOR THE INSTALLATION OF THESE STAKES THIS \_\_\_\_\_ DAY OF \_\_\_\_\_ 20

**WEBER COUNTY ENGINEER**

I HEREBY CERTIFY THAT THE REQUIRED PUBLIC IMPROVEMENTS HAVE BEEN PROVIDED FOR AND THE AMOUNT OF FINANCIAL RESPONSIBILITY AND/OR LIABILITIES ASSUMED BY THE SUBDIVISOR IS AS SHOWN ON THE PLAT.

**WEBER COUNTY SURVEYOR**

I HEREBY CERTIFY THAT THE WEBER COUNTY SURVEYOR'S CERTIFICATES SECTION CORNER DATA AND THE HANDBOOK WITH LINES AND MONUMENTS ON RECORD IN COUNTY RECORDS ARE CORRECT AND TRUE AND THAT THE SUBDIVISOR'S REPRESENTATIONS AND/OR LIABILITIES ASSUMED BY THE SUBDIVISOR ARE AS SHOWN ON THE PLAT.

**WEBER COUNTY ATTORNEY**


I HAVE EXAMINED THE PLANNING, GUARANTEE AND OTHER INSTRUMENTS AND HAVE CONSENTED TO THE SUBDIVISION IN MY OPINION THEY COMPLY WITH THE COUNTY ORDINANCE AND I HAVE SIGNED THIS PLAT ON THE DAY OF \_\_\_\_\_ 20

**WEBER COUNTY COMMISSION ACCEPTANCE**


**ACKNOWLEDGMENT**

STATE OF UTAH  
COUNTY OF WEBER  
BEFORE ME, THE UNDERSIGNED NOTARY PUBLIC, THE SIGNERS OF THE ABOVE INSTRUMENT HAVE IDENTIFIED THEMSELVES AS THE PERSONS WHOSE NAMES ARE THEREIN SET FORTH AND HAVE SIGNATURES AND IDENTIFICATION AS SHOWN ON THE INSTRUMENT AND HAVE SIGNED THIS INSTRUMENT OF THEIR OWN FREE WILL AND VOLUNTARILY AND FOR THE PURPOSES THEREIN INTENDED.

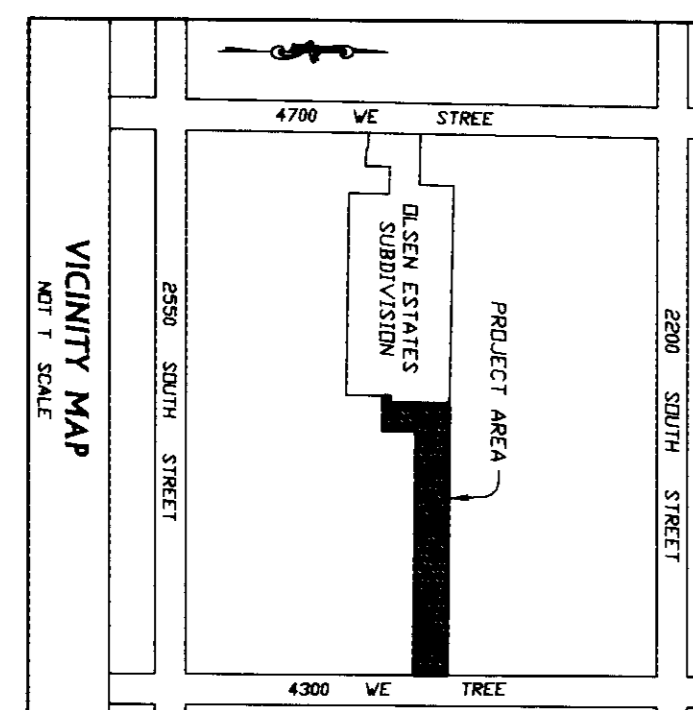

**LANDMARK SURVEYING AND ENGINEERING, INC.**  
A COMPLETE LAND DEVELOPMENT SERVICE  

**CLIENT:** JOE STOREY  
**LOCATION:** PART OF THE SE 1/4 OF SEC. 29 T6N. R2W. S.L.B. & M.  
**SURVEYED:** MAR. 2001  
**DESIGNERS:** DRYAN, BY L.A.  
**CHECKED BY:** J.B.  
**DATE:** 06.01.01  
**FILE:** 28277NDWG

**WEBER COUNTY RECORDER**  
ENTRY # \_\_\_\_\_ FEE \_\_\_\_\_  
FILED FOR RECORD & RECORDED THIS \_\_\_\_\_ DAY OF \_\_\_\_\_ 20  
AT \_\_\_\_\_ IN BOOK \_\_\_\_\_ OF \_\_\_\_\_  
PAGE \_\_\_\_\_  
WEBER COUNTY RECORDER  
BY \_\_\_\_\_ DEPUTY