


0 0 2 9 0

Legend

- Set Nail & Washer
- Set Pin & Cap
- Set Nail & Flag
- (N/A) Return Line to be set
- (N/A) Non-Return Line
- O.C.K. Ogden City Pins

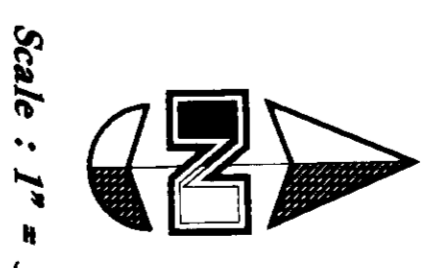

Scale : 1" = 30'

NARRATIVE

This survey was requested by Mr. Brad Richard of Richards/Beit Architect in behalf of the LDS Church for the purpose of locating new curb & gutter on the property and to establish the boundaries of the entire parcel. 

BOUNDARY DESCRIPTIONS

Parcel No. 1
All of lot 1 and part of lots 2 and 3 and part of vacated alley, Block 17, South Ogden, Plat A, Weber County, Utah, all described as follows:
Beginning at Northwest corner of said Lot 1, thence South 89°02'00" West 45.00 feet to monumented spike; thence South 89°02'00" East 45 feet; thence to right along arc of a 213.56 foot curve 100.63 feet; thence to right along arc of a 24.00 foot radius 20.00 feet; thence long straight double ended line bearing North 0°58'00" East along center of vacated alley to the North line of Lot 1; thence North 89°34' West 157.175 feet to the point of beginning.
Contains 8,295 sq.ft.

Parcel No. 2
All of lots 22 to 42, inclusive, Block 17, South Ogden, Plat A, Weber County, Utah, together with the vacated East 1/2 of the alley doubling said lots; together with West 1/2 of vacated Orchard Avenue doubling said property on the East.
Contains 2,338 Acres

Parcel No. 3
All of lots 1 to 12, inclusive, and the West 49,175 feet of Lots 13 to 17, inclusive, of Block 16, South Ogden, Plat A, Weber County, Utah, with East 1/2 of vacated Orchard Avenue doubling said lots on West side; together with West 1/2 of vacated alley doubling said lots on East side.
Contains 1,597 Acres

Parcel No. 4
The West 49,175 feet of lots 18 to 21, block 16, South Ogden, Plat A, Weber County, Utah, together with the East 1/2 of vacated street doubling said lots on the West.
Contains 8,217 sq.ft.

SURVEYOR'S CERTIFICATE

I, Gary L. Newman, do hereby certify that I am a Registered Land Surveyor of the State of Utah, and have made a survey of the above described property, I further certify that the above plat correctly shows the true dimensions of the property surveyed.

Date - 1-13-2003

Gary L. Newman
GARY L. NEWMAN
LAND SURVEYOR
No. 1000

NOTE:
Bearings & Distances in parentheses are
calculated bearings and distances.

RECEIVED

JAN 9 2003
Weber County Surveyor

0 0 2 9 0

4075 Orchard Avenue, Ogden Utah

LDS Church 41st & Orchard Avenue
A Part of the East 1/2 of the Northwest 1/4 of Section 9,
15N, 17W, S16&K, U.S. Survey
Ogden City, Weber County, Utah

DATE : 13 Jan, 2003

Property Survey
GREAT BASIN ENGINEERING NORTH
CONSULTING ENGINEERS AND SURVEYORS
5746 South 1475 East - Suite 200
P.O. Box 150046, Ogden, Utah 84415
Phone: (801)261-4115 Fax: (801)261-0222

SCALE : 1" = 30'

DRAWN : AH

REVISIONS :

99N5007

DATE : 13 Jan, 2003

DRAWN : AH

REVISIONS :

99N5006