
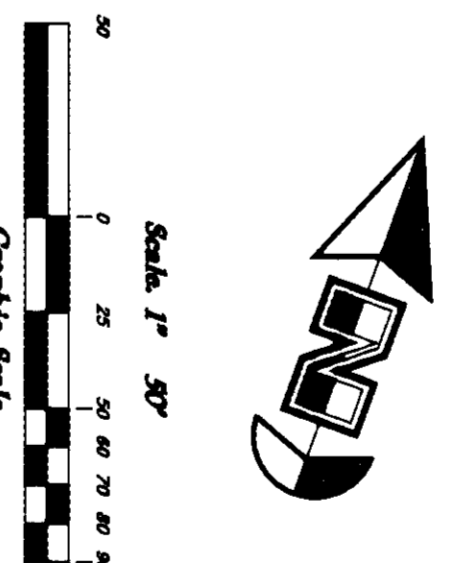


NARRATIVE


EXCEPTION TO COVERAGE

EXCEPTION #10 - A portion of the land... EXCEPTION #11 - A portion of the land... EXCEPTION #12 - A portion of the land...

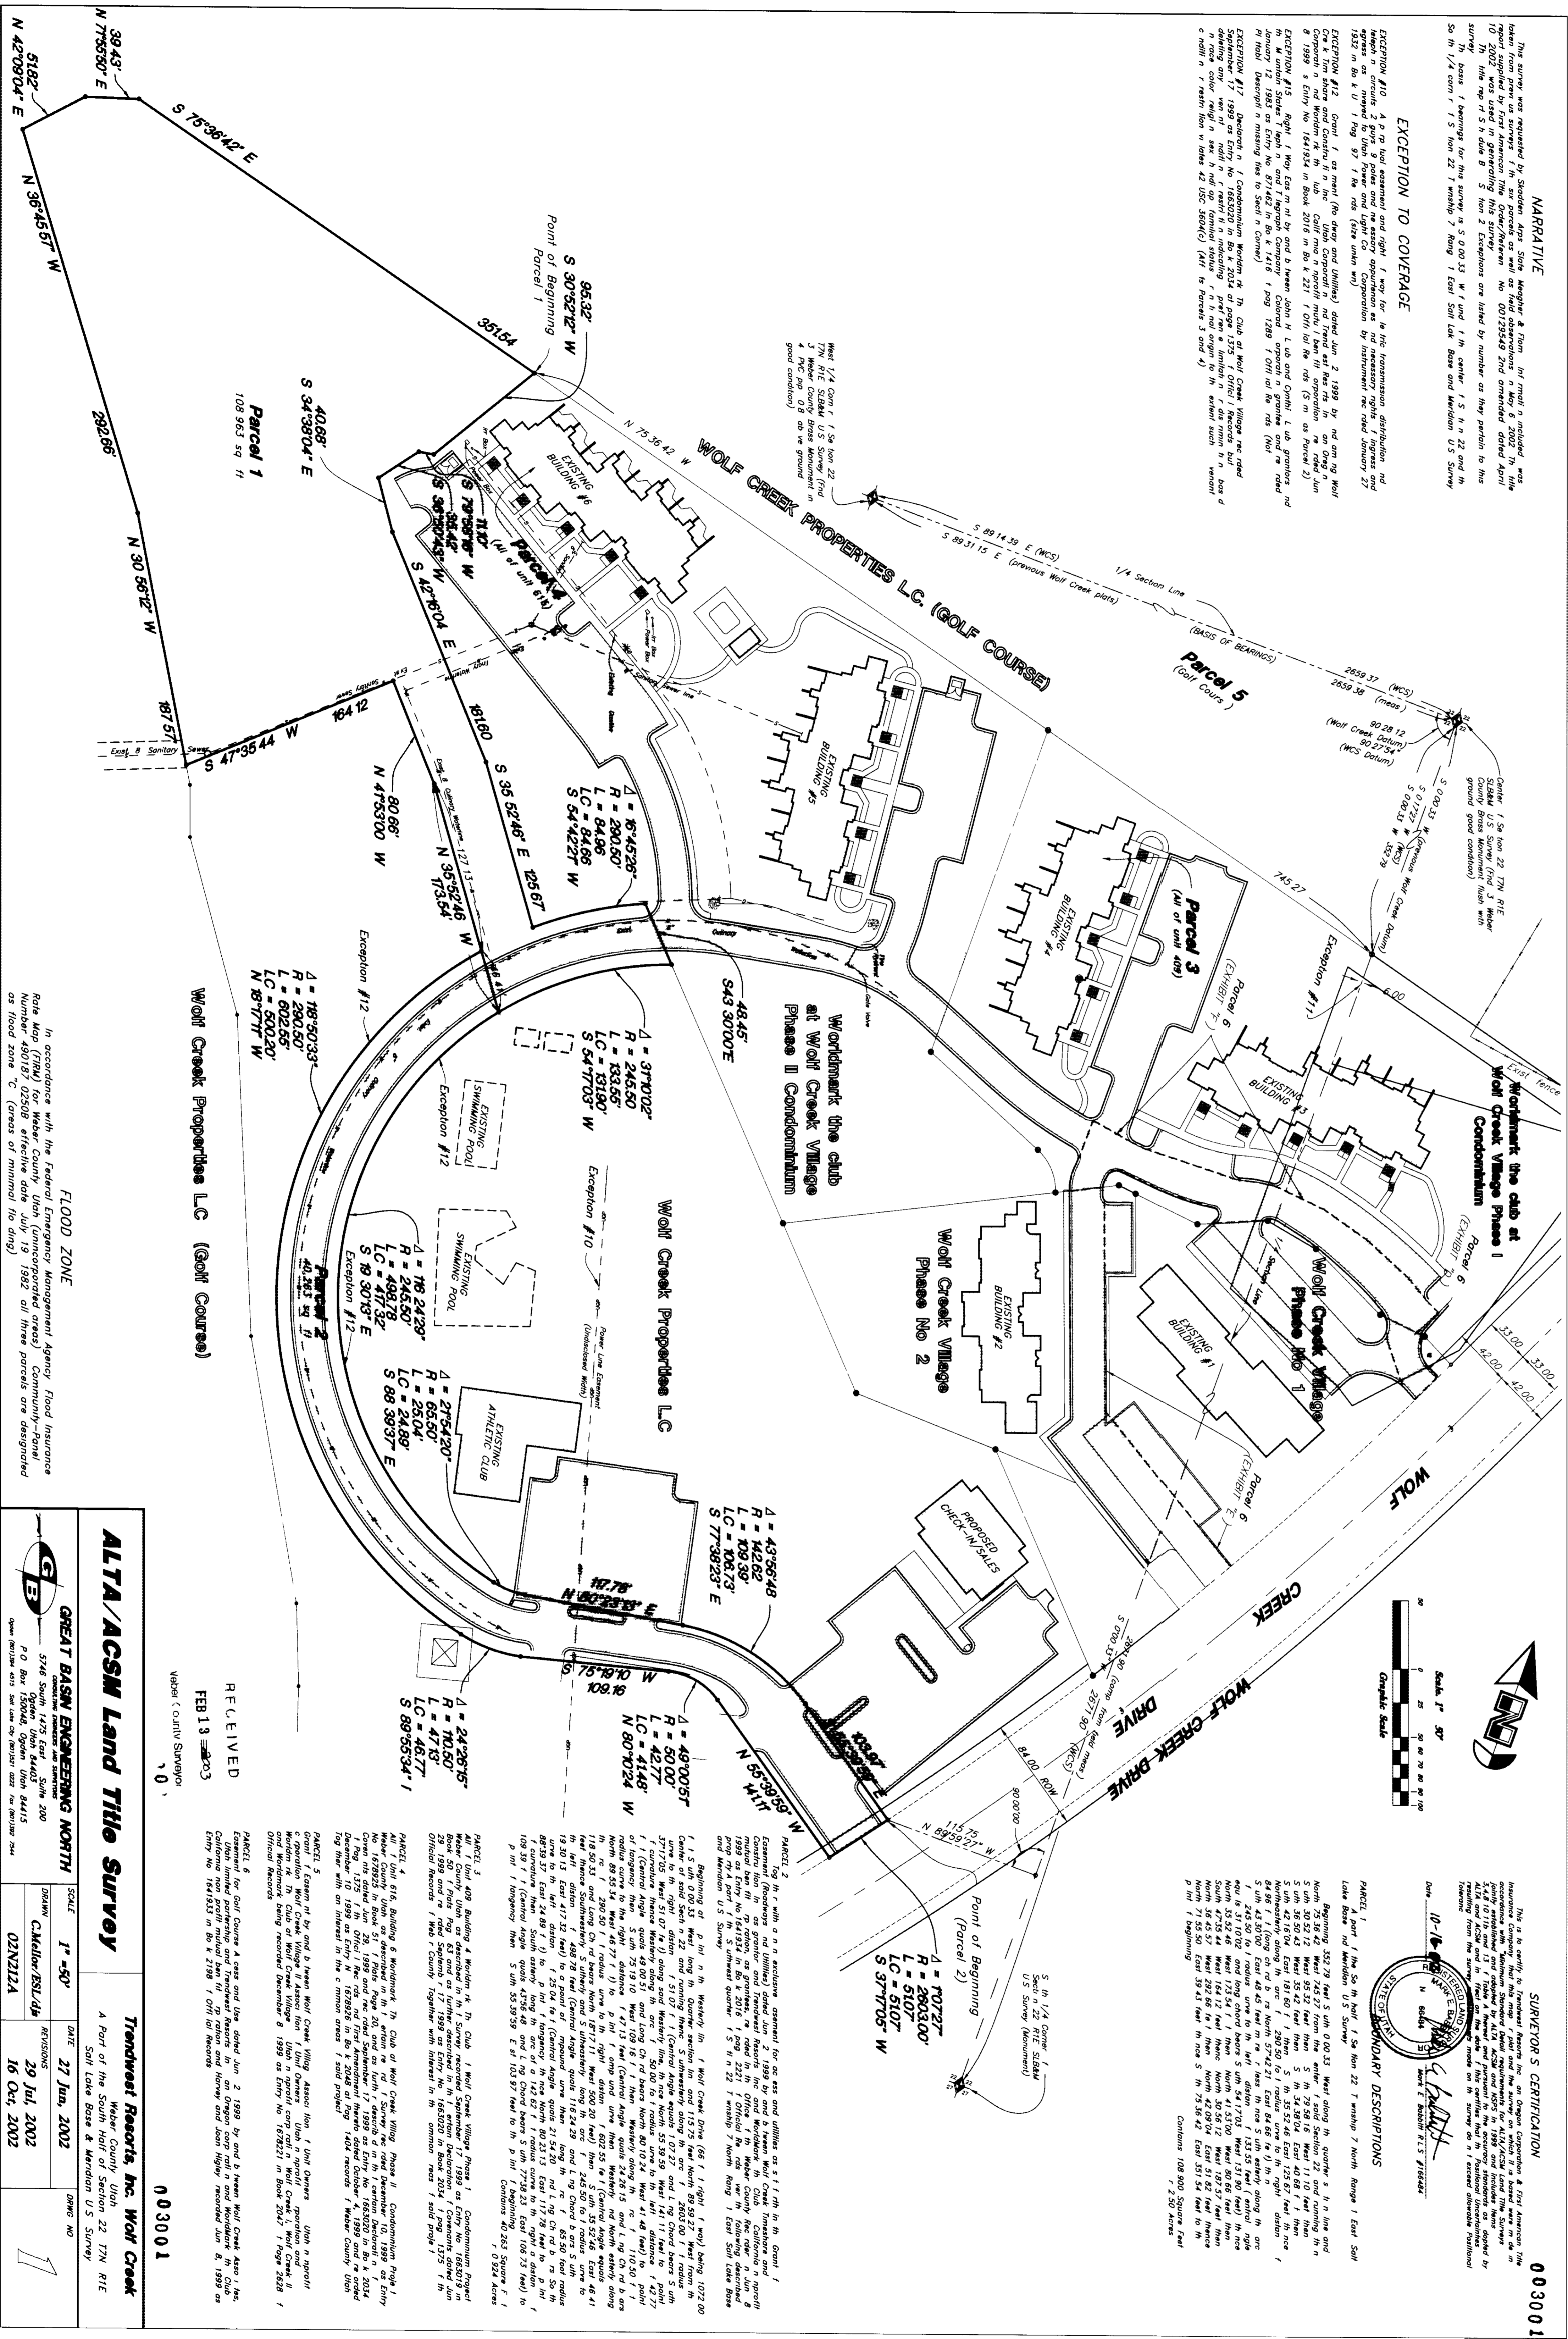




