




DRAWING NUMBER

000304

PLAN HOLL CORPORATION: . IRVINE, CALIFORNIA

DRAWING NUMBER

000304

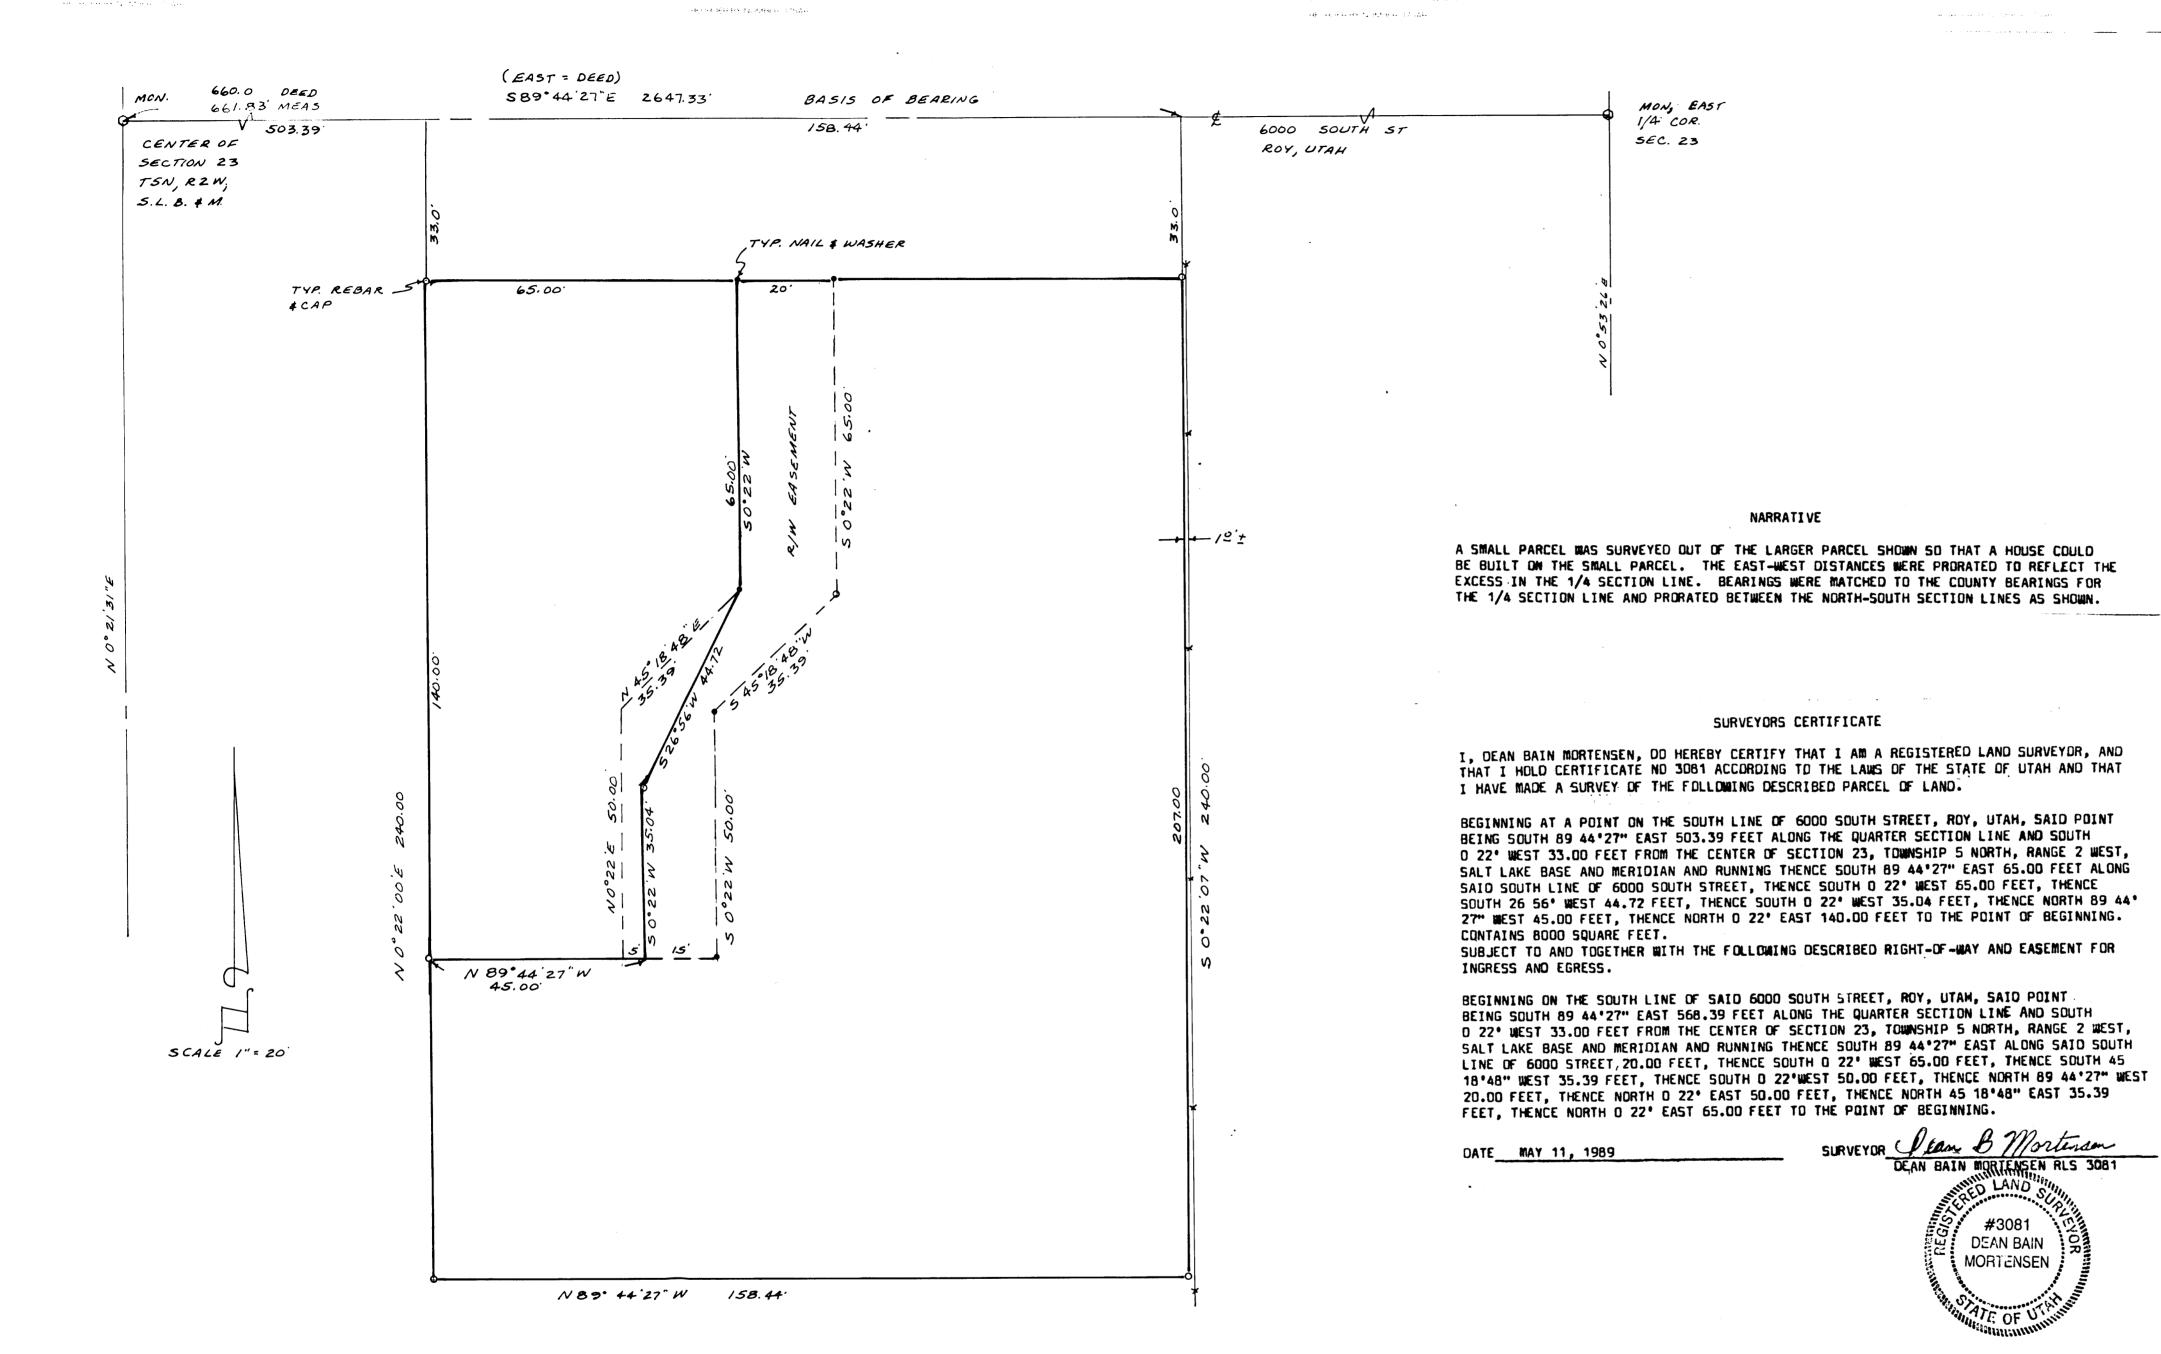

RECEIVED

JAN 1 9 1990

Weber County Surveyor

5.E 1/4 SECTION 23 T5N, R2W, SLB & M.