


Record of Survey Map WORLD MARK, THE CLUB AT WOLF CREEK VILLAGE PHASE 2 A Condominium Project

A part of the Southwest 1/4 of Section 22, T7N, R1E, SLB&M, U.S. Survey
Weber County, Utah



Scale: 1"=30'
NOTE: Building dimensions on this sheet are for exterior foundation only.

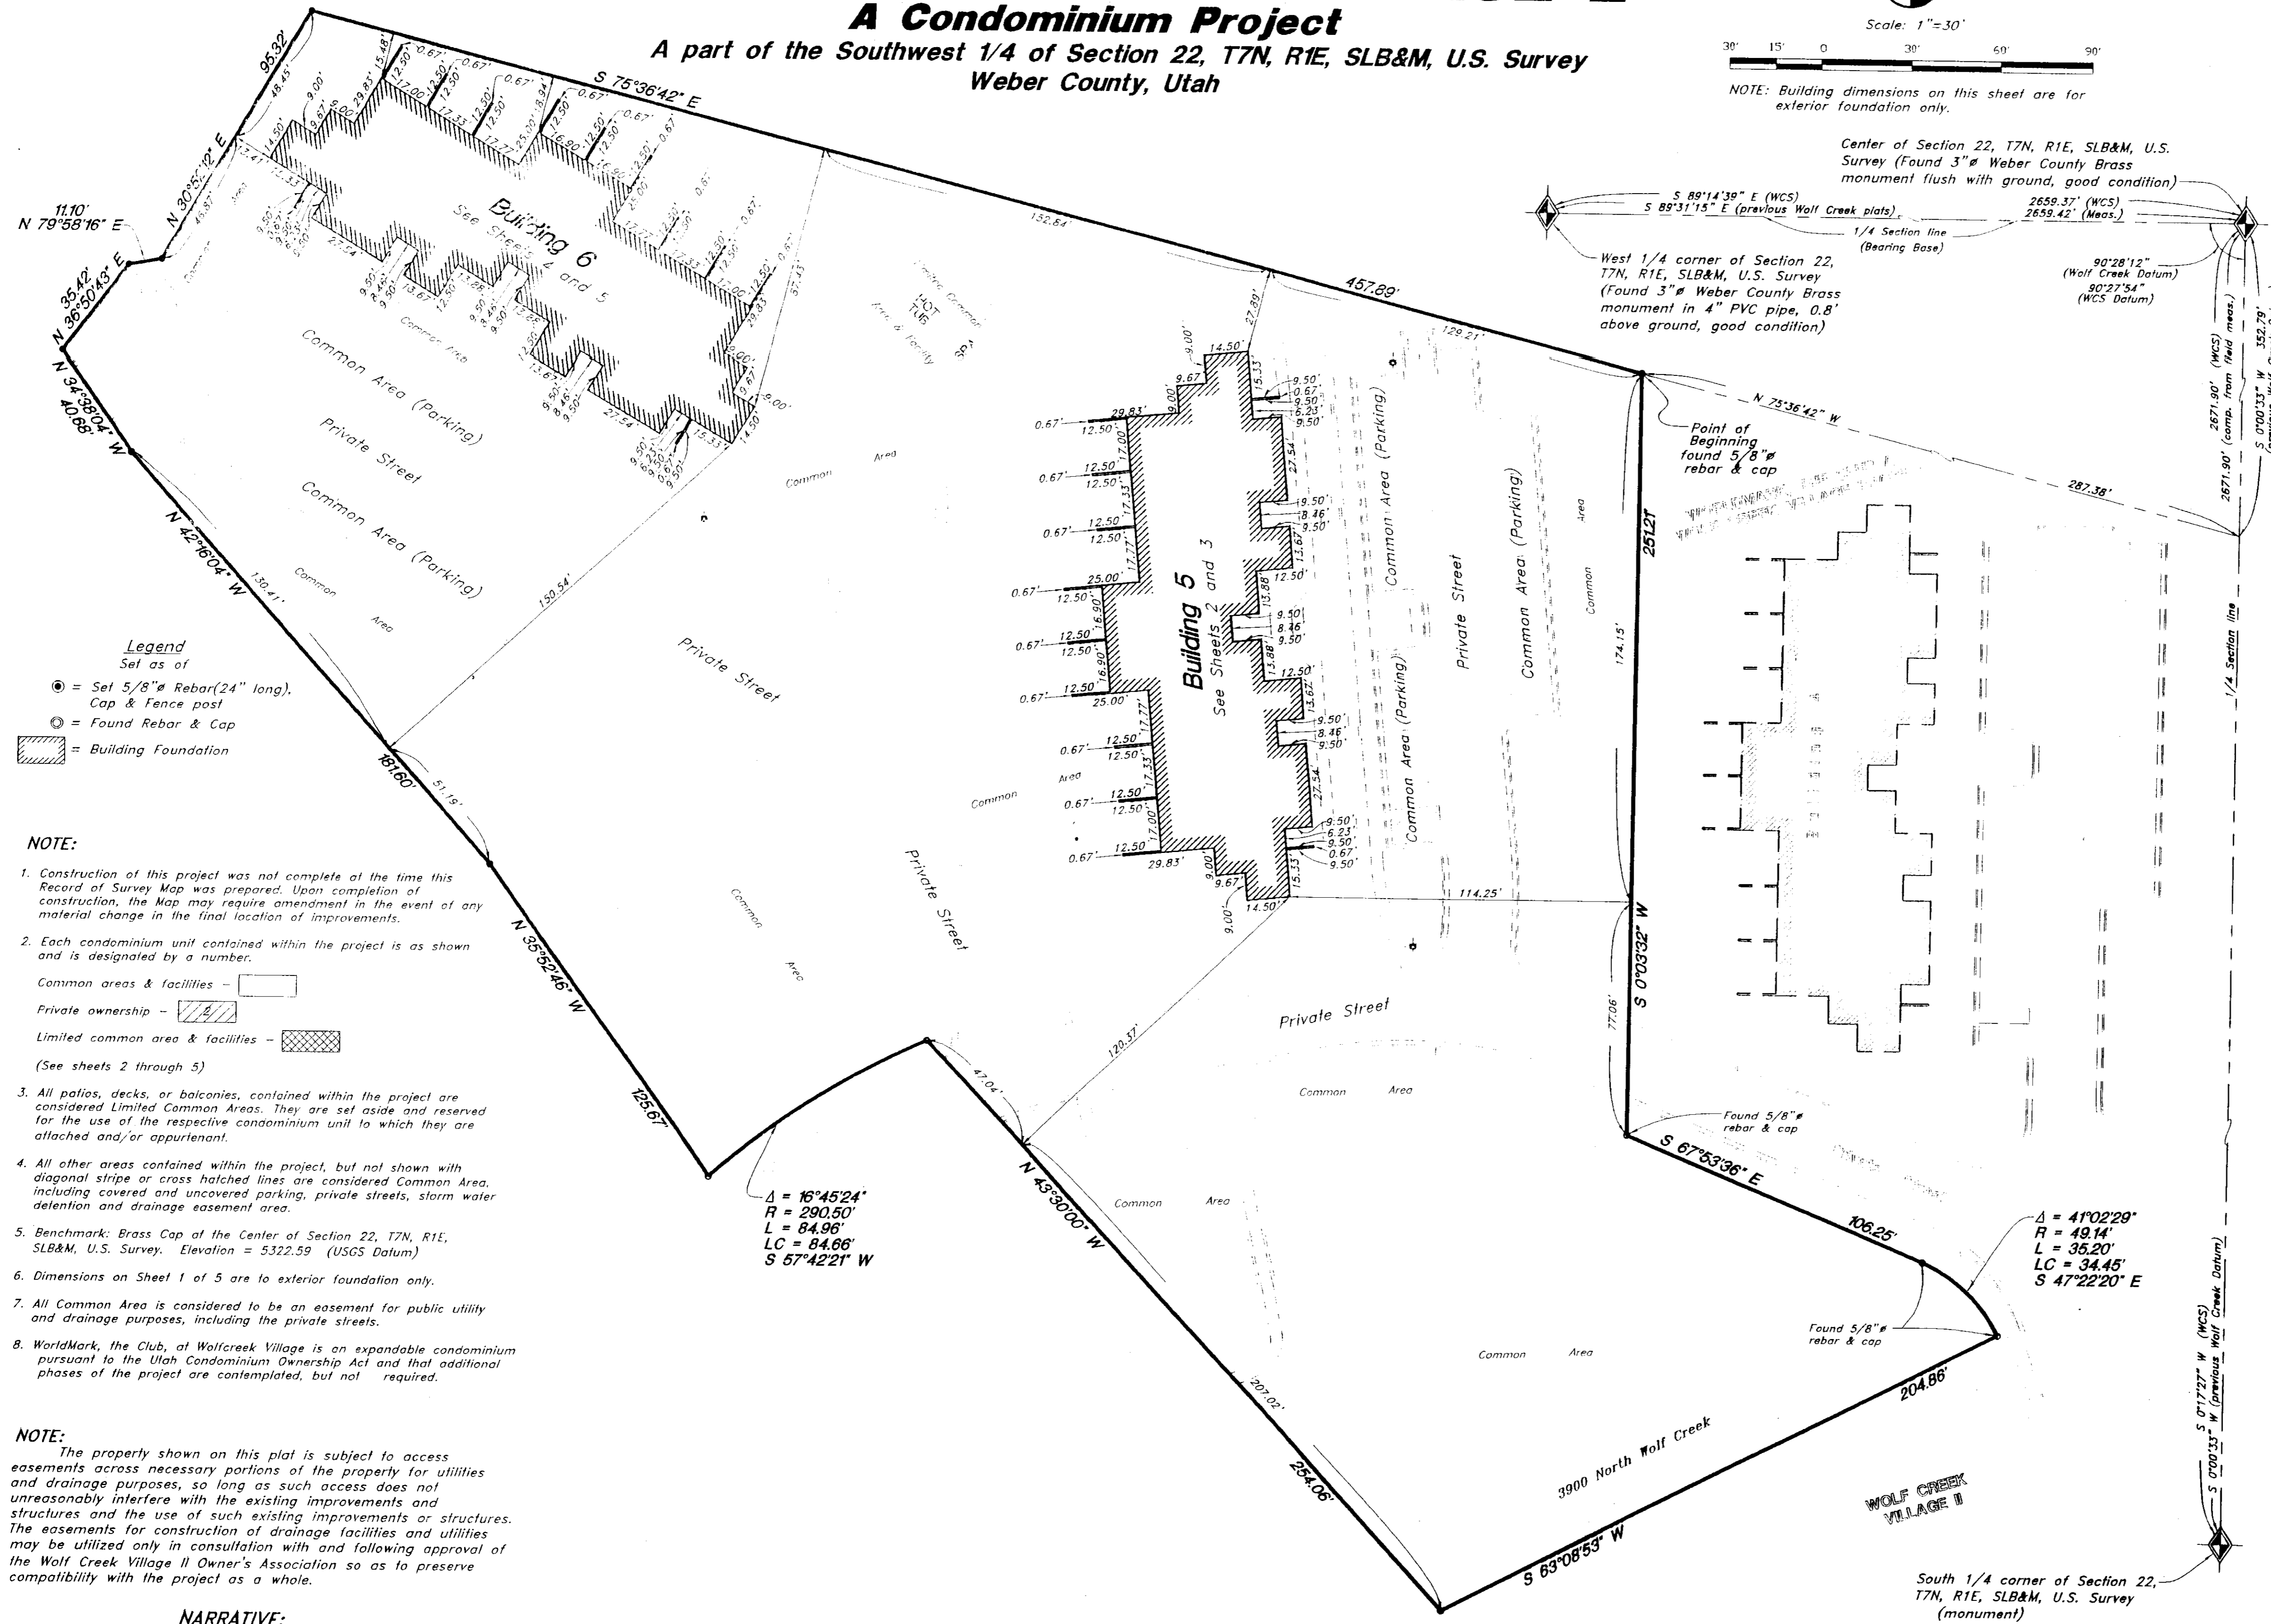

Legend
Set as of
● = Set 5/8" Rebar (24" long), Cap & Fence post
○ = Found Rebar & Cap
▨ = Building Foundation

- NOTE:**
- Construction of this project was not complete at the time this Record of Survey Map was prepared. Upon completion of construction, the Map may require amendment in the event of any material change in the final location of improvements.
 - Each condominium unit contained within the project is as shown and is designated by a number.
Common areas & facilities - [Symbol]
Private ownership - [Symbol]
Limited common area & facilities - [Symbol]
(See sheets 2 through 5)
 - All patios, decks, or balconies, contained within the project are considered Limited Common Areas. They are set aside and reserved for the use of the respective condominium unit to which they are attached and/or appurtenant.
 - All other areas contained within the project, but not shown with diagonal stripe or cross hatched lines are considered Common Area, including covered and uncovered parking, private streets, storm water detention and drainage easement area.
 - Benchmark: Brass Cap of the Center of Section 22, T7N, R1E, SLB&M, U.S. Survey. Elevation = 5322.59 (USGS Datum)
 - Dimensions on Sheet 1 of 5 are to exterior foundation only.
 - All Common Area is considered to be an easement for public utility and drainage purposes, including the private streets.
 - WorldMark, the Club, at Wolfcreek Village is an expandable condominium pursuant to the Utah Condominium Ownership Act and that additional phases of the project are contemplated, but not required.

NOTE:
The property shown on this plat is subject to access easements across necessary portions of the property for utilities and drainage purposes, so long as such access does not unreasonably interfere with the existing improvements or structures and the use of such existing improvements or structures. The easements for construction of drainage facilities and utilities may be utilized only in consultation with and following approval of the Wolf Creek Village II Owner's Association so as to preserve compatibility with the project as a whole.

NARRATIVE:

At the request of Trendwest Resort Inc. this Record of Survey Map was prepared in order to establish the boundaries of "WorldMark, The Club at Wolf Creek Village Phase 2" and to define the airspace for each condominium unit. The Basis of bearings for this survey is S 89°31'15" E between the Brass Monuments found at the West 1/4 corner and the Center of Section 22, Township 7 North, Range 1 East, Salt Lake Base and Meridian, U.S. Survey.

GREAT BASIN ENGINEERING NORTH
CONSULTING ENGINEERS AND SURVEYORS
3544 Lincoln Avenue, Ogden, Utah, 84401
P.O. Box 9307, Ogden, Utah, 84409
Ogden (801)394-4515 Salt Lake City (801)521-0222 Fax (801)392-7544

WEBER COUNTY ATTORNEY

I have examined the financial guarantee and other documents associated with this condominium plat and in my opinion they conform with the County Ordinance applicable thereto and now in force and effect.

Signed this 2nd day of December, 1999.
[Signature]

WEBER COUNTY SURVEYOR

I hereby certify that I have inspected the lines of survey of the foregoing plat and legal description of the land embraced therein, and find them to be correct and to agree with the lines and monuments on record in this office.

Signed this 2nd day of December, 1999.
[Signature]

WEBER COUNTY ENGINEER

I hereby certify that the required public improvement standards and drawings for this plat conform with County standards and the amount of the financial guarantee is sufficient for the installation of these improvements.

Signed this 9th day of December, 1999.
[Signature]

OWNERS CERTIFICATE OF CONSENT TO RECORD

Know all men by these presents, that the undersigned: Trendwest Resorts, Inc., an Oregon corporation and WorldMark, The Club, a California nonprofit mutual benefit corporation, Owners of the tract of land described hereon and WorldMark, The Club at Wolf Creek Village Phase 2, a condominium project located on said tract of land and hereby make this consent to the recordation of this in accordance with the provisions as Section 57-8-131 (1) of the Utah Condominium Ownership Act and creating units, common areas, limited common areas and convertible space, all as set forth herein.
I also certify that all the lots within WorldMark, The Club at Wolf Creek Village Phase 2 meet the frontage and area requirements of the Weber County Zoning Ordinance.

Signed this 24 day of November, 1999.

Trendwest Resorts, Inc., an Oregon corporation
WorldMark, The Club, a California nonprofit mutual benefit corporation
Alan B. Schriber, Exec. V.P. by David W. Herrick, Vice President
State of Washington
County of King
ACKNOWLEDGMENT

On the 24 day of November, 1999, personally appeared before me, Alan B. Schriber, Executive Vice President of Trendwest Resorts, Inc., an Oregon Corporation, who being by me duly sworn did say that he is the duly authorized officer of said Corporation and that said Corporation by a resolution of its Board of Directors, and he or she acknowledged to me that said Corporation executed the same.
Residing at: ISLAND COUNTY
Commission Expires: 9-21-2003
State of Washington
County of King
Dennis C. Ritchie
Print Name

On the 24 day of November, 1999, personally appeared before me, David W. Herrick, who being by me duly sworn did say that he is the duly authorized officer of WorldMark, The Club, a California non-profit mutual benefit Corporation and that said Corporation by a resolution of its Board of Directors, and he or she acknowledged to me that said Corporation executed the same.
Residing at: ISLAND COUNTY
Commission Expires: 9-29-2003
State of Washington
County of King
Dennis C. Ritchie
Print Name

SURVEYOR'S CERTIFICATE

I, Mark E. Babbitt, a duly Registered Professional Utah Land Surveyor as required by the laws of the State of Utah, holding License No. 166484, do hereby certify that I have surveyed the following described tract of land at the instance of Trendwest Resort's Inc., an Oregon Corporation and WorldMark, The Club, a California nonprofit mutual benefit corporation and is based on information on record at the Weber County Recorder's Office.
A part of the Southwest Quarter of Section 22, Township 7 North, Range 1 East, Salt Lake Base and Meridian, U.S. Survey:
Beginning at the Northwest corner of the record of Survey Map for WorldMark, the Club at Wolf Creek Village Phase 2, a condominium project in Ogden Valley, Weber County, Utah which is 352.79 feet South 0°00'33" West along the Quarter Section line and 287.38 feet North 75°36'42" West from the Center of said Section 22; running South 0°03'32" West 251.21 feet; thence South 67°53'36" East 106.25 feet and Southeasterly along the arc of a 49.14 foot radius curve to the right a distance of 35.20 feet (Central Angle equals 41°02'29" and Long Chord bears South 47°22'20" East 34.45 feet) to the Northwest corner of Wolf Creek Village II, a time share condominium in Ogden Valley, Weber County, Utah; thence (3) courses along the Westernerly and Southwesterly boundary of said phase 2 as follows: thence South 63°08'53" West 204.86 feet along said Northwesterly line; thence North 43°30'00" West a distance of 84.96 feet (Central Angle equals 16°45'24" and Long Chord bears South 57°42'21" West 84.66 feet); thence North 35°52'46" West 125.67 feet; thence North 42°16'04" West 181.60 feet; thence North 34°38'04" West 40.68 feet; thence North 36°50'43" East 35.42 feet; thence North 79°58'16" East 11.10 feet; thence North 30°52'12" East 95.32 feet; thence South 75°36'42" East 457.89 feet to the point of beginning.
Contains 162,033 Square Feet
Or 3.720 Acres

I further certify that the above description correctly describes the perimeter of the surface of the land on which has been or will be constructed "WorldMark, The Club at Wolf Creek Village Phase 2"; that the property corners have been accurately set on the ground and are sufficient to readily retrace or reestablish this survey; that this Record of Survey Map consisting of five (5) sheets was prepared in accordance with the "Utah Condominium Ownership Act" and represents a true and accurate map of the land and buildings thereon to the best of my knowledge and belief.
Signed this 23rd day of November, 1999.
166484 License No.
Mark E. Babbitt
REGISTERED LAND SURVEYOR
UTAH
166484

WEBER COUNTY PLANNING COMMISSION APPROVAL

This is to certify that this plat was duly approved by the Weber County Planning Commission on the _____ day of _____, 1999.
Wayne B. Seiborn
Chair of Weber County Planning Commission

WEBER COUNTY COMMISSION ACCEPTANCE

This is to certify that this condominium plat, the dedication of streets and other public ways and financial guarantee of public improvements associated with this condominium, thereon are hereby approved and accepted by the Commissioners of Weber County, Utah this 7th day of December, 1999.
Jatima Bradford
Deputy
Chair, Weber County Commission

WEBER COUNTY RECORDER


ENTRY NO. 1173925 FEE PAID
RECORDED FOR RECORD AND
RECORDED 10-15-99 AT
11:18 AM BOOK 51 OF OFFICIAL
RECORDS PAGE 16 RECORDED FOR
FIRST AMERICAN TITLE
DORIS CROFTS
WEBER COUNTY RECORDER
BY: [Signature]
DEPUTY

Record of Survey Map


WORLD MARK, THE CLUB AT WOLF CREEK VILLAGE PHASE 2

A Condominium Project


A part of the Southwest 1/4 of Section 22, T7N, R1E, SLB&M, U.S. Survey
Weber County, Utah

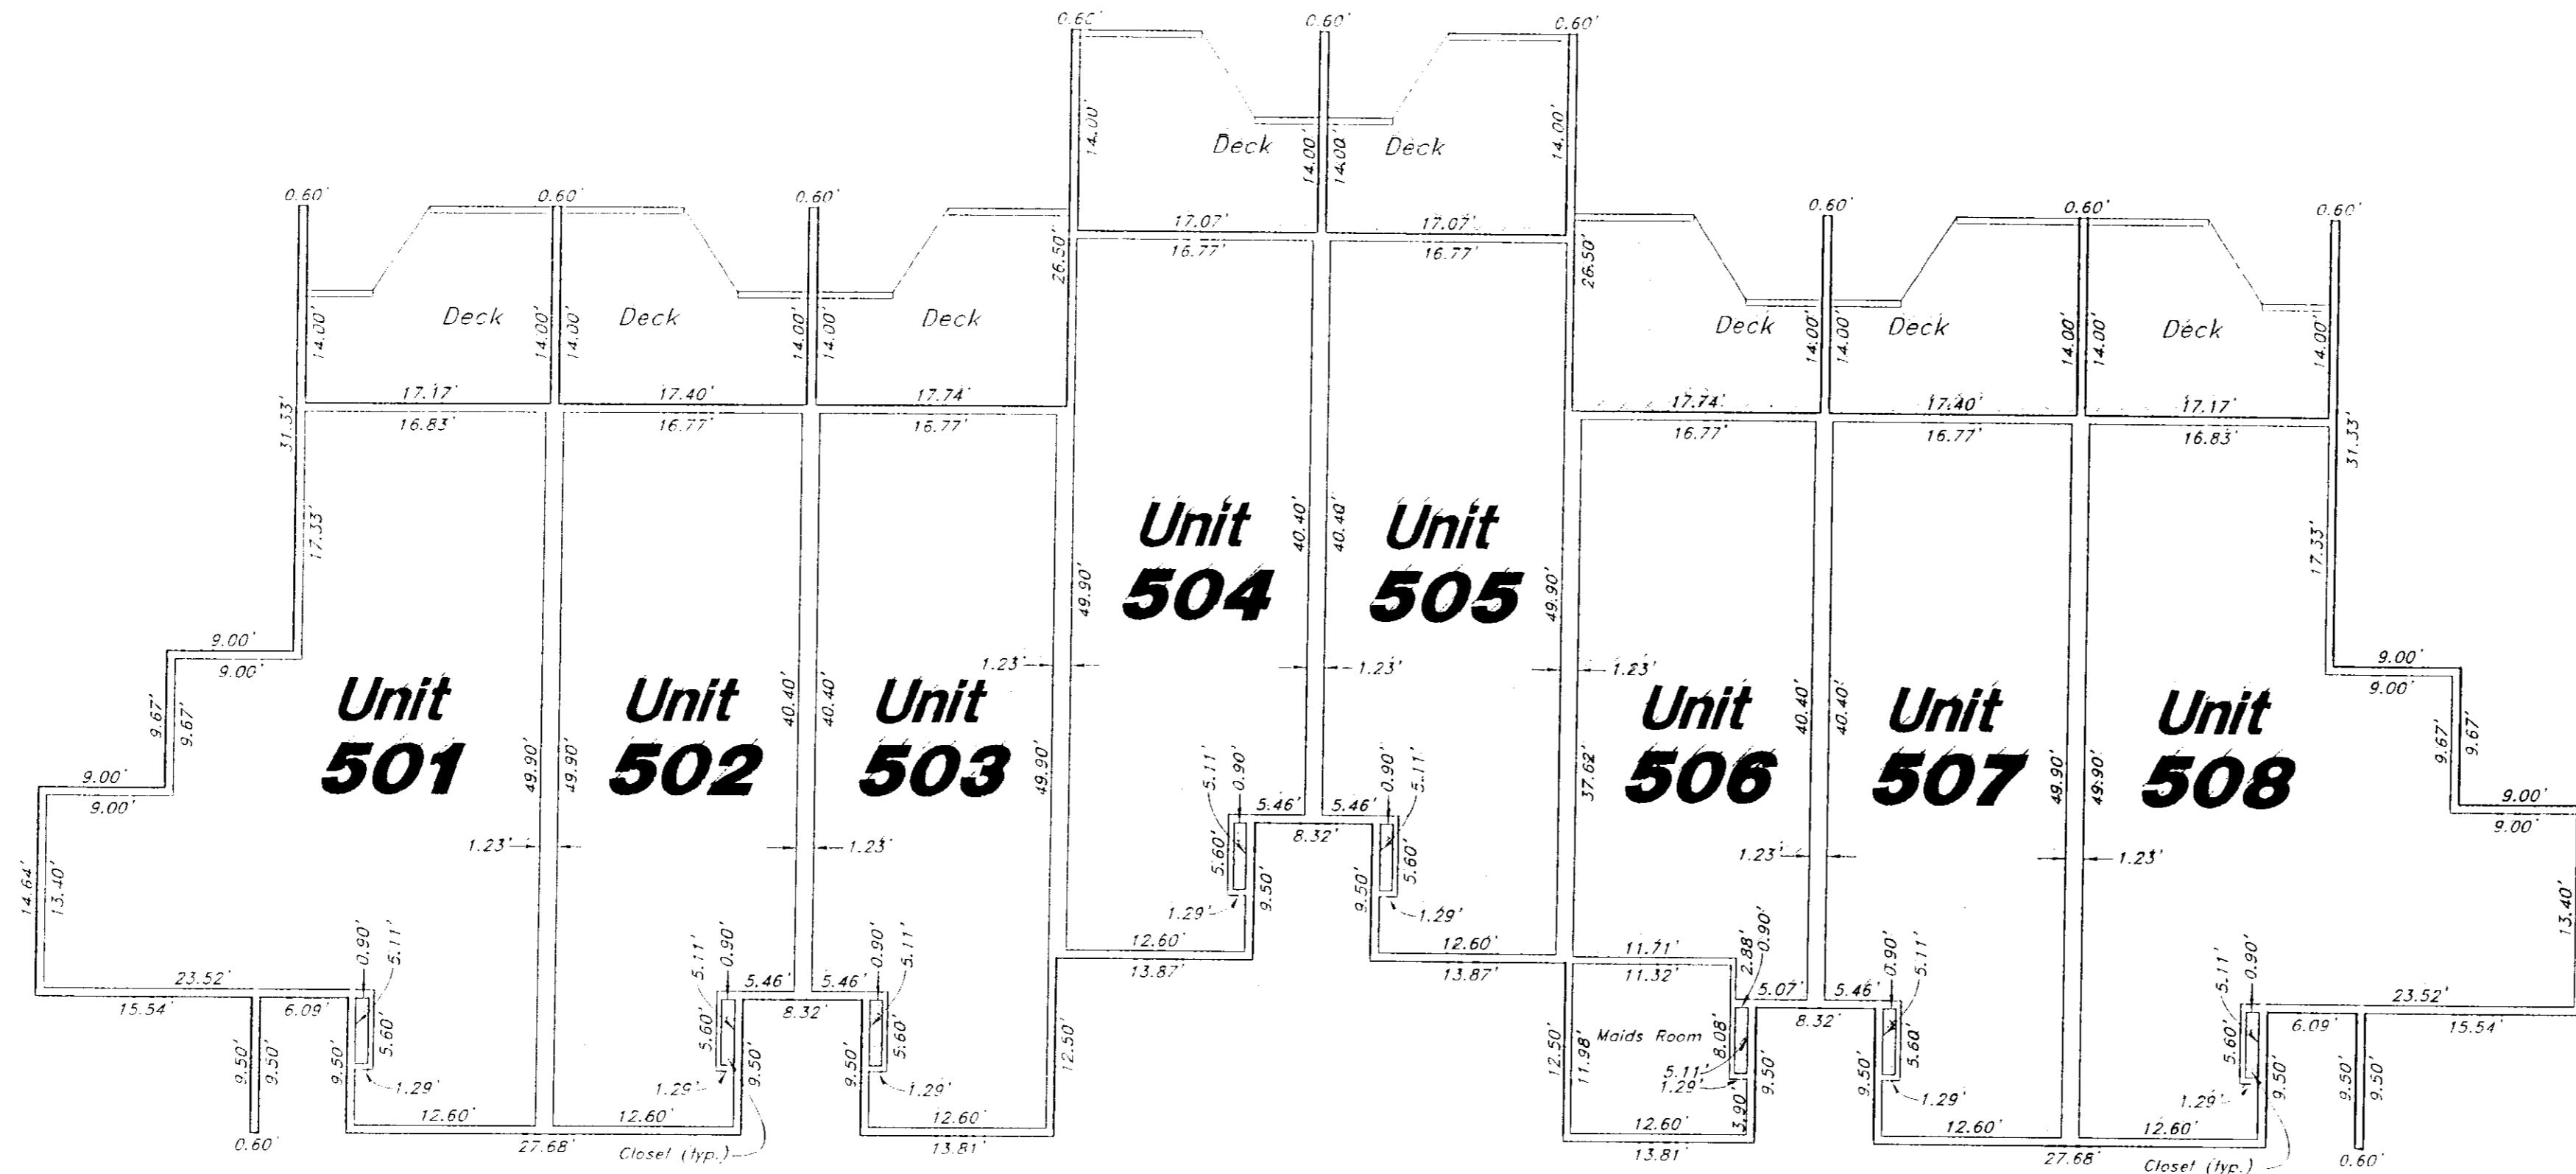


Building 5
Main Level Floor Plan
Scale : 1" = 10'

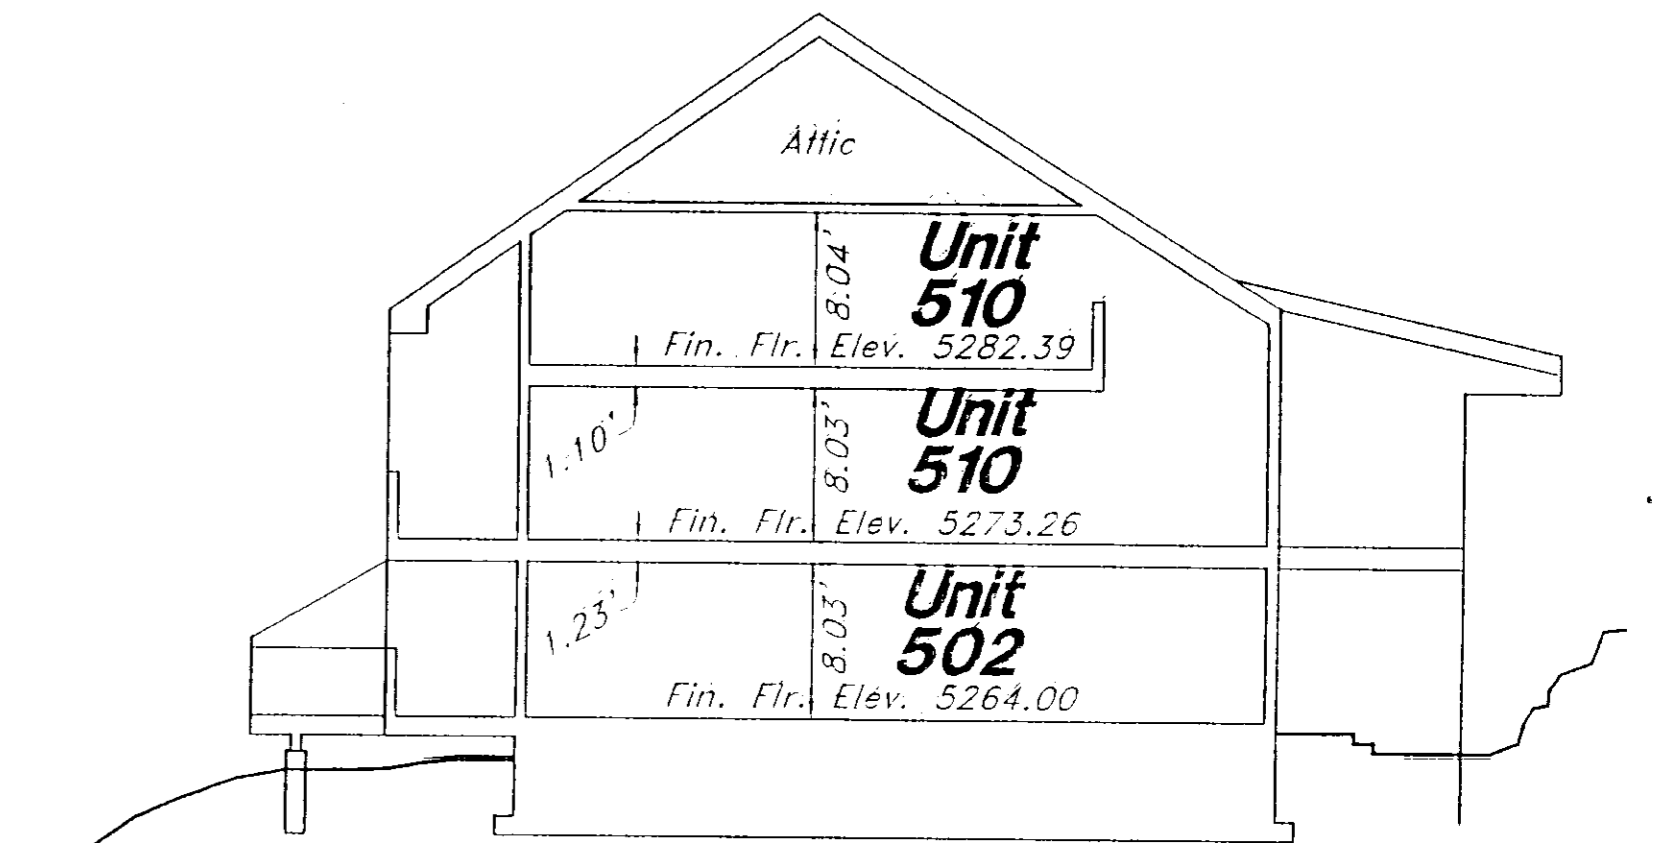

Building 5
Section A-A
Scale : 1" = 10'

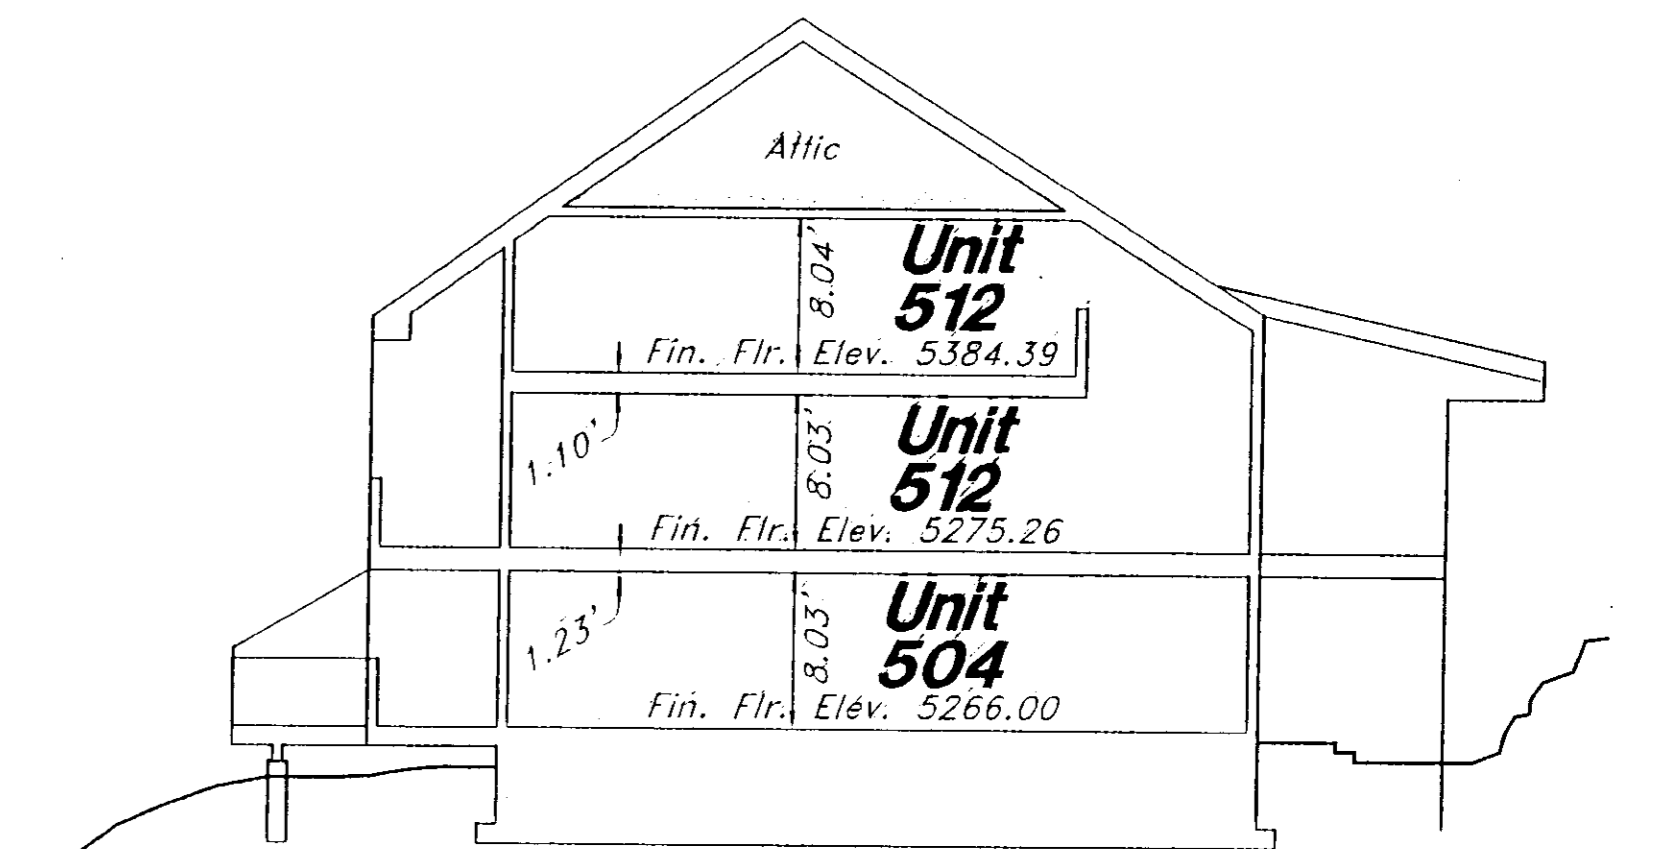

Building 5
Section B-B
Scale : 1" = 10'

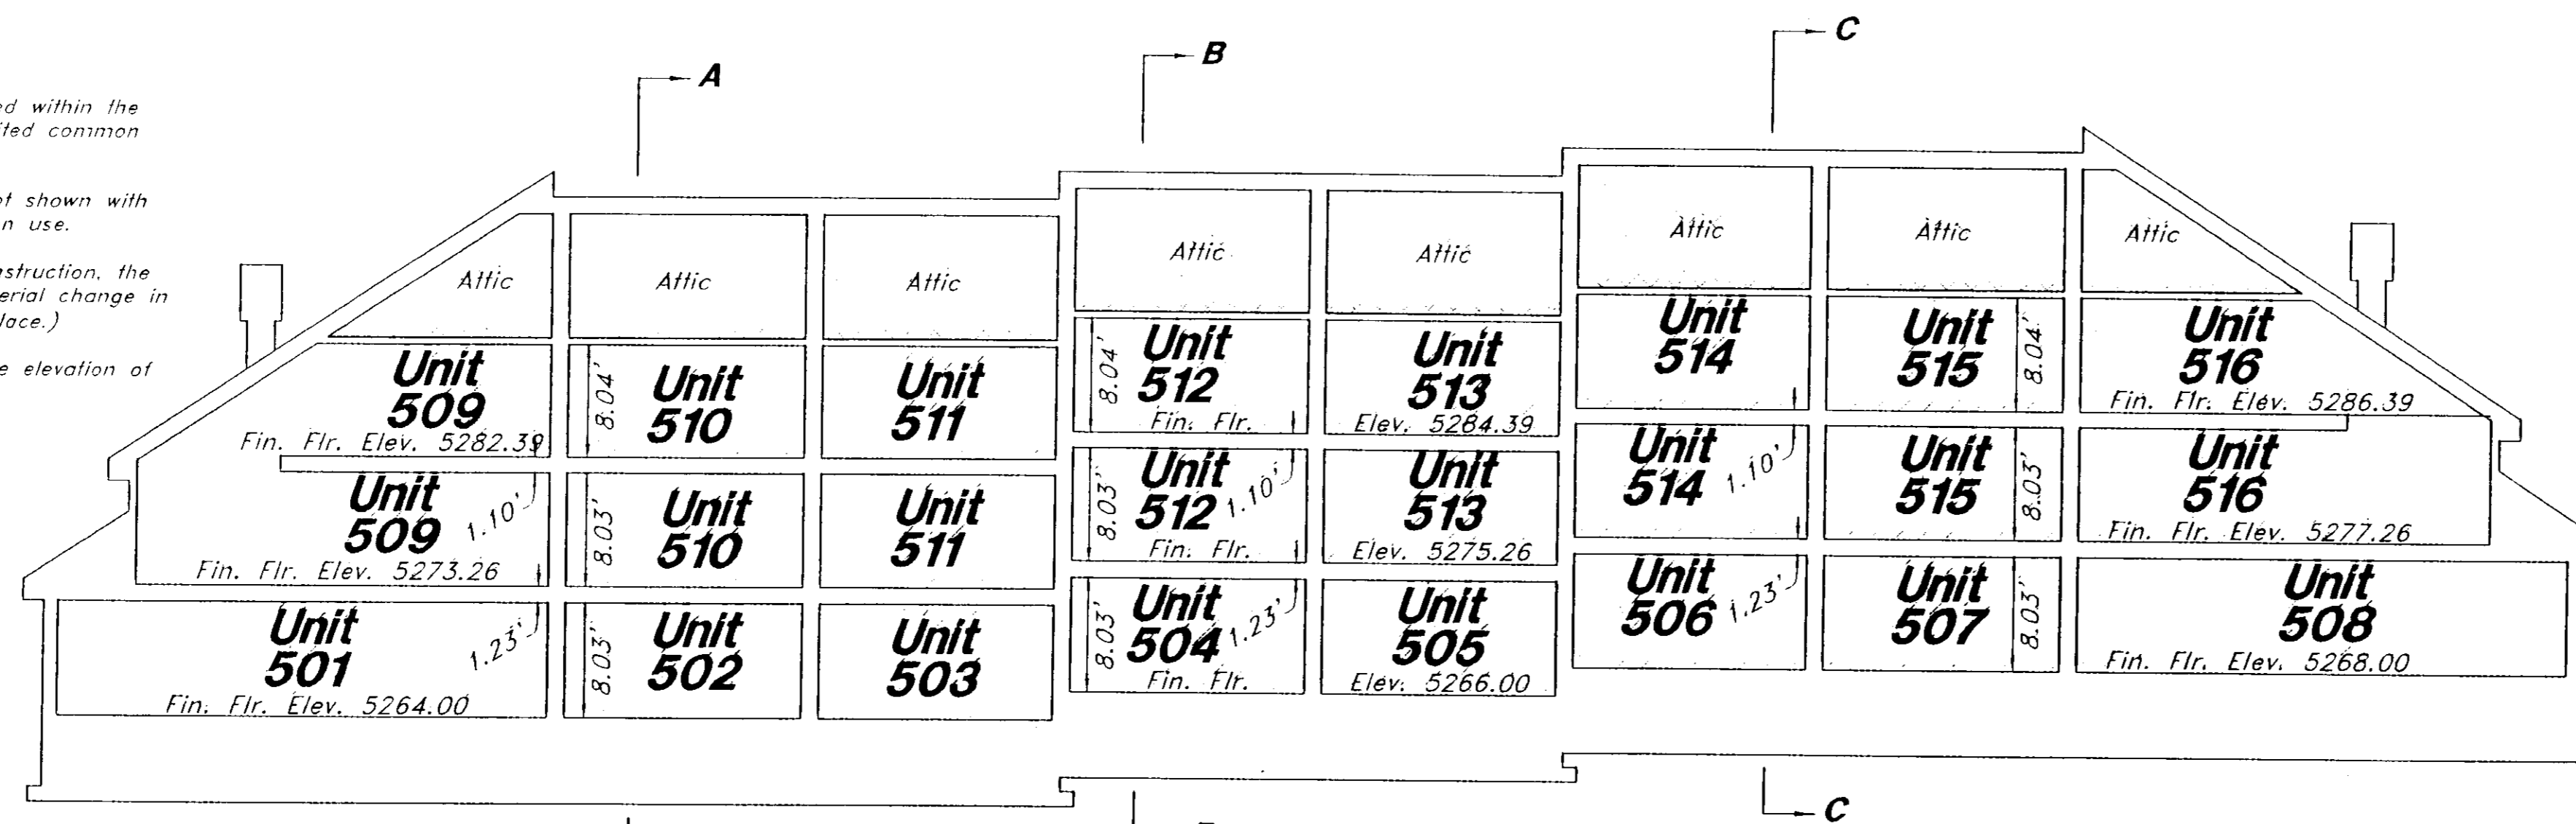


Building 5
Section C-C
Scale : 1" = 10'

Building 5
Section
Scale : 1" = 10'

Notes:

1. Elevations are based on USGS datum Benchmark - Brass Cap at center of Section 22, T7N, R1E, SLB&M = Elev. 5322.59
2. Each condominium unit contained within the project is shown by a diagonal stripe and is designated by a unit number.
Common areas & facilities -
Private ownership -
Limited common area & facilities -
(See sheets 2 through 5)
3. Storage areas, patios, and balcony's or decks contained within the project are shown by cross hatched lines and are limited common use areas.
4. All other areas contained within the project but are not shown with diagonal stripes or cross hatched lines are for common use.
5. This building is not completed. Upon completion of construction, the map may require amendment in the event of any material change in the final location of improvements. (foundation is in place.)
6. The elevation of all structures shall be greater than the elevation of any adjacent flood plain.

GREAT BASIN ENGINEERING NORTH
CONSULTING ENGINEERS and SURVEYORS
3544 Lincoln Avenue, Ogden, Utah, 84401
P.O. Box 9307, Ogden, Utah, 84409
Ogden (801)394-4515 Salt Lake City (801)521-0222 Fax (801)392-7544

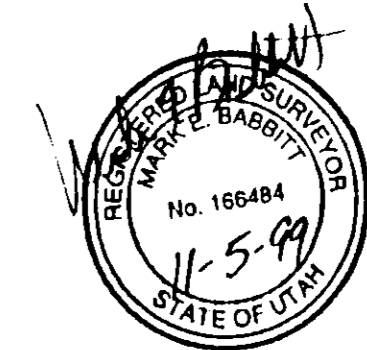

003049


WEBER COUNTY RECORDER
ENTRY NO. 101815 FEE PAID
\$ 182.00 FILED FOR RECORD AND
RECORDED 10 DEC 99 AT
11:18 AM IN BOOK 91 OF OFFICIAL
RECORDS, PAGE 11 RECORDED
FOR FIRST AMERICAN TITLE
DUKE CROFTS
WEBER COUNTY RECORDER
BY: Carrie Warner DEPUTY

Record of Survey Map


WORLD MARK, THE CLUB AT WOLF CREEK VILLAGE PHASE 2

A Condominium Project

A part of the Southwest 1/4 of Section 22, T7N, R1E, SLB&M, U.S. Survey
Weber County, Utah

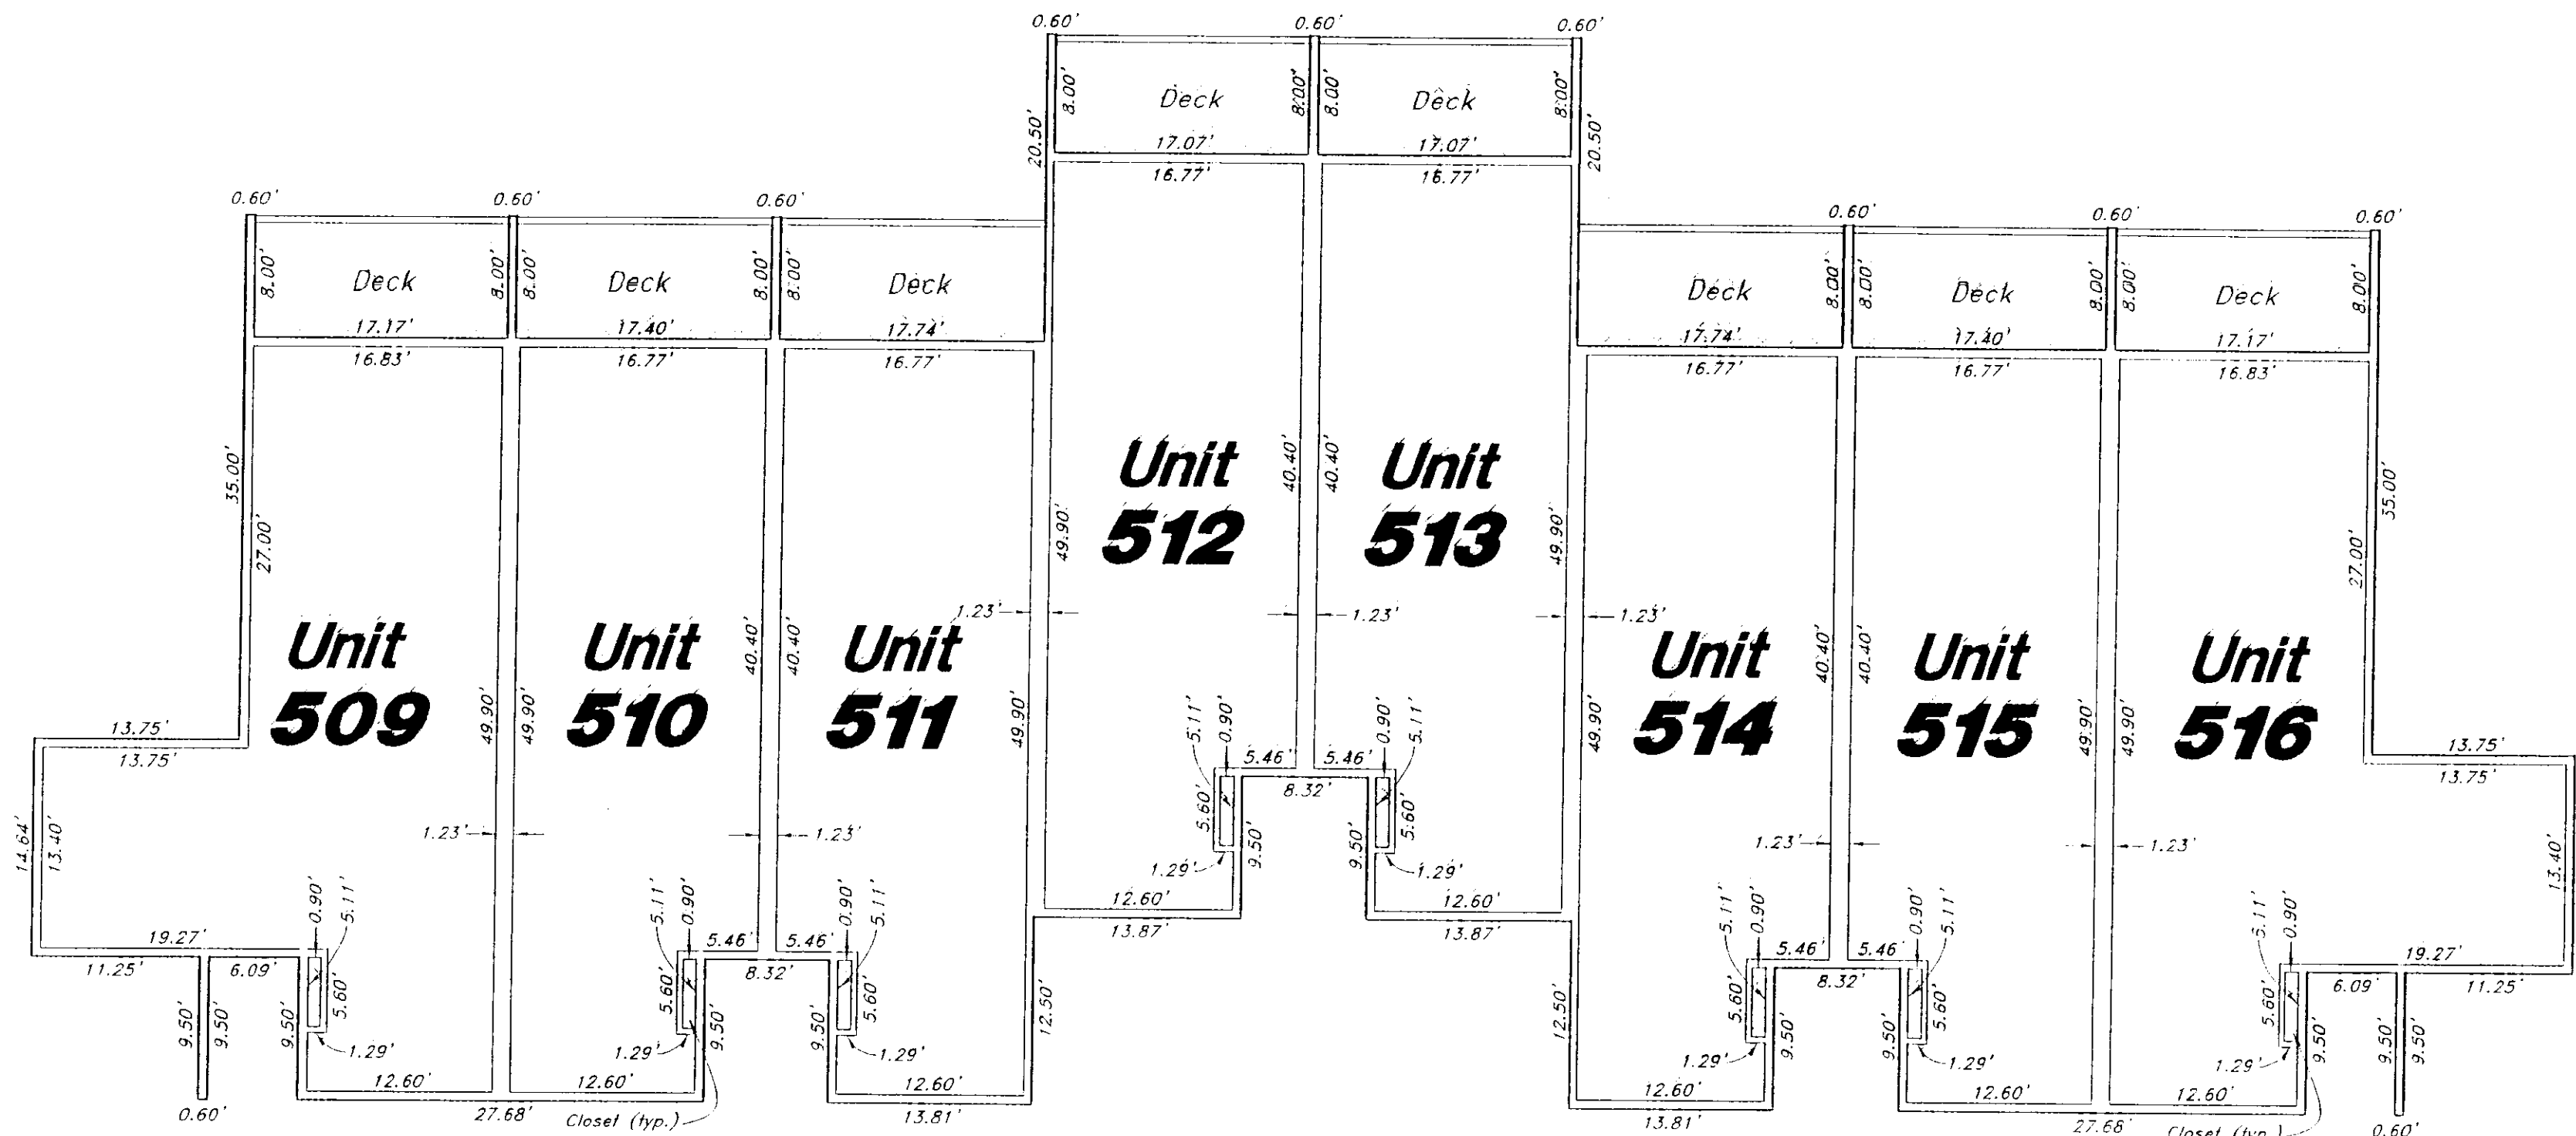

Building 5
Upper Level Floor Plan
Scale: 1" = 10'

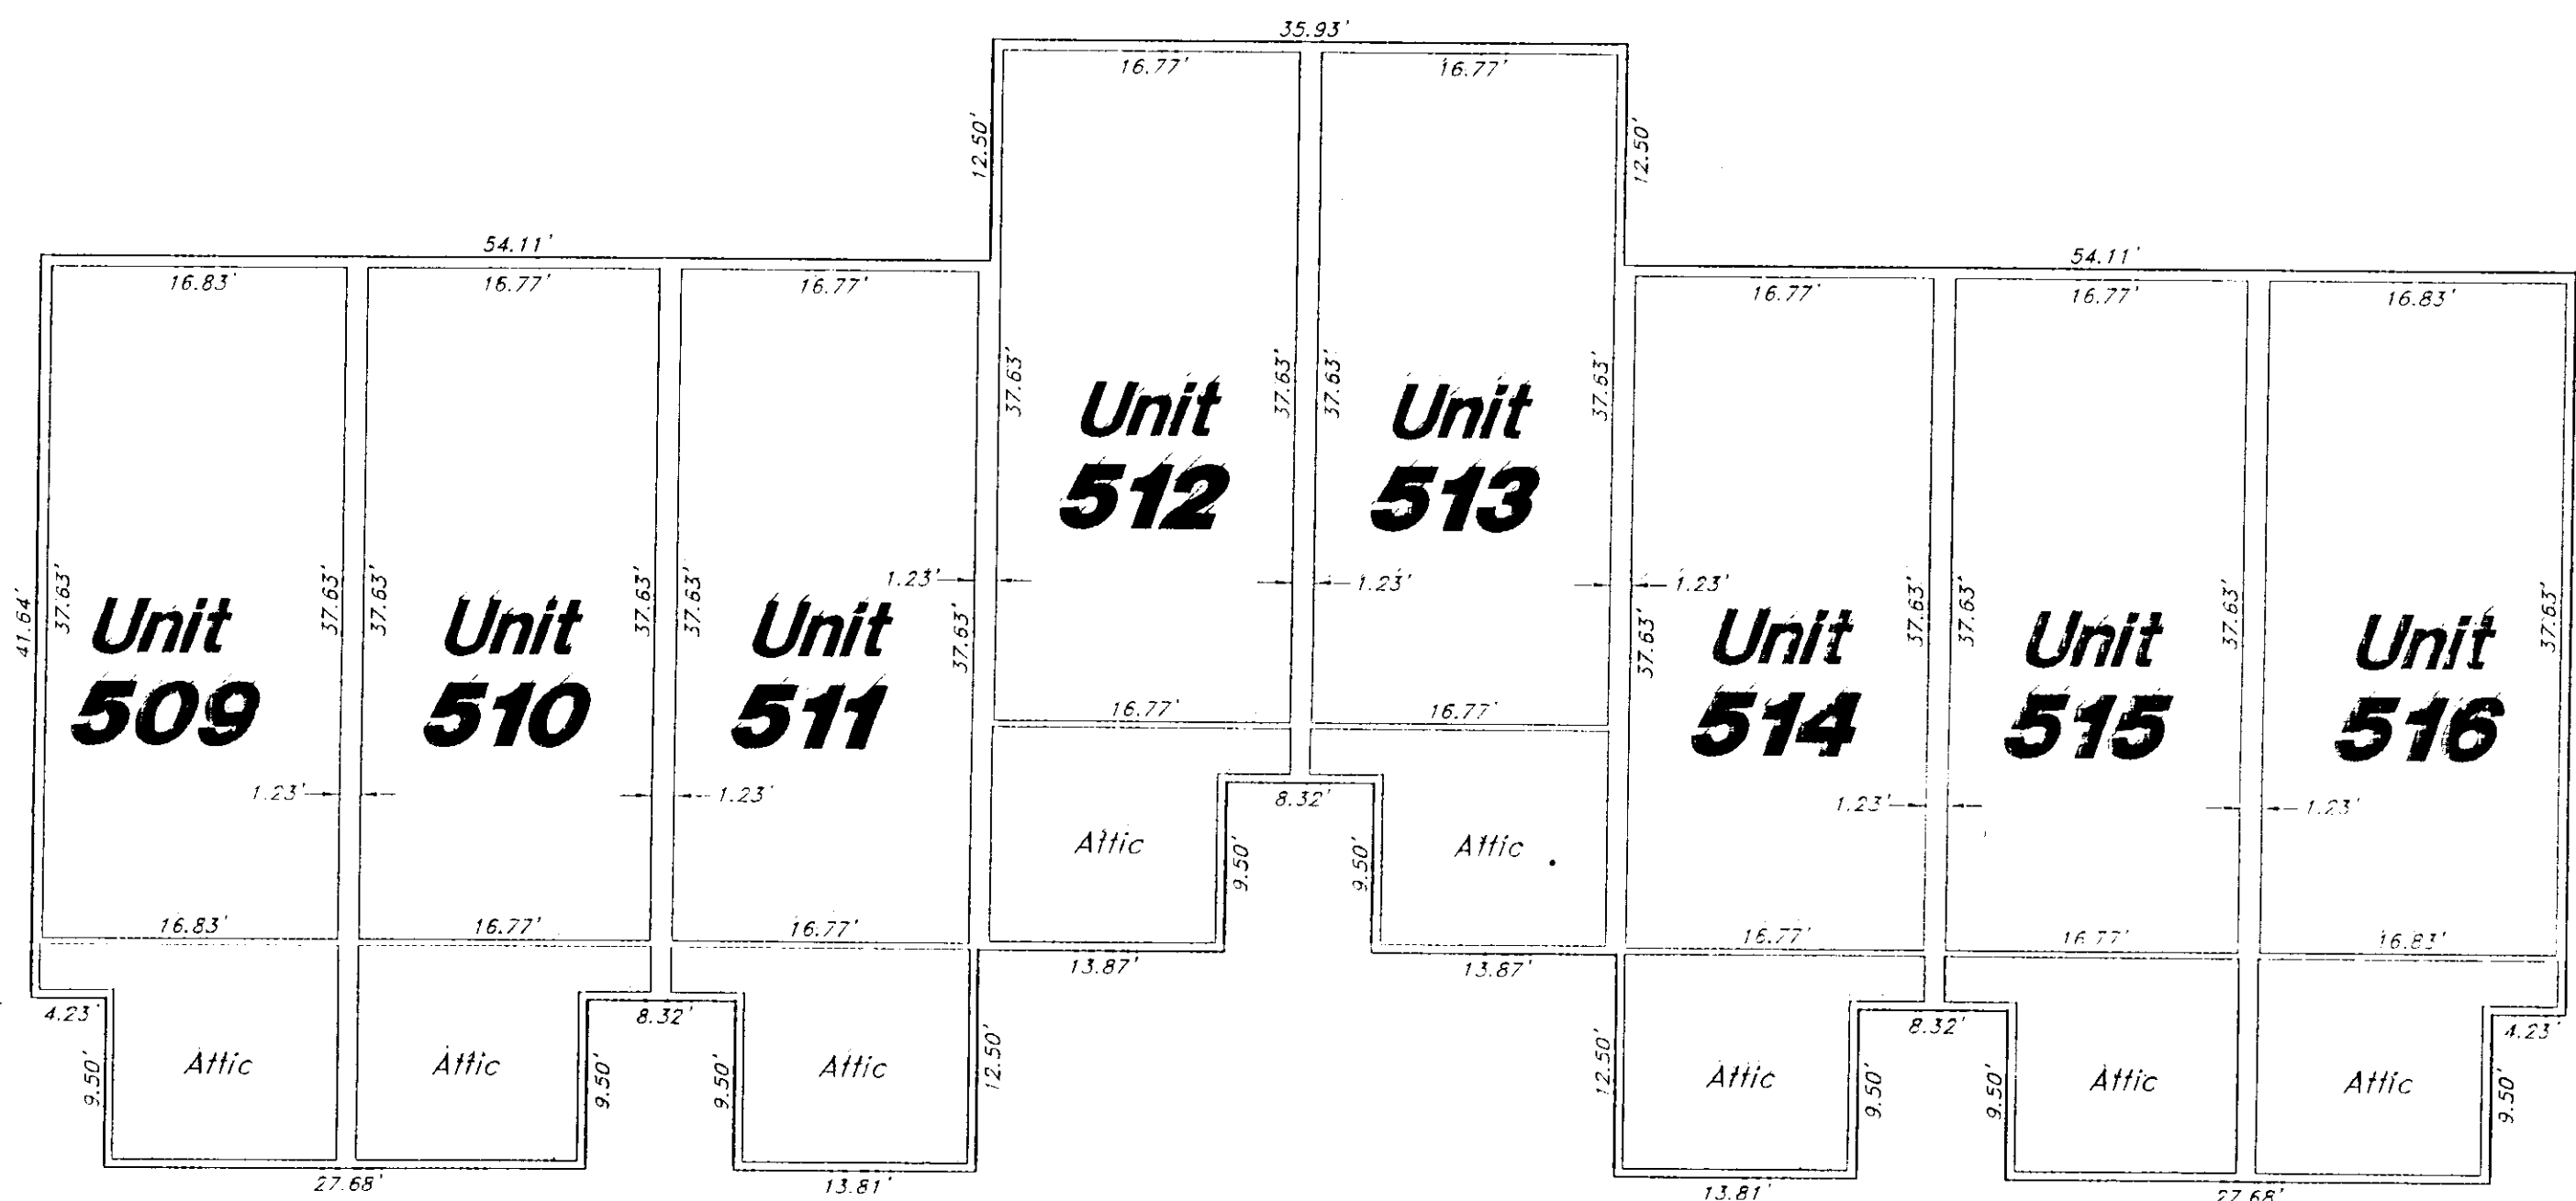


Building 5
Loft Floor Plan
Scale: 1" = 10'

Notes:

- Elevations are based on USGS datum Benchmark - Brass Cap at center of Section 22, T7N, R1E, SLB&M = Elev. 5322.59
- Each condominium unit contained within the project is shown by a diagonal stripe and is designated by a unit number.
Common areas & facilities -
Private ownership -
Limited common area & facilities -
(See sheets 2 through 5)
- Storage areas, patios, and balcony's or decks contained within the project are shown by cross hatched lines and are limited common use areas.
- All other areas contained within the project but are not shown with diagonal stripes or cross hatched lines are for common use.
- This building is not completed. Upon completion of construction, the map may require amendment in the event of any material change in the final location of improvements. (foundation is in place.)
- The elevation of all structures shall be greater than the elevation of any adjacent flood plain.

003049

GREAT BASIN ENGINEERING NORTH
CONSULTING ENGINEERS and SURVEYORS
3544 Lincoln Avenue, Ogden, Utah, 84401
P.O. Box 9307, Ogden, Utah, 84409
Ogden (801)394-4515 Salt Lake City (801)521-0222 Fax (801)392-7544

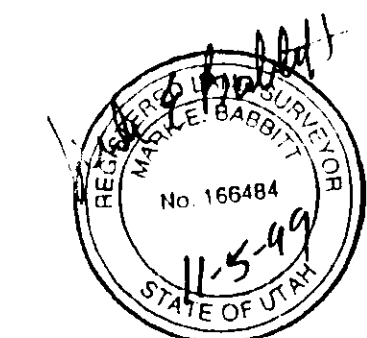


WEBER COUNTY RECORDER
ENTRY NO. 11718925 FEE PAID
\$ 182.00 FILED FOR RECORD AND
RECORDED 10 DEC 99 AT
14:16 PM IN BOOK OF OFFICIAL
RECORDS PAGE 18 RECORDED
FOR FIRST AMERICAN
Dale Crafts
WEBER COUNTY RECORDER
BY: *Debra Warner*
DEPUTY

Record of Survey Map

WORLD MARK, THE CLUB AT WOLF CREEK VILLAGE PHASE 2

A Condominium Project

A part of the Southwest 1/4 of Section 22, T7N, R1E, SLB&M, U.S. Survey
Weber County, Utah

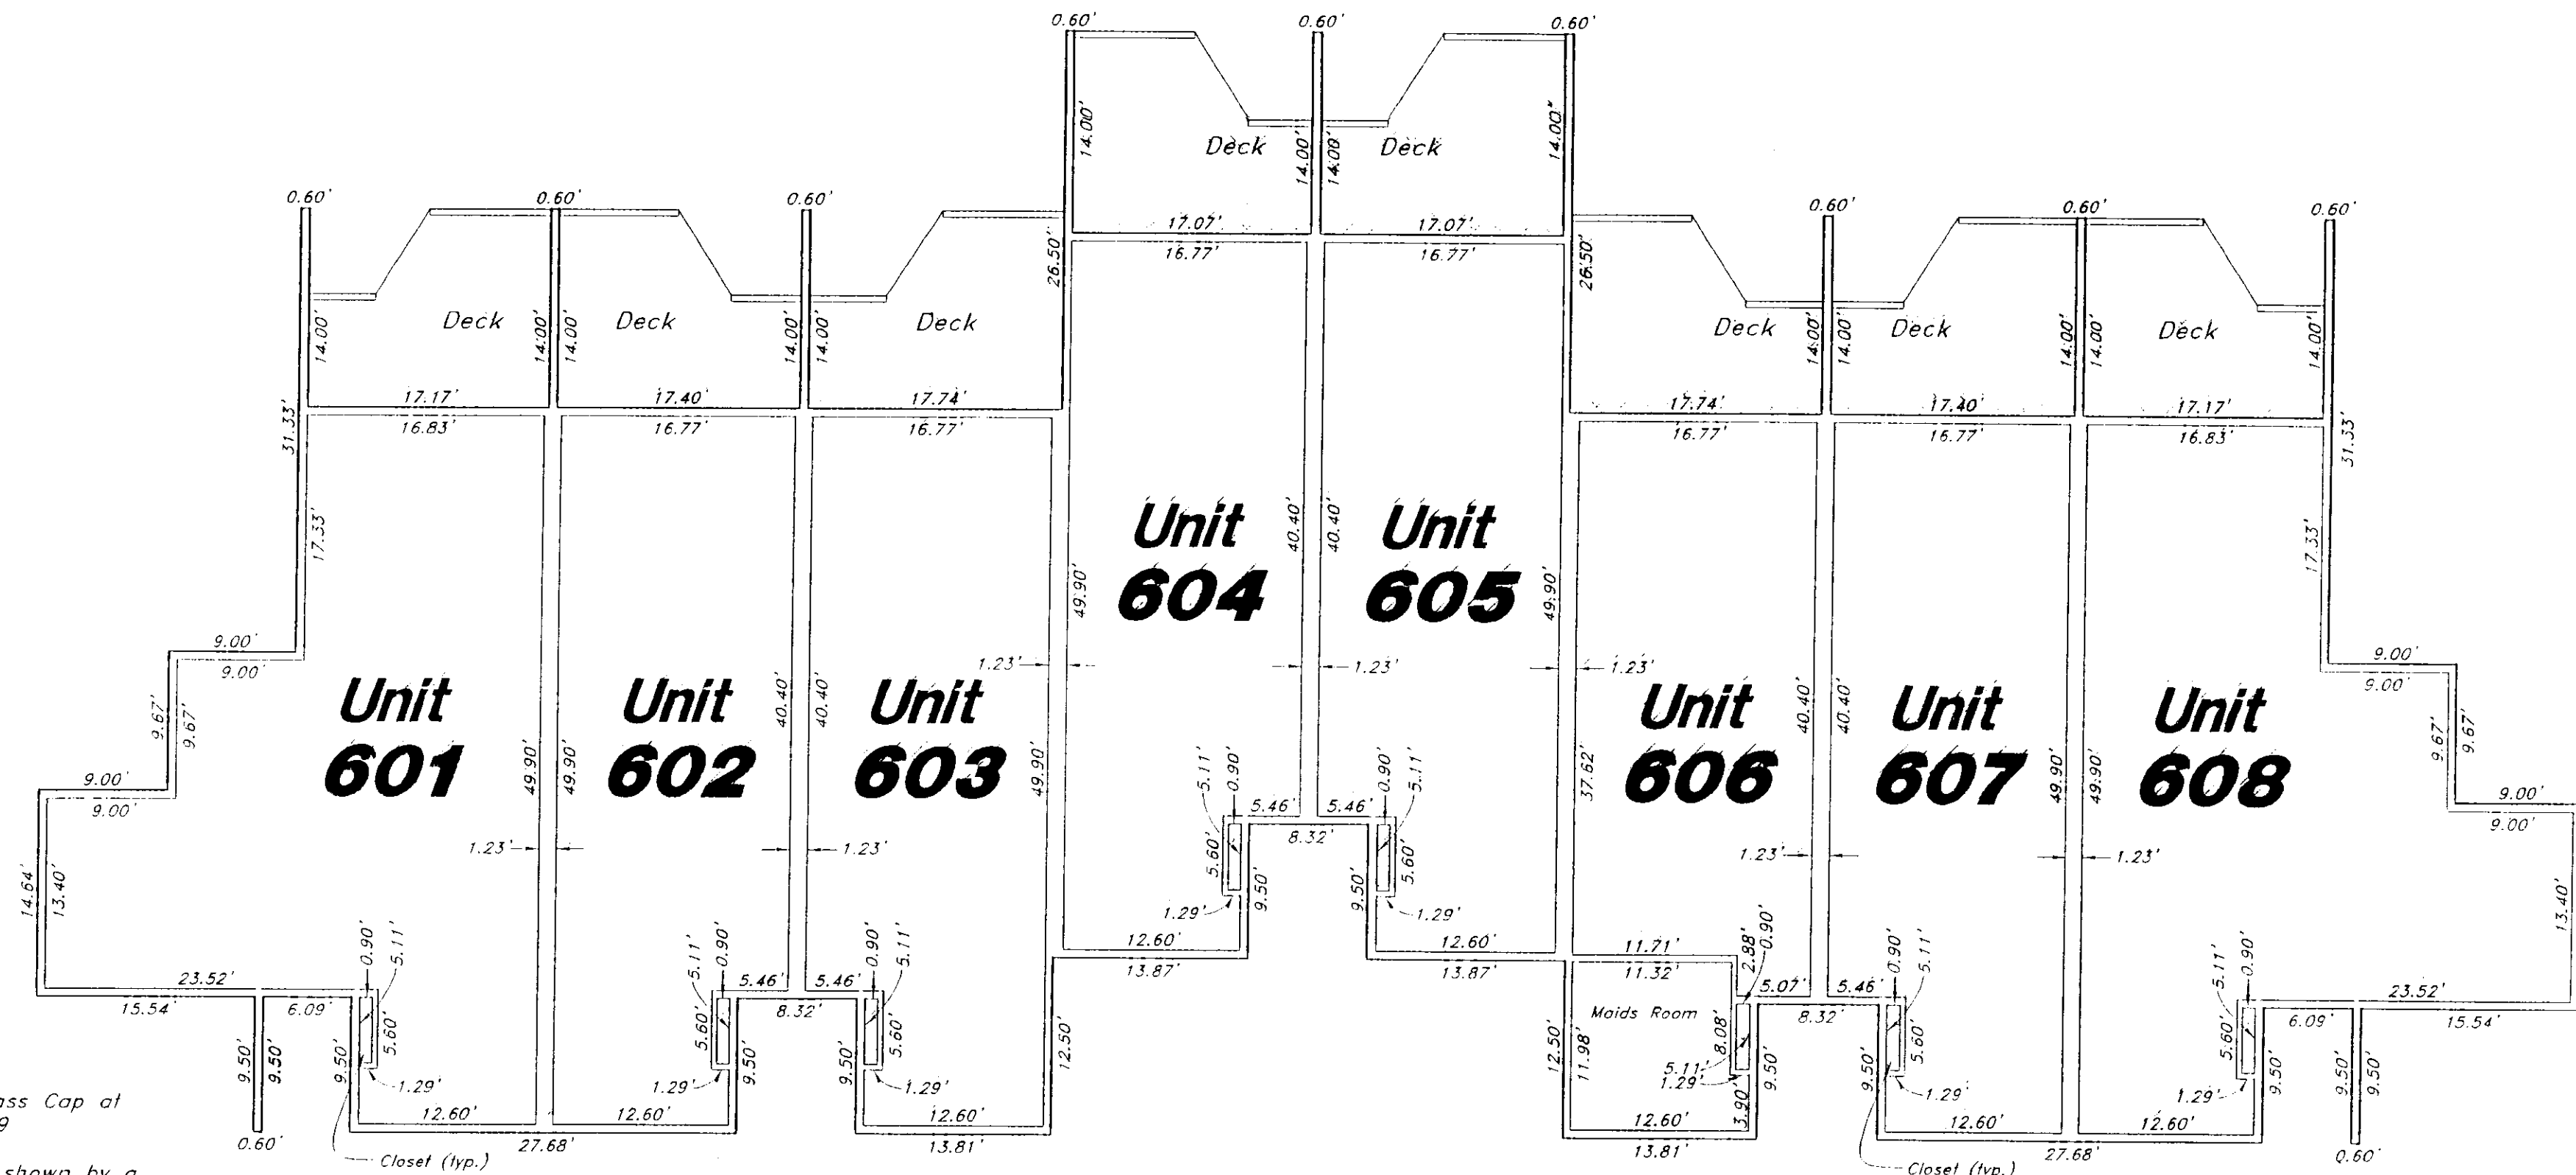

Building 6
Main Level Floor Plan
Scale : 1" = 10'

Notes:

1. Elevations are based on USGS datum Benchmark - Brass Cap at center of Section 22, T7N, R1E, SLB&M = Elev. 5322.59
2. Each condominium unit contained within the project is shown by a diagonal stripe and is designated by a unit number.

Common areas & facilities -

Private ownership -

Limited common area & facilities -


(See sheets 2 through 5)

3. Storage areas, patios, and balcony's or decks contained within the project are shown by cross hatched lines and are limited common use areas.


4. All other areas contained within the project but are not shown with diagonal stripes or cross hatched lines are for common use.

5. This building is not completed. Upon completion of construction, the map may require amendment in the event of any material change in the final location of improvements. (foundation is in place.)


6. The elevation of all structures shall be greater than the elevation of any adjacent flood plain.

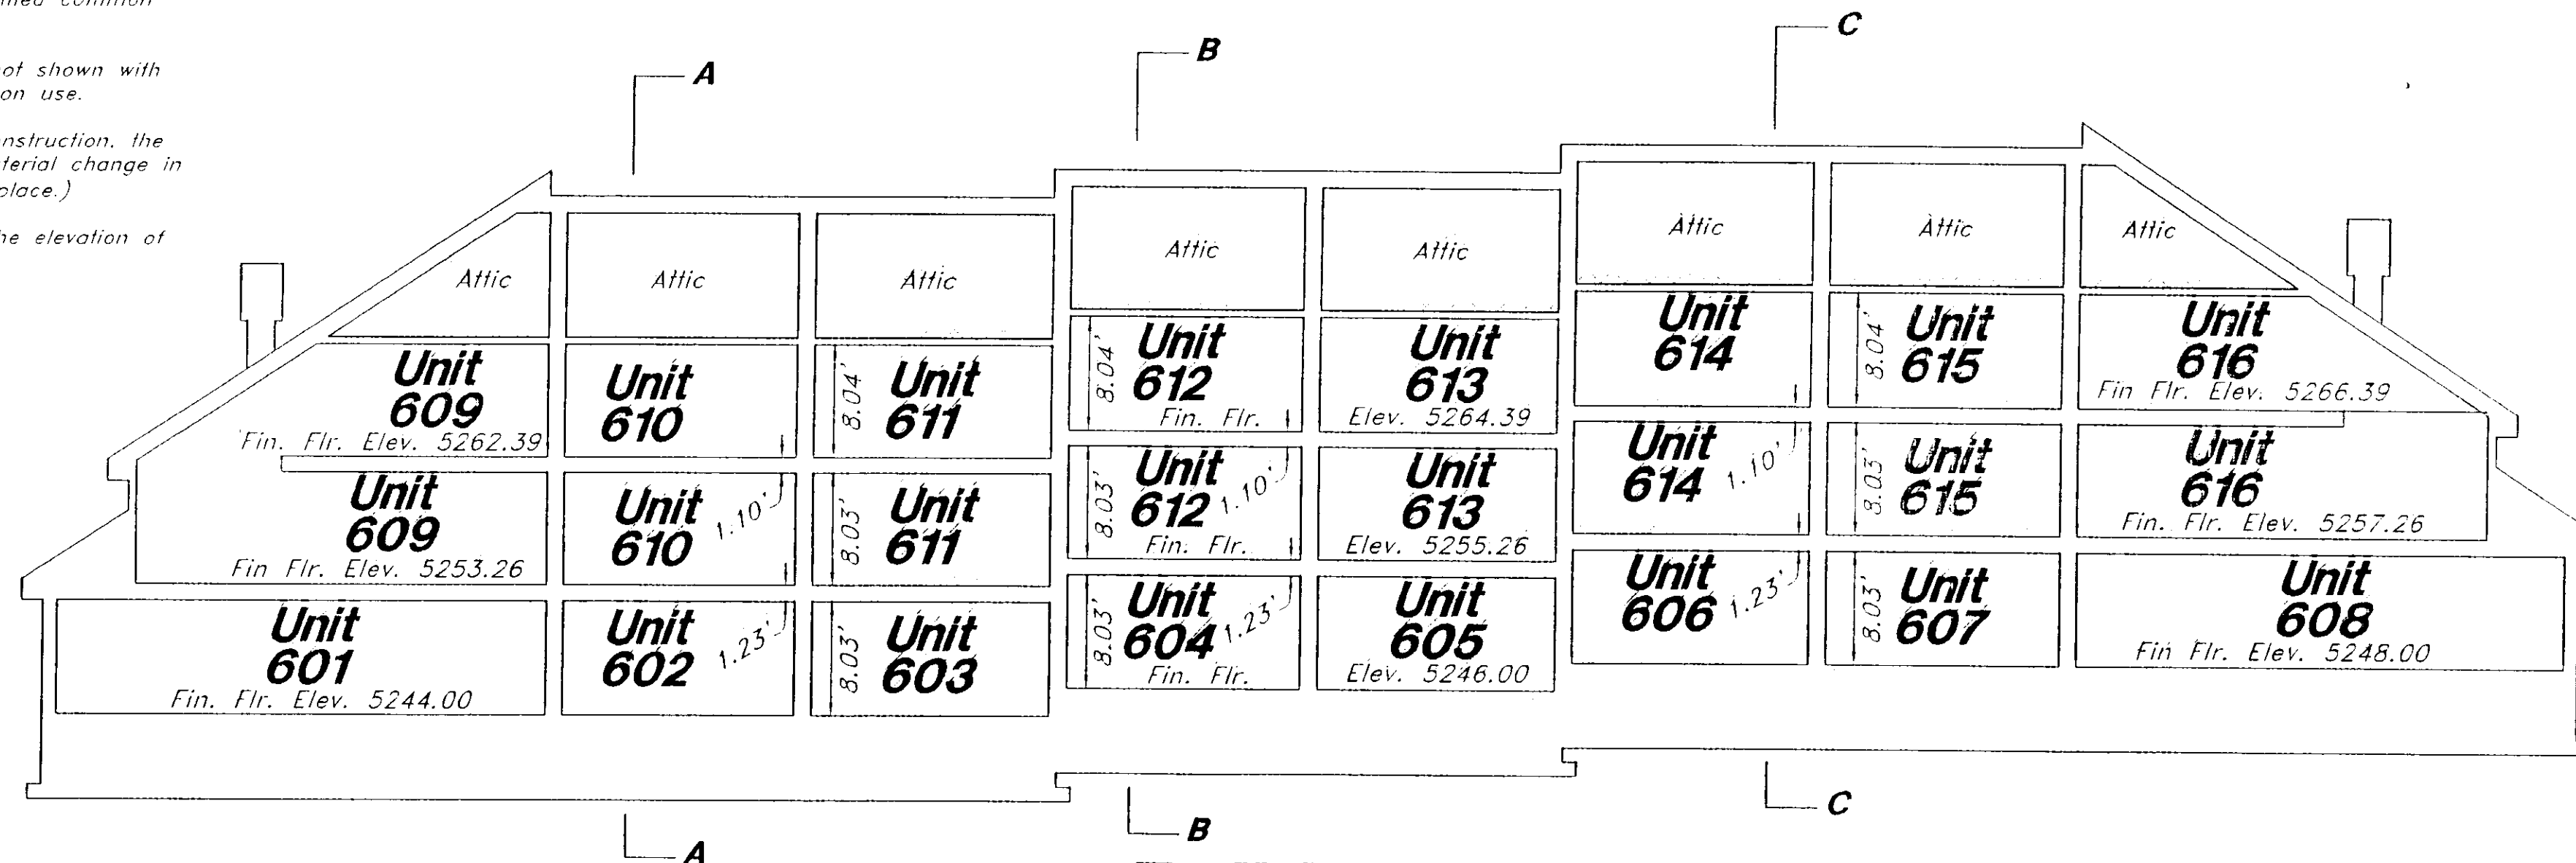


Building 6
Section
Scale : 1" = 10'

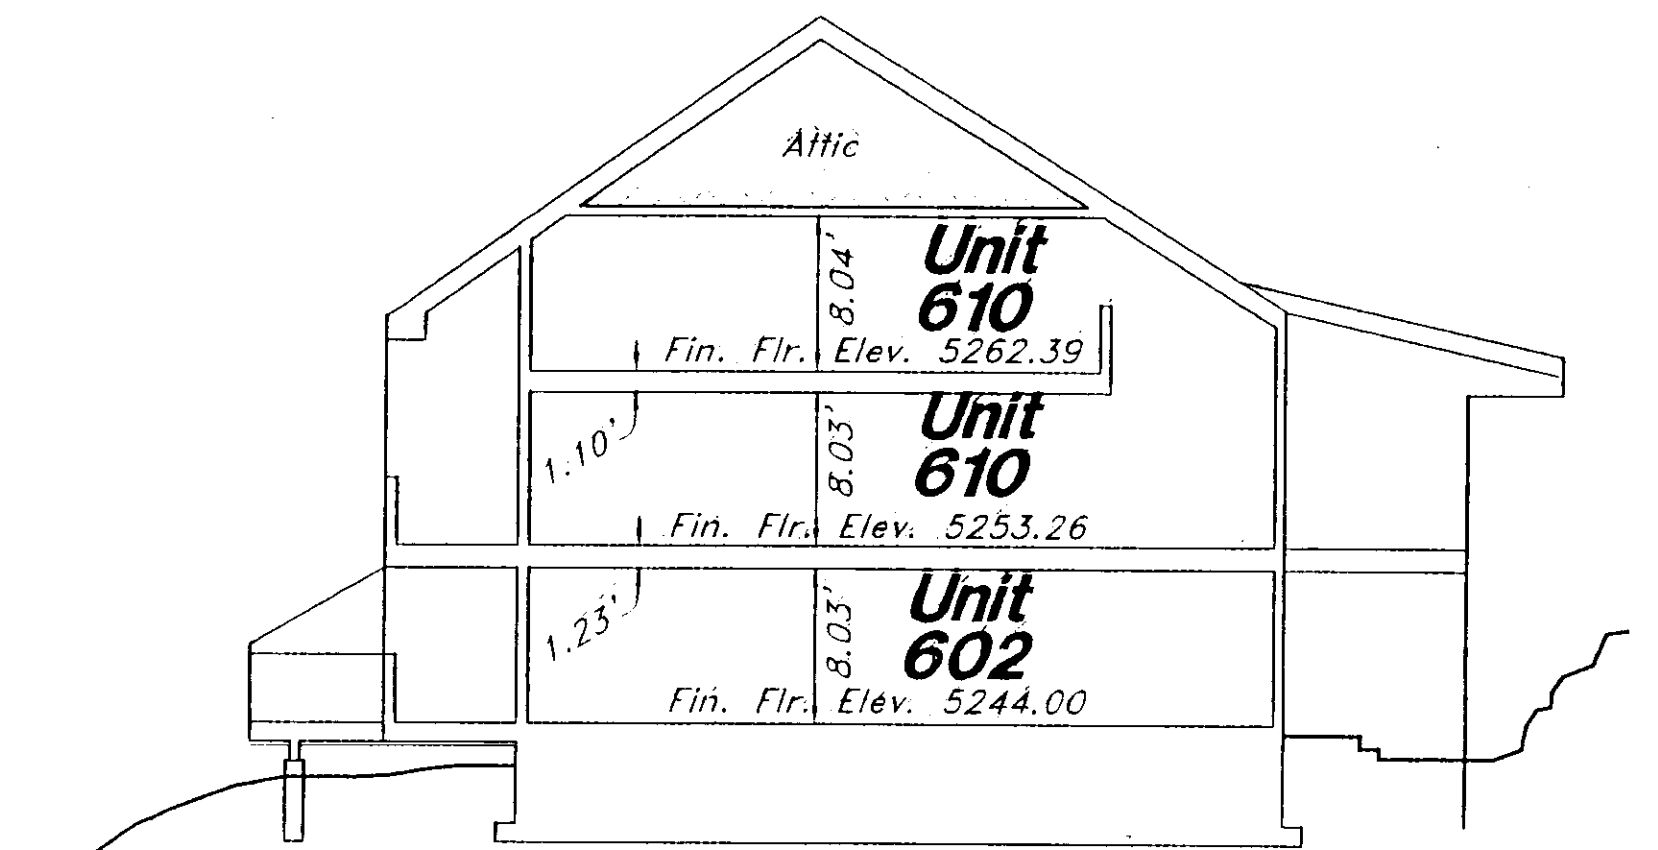

Building 6
Section A-A
Scale : 1" = 10'

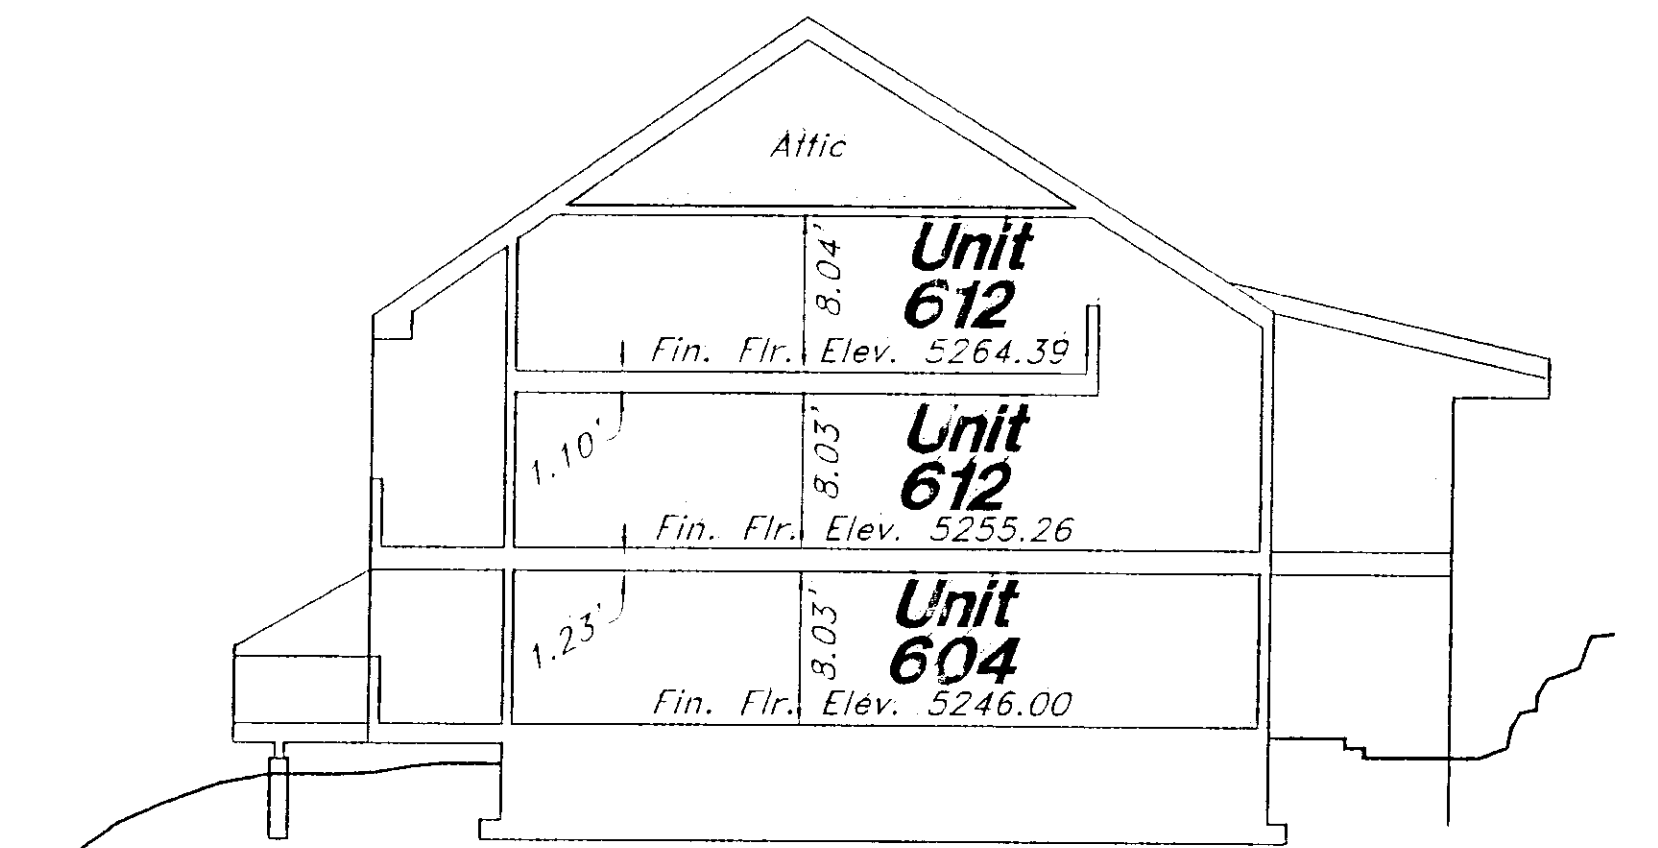


Building 6
Section B-B
Scale : 1" = 10'

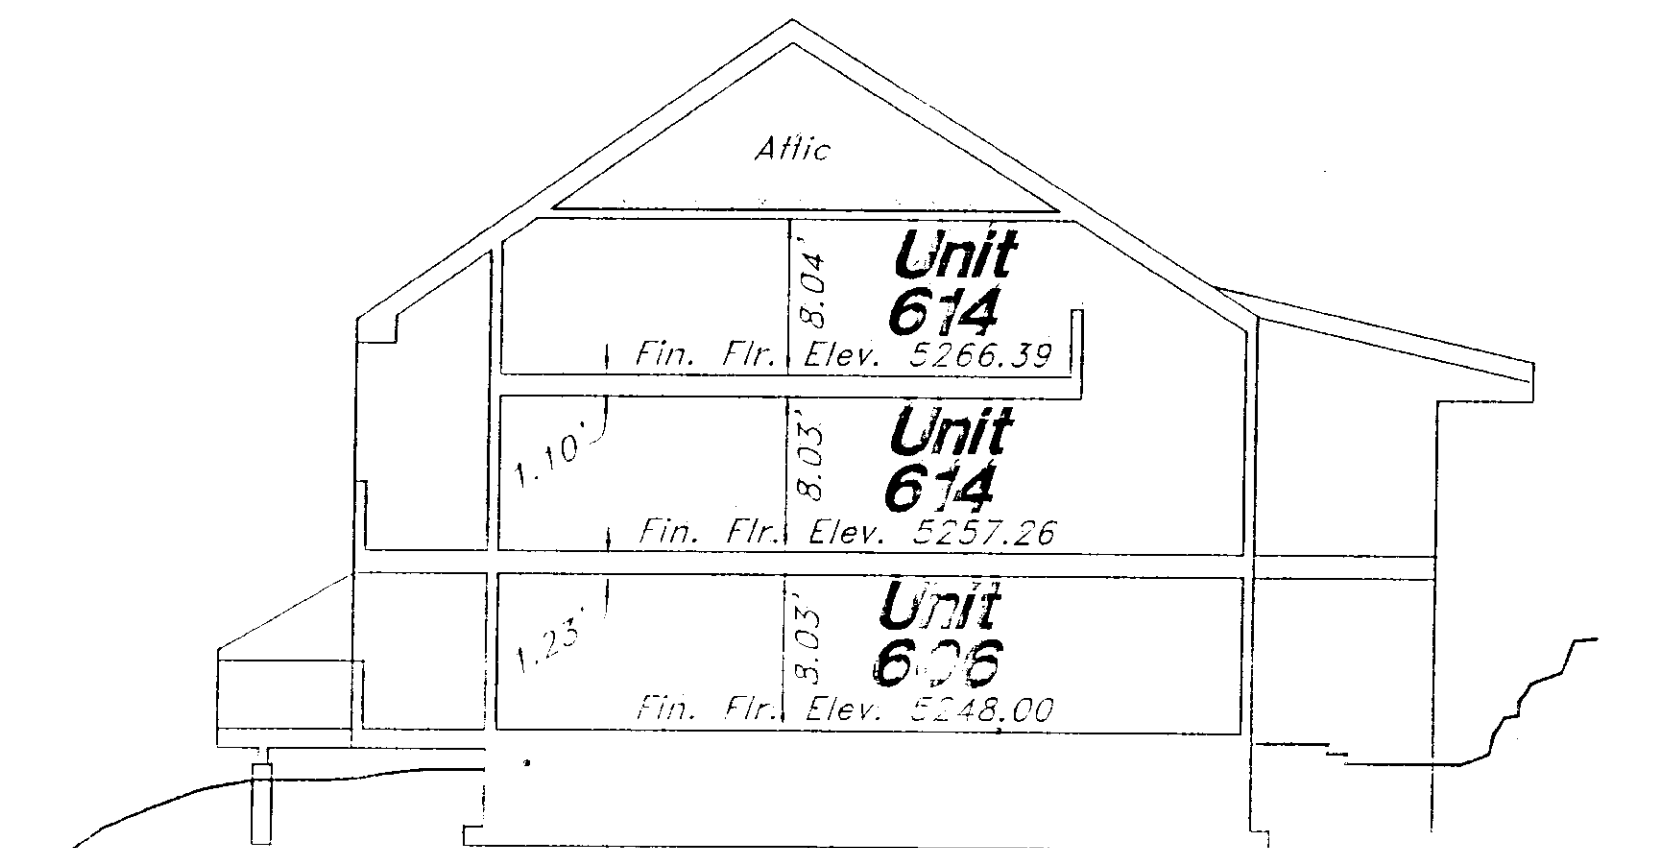

Building 6
Section C-C
Scale : 1" = 10'

GREAT BASIN ENGINEERING NORTH
CONSULTING ENGINEERS AND SURVEYORS
3544 Lincoln Avenue, Ogden, Utah, 84401
P.O. Box 9307, Ogden, Utah, 84409
Ogden (801)304-4516 Salt Lake City (801)521-0222 Fax (801)392-7544

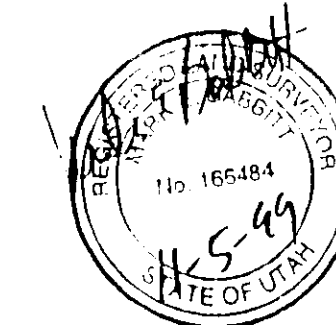


WEBER COUNTY RECORDER
ENTRY NO. 118915 FEE PAID
\$182.00 FILED FOR RECORD AND
RECORDED 18 DEC 99 AT
4:16 PM IN BOOK 51 OF OFFICIAL
RECORDS PAGE 11 RECORDED
FOR FIRST AMERICAN TITLE
DANIEL CRAILS
WEBER COUNTY RECORDER
BY: Carrie Warner
DEPUTY

Record of Survey Map


WORLD MARK, THE CLUB AT WOLF CREEK VILLAGE PHASE 2

A Condominium Project

A part of the Southwest 1/4 of Section 22, T7N, R1E, SLB&M, U.S. Survey
Weber County, Utah


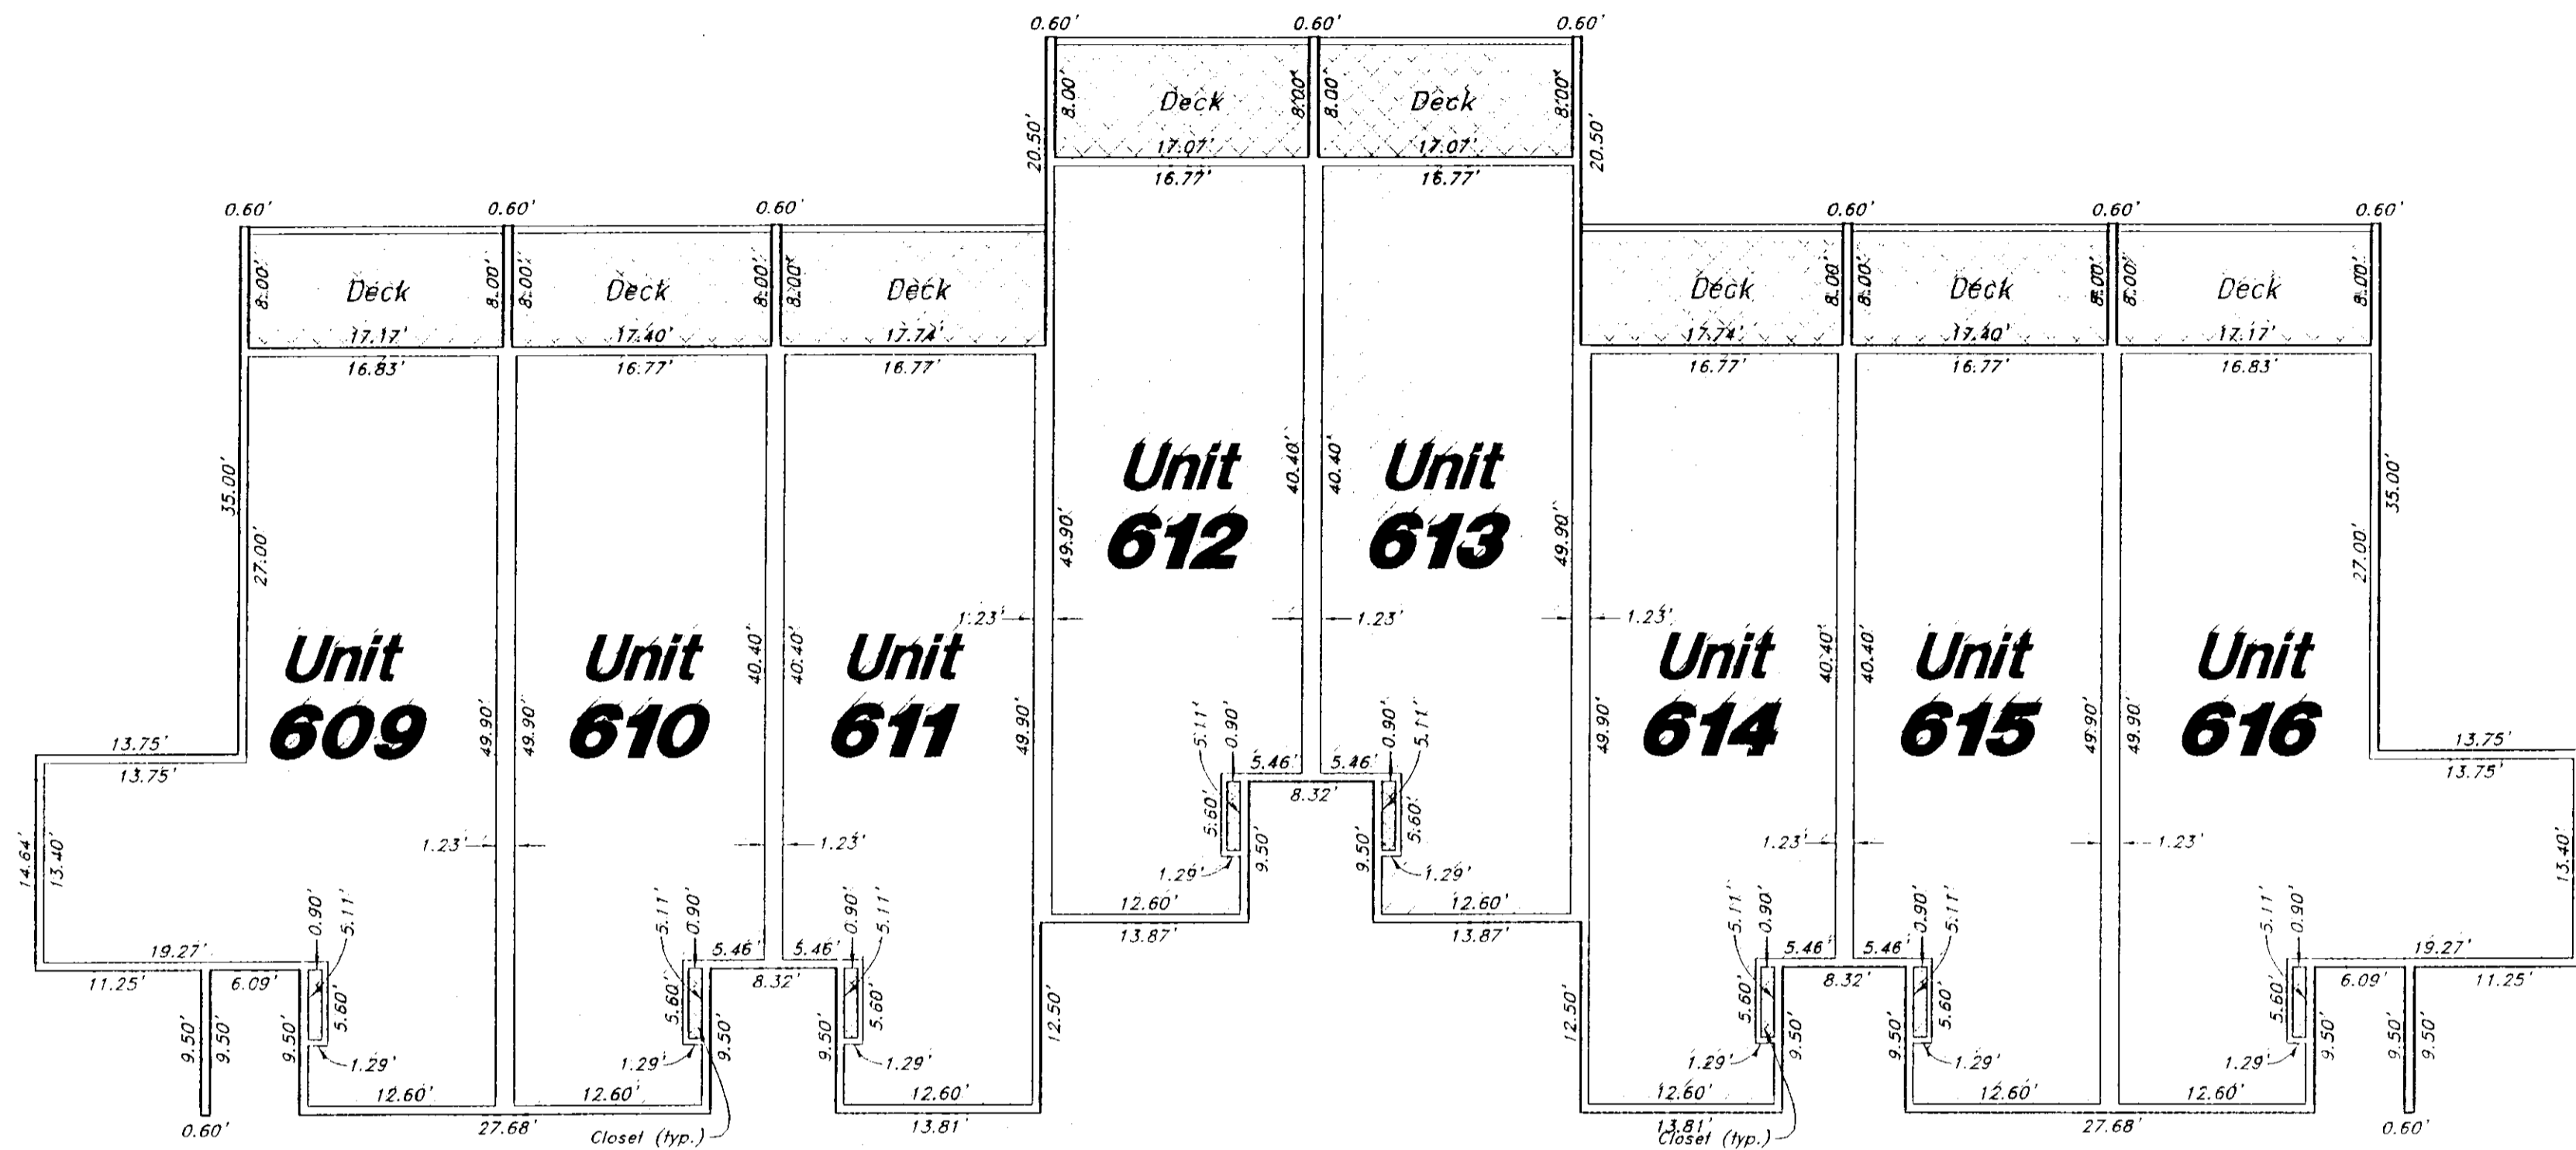



Building 6
Upper Level Floor Plan
Scale : 1" = 10'

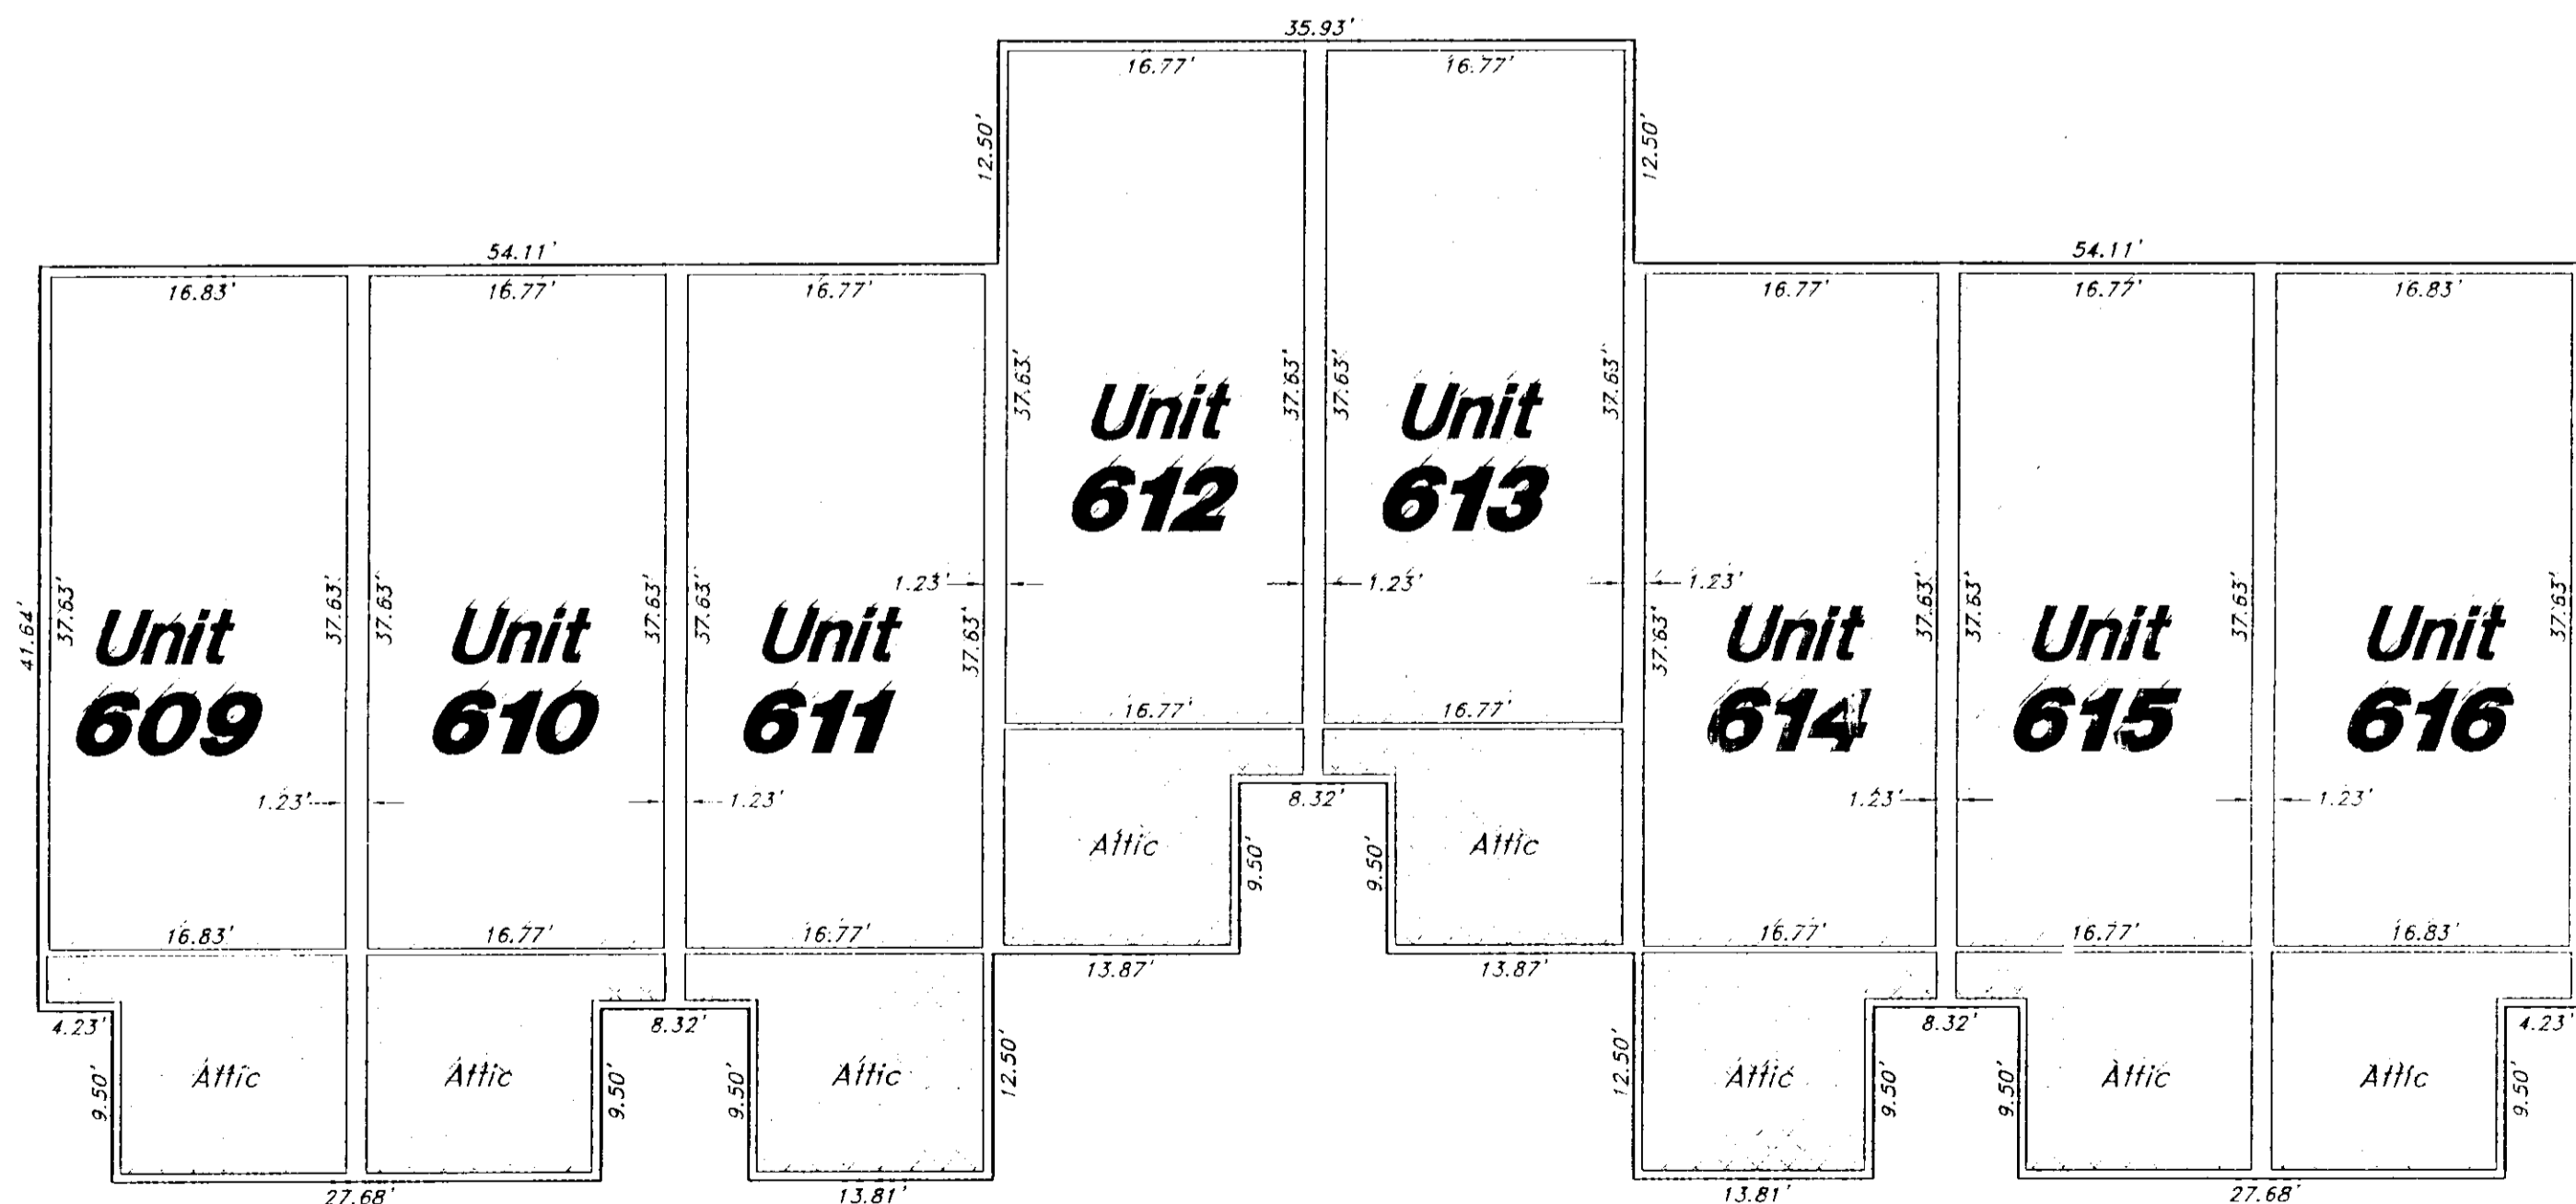

Building 6
Loft Floor Plan
Scale : 1" = 10'

Notes:

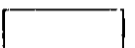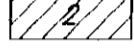- Elevations are based on USGS datum Benchmark - Brass Cap at center of Section 22, T7N, R1E, SLB&M = Elev. 5322.59
- Each condominium unit contained within the project is shown by a diagonal stripe and is designated by a unit number.
Common areas & facilities - 
Private ownership - 
Limited common area & facilities - 
(See sheets 2 through 5)
- Storage areas, patios, and balcony's or decks contained within the project are shown by cross hatched lines and are limited common use areas.
- All other areas contained within the project but are not shown with diagonal stripes or cross hatched lines are for common use.
- This building is not completed. Upon completion of construction, the map may require amendment in the event of any material change in the final location of improvements. (foundation is in place.)
- The elevation of all structures shall be greater than the elevation of any adjacent flood plain.



003049

WEBER COUNTY RECORDER

ENTRY NO. 1178915 FEE PAID
 11/22/00 FILED FOR RECORD AND
 RECORDED 10 DEC 01 AT
 1:52 PM IN BOOK 51 OF OFFICIAL
 RECORDS, PAGE 20 RECORDED
 FOR FIRST AMERICAN TITLE

Doug Crofts
 WEBER COUNTY RECORDER

BY: *Carole Warner*
 DEPUTY